

PROFILE	BY	DATE
CHECKED		
CHECKED		



404.6825 100.0140
N-10, ~~400.7295~~, E-11, ~~102.0159~~
LINE NO. 1, Sta. ~~0+60.0~~ = 0+58.6
LINE NO. 3, Sta. 0+00.0
MH 1

LINE NO. 1
See sheet no. 4

6748 949 839
N-10,585.3842; E-10,950.0059
Sta. 2+39.6 2+35.2
Const. MH 12
Standard MH (Type "P")

CAUTION !!!
Proposed 24" RCP Storm
Sewer (by others)

$\begin{matrix} .9076 & .384 \\ N-10,584.0013; & E-10,582.9929 \\ Sta. ~~6+06.6~~ & 6+02.7 \\ Const. MH 13 \\ Standard MH (Type "P") \end{matrix}$

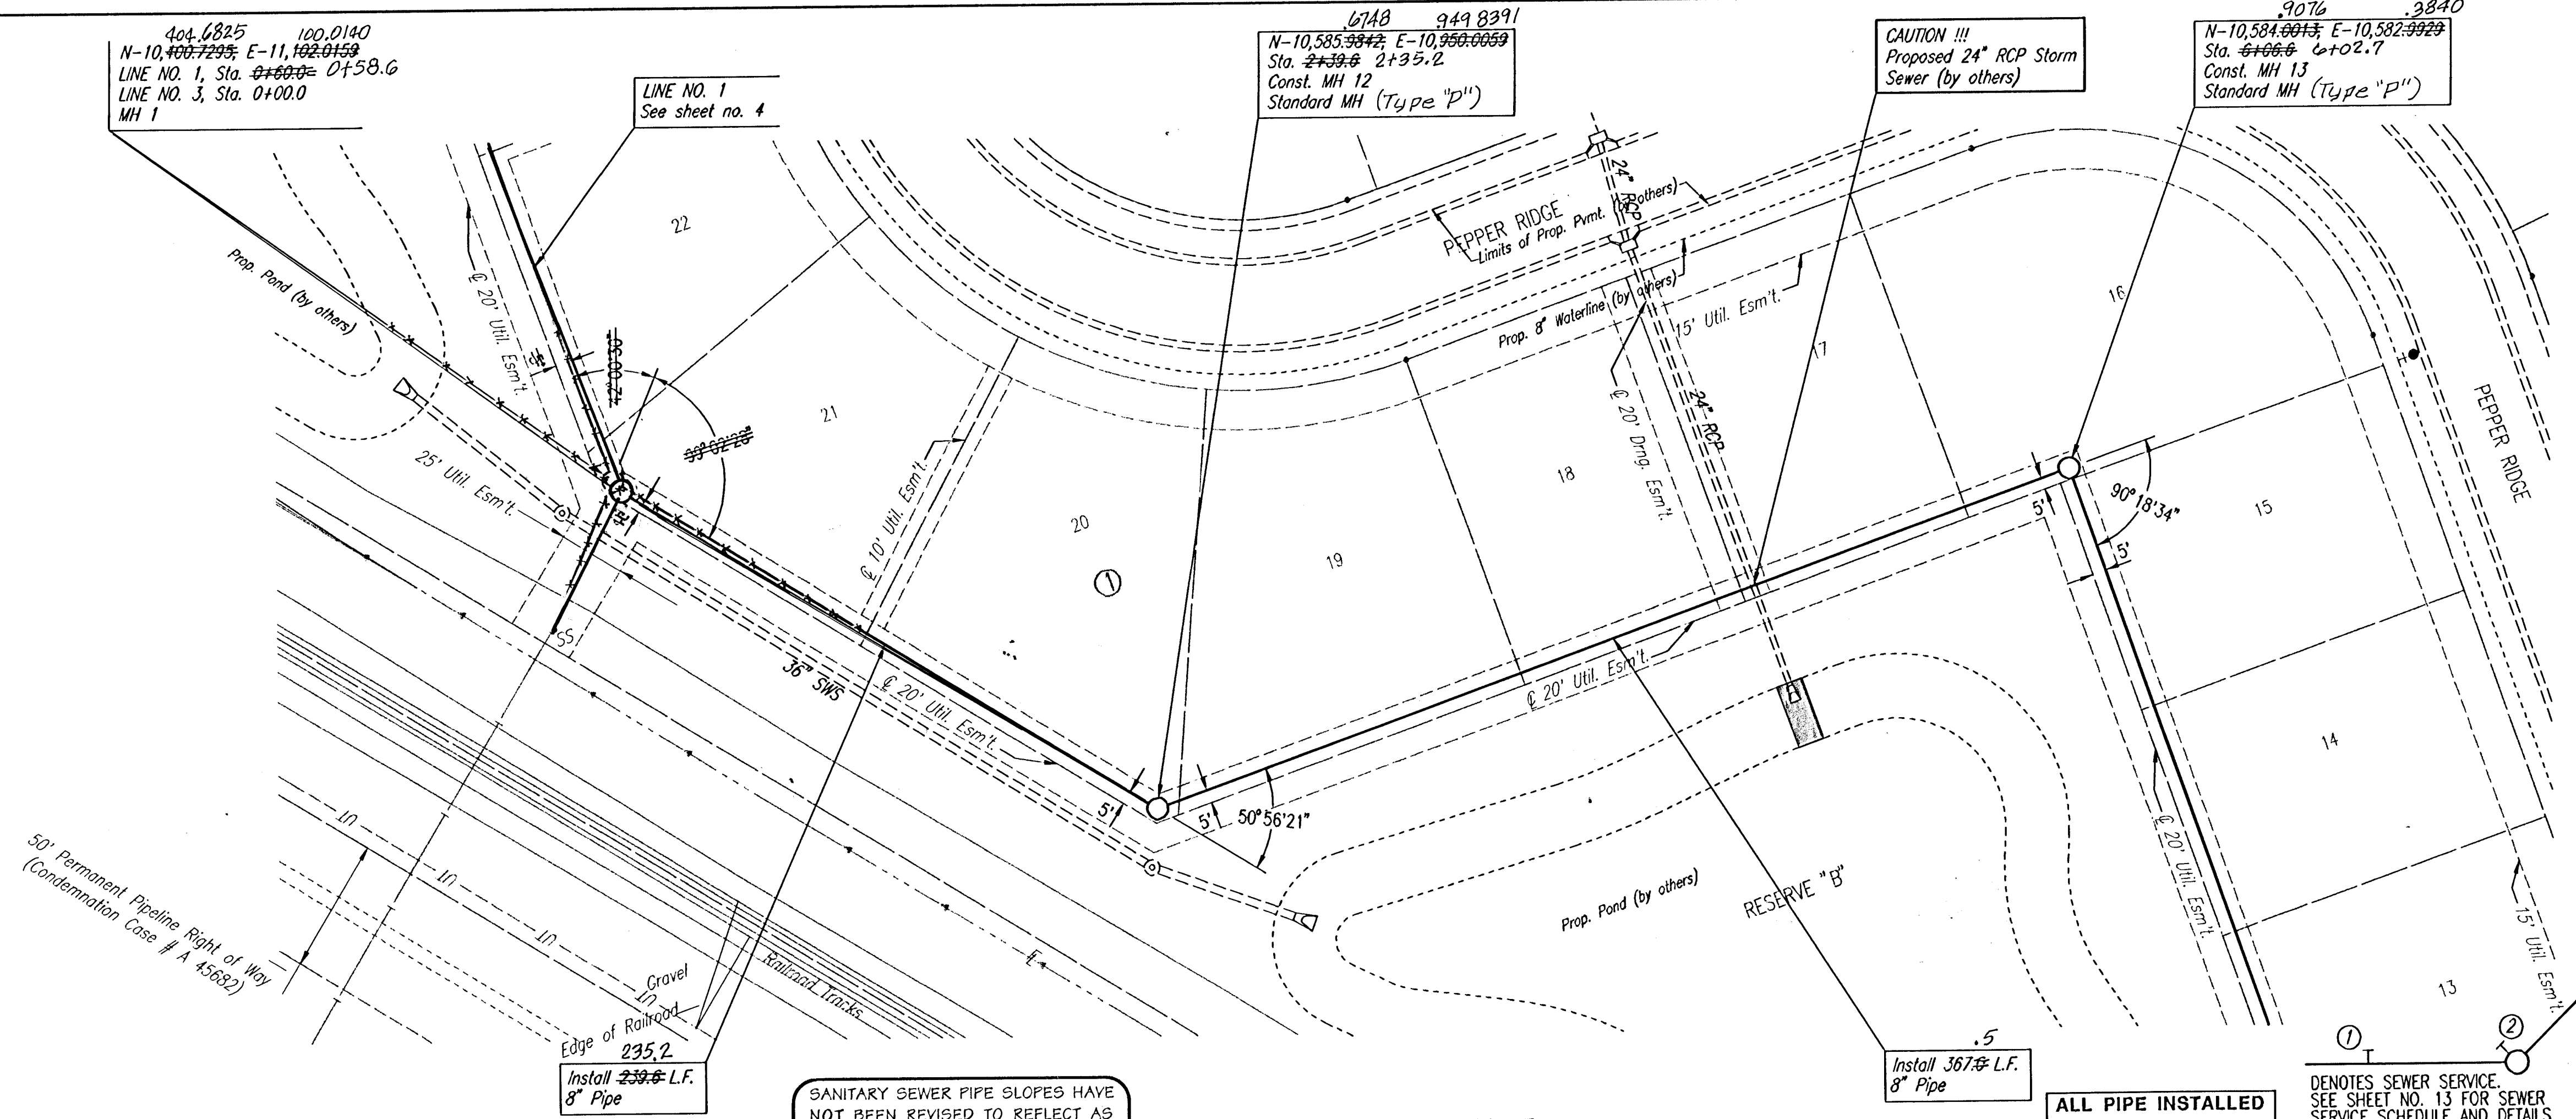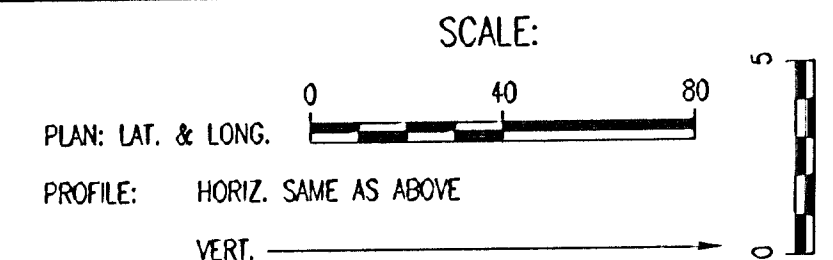

SANITARY SEWER PIPE SLOPES HAVE NOT BEEN REVISED TO REFLECT AS CONSTRUCTED CONDITIONS.



SANITARY SEWER LINE NO. 3

5
Install 367.5 L.F.
8" Pipe

**ALL PIPE INSTALLED
IS PVC PIPE.**

DENOTES SEWER SERVICE.
SEE SHEET NO. 13 FOR SEWER
SERVICE SCHEDULE AND DETAILS

RECORD DRAWING

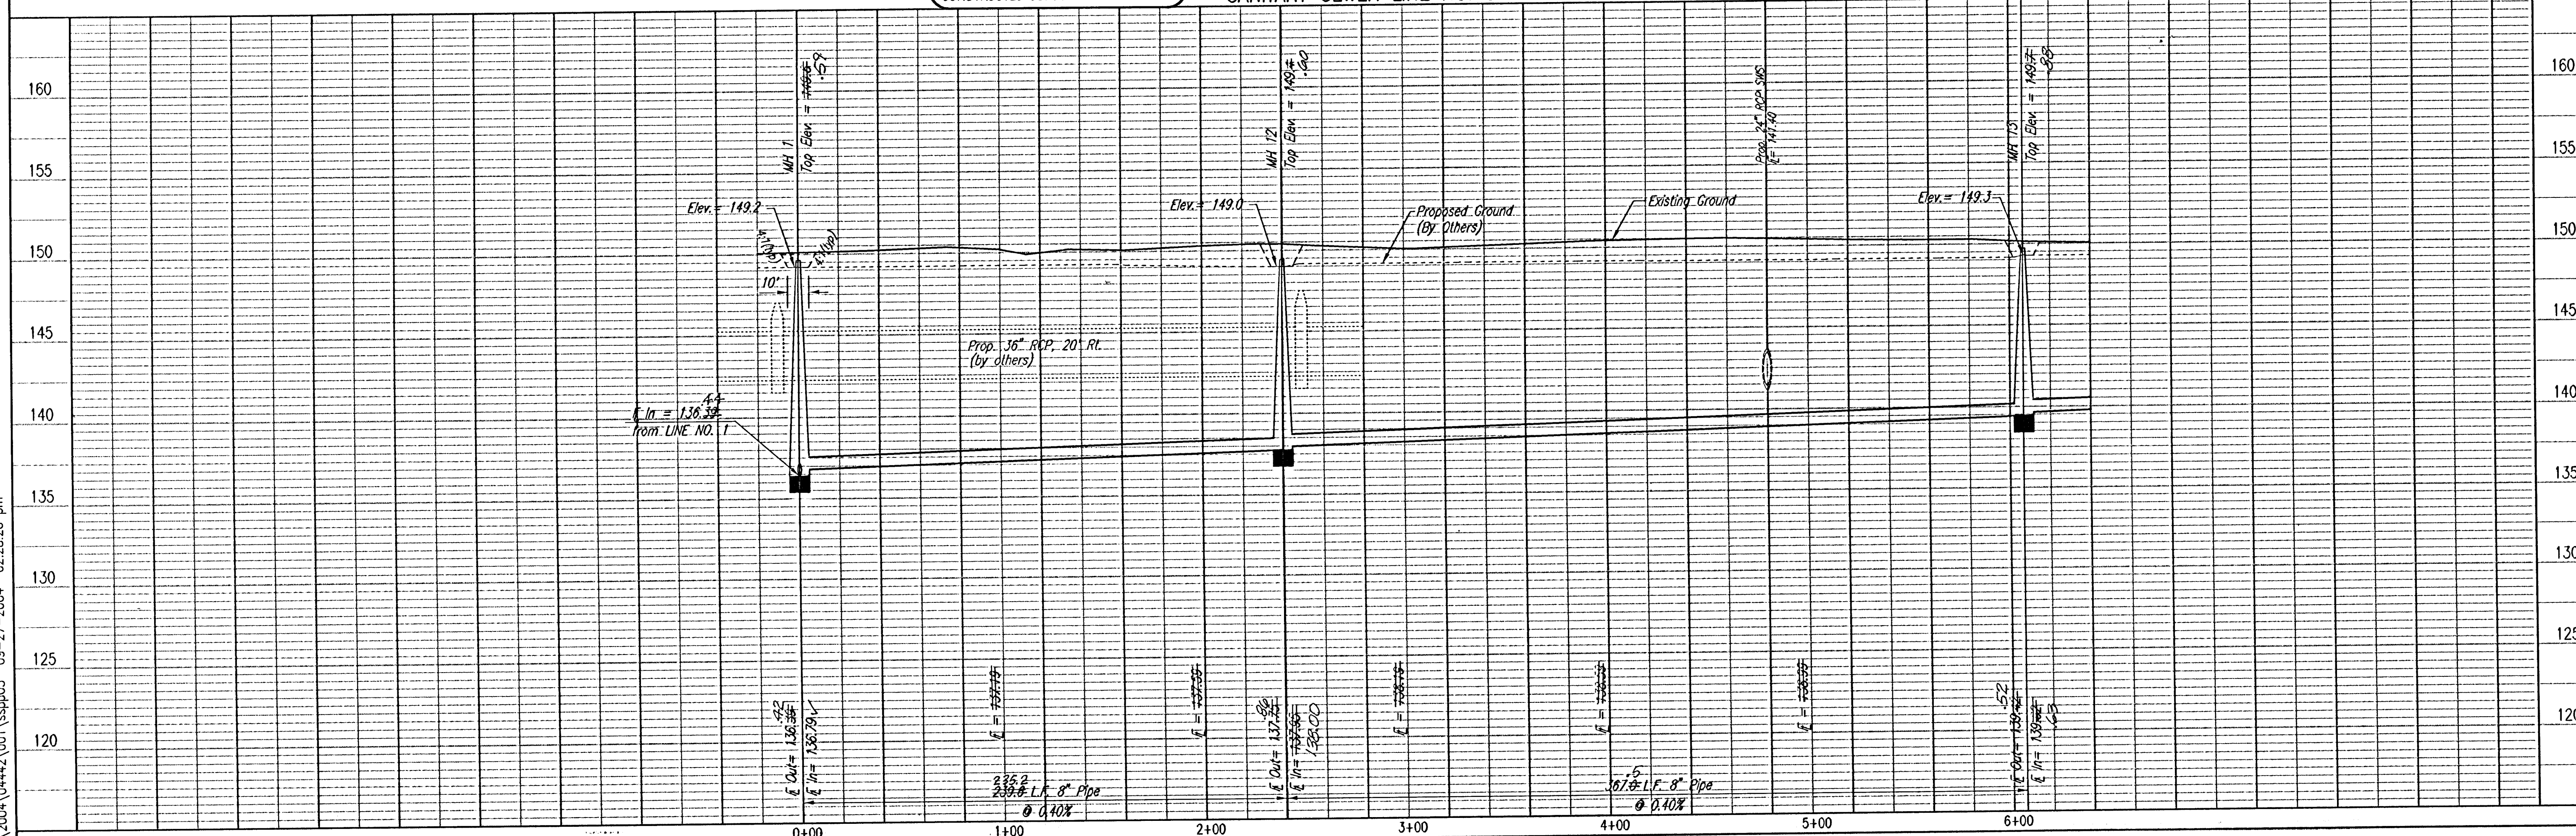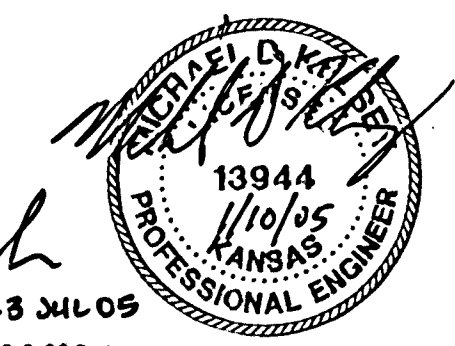

LATERAL 16, MAIN 19 OF THE
SOUTHWEST INTERCEPT SEWER

SANITARY SEWER LINE NO. 3

JAMES L. ARMOUR, P.E. - ACTING CITY ENGINEER
CITY OF WICHITA PROJECT NO. 468-83748

Professional Engineering Consultants, P.A.
303 S. TOPEKA • WICHITA, KANSAS 67202
316-261-2424 • FAX 316-242-2002

03 S. TOPEKA • WICHITA, KANSAS 67202
16-262-2691 • FAX 316-262-3003

Designed By	MDK	Job No.	35-04442-001-042
Drawn By	JCA	Date	July 2004

Designed By	MDK	Job No.	35-04442-001-042
Drawn By	JCA	Date	July 2004