
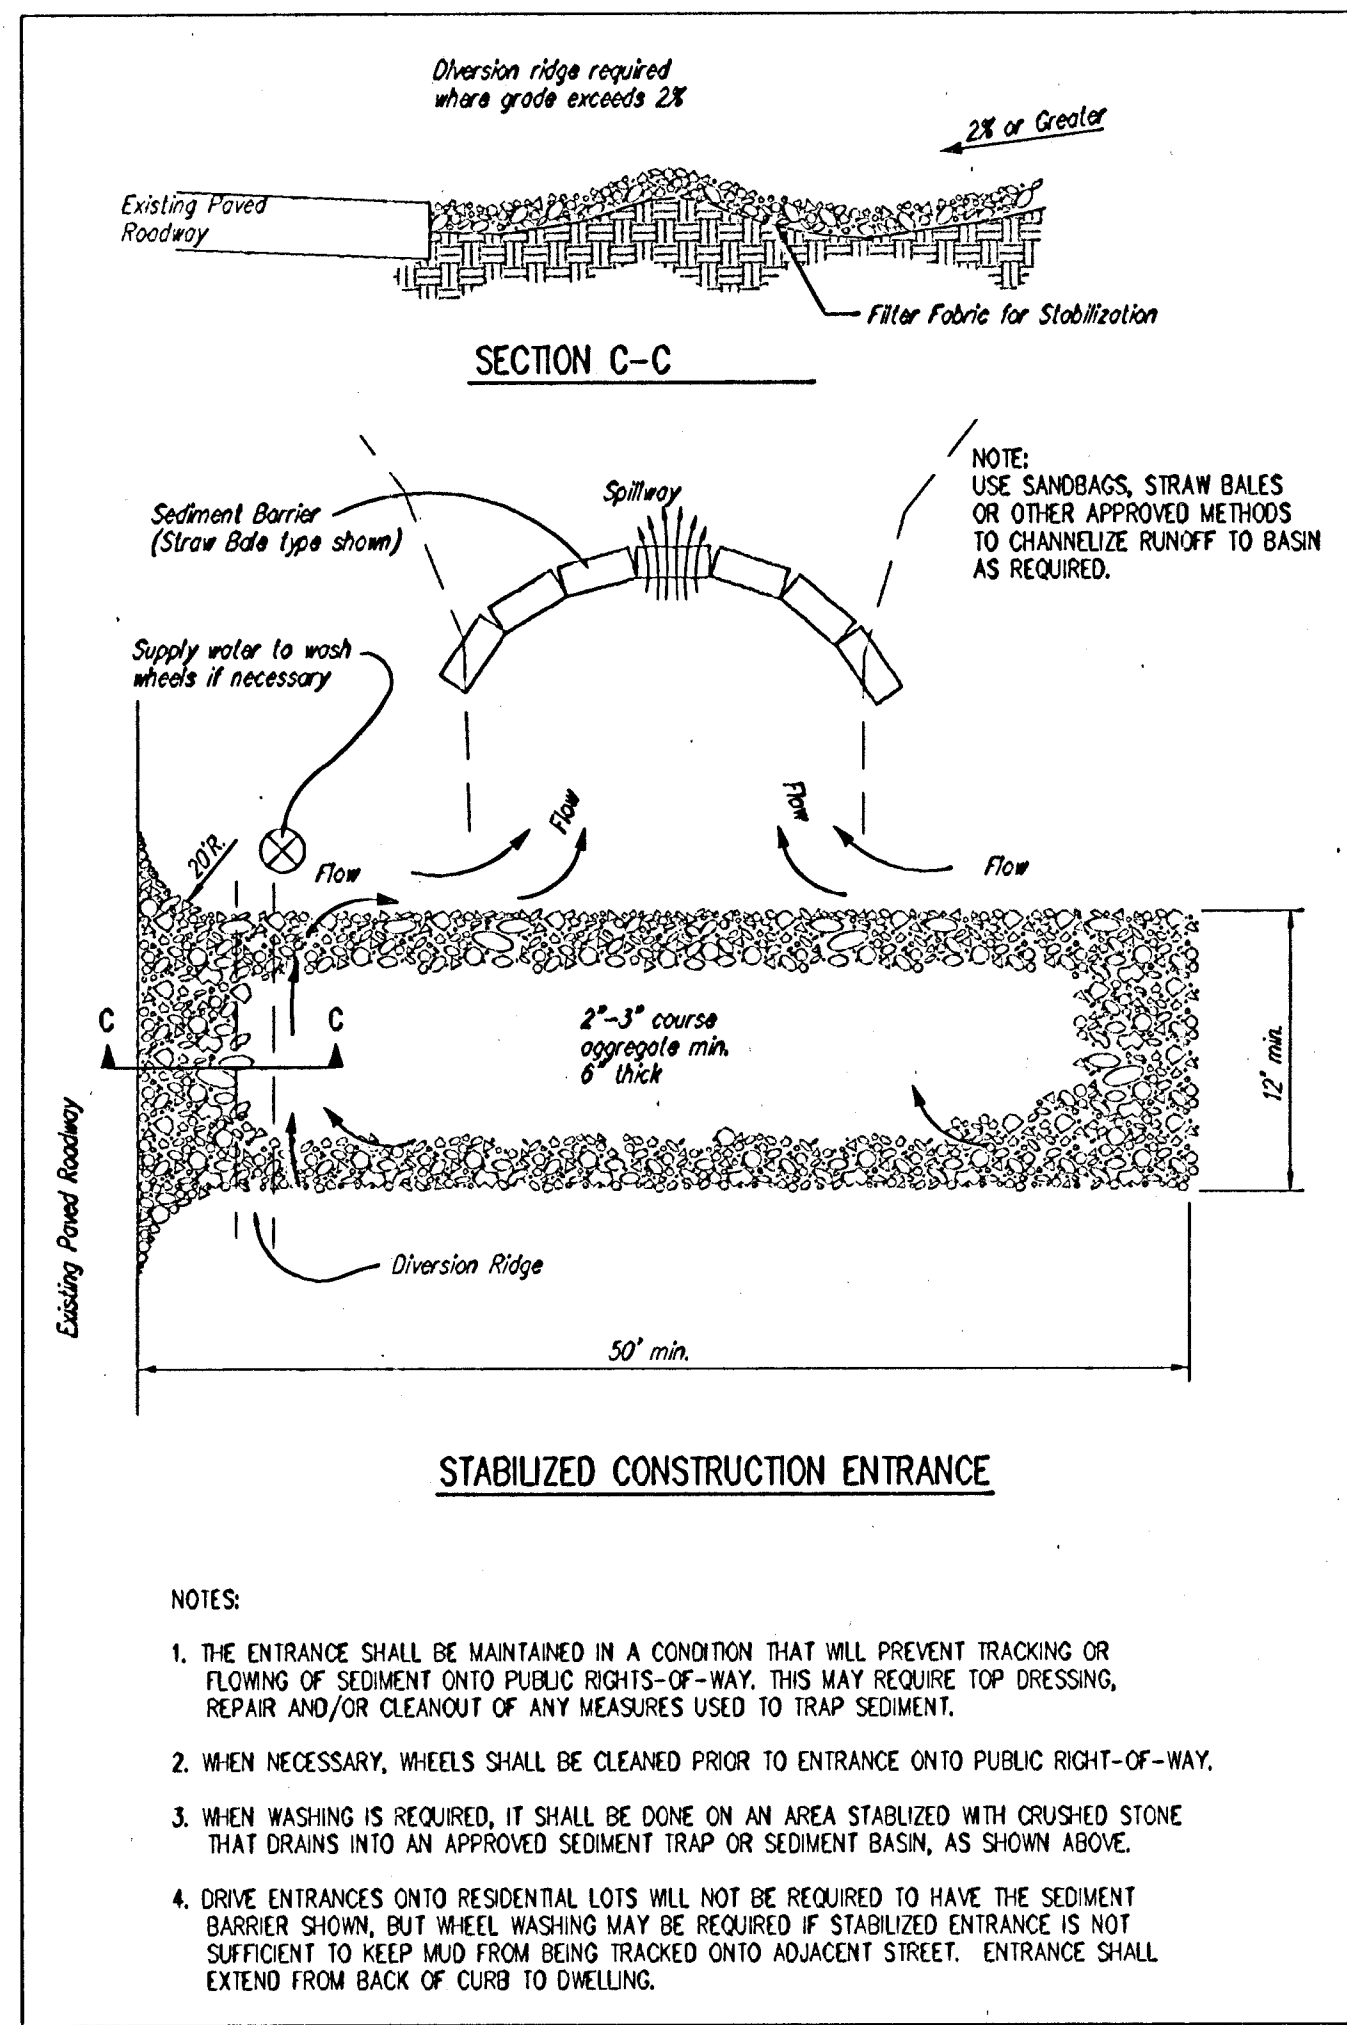


Scale:
1" = 40' Horizontal
• = Iron

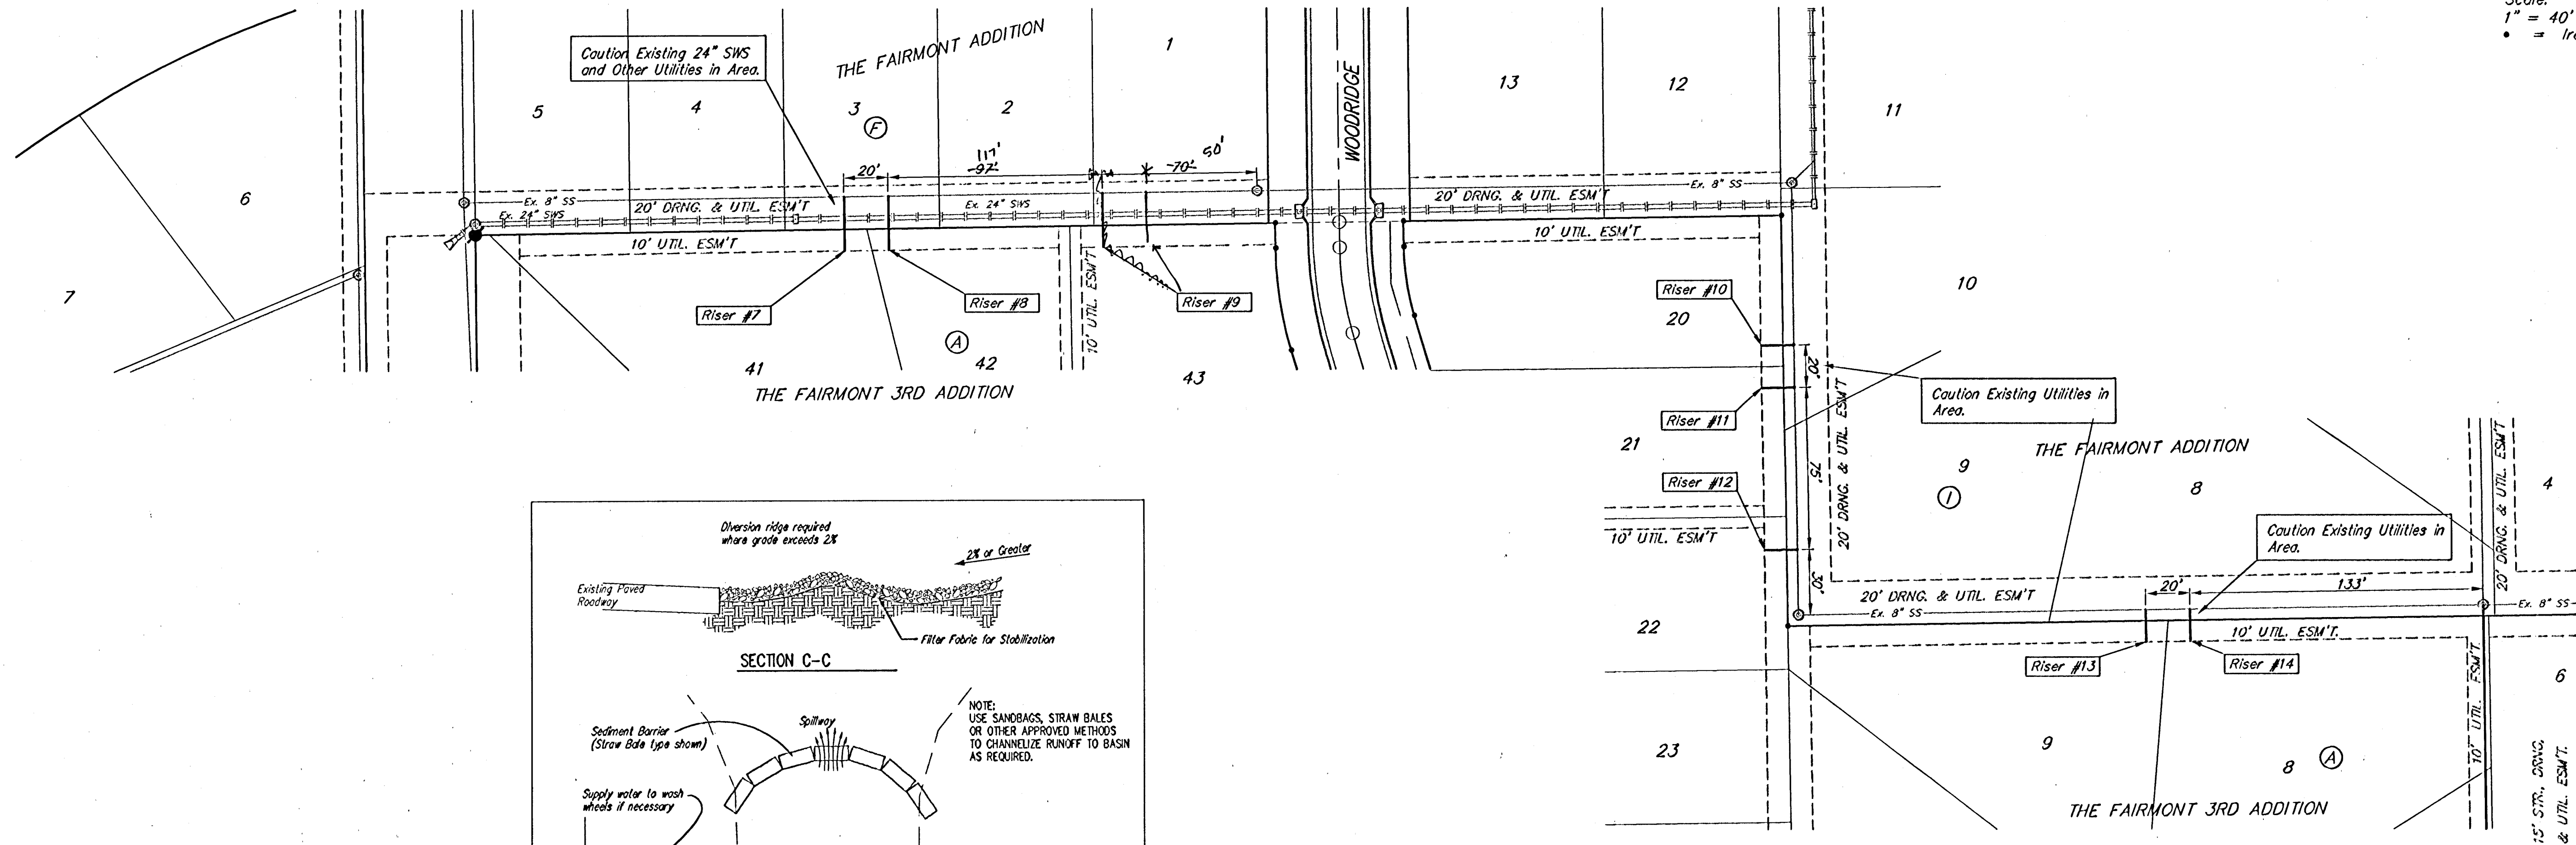

Contractor to verify depth & location of existing sanitary sewer line and utilities prior to construction.

SEWER SERVICE TABLE

NUMBER	TYPE	LOCATION			STATION/ DIRECTION	FOR INFORMATION ONLY APPROXIMATE LENGTH 4" PIPE	
		LOT NO.	BLOCK NO.	LINE NO.		VERTICAL	HORIZONTAL
7	8" X 4" Tee Saddle	41	A	Existing	Right	16.5'	25.0'
8	8" X 4" Tee Saddle	42	A	Existing	Right	16.5'	25.0'
9	8" X 4" Tee Saddle	43	A	Existing	Right	16.5'	25.0'±
10	8" X 4" Tee Saddle	20	A	Existing	Right	16.5'	15.0'
11	8" X 4" Tee Saddle	21	A	Existing	Right	16.5'	15.0'
12	8" X 4" Tee Saddle	22	A	Existing	Right	16.5'	15.0'
13	8" X 4" Tee Saddle	9	A	Existing	Right	16.5'	15.0'
14	8" X 4" Tee Saddle	8	A	Existing	Right	16.5'	15.0'

NOTE: Vertical Riser Pipe shall be extended to 2' minimum above ground water elevation and 4' maximum below proposed ground elevation.
Contractor shall use method "B" for riser construction. (See Detail, Sheet 10)

As Built 4/12/05 KK

THE FAIRMONT 3rd
RISER PLAN
SANITARY SEWER IMPROVEMENTS

BAUGHMAN COMPANY P.A.
ENGINEERING, SURVEYING, & PLANNING
316-262-7271 • 315 ELLIS • WICHITA, KANSAS 67211

PROJECT NUMBER
488-83935

DESIGN A/D DRAWN DSM APPROVED DATE 12/04 SCALE NOTED SHEET **7** OF **16**