


# CONSTRUCTION PLANS FOR WAR INDUSTRIES RELIEF SEWER (PHASE 3)

FOR  
THE CITY OF WICHITA,  
SEDGWICK COUNTY, KANSAS  
MICHAEL E. LINDEBAK, P.E.-CITY ENGINEER

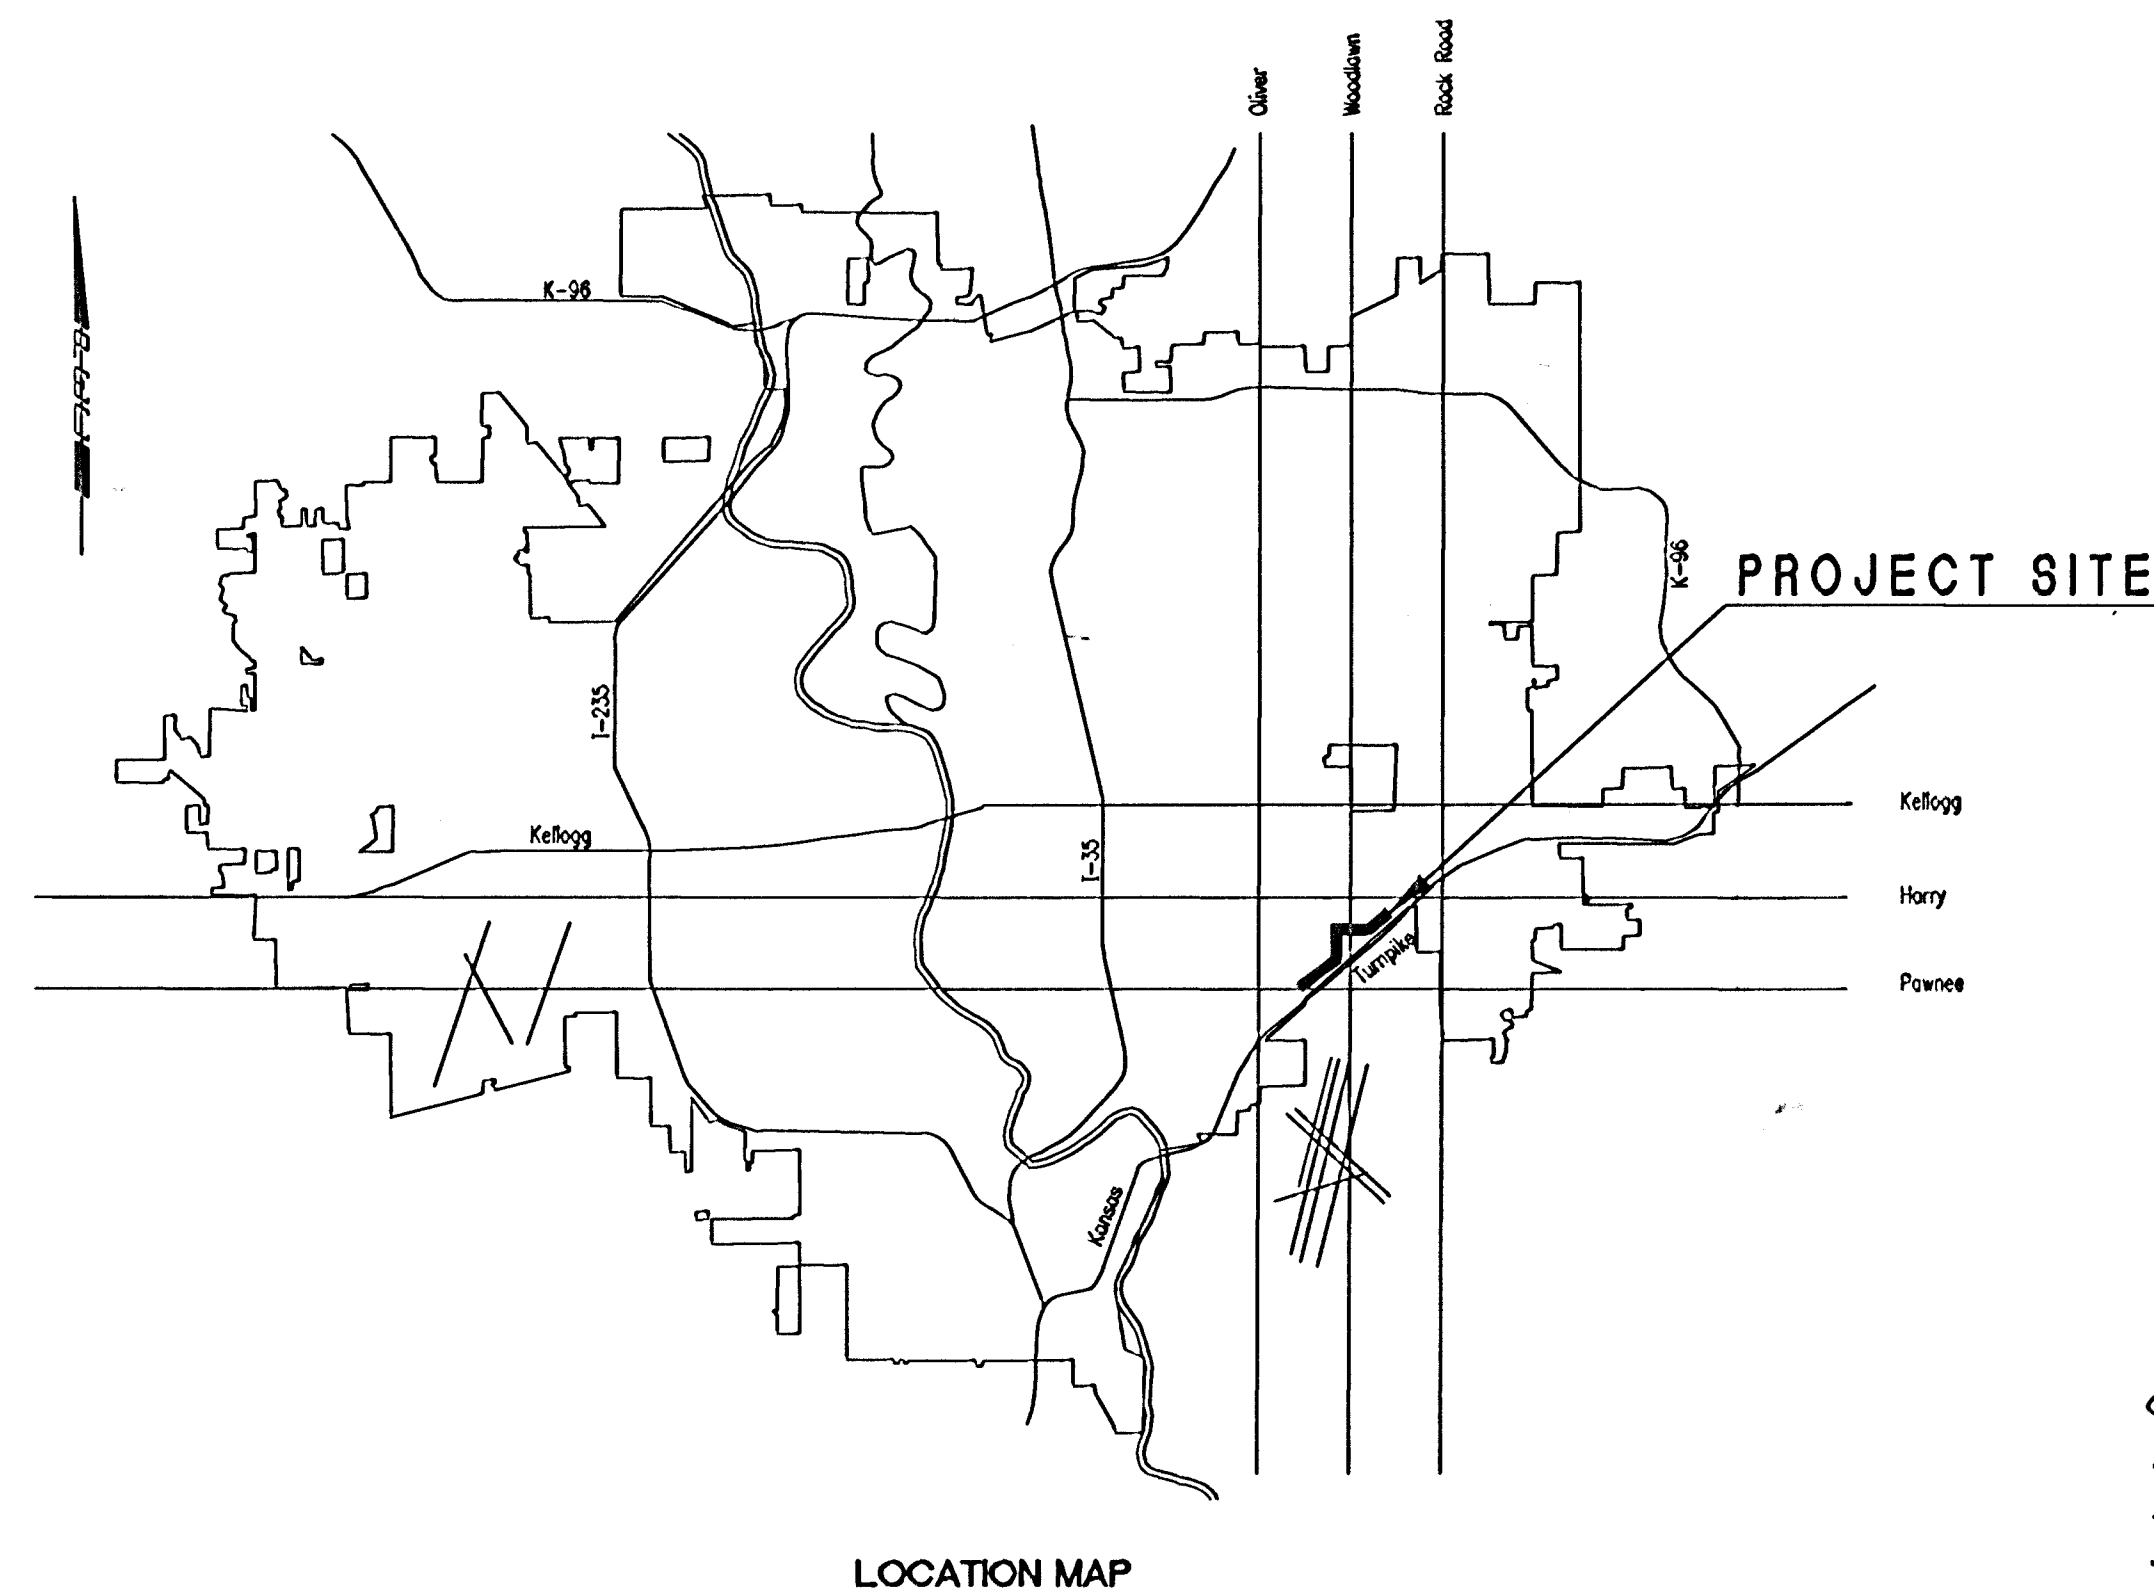

LOCATION MAP

## INDEX OF SHEETS

|                |                          |
|----------------|--------------------------|
| SHEET NO. 1    | TITLE SHEET              |
| SHEET NO. 2    | KEY MAP                  |
| SHEET NO. 3-14 | PLAN/PROFILE             |
| SHEET NO. 15   | SANITARY SEWER DETAILS   |
| SHEET NO. 16   | TYPE "P" MANHOLE DETAILS |
| SHEET NO. 17   | MANHOLE FRAME AND COVER  |
| SHEET NO. 18   | EROSION CONTROL DETAILS  |

*Note: Not as-built  
Changes reflect best info available  
7/27/04 - RDL*

*Garver Construction, LTD., BRH Garver, General Partner- Contractor  
Wood, City Inspector  
Released 8/16/05  
JDL 8/30/05*

OCA NO. 623323

CITY OF WICHITA PROJECT NO. 468-76-245-82930-000-000-001

**OCTOBER 2000**

### BENCH MARKS

- BM #18 - (DATUM) CITY OF WICHITA BENCH MARK DISC AT NORTHEAST CORNER OF BRIDGE OVER THE GYPSUM CREEK ON PANNIE, ± 300' WEST OF KANSAS TURNPIKE, ± 395' EAST OF E OF ADAMS STREET. ELEV. = 123.02
- BM #19 - "I" POST 5' OFF WESTERLY EDGE OF CONCRETE BIKE PATH, ± 60' ENE OF 12' DECIDUOUS TREE. ELEV. = 123.77
- BM #20 - CHISELED "o" AT NORTHEAST CORNER OF PAVILLON. ELEV. = 129.38
- BM #21 - CHISELED "o" IN TOP BACK CURB, ON SOUTH SIDE OF KINKAID STREET, ADJACENT TO CENTER OF DRIVE AT 5938 EAST KINKAID. ELEV. = 140.19
- BM #22 - CHISELED "o" ON WESTERLY SIDE OF CONCRETE BIKE PATH AT 2 - 15'±20' CMP'S. ELEV. = 139.77
- BM #23 - CHISELED "o" IN SOUTHWEST CORNER OF CONCRETE LIGHT POLE BASE NEAR NORTHEAST CORNER OF PLAYGROUND. ELEV. = 134.25
- BM #24 - RAILROAD SPIKE IN SOUTH FACE OF LIGHT POLE AT NORTHEAST CORNER OF WINDSOR AND SKINNER STREETS. ELEV. = 131.19
- BM #25 - CITY OF WICHITA BENCH MARK DISC ON SOUTHEAST CORNER OF BRIDGE OVER GYPSUM CREEK ON WOODLAWN. ELEV. = 136.79
- BM #26 - "I" POST ± 23' EAST AND ± 5' SOUTH OF NORTHEAST CORNER OF FENCE TO STORAGE UNITS. ELEV. = 144.78
- BM #27 - "I" POST AT SOUTHERLY EDGE OF ASPHALT BIKE PATH, ± 353' NE OF 40' RCP OUTFALL AT NORTH SIDE GYPSUM CREEK. ELEV. = 134.32
- BM #28 - CHISELED "o" ON NORTHERLY EDGE OF BIKE PATH WHERE ASPHALT STOPS AND CONCRETE BEGINS. ELEV. = 126.































