


BENCHMARK:
Arkansas River bridge & 63rd St. S. City of
Wichita Benchmark Disc. SW Cor. of bridge,
top of hubguard, 500'± E. of Grove.
Elev. = 1269.95 NGVD29 (per City record)

Brass plate on the NE wingwall of Arkansas
River bridge & 63rd St. S.
Elev. = 1267.48 NGVD29 (per County record)

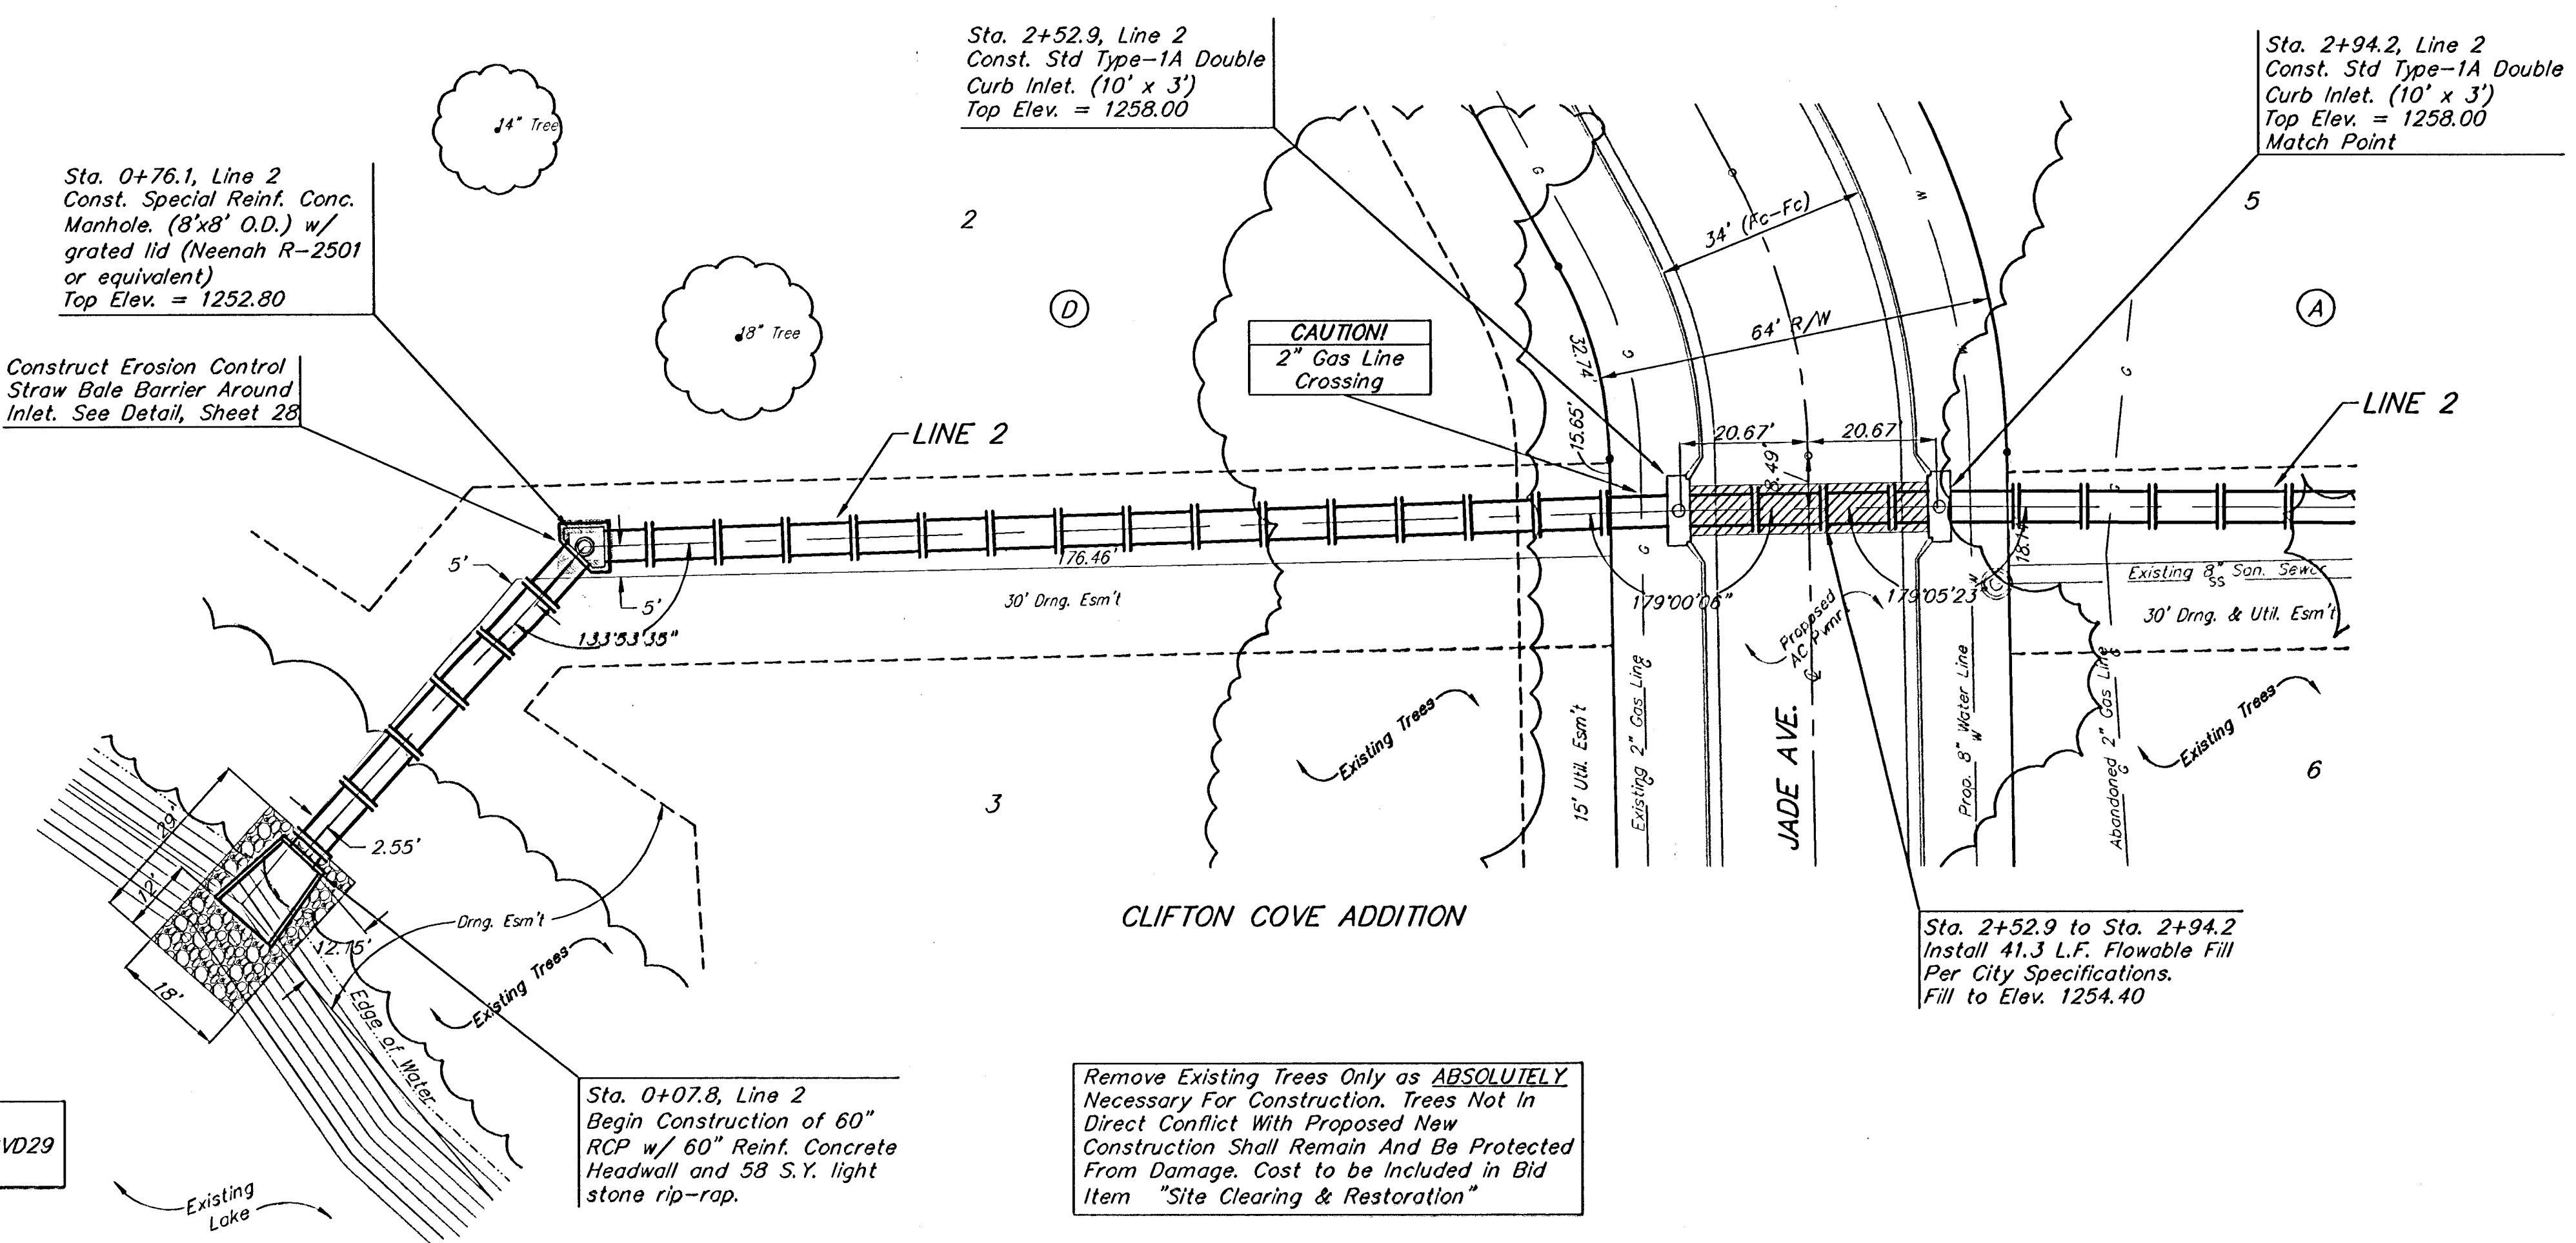


SCALE:
1" = 20' HORIZONTAL
1" = 5' VERTICAL
• = IRON

POND DATA:
STATIC POOL ELEVATION: 1246.6 NGVD29
100 YEAR DWS: 1256.0 NGVD29

RESERVE "B"

Remove Existing Trees Only as ABSOLUTELY
Necessary For Construction. Trees Not in
Direct Conflict With Proposed New
Construction Shall Remain And Be Protected
From Damage. Cost to be Included in Bid
Item "Site Clearing & Restoration"

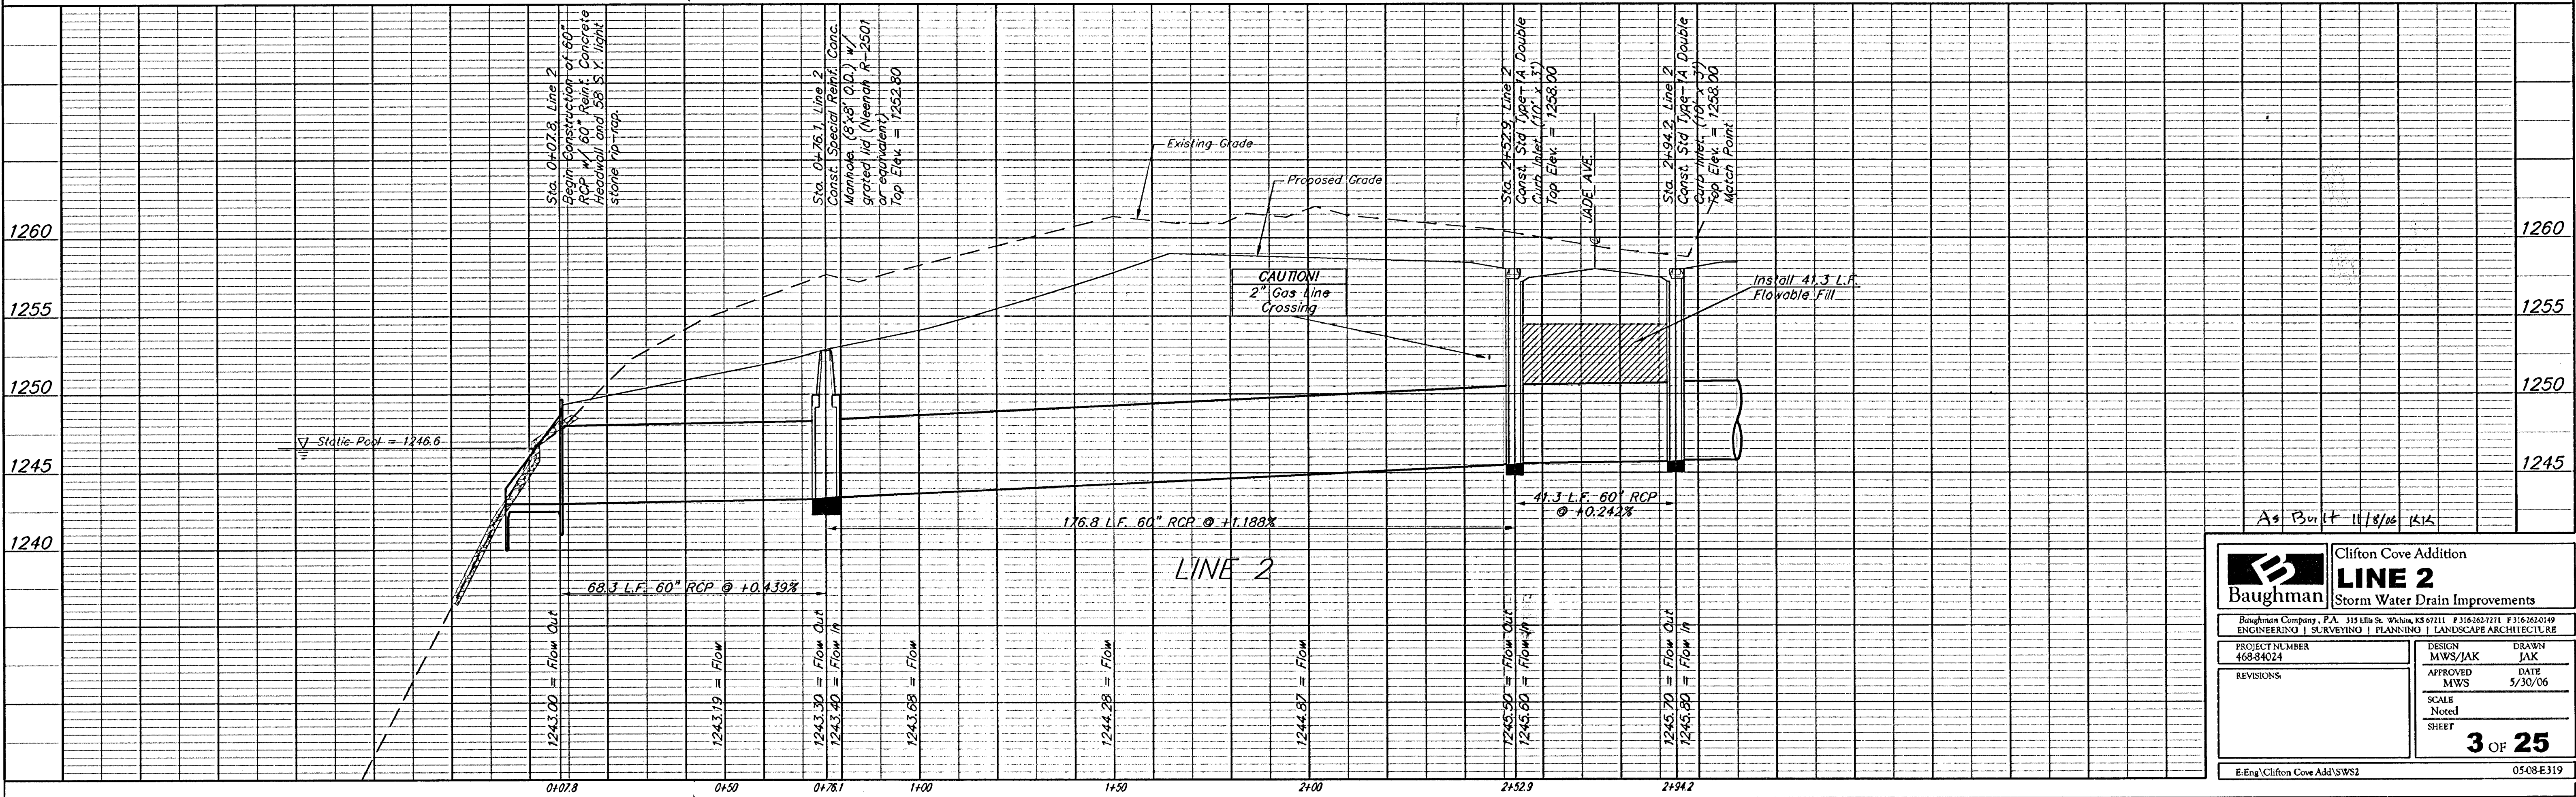

As Built 11/8/06 JAK

Baughman		Clifton Cove Addition LINE 2 Storm Water Drain Improvements	
Baughman Company, P.A. 315 Ellis St. Wichita, KS 67211 P 316-262-7271 F 316-262-0149 ENGINEERING SURVEYING PLANNING LANDSCAPE ARCHITECTURE			
PROJECT NUMBER 46894024		DESIGN JAWS/JAK	DRAWN JAK
REVISIONS:		APPROVED MWS	DATE 5/30/06
		SCALE Noted	SHEET 3 OF 25
E:\Eng\Clifton Cove Add\SWSI		05-08-E319	