


DSNR: OPER JGA SCALE: 1"=100.00
C:\2002\02633\Irrigation Map South 09-22-2004 05:51:51 pm

NEWCREST.DWG
ASBUILT,
May 7, 1991

IRRIGATION LEGEND	
○	Existing Sprinkler Head (Not To Be Replaced)
●	Rain Bird Model 510S/510R; Nozzle Set 18x11.5
●	Rain Bird Model 470S; Nozzle Set 16
●	Rain Bird Model 910S/910R; Nozzle Set 13/32x15/84
△	Existing Quick Coupler Valve
●	Rain Bird EFA Series Remote Control Valve (Not To Be Replaced)
●	Rain Bird PES-PRS Remote Control Valve (Part of System Expansion)
●	Existing TH Type Valve - To Be Replaced By Rain Bird PES-PRS Series
SB	Rain Bird SBM-1230-SS Satellite Controller (Designated By Path & Device #)
MS-3	Controller/Station Valve Assignment
*	Designates Station & Heads Assigned To MSR-4 Multi-Station Relay
■	Existing Manual Drain Valve
x	Isolation Valve
---	Underground Wire Path
---d	Main Line Isolation Valve; Cast Iron, AWWA Standards; Full Line Size
---	Property Line or Road Centerline
---	Irrigation Main Pipe Line; Size As Noted; Gasket Joints
---	Irrigation Sub-Main Pipe Line; Size Per Specifications; Solvent Weld Joints
NR	Combination Air/Vacuum Relief Valve; Location Approximate; Best Sited Location To Be Selected During Installation
---	Stream Bed or Lake Shoreline

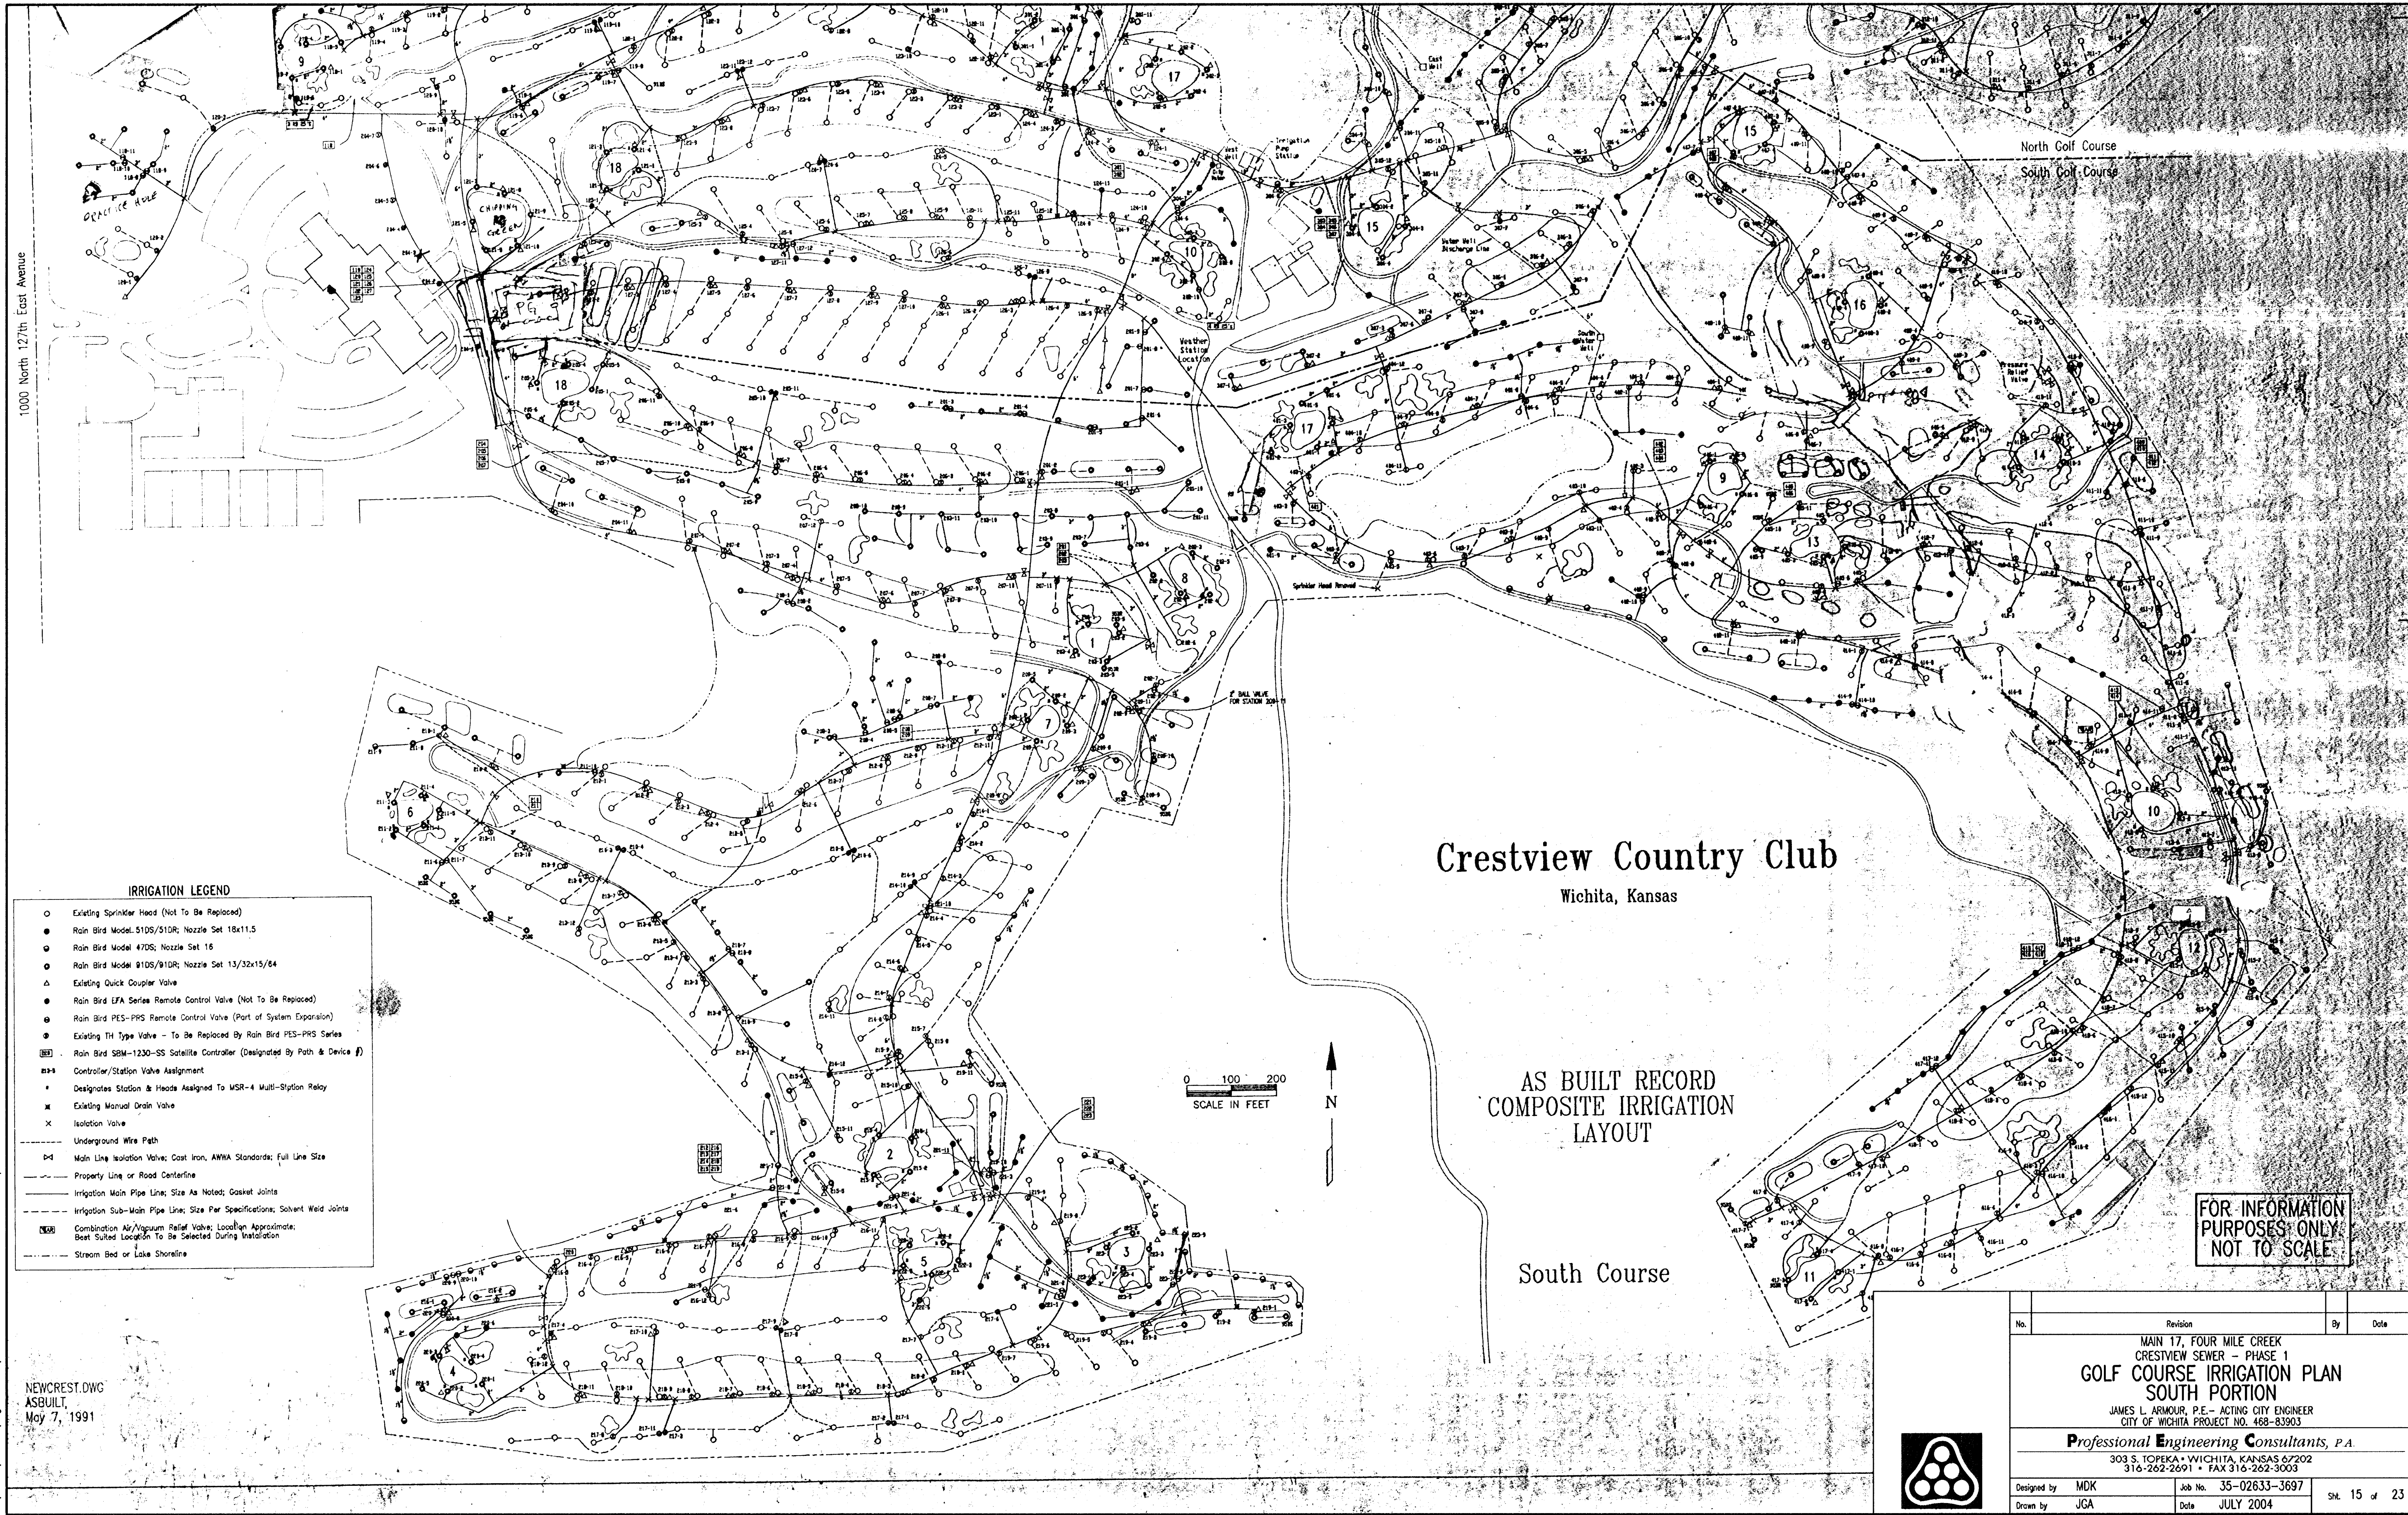


Crestview Country Club

Wichita, Kansas

AS BUILT RECORD
COMPOSITE IRRIGATION
LAYOUT

South Course

FOR INFORMATION
PURPOSES ONLY
NOT TO SCALE

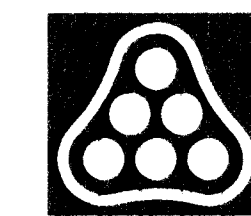

No.	Revision	By	Date
	MAIN 17, FOUR MILE CREEK CRESTVIEW SEWER - PHASE 1 GOLF COURSE IRRIGATION PLAN SOUTH PORTION JAMES L. ARMOUR, P.E. - ACTING CITY ENGINEER CITY OF WICHITA PROJECT NO. 468-83903 Professional Engineering Consultants, P.A. 303 S. TOPKA • WICHITA, KANSAS 67202 316-262-2691 • FAX 316-262-3003		
Designed by	MDK	Job No.	35-02633-3697
Drawn by	JGA	Date	JULY 2004
		Sht. 15 of 23	