
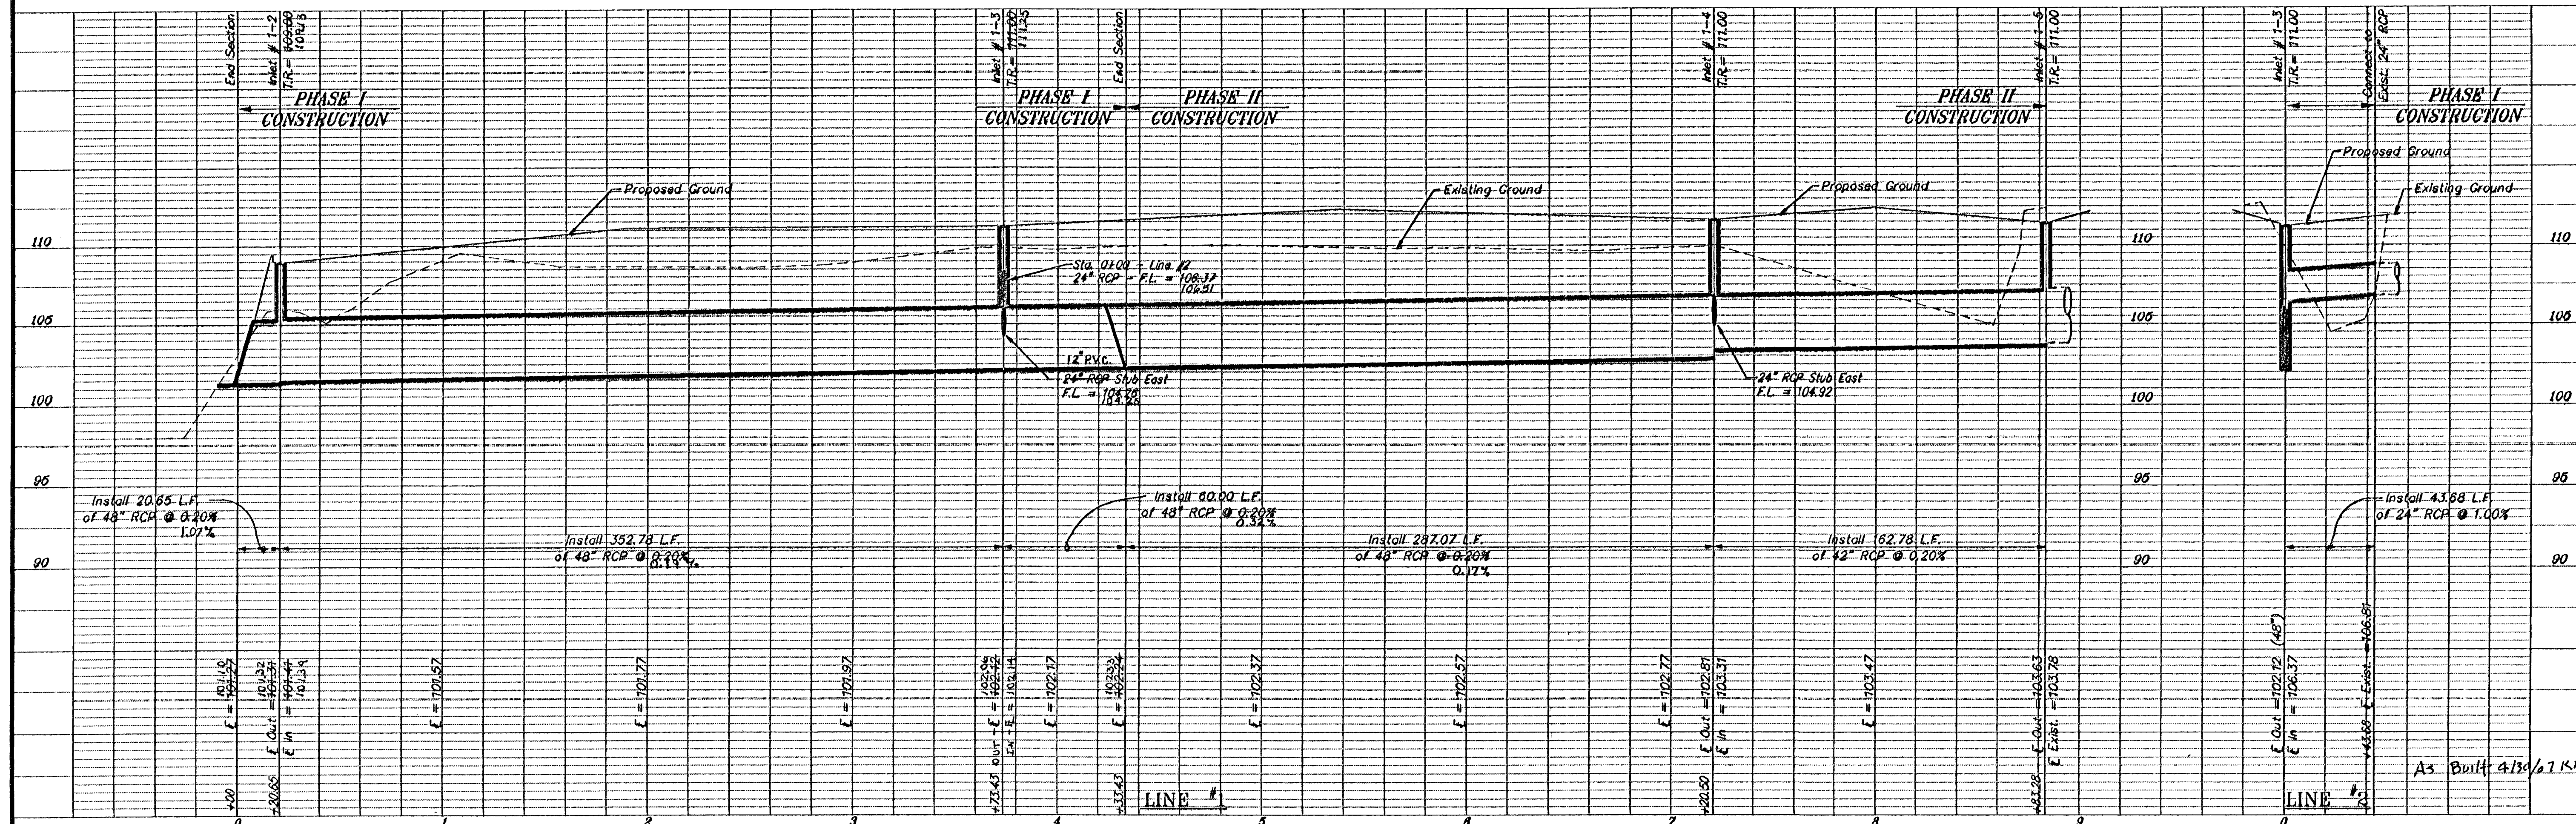


BENCH MARK: "V" - NOTCH IN CENTERLINE OF MCCORMICK
40' N. OF NORTHWEST CORNER OF GOEBEL BROS. 4TH ADDITION.
ELEV. = 113.59 CITY DATUM

SCALE
PLAN 1" = 40'
PROFILE 1" = 40' HORZ.
1" = 5' VERT.

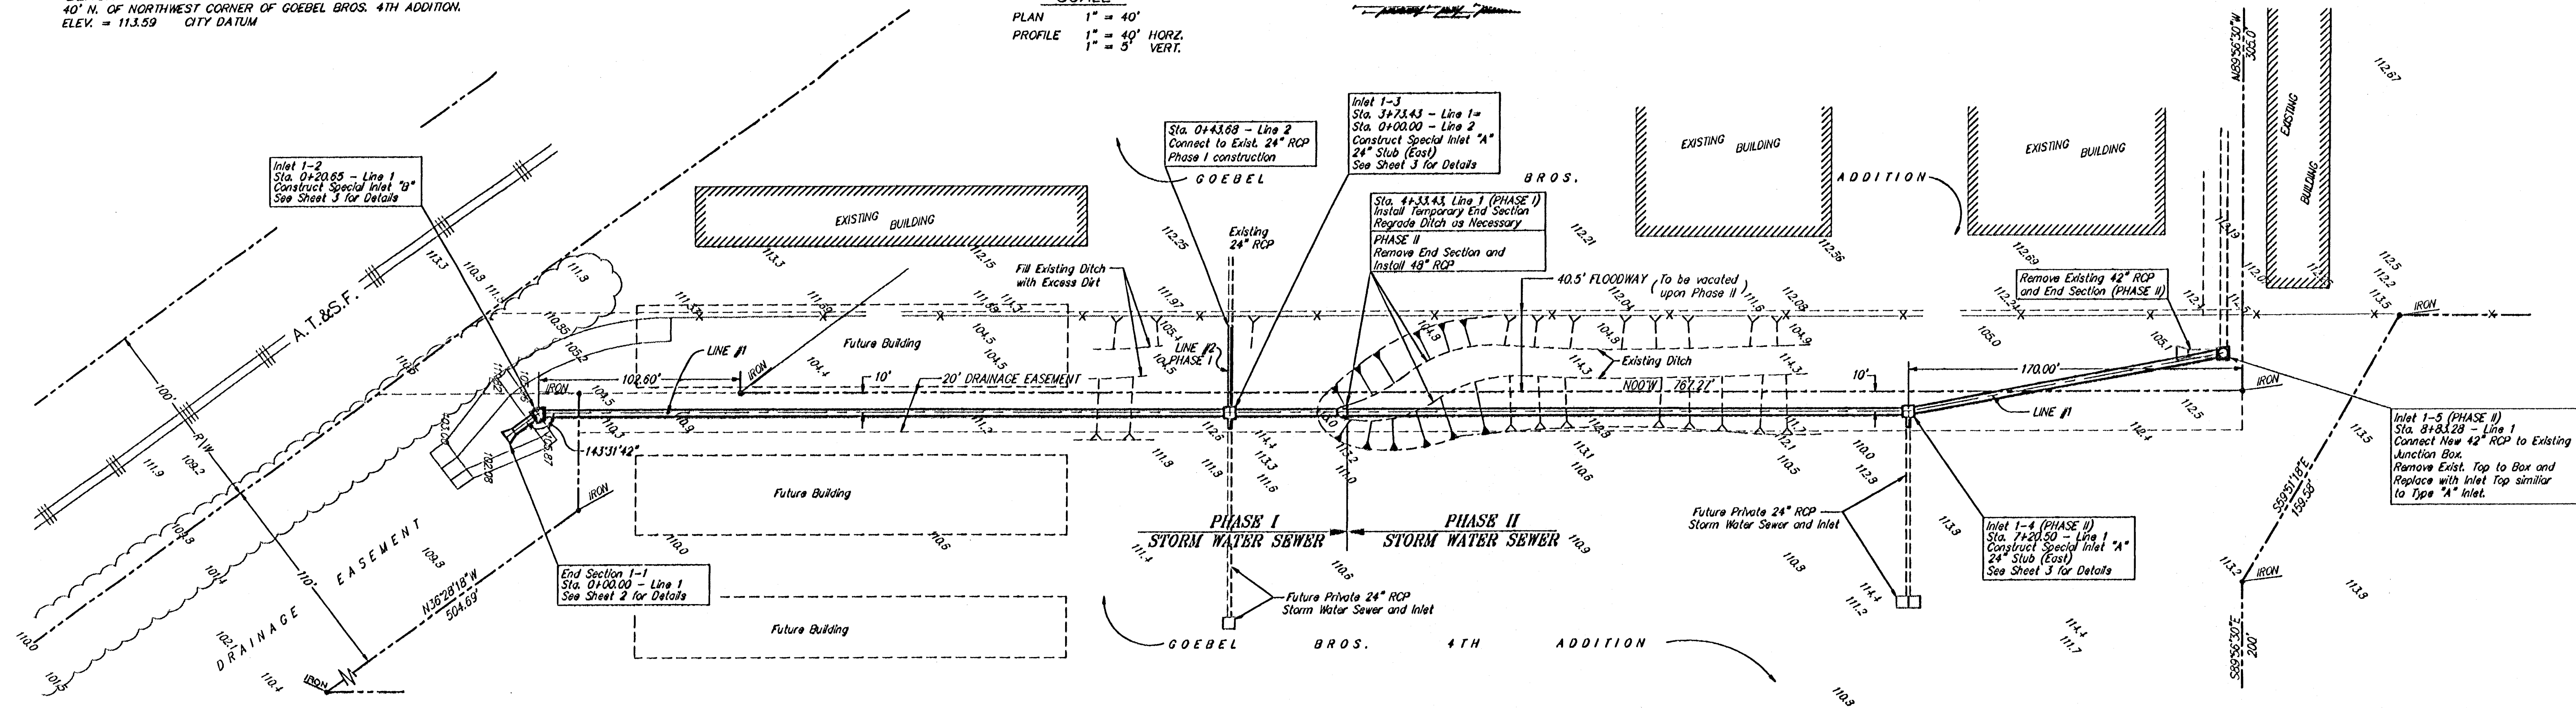

PRIVATE STORM WATER SEWER
EXTENSION TO SERVE
GOEBEL 4TH ADDITION

LINES #1 AND #2

BAUGHMAN COMPANY P. A.
SURVEYING & ENGINEERING
316/262-7271 • 315 ELLIS • WICHITA, KANSAS 67211

Drawn by: [Signature]
Date: December 16, 1992

Revision: [Table]
By: [Table]
Date: [Table]

As Built 4/13/07 K2