
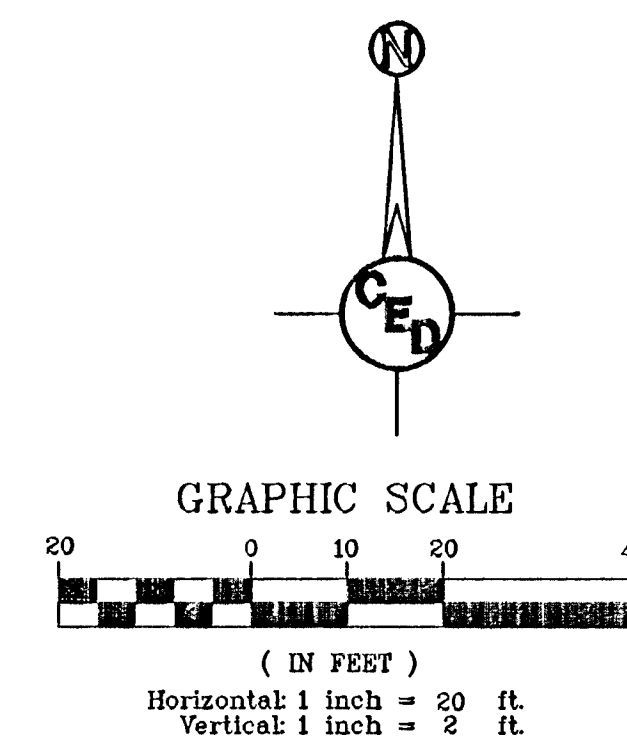



C.P. NO. 1	N 19211.92 E 18134.47	NE Cor. of Prop., Pipe w/ Plastic Cap Found
C.P. NO. 2	N 19056.91 E 18134.65	SE Corner of Property Pipe Found

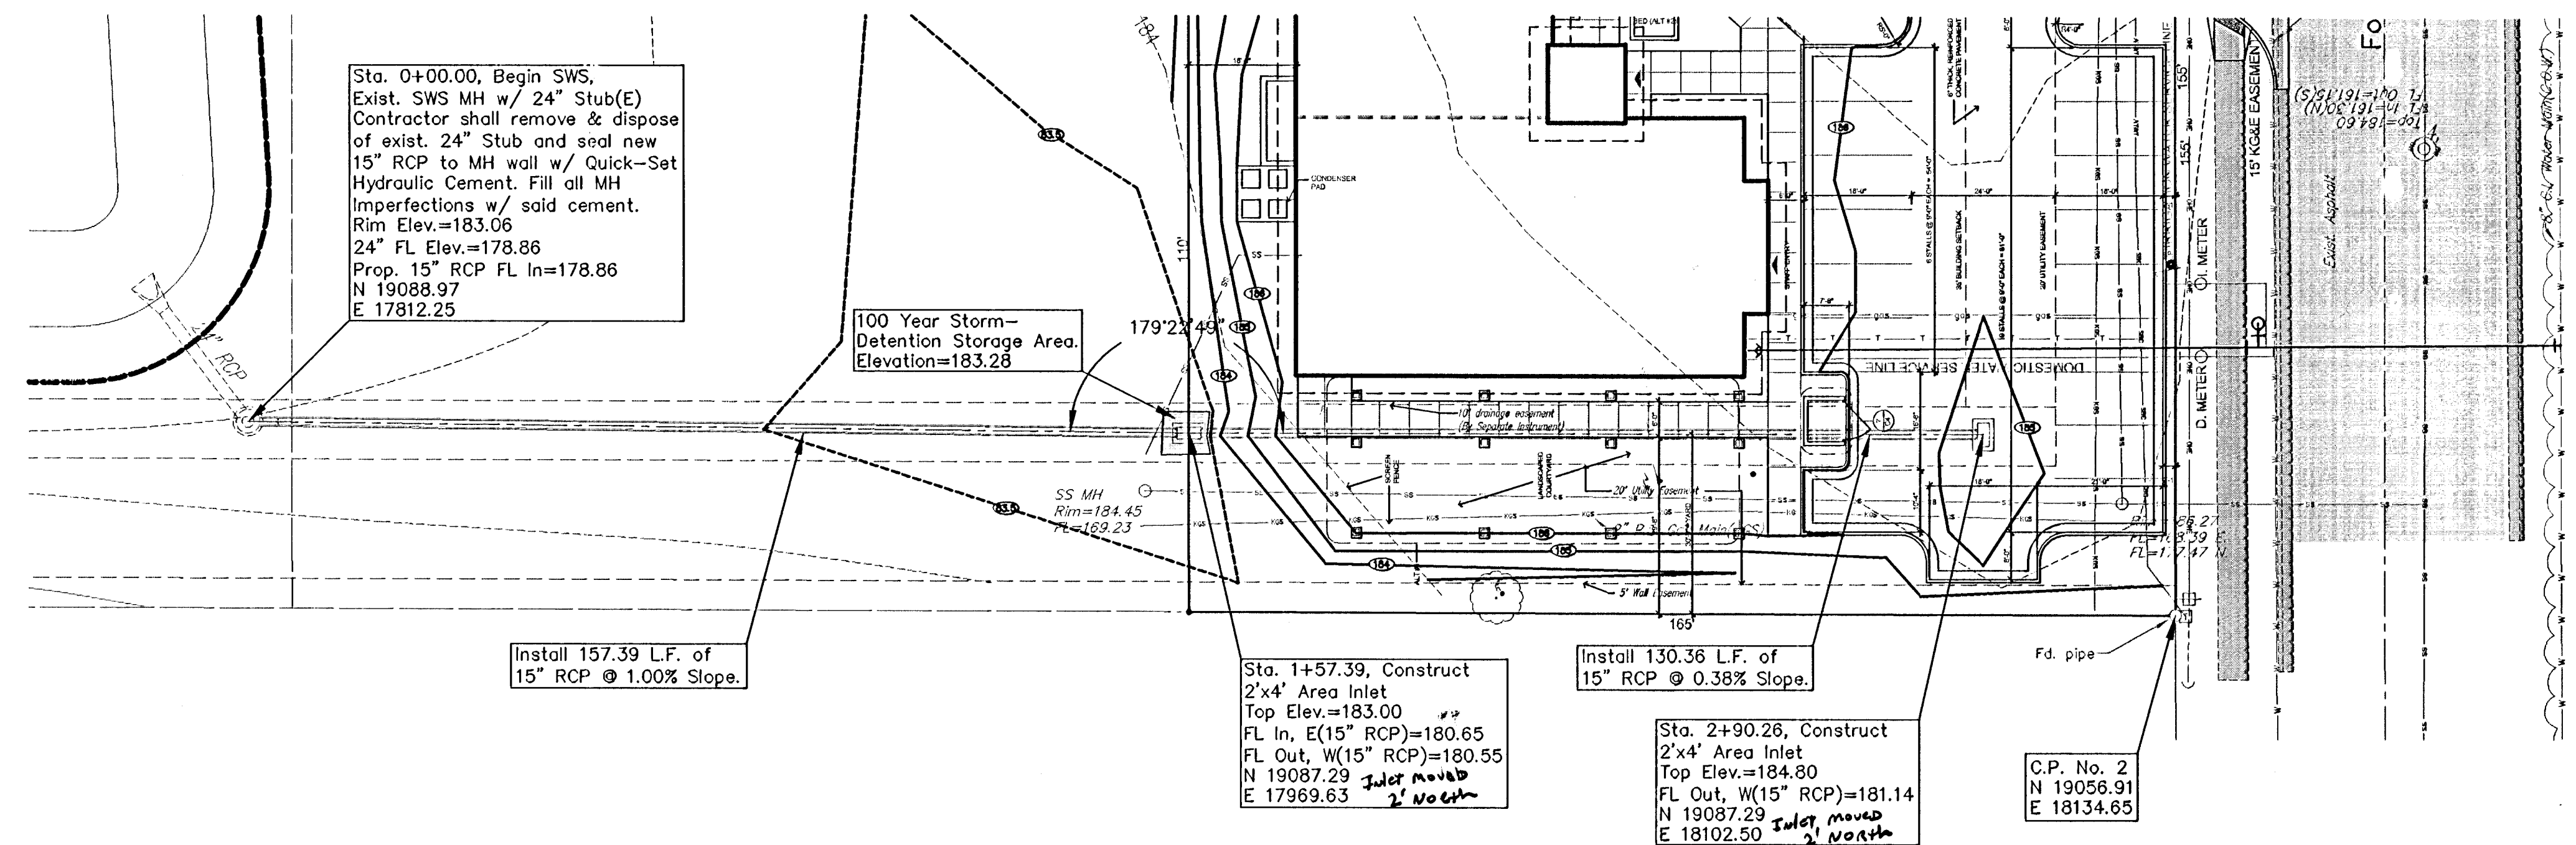

Benchmark:
R.R. Spike in N. Face of P.P.
120' S. of Ctr. Res. A on W.
side of Founders St.(Wawona).
Elev.=190.17(City Datum)

UTILITIES SHOWN REPRESENT THE BEST INFORMATION AVAILABLE FOR DESIGN. ADDITIONAL UTILITIES MAY BE PRESENT ON THIS PROJECT. THE CONTRACTOR SHALL BE RESPONSIBLE FOR DETERMINING THE EXACT LOCATION, DEPTH AND SIZE OF ALL UNDERGROUND UTILITIES PRIOR TO CONSTRUCTION. THE CONTRACTOR SHALL BE LIABLE FOR ANY DAMAGE CAUSED BY THE FAILURE TO DO SO.

STORM WATER SEWER IMPROVEMENTS

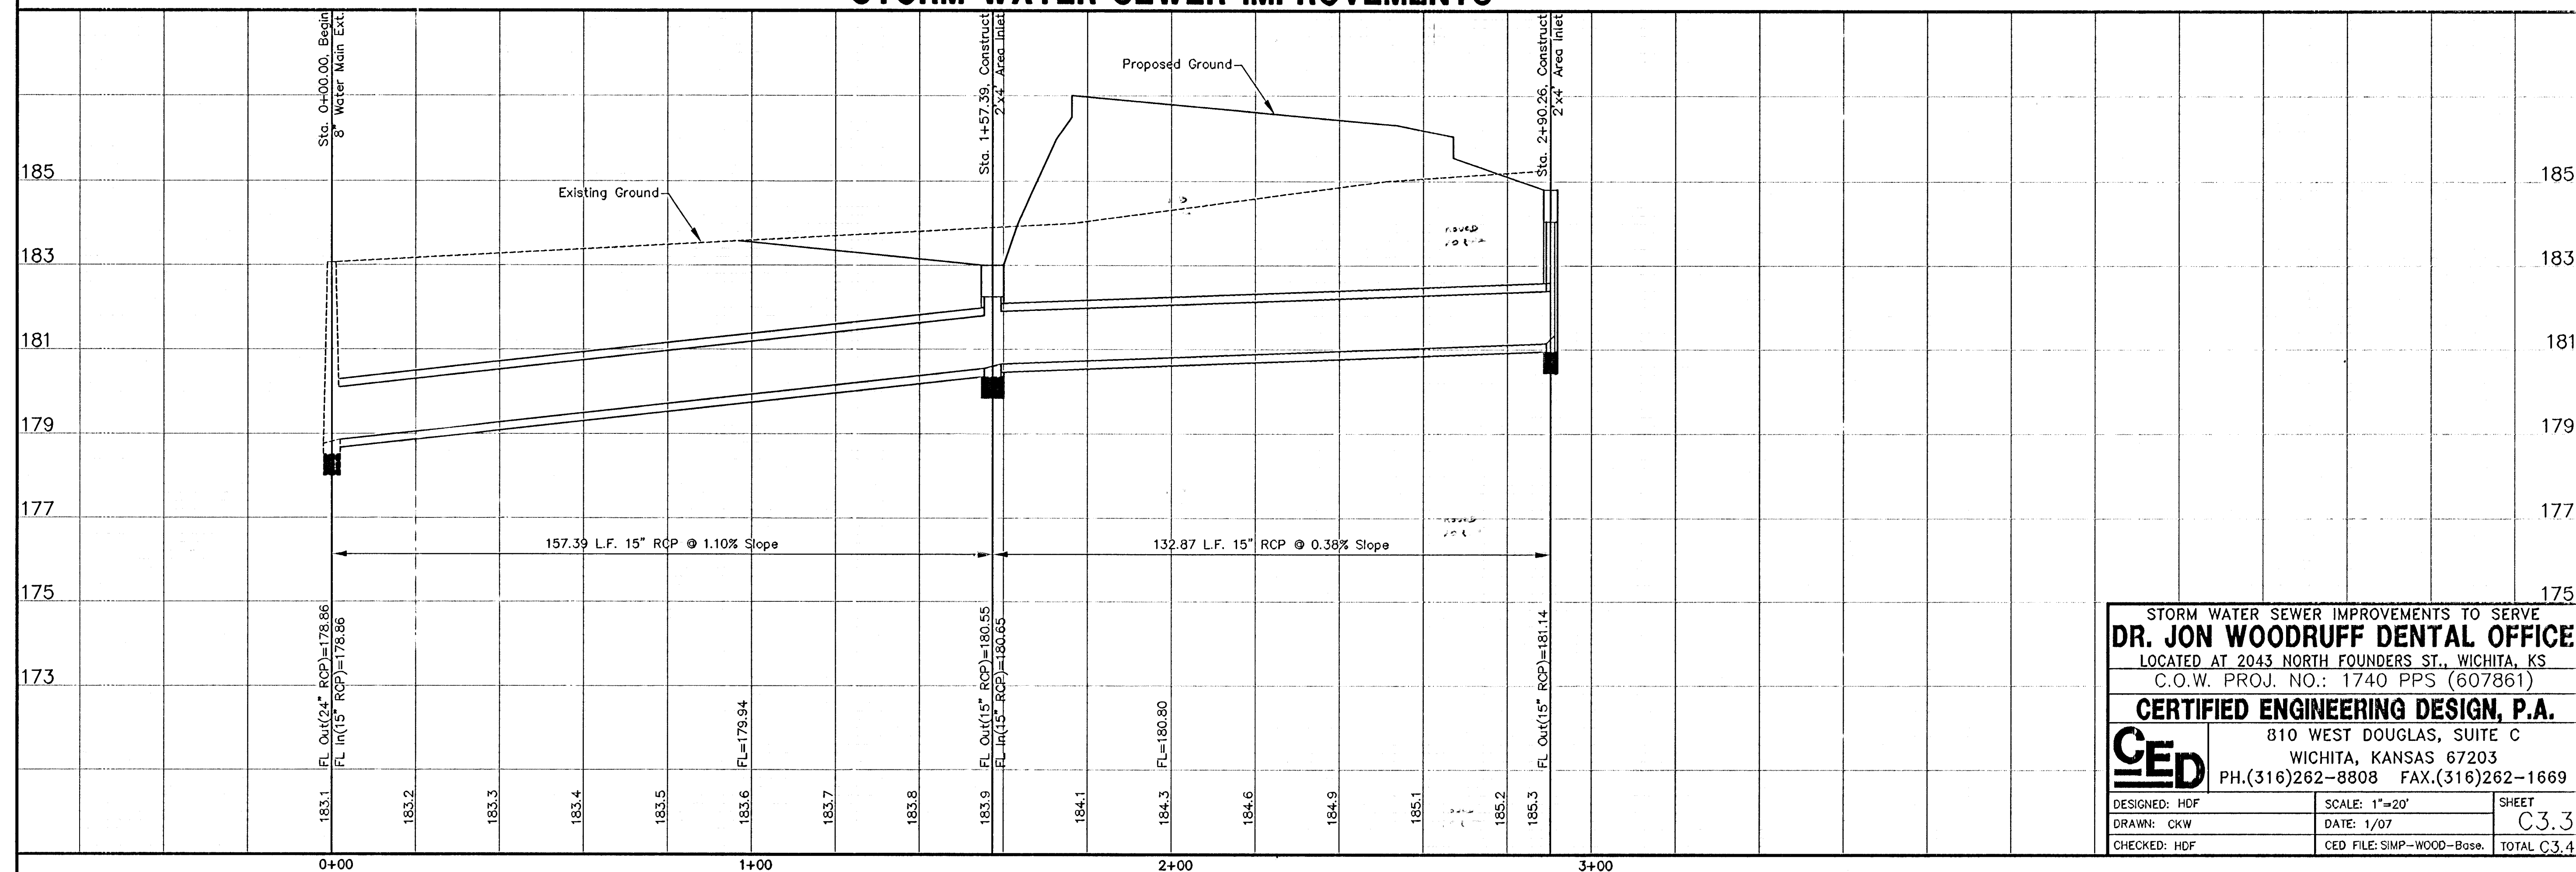

STORM WATER SEWER IMPROVEMENTS TO SERVE
DR. JON WOODRUFF DENTAL OFFICE
LOCATED AT 2043 NORTH FOUNDERS ST., WICHITA, KS
C.O.W. PROJ. NO.: 1740 PPS (607861)

CERTIFIED ENGINEERING DESIGN, P.A.

CED 810 WEST DOUGLAS, SUITE C
WICHITA, KANSAS 67203
PH.(316)262-8808 FAX.(316)262-1669

DESIGNED: HDF	SCALE: 1"=20'	SHEET C3.3
DRAWN: CKW	DATE: 1/07	
CHECKED: HDF	CED FILE: SIMP-WOOD-Bose.	TOTAL C3.4

PERMIT SET
19 JAN 07

STORM WATER
PLAN/PROFILE

C3.3