



BENCHMARK:
"□" CUT ON TOP OF CURB
AT WEST LINE OF LOT 7,
BLOCK A, AUBURN HILLS 5TH
ADD.
ELEV. = 1395.13 NGVD29

DISC IN BACK OF CURB,
NORTH OF FRONT CORNER
COMMON TO LOTS 23 AND 24,
BLOCK D, AUBURN HILLS 12TH
ADD.
ELEV. = 1379.24 NGVD29

"□" CUT ON CENTER OF
CATCH BASIN, NORTH OF LOT
CORNER COMMON TO LOTS 1
AND 15, BLOCK B, AUBURN
HILLS 14TH ADD.
ELEV. = 1381.05 NGVD29

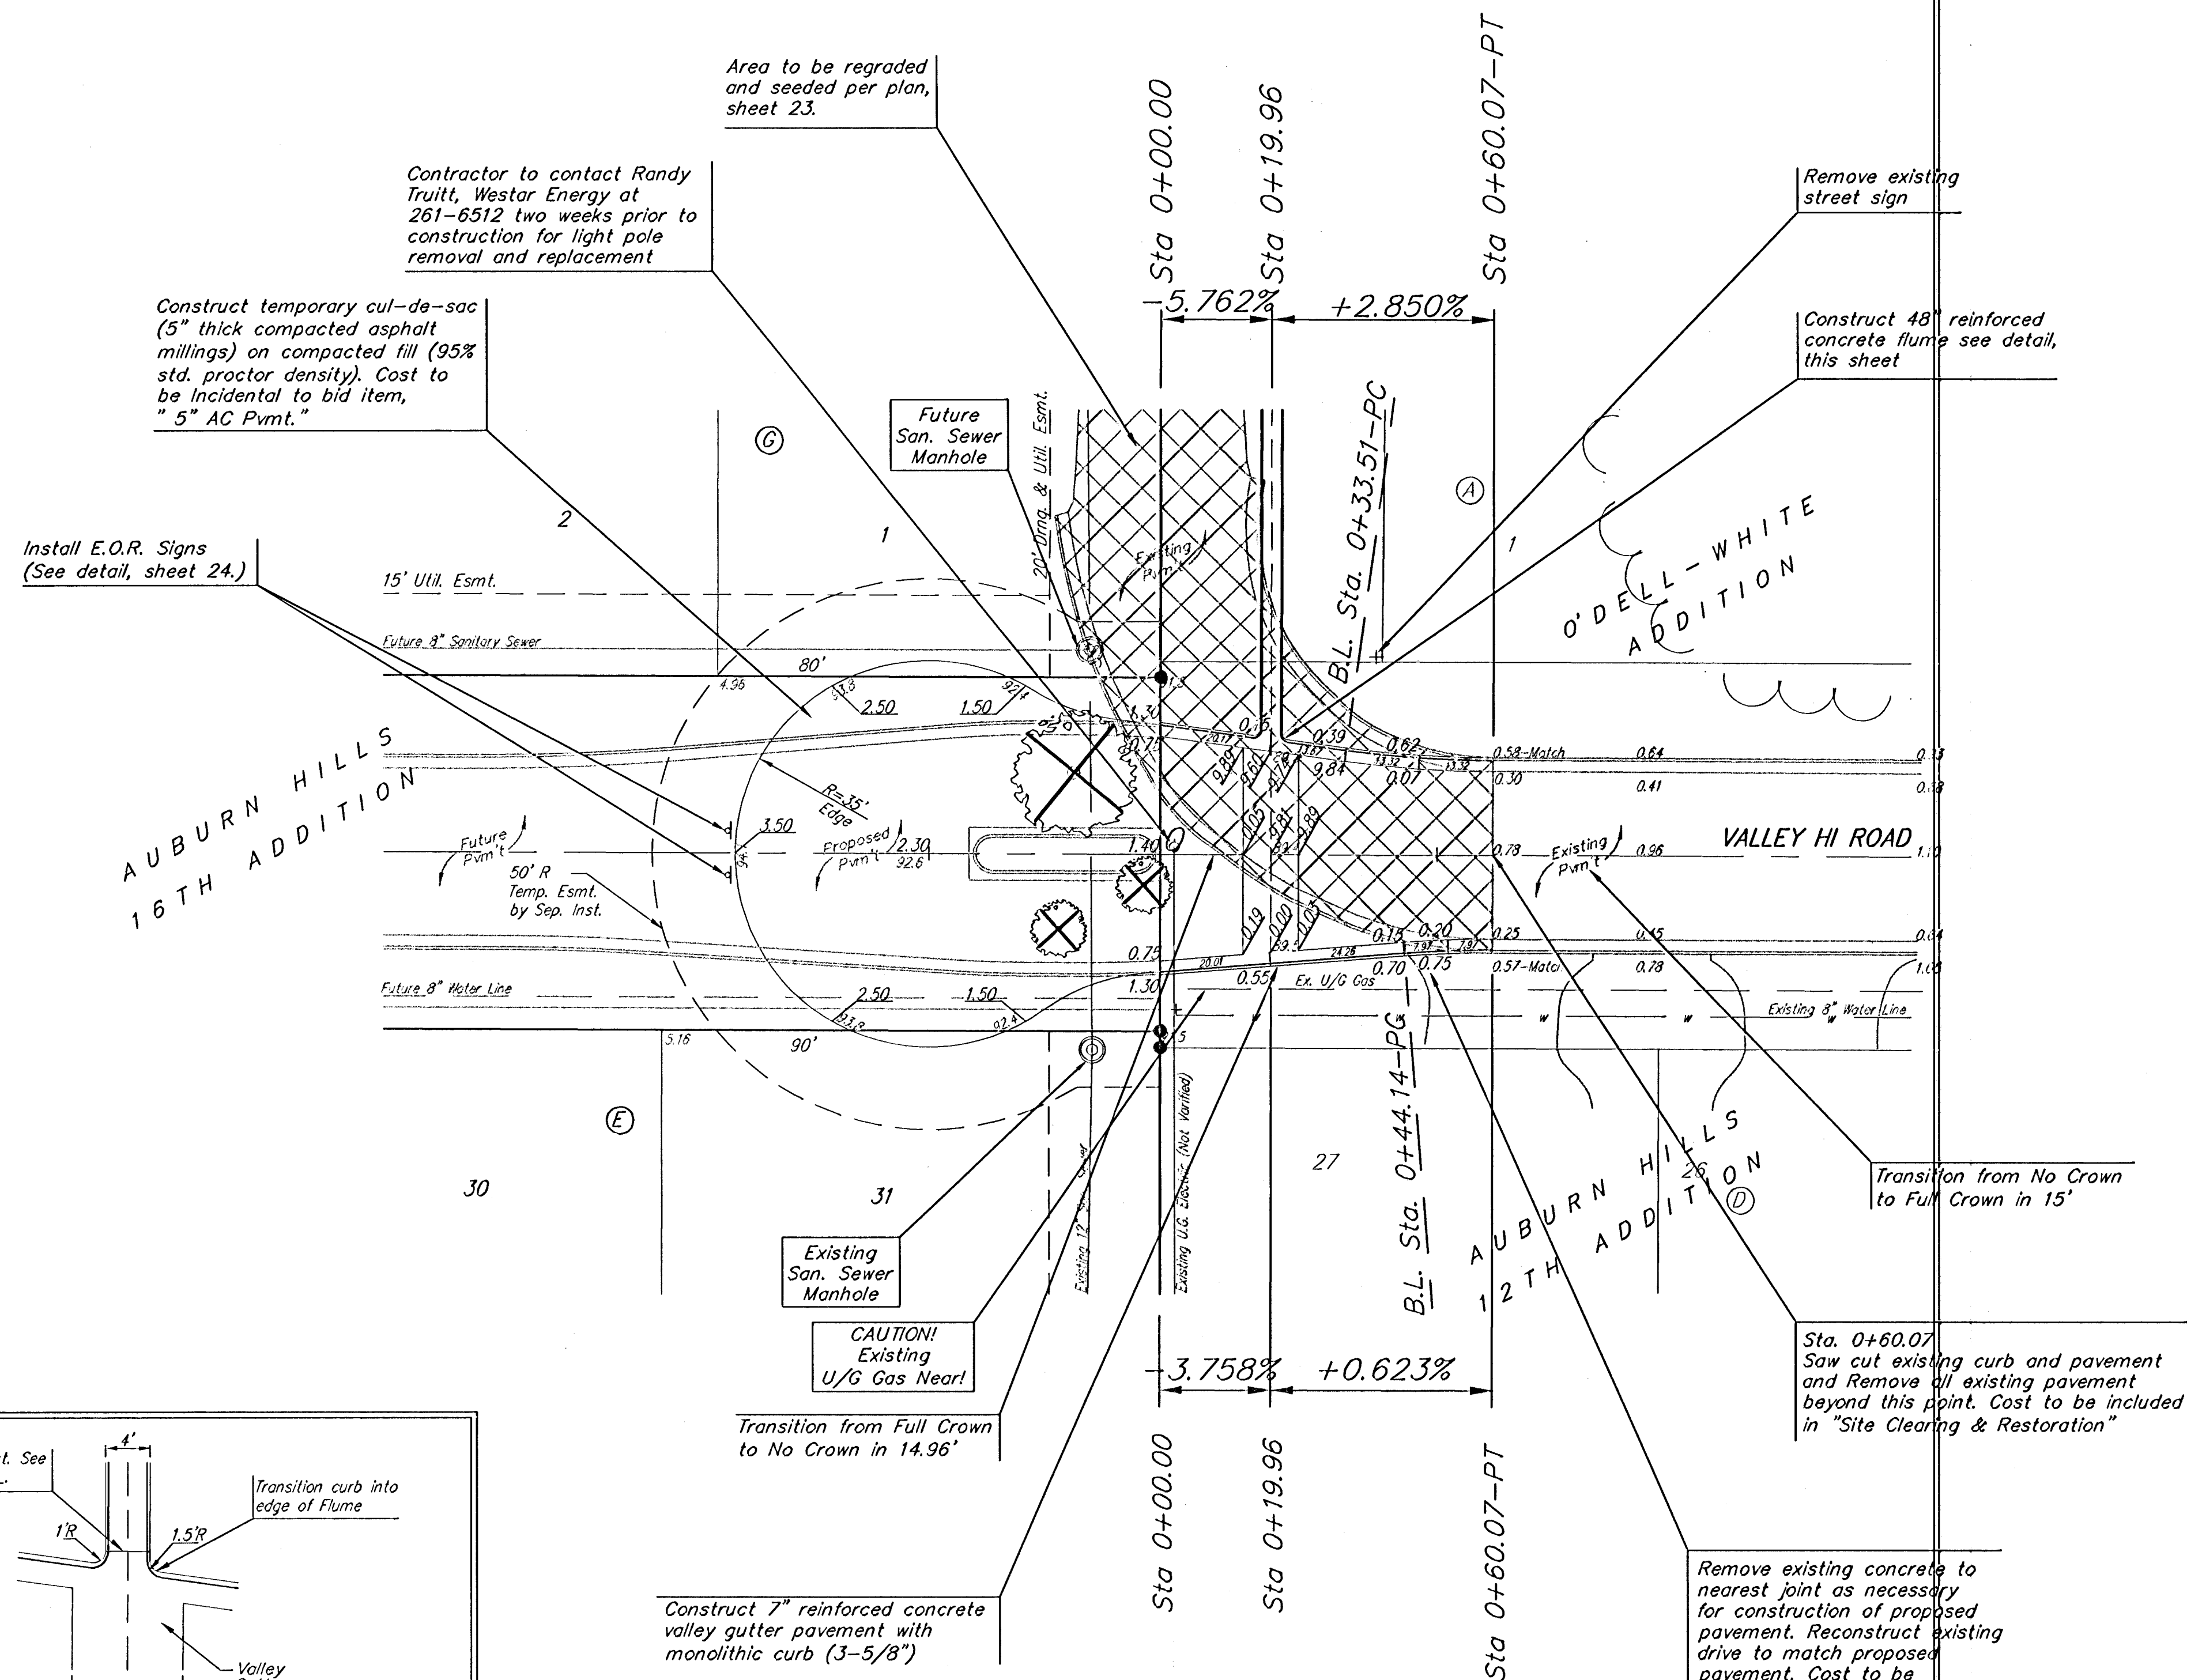

Scale: 1" = 20'
● = Iron

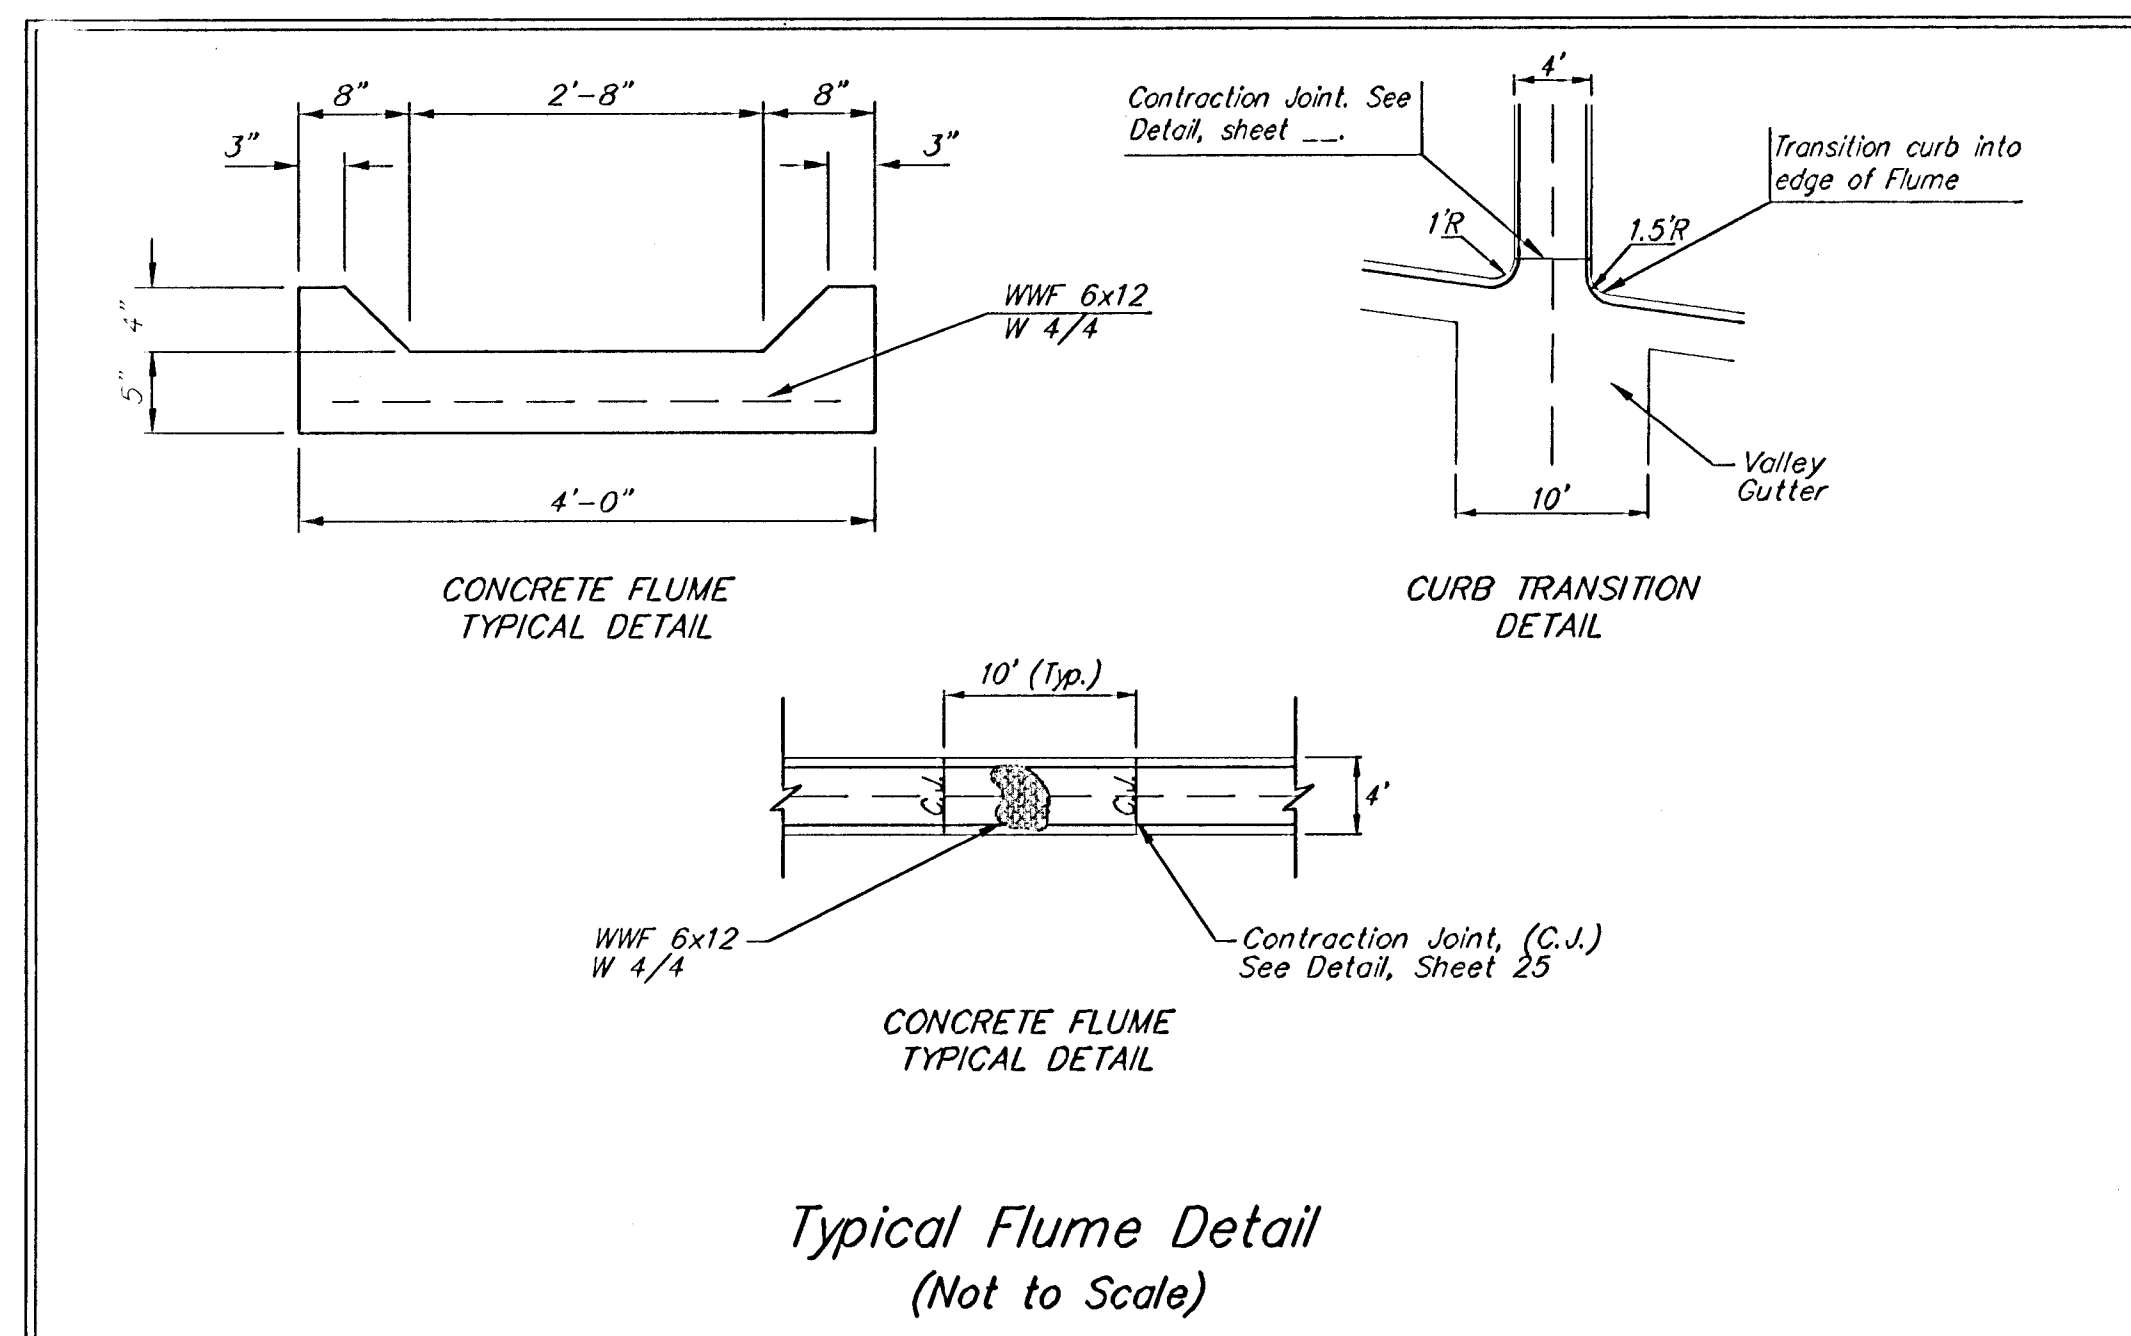

As Built 8/19/06

Baughman		Auburn Hills 16th Addition Valley Hi Road Street Plan Storm Water Drain Improvements	
Baughman Company, P.A. 315 Ellis St. Wichita, KS 67211 F316162-7771 F316162-0149 ENGINEERING SURVEYING PLANNING LANDSCAPE ARCHITECTURE			
PROJECT NUMBER 4684092	DESIGN AEG	DRAWN RDM	APPROVED DATE 03/08/2006
REVISIONS:	SCALE Noted SHEET 22 OF 47		
E:\Auburn Hills 16th\SWD\STR_L.dwg			