
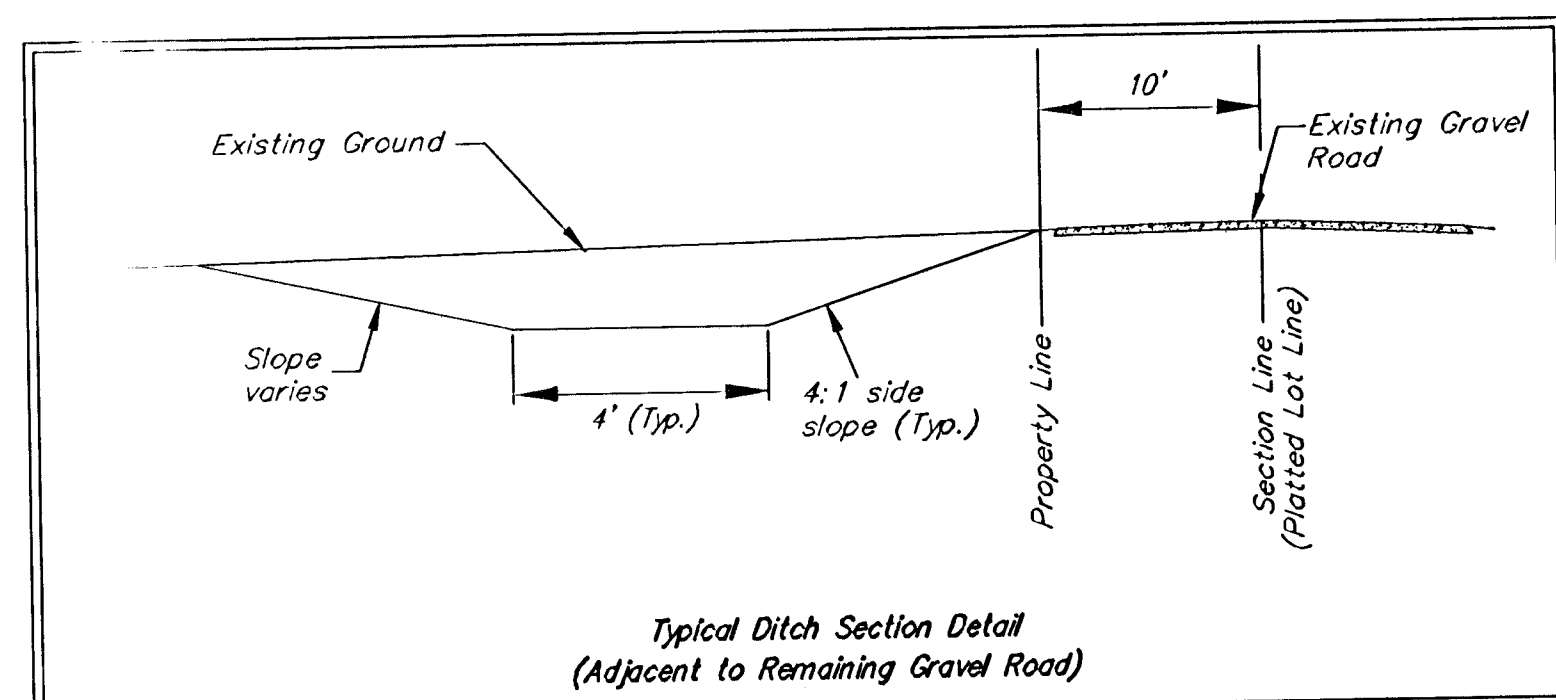


BENCHMARK:
 "□" CUT ON TOP OF CURB
 AT WEST LINE OF LOT 7,
 BLOCK A, AUBURN HILLS 5TH
 ADD.
 ELEV. = 1395.13 NGVD29


DISC IN BACK OF CURB,
 NORTH OF FRONT CORNER
 COMMON TO LOTS 23 AND 24,
 BLOCK D, AUBURN HILLS 12TH
 ADD.
 ELEV. = 1379.24 NGVD29

"□" CUT ON CENTER OF
 CATCH BASIN, NORTH OF LOT
 CORNER COMMON TO LOTS 1
 AND 15, BLOCK B, AUBURN
 HILLS 14TH ADD.
 ELEV. = 1381.05 NGVD29

Scale: 1" = 20'
 ● = Iron

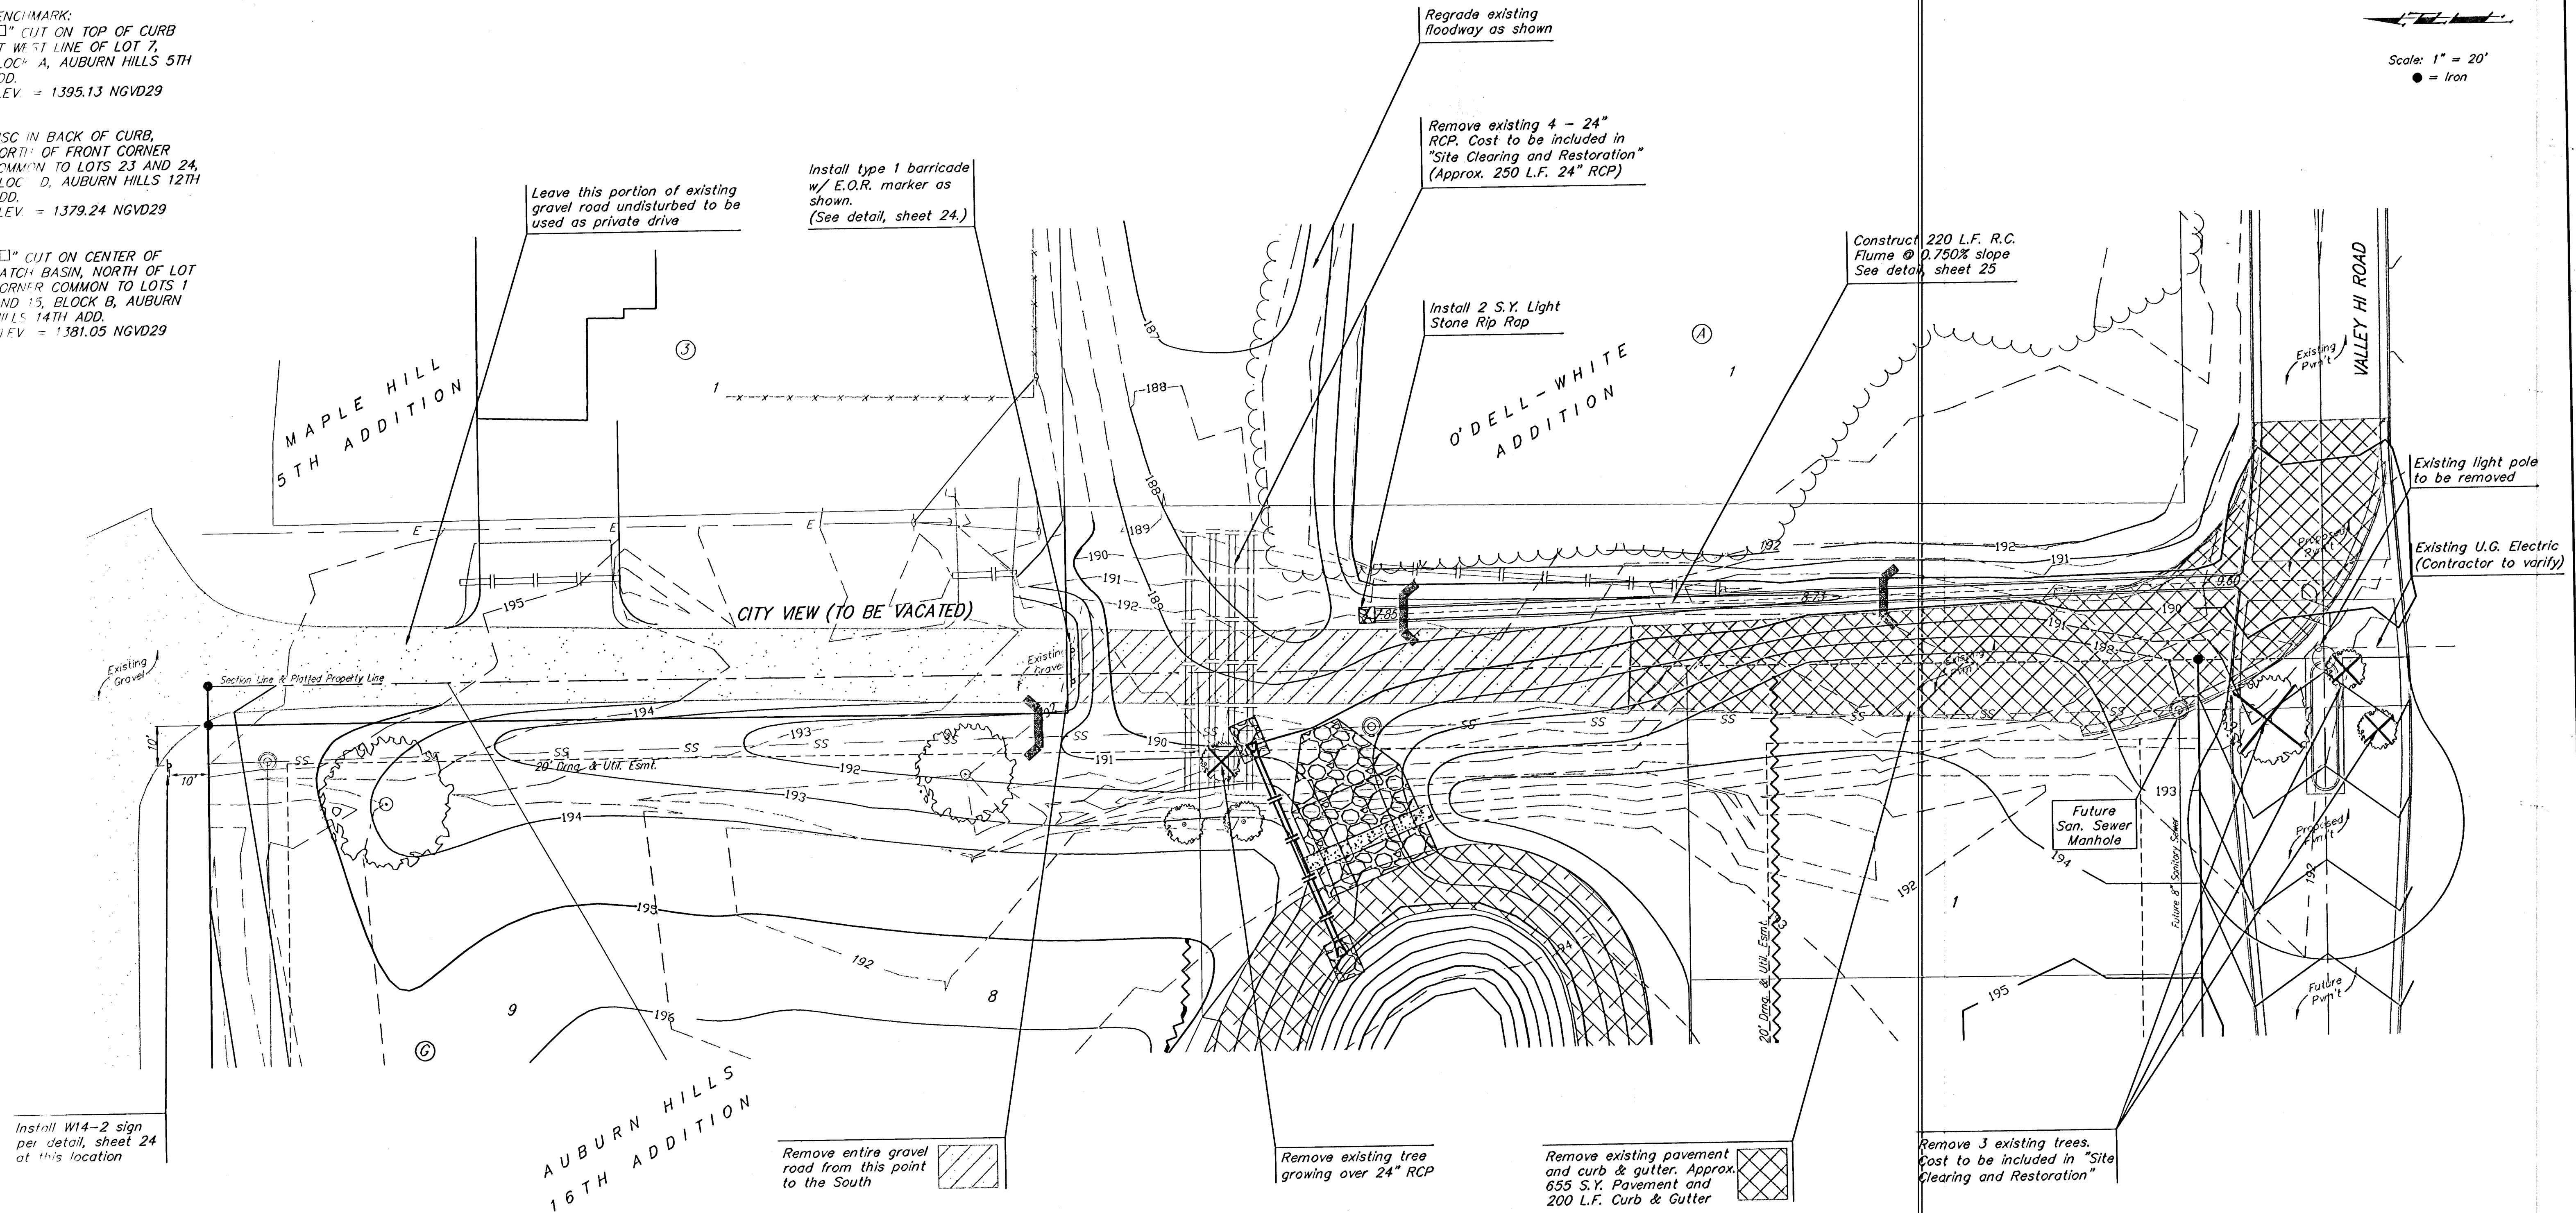

Remove trees only as necessary for street construction and only with permission of Developer or Baughman Co. Cost of removal to be incidental to lump sum bid item "Site Clearing & Restoration".

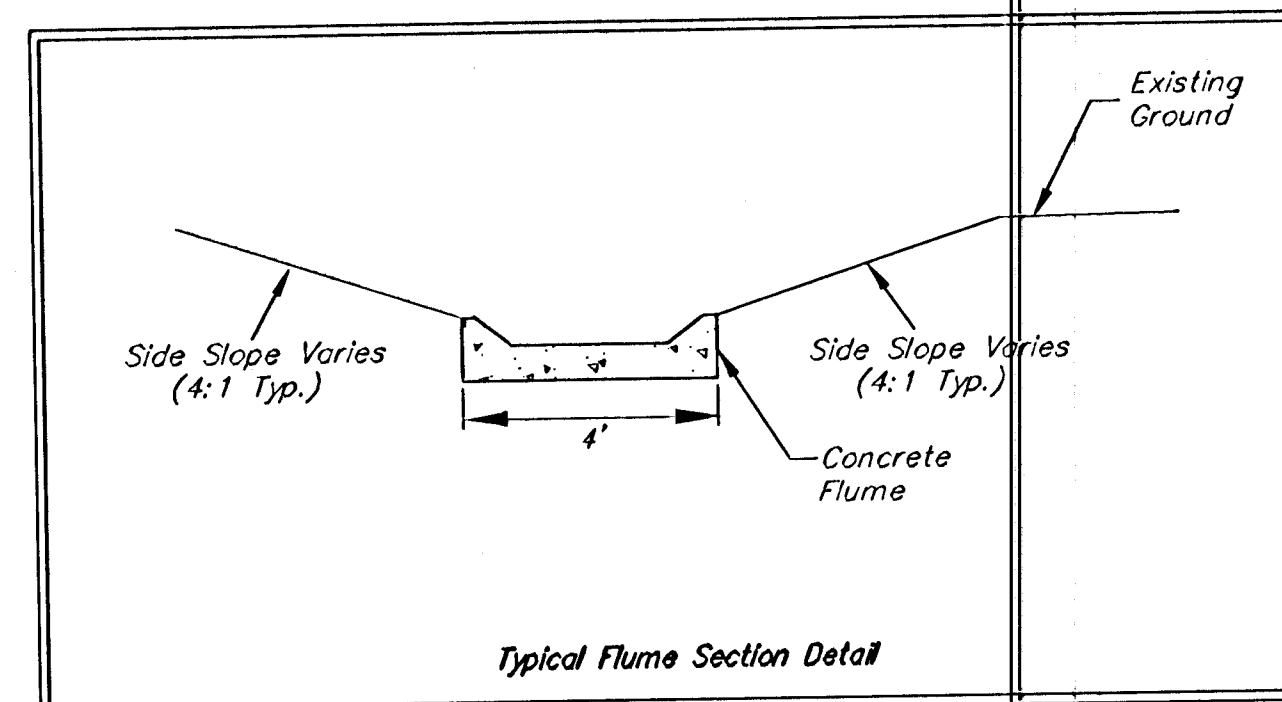

As Built 8/14/16 KK

Baughman

Auburn Hills 16th Addition
City View Street Closure Plan
 Storm Water Drain Improvements

Baughman Company, P.A. 315 Elm St. Woburn, MA 01801 P: 316.563.1211 F: 316.563.0149
 ENGINEERING | SURVEYING | PLANNING | LANDSCAPE ARCHITECTURE

PROJECT NUMBER
 46884092

DESIGN
 AEG

DRAWN
 RDM

APPROVED
 DATE
 03/08/2006

REVISIONS

SCALE
 Noted

SHEET
23 OF 47

E:\Auburn Hills 16th\SWD\Mass_7.dwg