

# PRIVATE STORM WATER SEWER EXTENSION

TO SERVE

## ETHANOL PRODUCT CORP HEADQUARTERS


PRIVATE PROJECT NO. 1750 PPS (607861)

## CITY OF WICHITA, KANSAS

JAMES L. ARMOUR, P.E. - CITY ENGINEER

### INDEX OF SHEETS

SHEET NO. C2.1	TITLE SHEET
SHEET NO. C2.2	KEY MAP AND GENERAL NOTES
SHEET NO. C2.3	PLAN/PROFILE SWS LINE NO. 1
SHEET NO. C2.4	PLAN/PROFILE SWS LINE NOS. 2 & 3
SHEET NO. C2.5	TYPE 1A CURB INLET DETAILS
SHEET NO. C2.6	STANDARD AREA INLET DETAILS
SHEET NO. C2.7	TYPE C INLET DETAILS
SHEET NO. C5.2-5.4	SOIL EROSION BMP DETAILS
SHEET NO. C6.1	PLAT
SHEET NO. C6.2	TYPE "P" MANHOLE DETAILS
SHEET NO. C6.3	FRAME & COVER DETAILS

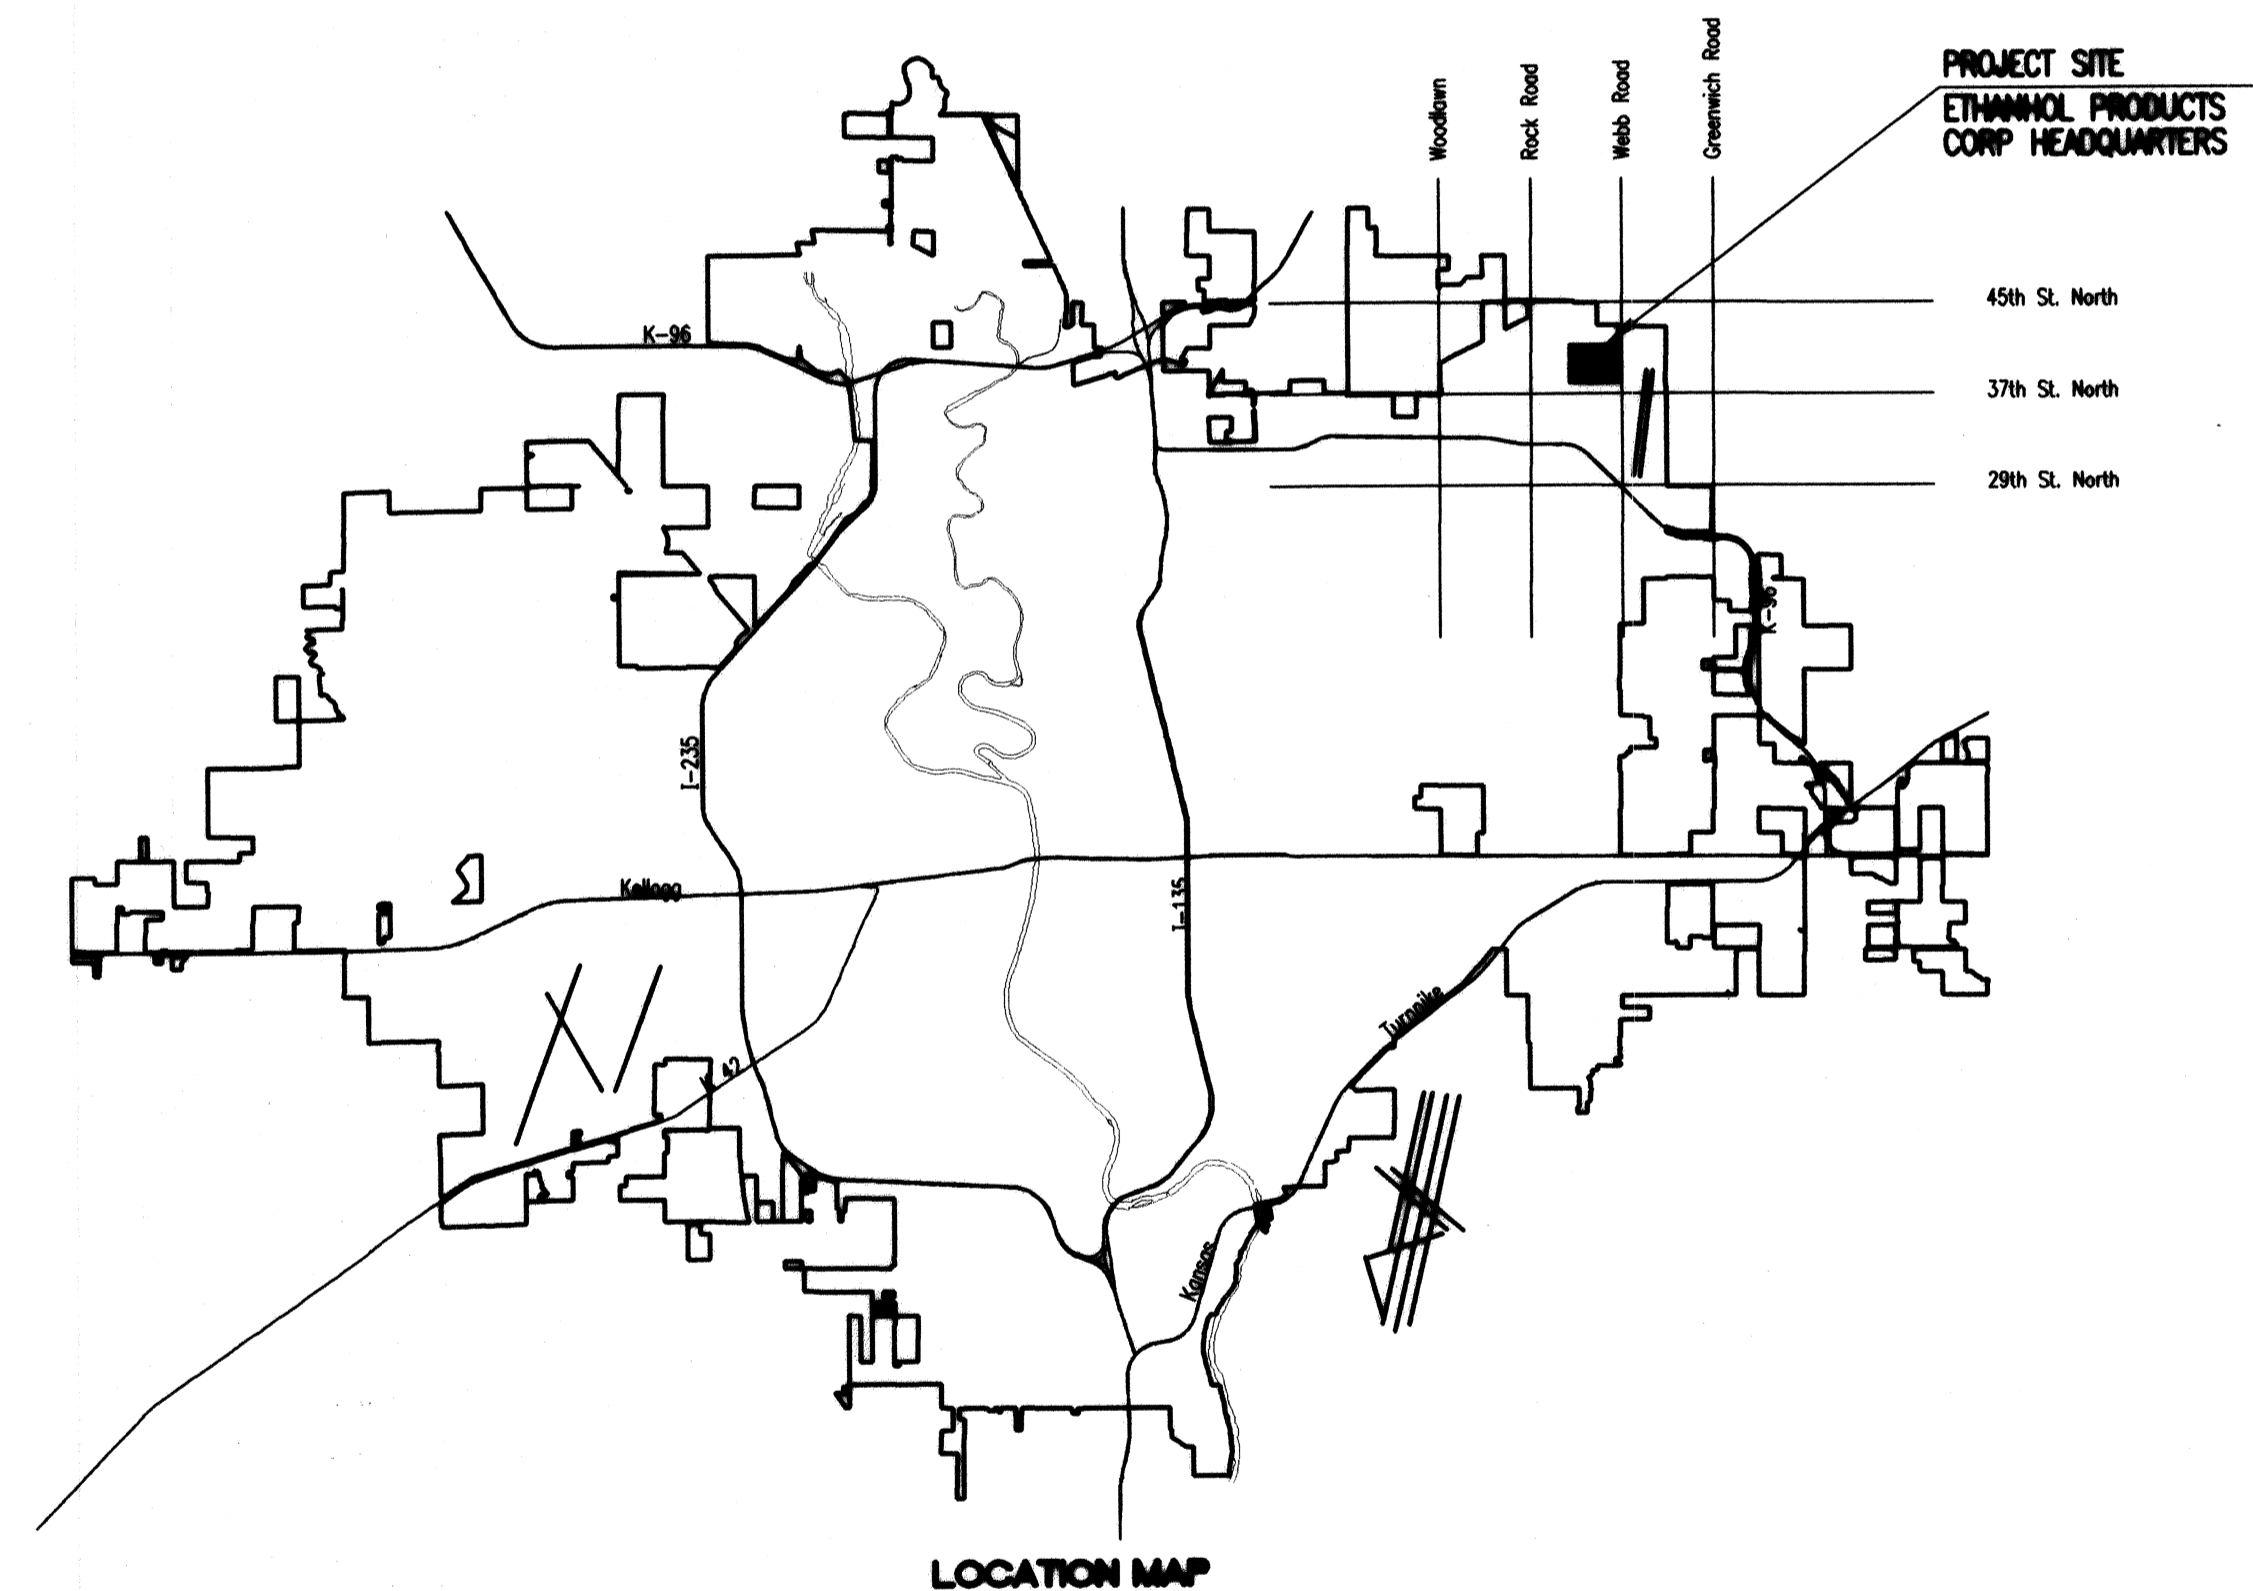

**AS-BUILT**  
9/7/07  
Date  
Signature  
Signed


APPROVED AS NOTED  
By CITY ENGINEER OF WICHITA

Sanitary Sewers \_\_\_\_\_  
Storm Sewers VRH 3/8/07  
Driveway Approaches \_\_\_\_\_  
Paving \_\_\_\_\_

**NOTE TO CONTRACTOR**

INSPECTION AND TESTING FOR THIS PROJECT IS TO BE PROVIDED BY A LICENSED CONSULTING ENGINEERING FIRM CONTRACTED BY THE OWNER/DEVELOPER. SAID INSPECTION TO BE IN ACCORDANCE WITH THE CITY OF WICHITA STANDARD CONSTRUCTION ENGINEERING PRACTICES AND CERTIFIED BY A LICENSED PROFESSIONAL ENGINEER. NO WORK SHALL BE PERFORMED IN DEDICATED EASEMENTS OR PUBLIC RIGHT-OF-WAY BY THE CONTRACTOR UNTIL SUCH INSPECTION IS ARRANGED FOR AND REQUIRED BONDS HAVE BEEN SUBMITTED TO AND APPROVED BY THE CITY. NOR SHALL ANY WORK BE COMMENCED IN DEDICATED EASEMENTS OR PUBLIC RIGHT-OF-WAY WITHOUT WRITTEN AUTHORIZATION BY THE CITY ENGINEER. IMPROVEMENTS PERFORMED UNDER THIS PROJECT SHALL NOT BE ACCEPTED BY THE CITY UNTIL ALL APPLICABLE DOCUMENTATION HAS BEEN SUBMITTED TO THE CITY ENGINEER. THIS MAY INCLUDE: RECORD DRAWINGS, INSPECTION LOGS, TEST DOCUMENTATION, TV TAPES, AND A CERTIFICATE OF COMPLETION. THE ABOVE SHALL BE PERFORMED BY THE CONSULTING FIRM CONTRACTED TO INSPECT THIS PROJECT.

**MARCH 2007**  
PLANS PREPARED BY  
**PROFESSIONAL ENGINEERING CONSULTANTS, P.A.**  
ENGINEERS  
WICHITA, KANSAS

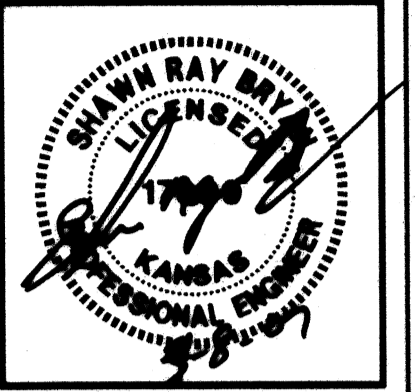

**Ethanol Products  
Corporate Headquarters**  
38th and Webb Road  
Wichita, Kansas

prints issued  
3-9-07  
For Construction

project no.  
06122

PRIVATE STORM  
WATER SEWER  
TITLE SHEET  
**C2.1**  
of

Save: 03-08-2007 1:13:50 PM by SW  
Plot Scale: 1:1 03-08-2007 1:29:52 PM by SW  
Q:\2006\06567\Site C\Private Plans\Storm Water Sewer\06567-C2.1-PPSTITLE