


VAC2009-23

VIA CHRISTI - WEST CAME
SEDGWICK COUNTY, KAN



DOC # 714-PG: 28012703
 Received 12/9/2006 10:50:08 AM

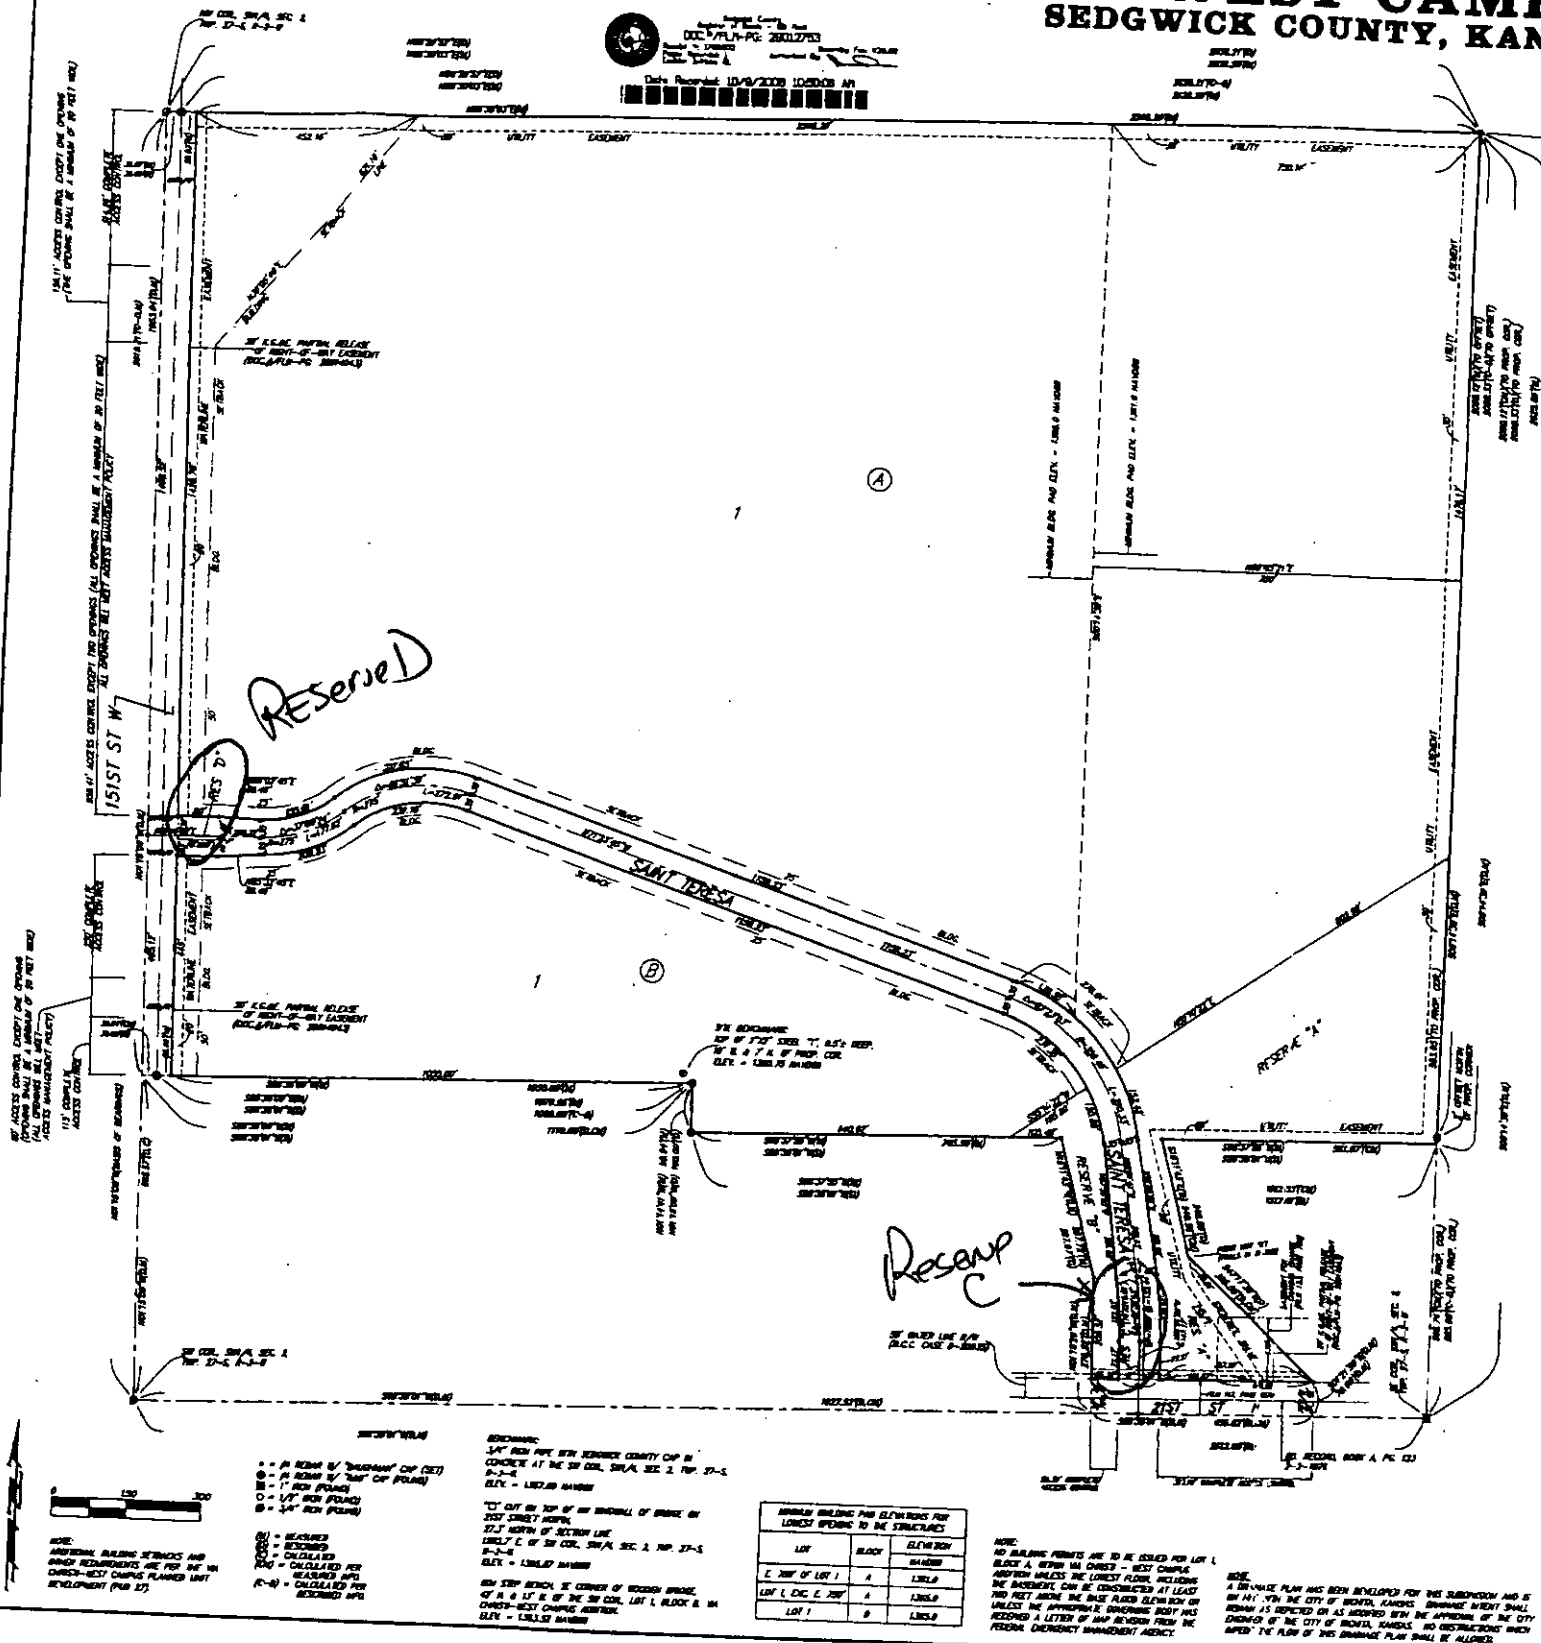

MINIMUM BUILDING PAD ELEVATIONS FOR LOWEST OPENING TO THE STRUCTURES		
LOT	BLOCK	ELEVATION
		MINIMUM
E. 200' OF LOT 1	A	1,215.0
LOT 1, EXC. E. 200'	A	1,205.0
LOT 1	B	1,195.0