


ALL SOUTH Broadway Industrial Park Add

H-1 3-23

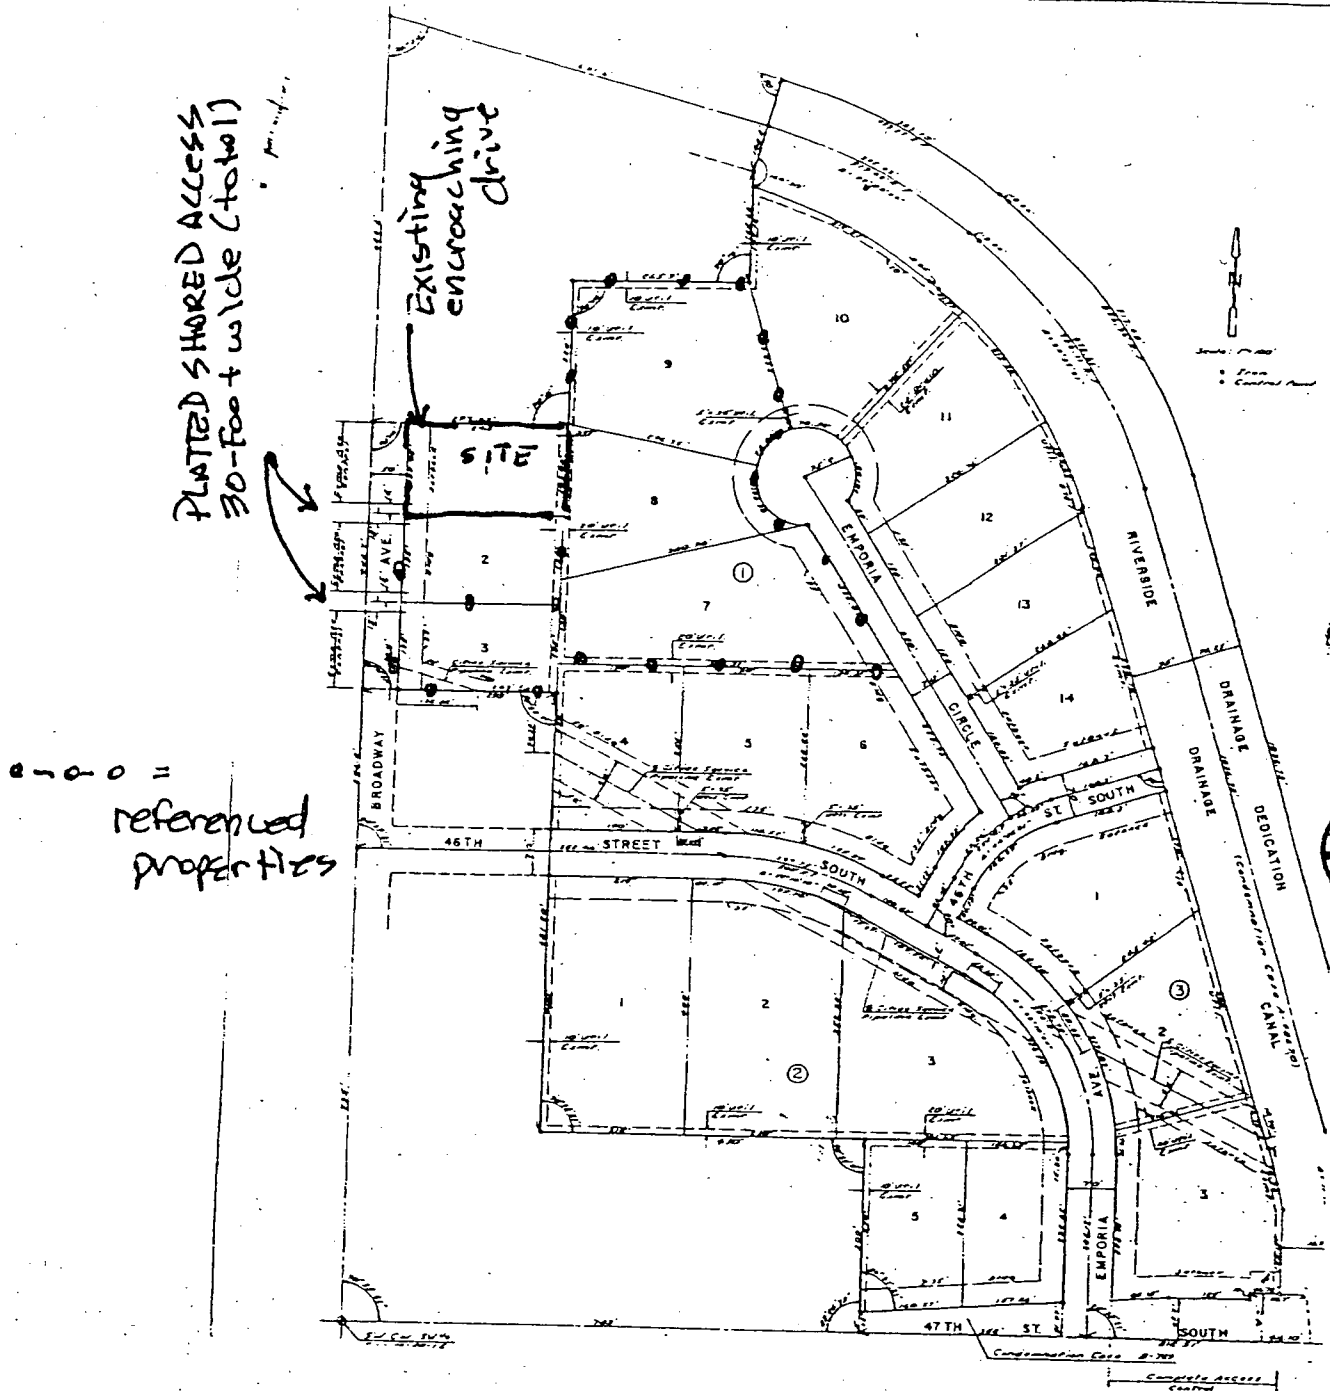

VAC2010-40