

 Note: All front and side set-backs are 30 feet.
 1448.231'

PROPERTY LINE

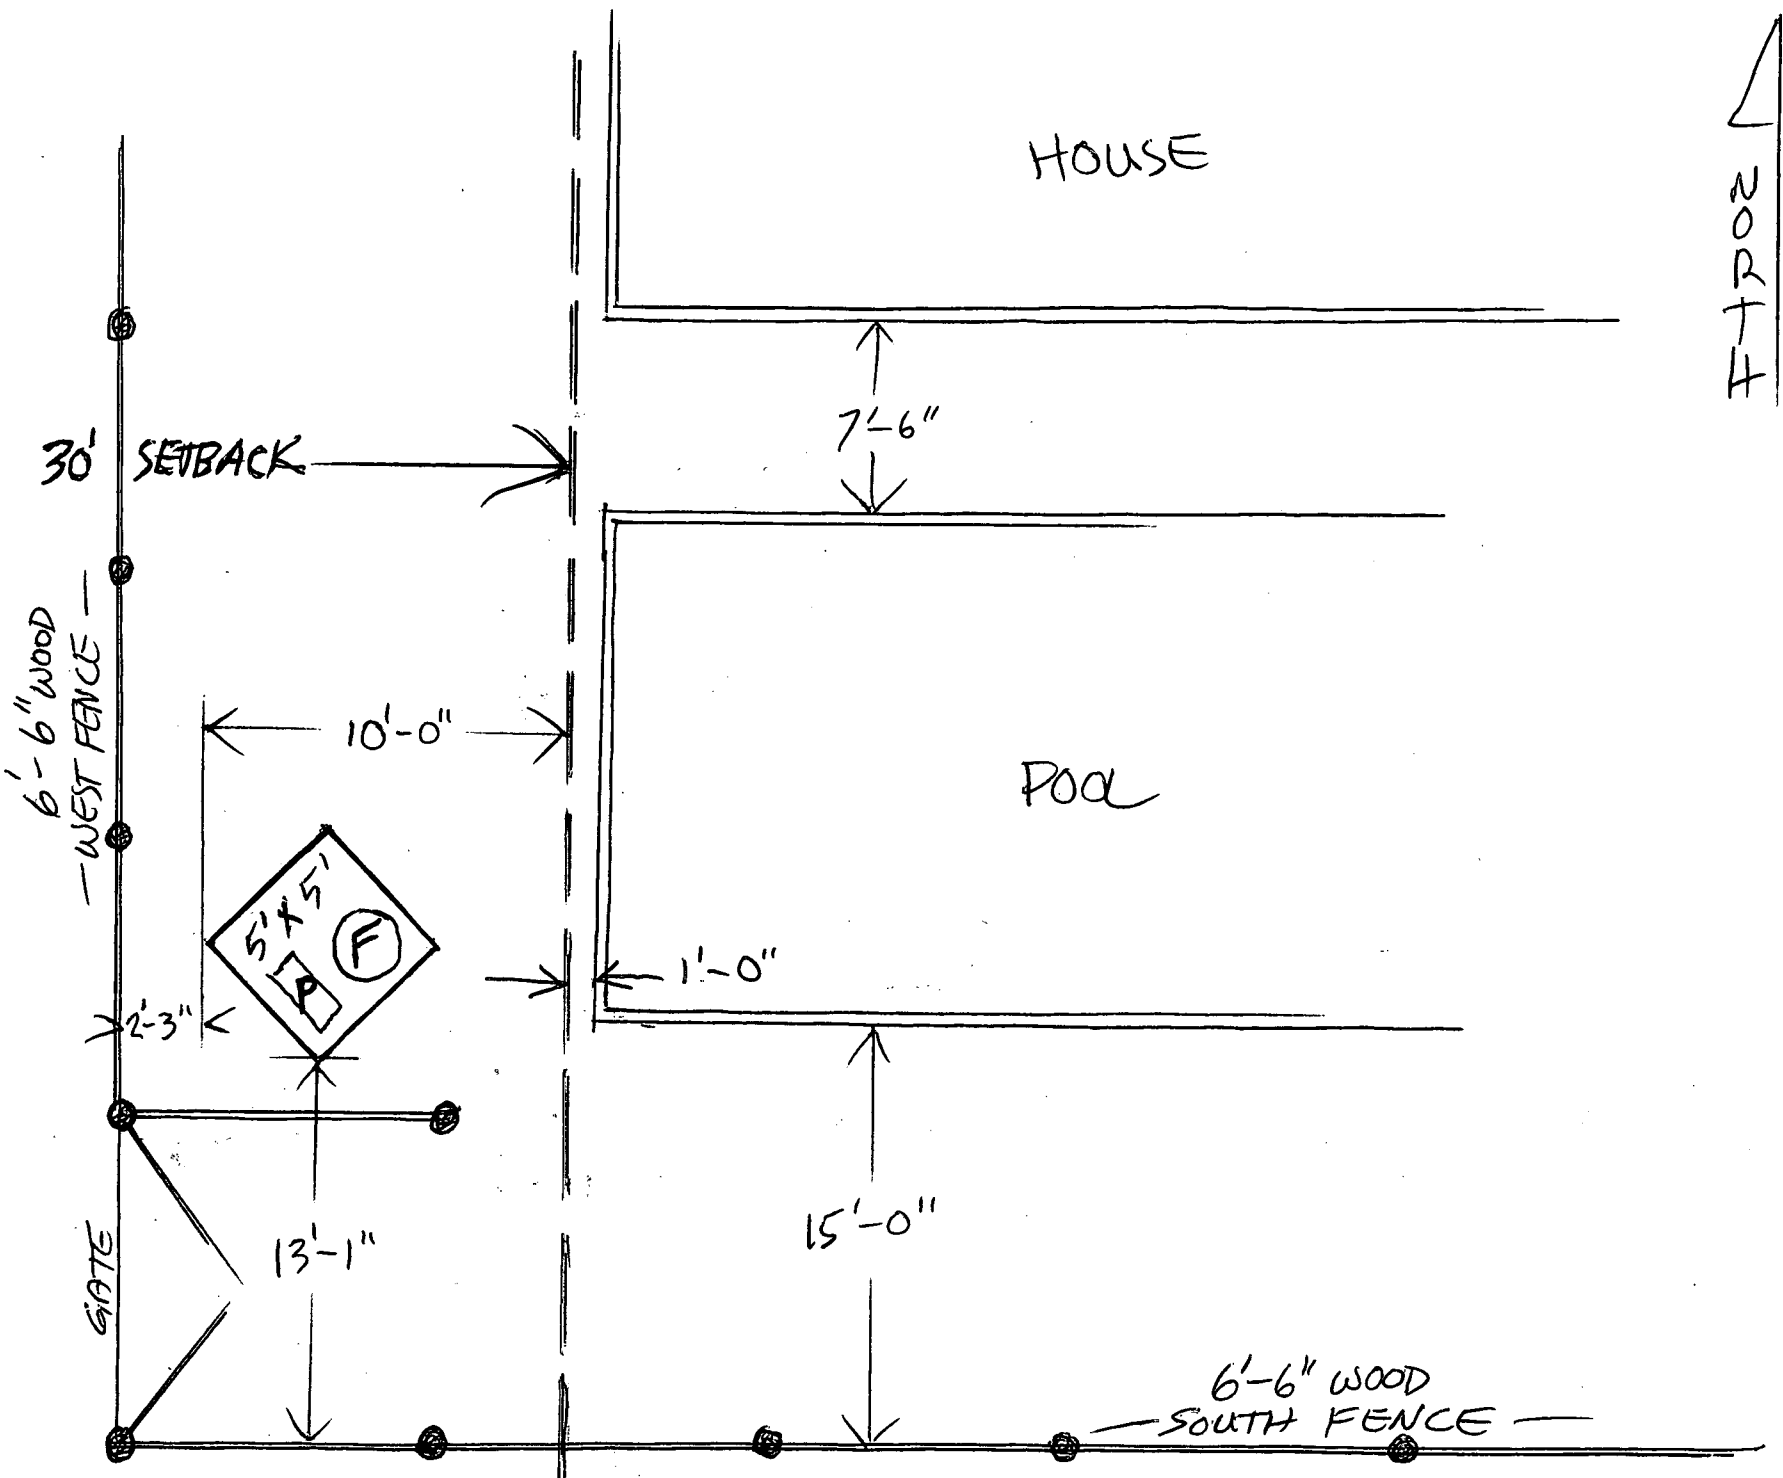

↑ NORTH

30' SETBACK


6'-6" WOOD WEST FENCE

2'-3"

GATE

13'-1"

10'-0"

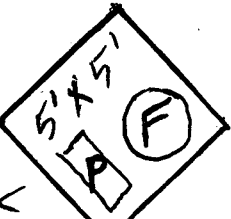

7'-6"

1'-0"

15'-0"

6'-6" WOOD SOUTH FENCE


HOUSE

POOL

26th STREET

N
S
E
W

CLARENCE STREET

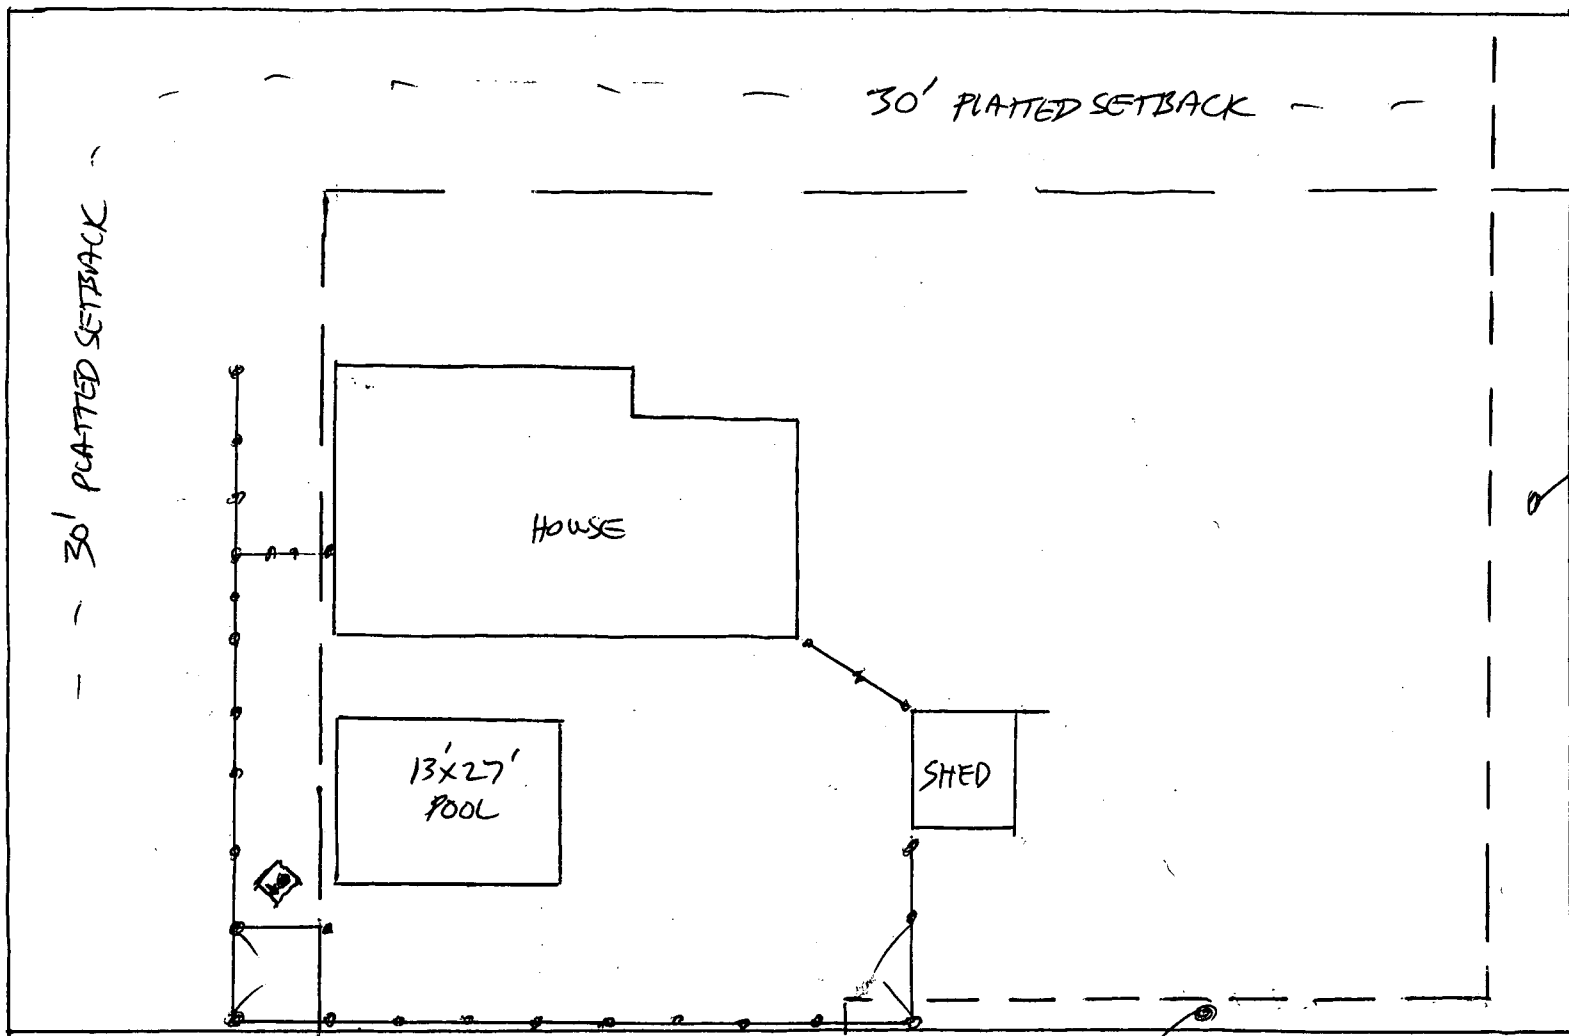

30' PLATTED SETBACK

30' PLATTED SETBACK

HOUSE

13'x27'
POOL

SHED

8' EASEMENT

5' EASEMENT

BUD 2012
-01600



30' PLOTTED
RAZOR SETBACK

CLARENCE

PLOTTED
30' RAZOR
SETBACK

26th ST

218.75'

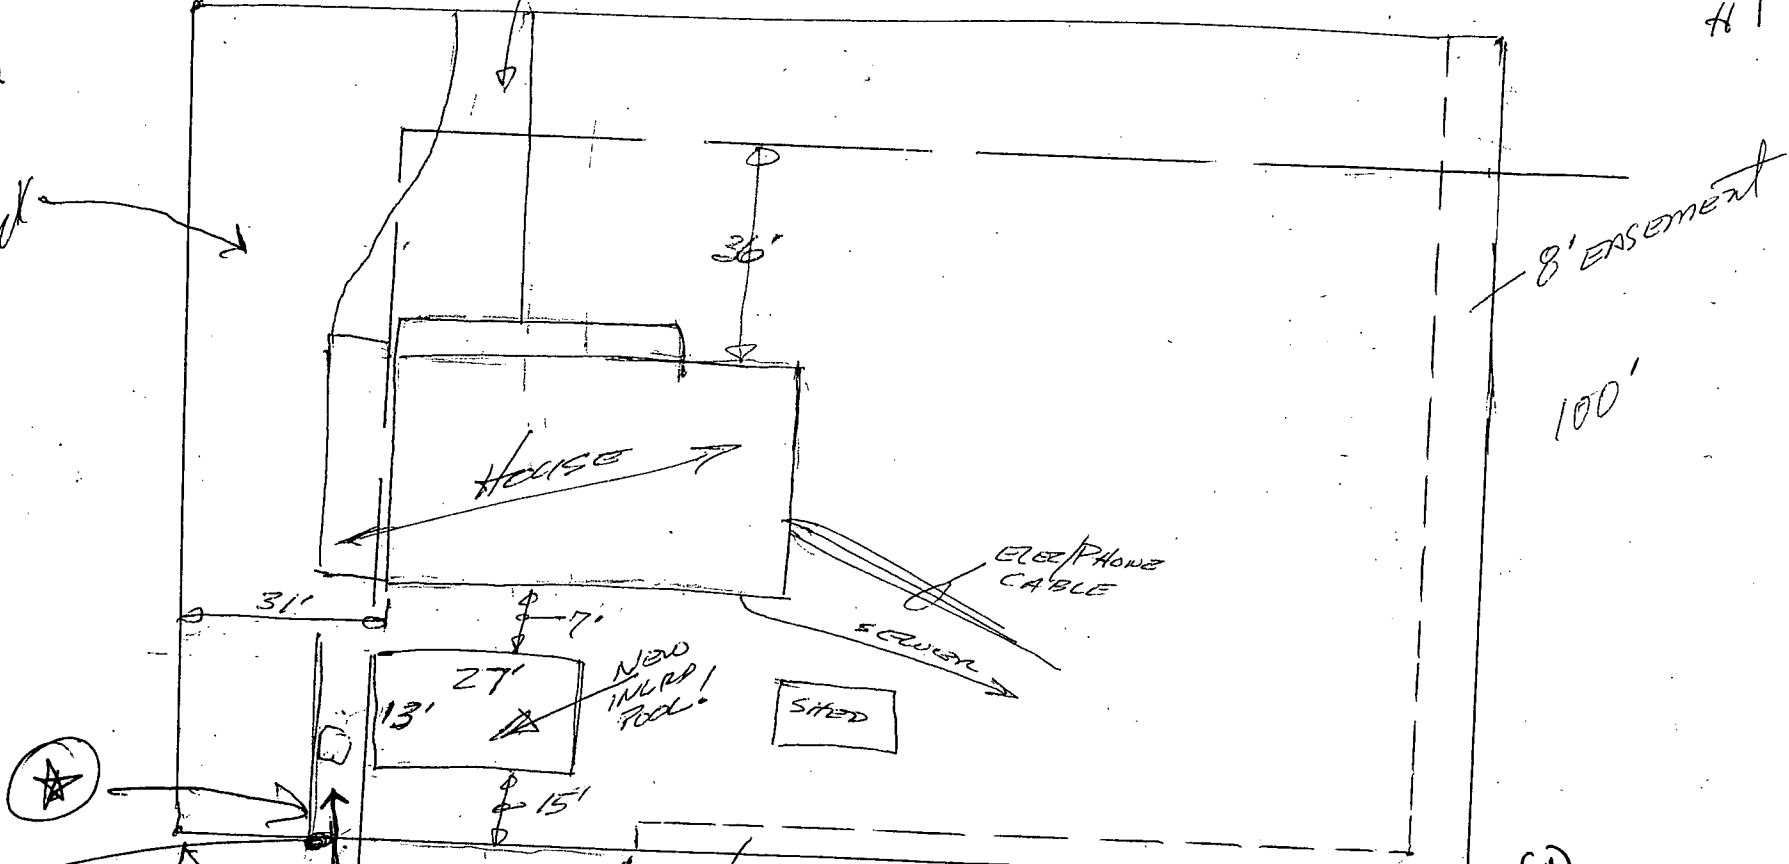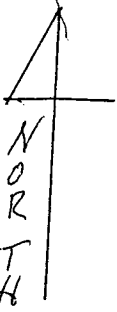

8' EASEMENT

100'

HOUSE

ELECT/PHONE
CABLE

SEWER

NEW
INFLAT
POOL

SHED

Show

by deminism where

at = how far into front setback

5' EASEMENT

Show/call out 6' tall

wooden fence

15TH is where wood fence located on south side of 1931 w 26th ST
ends?
if so, 50' 50'

Lot 7 Block 3

NORTHWEST GARDENS ADDN

13 JUNE 2012