



Wichita-Sedgwick County Metropolitan Area Planning Department

CORRECTED

February 22, 2017

~~February 13, 2017~~

MKEC Engineering Inc.
Attn: Brian Lindebak
411 N. Webb Rd.
Wichita, KS 67206

Ref: VAC2016-00041 - City request to vacate portions of a platted setback, platted drainage easement and platted utility easement on property generally located east of Rock Road, north of 21st Street North on the east side of Tallgrass Street.

Dear Mr. Lindebak:

At its regular meeting on Tuesday, January 3, 2017, the Wichita City Council considered the above-referenced request. The action of the City Council was to **APPROVE** subject to the recommendation by the MAPC.

If you have any questions about this matter, please call 268-4421.


Sincerely,

A handwritten signature in cursive script that reads 'Stephen M. Banks'.

Stephen Banks
Senior Planner


SB:klw

cc: Perfection Builders LLC, c/o Scott Lehner, 11828 W Central Av, Ste 112, Wichita KS 67212

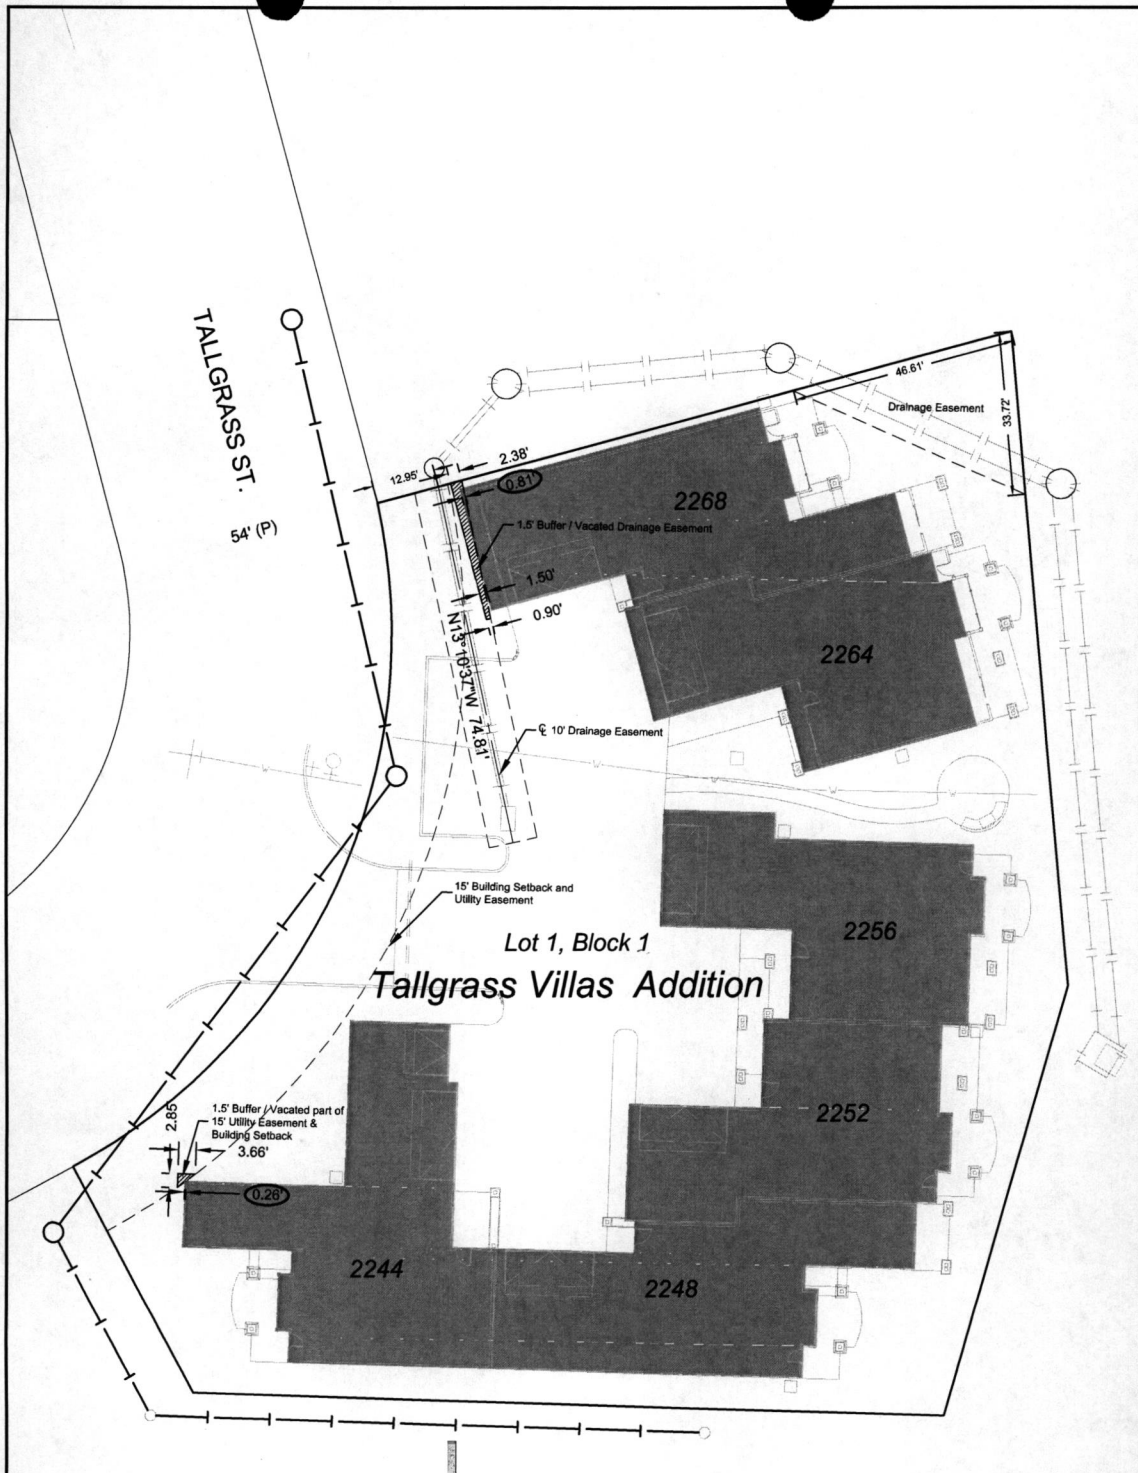

Lot 1, Block 1
Tallgrass Villas Addition

VAC2016-41

 - Vacated Tracts



©2016
MKEC Engineering
All Rights Reserved
www.mkec.com
These drawings and their contents, including, but not limited to, all concepts, designs, & ideas are the exclusive property of MKEC Engineering (MKEC), and may not be used or reproduced in any way without the express consent of MKEC.



VACATION EXHIBIT VAC2016-000 TALLGRASS VILLAS ADDITION		
PROJECT NO. 1301010787	DATE: AUGUST 2016	SHEET NO.
DRAWN BY: JGD	DESIGNED BY: BDL	APPROVED BY: BDL
		1 OF 1

J:\PROJECTS\2016\1301010787_PREFERENCE - TALLGRASS_VILLAS_ADDITION\1301010787_PREFERENCE - TALLGRASS_VILLAS_ADDITION\1301010787_PREFERENCE.dwg