
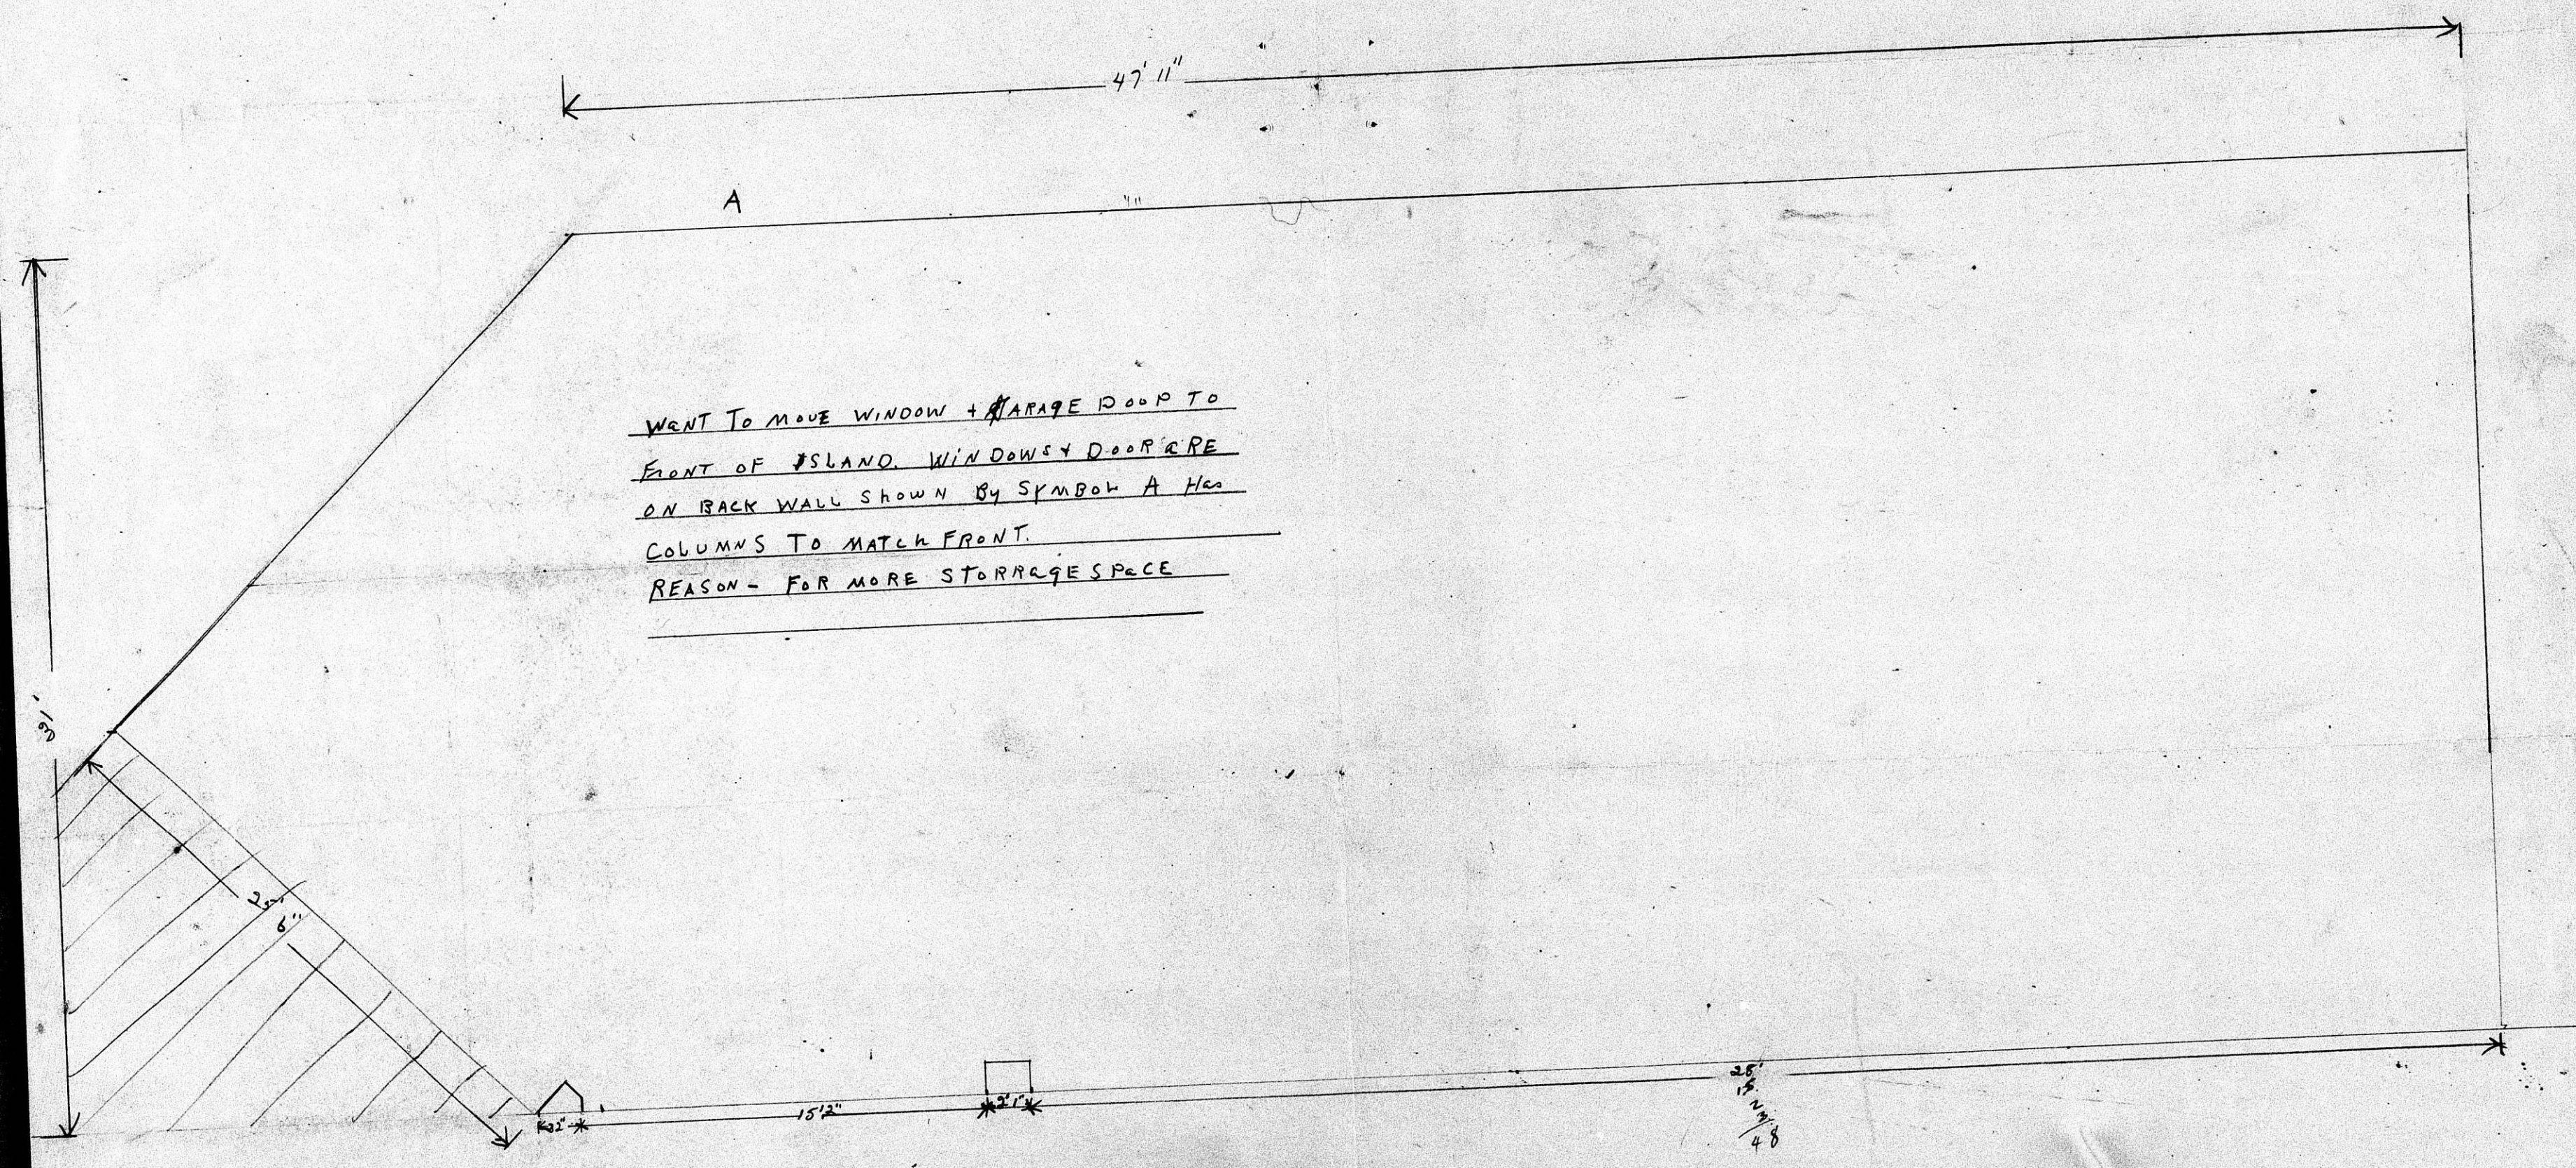


7-51

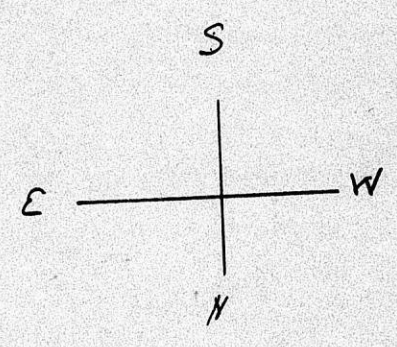

WENT TO MOVE WINDOW + GARAGE DOOR TO  
 FRONT OF ISLAND WINDOW DOOR ARE  
 ON BACK WALL SHOWN BY SYMBOL A HAS  
 COLUMNS TO MATCH FRONT  
 REASON - FOR MORE STORAGE SPACE

212

7-51

