


LANGE SENECA STREET INDUSTRIAL PLANNED UNIT DEVELOPMENT PUD #46

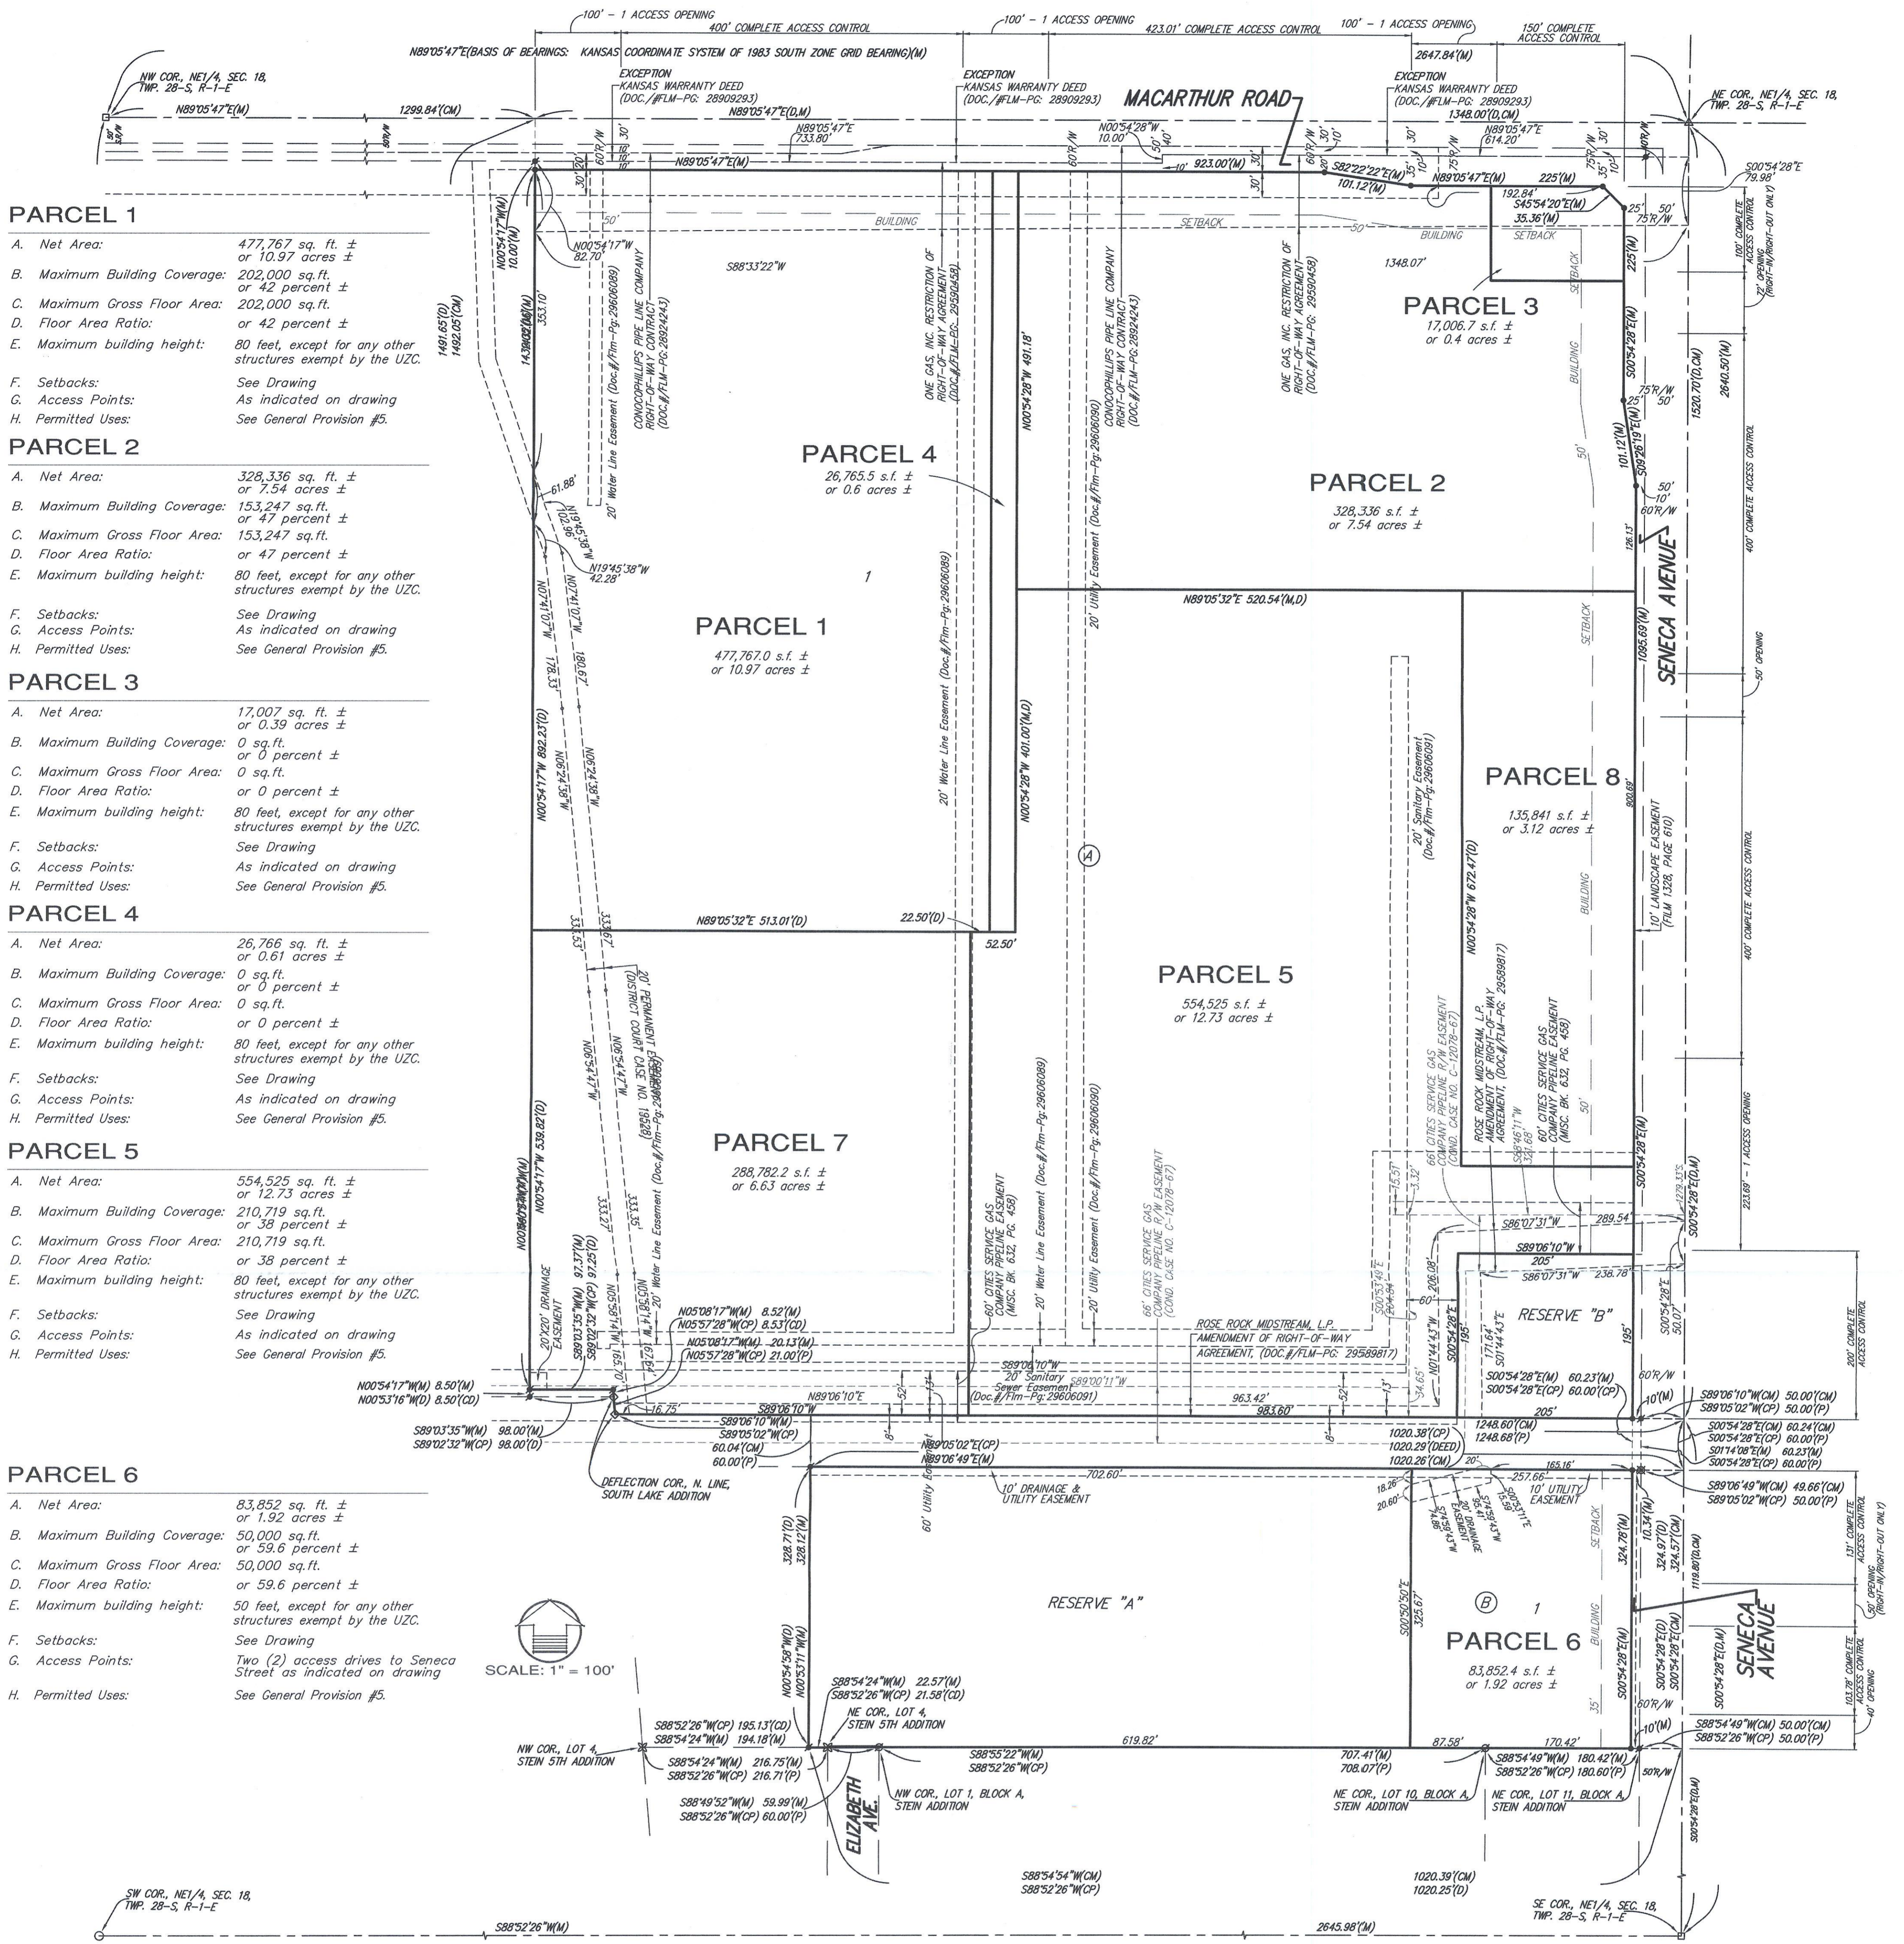

PARCEL 1

A. Net Area: 477,767 sq. ft. ± or 10.97 acres ±

B. Maximum Building Coverage: 202,000 sq. ft. or 42 percent ±

C. Maximum Gross Floor Area: 202,000 sq. ft.

D. Floor Area Ratio: or 42 percent ±

E. Maximum building height: 80 feet, except for any other structures exempt by the UZC.

F. Setbacks: See Drawing

G. Access Points: As indicated on drawing

H. Permitted Uses: See General Provision #5.

PARCEL 2

A. Net Area: 328,336 sq. ft. ± or 7.54 acres ±

B. Maximum Building Coverage: 153,247 sq. ft. or 47 percent ±

C. Maximum Gross Floor Area: 153,247 sq. ft.

D. Floor Area Ratio: or 47 percent ±

E. Maximum building height: 80 feet, except for any other structures exempt by the UZC.

F. Setbacks: See Drawing

G. Access Points: As indicated on drawing

H. Permitted Uses: See General Provision #5.

PARCEL 3

A. Net Area: 17,007 sq. ft. ± or 0.39 acres ±

B. Maximum Building Coverage: 0 sq. ft. or 0 percent ±

C. Maximum Gross Floor Area: 0 sq. ft.

D. Floor Area Ratio: or 0 percent ±

E. Maximum building height: 80 feet, except for any other structures exempt by the UZC.

F. Setbacks: See Drawing

G. Access Points: As indicated on drawing

H. Permitted Uses: See General Provision #5.

PARCEL 4

A. Net Area: 26,766 sq. ft. ± or 0.61 acres ±

B. Maximum Building Coverage: 0 sq. ft. or 0 percent ±

C. Maximum Gross Floor Area: 0 sq. ft.

D. Floor Area Ratio: or 0 percent ±

E. Maximum building height: 80 feet, except for any other structures exempt by the UZC.

F. Setbacks: See Drawing

G. Access Points: As indicated on drawing

H. Permitted Uses: See General Provision #5.

PARCEL 5

A. Net Area: 554,525 sq. ft. ± or 12.73 acres ±

B. Maximum Building Coverage: 210,719 sq. ft. or 38 percent ±

C. Maximum Gross Floor Area: 210,719 sq. ft.

D. Floor Area Ratio: or 38 percent ±

E. Maximum building height: 80 feet, except for any other structures exempt by the UZC.

F. Setbacks: See Drawing

G. Access Points: As indicated on drawing

H. Permitted Uses: See General Provision #5.

PARCEL 6

A. Net Area: 83,852 sq. ft. ± or 1.92 acres ±

B. Maximum Building Coverage: 50,000 sq. ft. or 59.6 percent ±

C. Maximum Gross Floor Area: 50,000 sq. ft.

D. Floor Area Ratio: or 59.6 percent ±

E. Maximum building height: 50 feet, except for any other structures exempt by the UZC.

F. Setbacks: See Drawing

G. Access Points: Two (2) access drives to Seneca Street as indicated on drawing

H. Permitted Uses: See General Provision #5.

PARCEL 7

A. Net Area: 288,782 sq. ft. ± or 6.63 acres ±

B. Maximum Building Coverage: 109,737 sq. ft. or 38 percent ±

C. Maximum Gross Floor Area: 109,737 sq. ft.

D. Floor Area Ratio: or 38 percent ±

E. Maximum building height: 80 feet, except for any other structures exempt by the UZC.

F. Setbacks: See Drawing

G. Access Points: As indicated on drawing

H. Permitted Uses: See General Provision #5.

PARCEL 8

A. Net Area: 135,841 sq. ft. ± or 3.12 acres ±

B. Maximum Building Coverage: 51,620 sq. ft. or 38 percent ±

C. Maximum Gross Floor Area: 51,620 sq. ft.

D. Floor Area Ratio: or 38 percent ±

E. Maximum building height: 80 feet, except for any other structures exempt by the UZC.

F. Setbacks: See Drawing

G. Access Points: As indicated on drawing

H. Permitted Uses: See General Provision #5.

RESERVES A & B

A. Reserve A Net Area: 229,255 sq. ft. ± or 5.26 acres ±

B. Reserve B Net Area: 39,975 sq. ft. ± or 0.92 acres ±

C. Permitted Uses: Reserve "A" is hereby reserved for landscaping, open space, lakes, drainage purposes, utilities as confined to easement, and communication systems and related appurtenances as confined to easement. Reserve "B" is hereby reserved for landscaping, open space, lakes, drainage purposes, and pipelines and related appurtenances as confined to easement. Reserves "A" and "B" shall be owned and maintained by the owner of Lot 1, Block A.

GENERAL PROVISIONS:

- Total Land Area: 2,182,115 sq. ft. ± or 50.09 acres
Total Gross Floor Area: 777,323 sq. ft.
Total Floor Area Ratio: 36 percent
- Parking requirements shall be calculated at 1 parking space per 1,000 square feet of building area. Parking areas may be surfaced with crushed rock or similar material.
- Setbacks are as indicated on the P.U.D. drawing.
- A Drainage Plan shall be submitted to Public Works Department for approval. Required guarantees for drainage shall be provided at the time of platting improvements.
- Uses in Parcels 1-7 shall be limited to those permitted by-right in the "L1" Limited Industrial district, except the following: correctional facility; correctional placement residence, limited and general; day reporting center; kennel, boarding/breeding/training; night club in the city; pawn shop; secondhand store; sexually oriented business in the city or the county; tattooing and body piercing facility (city); tavern and drinking establishment; asphalt or concrete plant, limited and general; and grain storage. Parcel 6 may permit single-family, two-family, and multi-family residential uses.
- Access shall be limited to three openings to MacArthur Road, and six openings to Seneca Street as indicated on the Plan, and as approved by the City Engineer. There shall be no access permitted to the private access drive indicated on the plan without authorization from the property owner. One access opening may be up to 36 feet in width to accommodate truck traffic on each frontage for Parcels 1-7.
- Screening shall be per Uniform Pattern Code; however, any fences or walls shall be constructed of a consistent zoning and color.
- Landscaping will be per the Landscape Ordinance.
- Storage of merchandise shall be allowed outside an enclosed building only in compliance with the general screening standards of the Unified Zoning Code and the following additional standards: (1) no outdoor storage or work areas shall be permitted in any building setback; and (2) no required off-street parking space or loading area shall be utilized for storage. Outdoor storage areas may be surfaced with crushed rock or similar material.
- Roof-mounted equipment and loading docks, trash receptacles, ground level heating, air conditioning and mechanical equipment, free-standing coolers or refrigeration units, outdoor storage including portable storage containers, outdoor work areas or similar uses shall be screened from ground level view along MacArthur Road and Seneca Street, and any residentially-zoned property.
- Setbacks shall be as shown on the plan.
- No overhead doors or loading docks within 50 feet of residential zoning.
- All signs shall be limited to signs that would be allowed in the "LC" Limited Commercial zoning district; no off-site, billboard or portable signs shall be permitted except for off-site signs advertising uses located within this tract that shall be allowed to have signage placed on signs fronting MacArthur Road and Seneca Street.
- The design layout shown on the plan illustrates only one development concept. Slight modifications to the location of improvements may be permitted, provided they meet all requirements of this plan.
- Amendments, adjustments or interpretations to this P.U.D. shall be done in accordance with the Unified Zoning Code.
- Development may be phased based on the ability to provide adequate water and sanitary sewer infrastructure.
- The Transfer of title of all or any portion of land included within the Planned Unit Development (or any amendments thereto) does not constitute a termination of the plan or any portion thereof, but said plan shall run with the land and be binding upon present owners, their successors and assigns.
- The development of this property shall proceed in accordance with the development plan as recommended for approval by the Planning Commission and approved by the Governing Body, and any substantial deviation of the plan, as determined by the Zoning Administrator or the Director of Planning, shall constitute a violation of the building permit authorizing construction of the proposed development.
- Any major changes in this development plan shall be submitted to the Planning Commission and to the Governing Body for their consideration.

LEGAL DESCRIPTION:

Lot 1, Block A, TOGETHER WITH Lot 1, Block B, TOGETHER WITH Reserves A and B, Cross Gate Addition, Wichita, Sedgwick County, Kansas.

- REVISIONS:**
- | | |
|---|--------------------|
| Draft Planned Unit Development Filed: | January 12, 2015 |
| Draft Planned Unit Development Revised: | January 27, 2015 |
| Approved by MAPC: | February 19, 2015 |
| Revised Layout: | March 2, 2015 |
| Approved by City Council (PUD2015-01): | March 24, 2015 |
| Revised per Adjustment (PUD2016-09): | October 12, 2016 |
| Revised per Adjustment (PUD2018-04): | October 19, 2018 |
| Revised per Adjustment (PUD2019-11): | September 30, 2019 |
| Revised per Adjustment (PUD2022-26): | December 21, 2022 |

APPROVED PUD

Per Admin Adjustment
12/10/25
PUD20-26
Copy 2/24

PUD #46

LANGE
SENECA STREET INDUSTRIAL
PLANNED UNIT DEVELOPMENT



BAUGHMAN



Wichita-Sedgwick County Metropolitan Area Planning Department

December 21, 2022

IHL, LLC
Attn: Tim Johnson
PO Box 3548
Wichita, KS 67201

Baughman Company, P.A.
Attn: Russ Ewy
303 S. Topeka
Wichita, KS 67202

RE: PUD2022-00026 – Administrative Adjustment in the City to the Lange Seneca Street Industrial Planned Unit Development PUD #46 to alter parcel boundaries and area calculations to reflect a lot split on Parcel 2 (LSP2022-00042); generally located on the southwest corner of MacArthur Road and Seneca Street.

LEGAL DESCRIPTION: See attached

Dear Applicant:

We received and reviewed your request for an Administrative Adjustment to PUD #46 to alter the parcel boundary and area calculations of Parcel 2 associated with Lot Split LSP2022-00042, which split Lot B-1, Block A, Cross Gate Addition into Lots B-1 and B-2.

An administrative adjustments may be made to an approved PUD when the adjustment does not increase the floor area or building coverage by more than ten percent when calculated on a total, aggregate basis. The requested modifications create Parcel 8 and increase the building coverage on Parcel 1 by 11 percent. However, adjustments to Parcels 2, 3, and 4 reduce the building coverage and gross floor area; therefore, the aggregate total gross floor area only increases by four percent. In addition to these modifications, a correction was made to the General Provisions, total floor area ratio.

The following reflects the proposed modifications identified in red letters:

PARCEL 1

Net Area: 477,767 sq.ft. or 10.97 acres
Max Building Coverage: ~~181,551 sq.ft. or 38 percent~~ **202,000 sq.ft. or 42 percent**
Max Gross Floor Area: ~~181,551 sq.ft.~~ **202,000 sq.ft**
Floor Area Ratio: ~~or 38 Percent~~ **or 42 percent**

PARCEL 2

Net Area: ~~464,177 sq.ft. or 10.66 acres~~ **328,336 sq.ft. or 7.54 acres**
Max Building Coverage: ~~176,387 sq.ft. or 38 percent~~ **153,247 sq.ft. or 47 percent**
Max Gross Floor Area: ~~176,387 sq.ft.~~ **153,247 sq.ft**
Floor Area Ratio: ~~or 38 Percent~~ **or 47 percent**

PARCEL 3

Net Area: 17,007 sq.ft. or 0.39 acres
Max Building Coverage: ~~6,463 sq.ft. or 38 percent~~ **0 sq.ft. or 0 percent**
Max Gross Floor Area: ~~6,463 sq.ft.~~ **0 sq.ft**
Floor Area Ratio: ~~or 38 Percent~~ **or 0 percent**

PARCEL 4

Net Area: 26,766 sq.ft. or 0.61 acres
Max Building Coverage: ~~10,171 sq.ft. or 38 percent~~ **0 sq.ft. or 0 percent**
Max Gross Floor Area: ~~10,171 sq.ft.~~ **0 sq.ft**
Floor Area Ratio: ~~or 38 Percent~~ **or 0 percent**

PARCEL 8

Net Area: 135,841 sq.ft. or 3.12 acres
Maximum Building Coverage: 51,620 sq.ft or 38 percent
Maximum Gross Floor Area: 51,620 sq.ft.
Floor Area Ratio: or 38 percent
Maximum Building Height: 80 feet, except for any other structures exempt by the UZC.
Setbacks: See Drawing
Access Points: As indicated on drawing
Permitted Uses: See General Provisions #5


General Provisions:

Total Land Area: 2,182,115 sq.ft. or 50.09 acres
Total Gross Floor Area: ~~745,032 sq.ft.~~ 777,323 sq.ft.
Total Floor Area Ratio: ~~38 percent~~ 36 percent

On the basis of our review, we find that adjusting the CUP in the manner stated above is consistent with the approved CUP and will not have an adverse effect on the CUP or adjacent properties, nor will it be a substantial deviation of the original plan. Our signatures below indicate that the CUP shall be adjusted as stated in this letter. This CUP adjustment shall not be deemed to alter any other provisions of the CUP except as expressly stated herein. The "Development Application" sign should now be removed from the property. Please submit one (1) electronic copy and four (4) full-sized paper copies of the revised CUP drawing within 60 days in order for this adjustment to be considered final.



Scott Wadle, Director
Metropolitan Area Planning Department

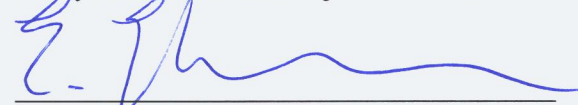

John R. Cox, Jr., Zoning Administrator
Metropolitan Area Planning Department


cc: MABCD, Jeff Blubaugh, CM District IV, Rebecca Fields, CSR District IV

Legal Description


That part of Lot 1, Block A, Cross Gate Addition, Wichita, Sedgwick County, Kansas described as follows:
Commencing at the most easterly corner common to said Lot 1 and Reserve "B" in said Cross Gate Addition;
thence N00°54'28"W along the east line of said Lot 1, 102.09 feet for a point of beginning; thence S89°05'32"W
perpendicular to the east line of said Lot 1, 202.00 feet; thence N00°54'28"W parallel with the east line of said Lot
1, 672.47 feet; thence S89°05'32"W perpendicular to the east line of said Lot 1, 520.54 feet; thence N00°54'28"W
parallel with the east line of said Lot 1, 491.18 feet to a point on the north line of said Lot 1; thence N89°05'47"E
along the north line of said Lot 1, 357.54 feet to a deflection corner in said north line; thence S82°22'22"E along
the north line of said Lot 1, 101.12 feet to a deflection corner in said north line; thence N89°05'47"E along the
north line of said Lot 1, 93.98 feet to a point 131.02 feet west of the most northerly northeast corner of said Lot 1;
thence S00°54'28"E parallel with the east line of said Lot 1, 111.01 feet; thence N89°05'32"E perpendicular to the
east line of said Lot 1, 156.02 feet to a point on the east line of said Lot 1; thence S00°54'28"E along the east line of
said Lot 1, 139.00 feet to a deflection corner in said east line; thence S09°26'19"E along the east line of said Lot 1,
101.12 feet to a deflection corner in said east line; thence S00°54'28"E along the east line of said Lot 1, 798.60 feet
to the point of beginning.

GENERAL PLANTING NOTES


- PRIOR TO BEGINNING ANY WORK ON THE SITE, THE CONTRACTOR SHALL CONTACT THE OFFICE OF THE OWNER AND THE ARCH./LANDSCAPE ARCH. FOR SPECIFIC INSTRUCTIONS RELEVANT TO THE SEQUENCING OF THE WORK.
- LANDSCAPE CONTRACTOR SHALL PROVIDE ALL LABOR, MATERIALS AND SERVICE NECESSARY TO FURNISH AND INSTALL PLANTINGS AS SPECIFIED HEREIN AND AS SHOWN ON THESE PLANS.
- NO MATERIAL SUBSTITUTIONS SHALL BE MADE WITHOUT LANDSCAPE ARCH. OR OWNER'S REPRESENTATIVE'S APPROVAL. MATERIALS OF SIMILAR SIZE AND CHARACTER MAY BE CONSIDERED IF SPOKE PLANT LIST AS DEEMED NECESSARY.
- ALL PLANT LOCATIONS ARE APPROXIMATE. ADJUST AS NECESSARY TO AVOID CONFLICTS.
- UTILITIES HAVE BEEN SHOWN ON THE PLAN FOR BOUGH LOCATION OF SERVICES. CONTRACTOR SHALL LOCATE ALL UTILITIES BEFORE WORK. LOCATE EXACT UTILITY LOCATIONS BY CONTACTING KANSAS ONE-CALL CENTER. CONTRACTOR WILL BE RESPONSIBLE FOR THE REPAIR OF ANY DAMAGE HE MAY CAUSE TO UTILITIES.
- SOD/SEED TYPE SHALL BE LOCALLY AVAILABLE HARDY BLEND OF TALL FESCUE, BERNUADGRASS, OR OTHER TURF APPROPRIATE FOR THE AREA.
- RE-ESTABLISH TURF IN AREAS DISTURBED BY GRADING OR UTILITY TRENCHING IN THE R.O.W.
- RE-ESTABLISH TURF IN ALL AREAS DISTURBED BY THE CONSTRUCTION PROCESS AND WITHIN THE LIMITS OF DISTURBANCE BY SEED, SOD OR PLANNED PLANTING AREAS, AS NOTED ON PLAN.
- BACKFILL FOR PLANT EXCAVATIONS TO BE CLEAN NATURAL SOIL EXCAVATED FROM PARTS SOIL TO ONE (1) PART COMPOST AND WELL-ROTTED MANURE AT A RATIO OF THREE (3) PARTS SOIL TO ONE (1) PART COMPOST AND WELL-ROTTED MANURE.
- FERTILIZE ALL PLANTS WITH 6-10-4 COMMERCIAL FERTILIZER AS DIRECTED BY INSTRUCTIONS ON FERTILIZER.
- ALL PLANT MATERIALS SHALL HAVE BACKFILL CAREFULLY PLACED AROUND BASE AND SIDES OF BALL TO TWO-THIRDS (2/3) DEPTH OF BALL, THEN THOROUGHLY SOAKED WITH WATER TO ALLOW SETTLEMENT. ALL WIRE, BURGLAP FASTENERS AND LOOSE BURGLAP AROUND BASE OF BALLS SHALL BE REMOVED. NUMBER OF PIT SHALL BE BASED ON BALL SIZE. BACKFILL, ALLOWING FOR DEPTH OF MULCH, SAUCER AND TOLERANCE OF BACKFILL. BACKFILL SHALL THEN BE THOROUGHLY WATERED ONCE AGAIN.
- ALL PLANT MATERIALS SHALL BE PROTECTED FROM THE DRYING ACTION OF THE SUN AND WIND AFTER BEING PLANTED. BALLS WHICH CANNOT BE PLANTED IMMEDIATELY WHILE PLANTING PLANTING DRYING ACTION BY COVERING THEM WITH MOIST MULCH. PERIODICALLY, APPLY WATER TO MULCH-COVERED BALLS TO KEEP MOIST. IF PLANTING SHOULD OCCUR DURING GROWING SEASON, REPLY ANTI-DESICCANT TO LEAVES BEFORE TRANSPORT TO REDUCE LIKELIHOOD OF WINDBURN. REPLY ANTI-DESICCANT AFTER PLANTING TO REDUCE TRANSPIRATION.
- STEEL EDGER BY "PROSTEEL, INC." EDGER TO BE 10 GAUGE (1/8" X 4" HIGH) AND PAINTED GREEN. INSTALL AS PER MANUFACTURER'S RECOMMENDATIONS. TOP OF EDGER TO ALIGN WITH SIDEWALK/CURB WHERE OCCURS. GRADE TO BE 1" BELOW TOP OF EDGER ON LAWN SIDE. REFER TO EDGER DETAIL.
- USE SHREDDED CEDAR WOOD MULCH IN ALL PLANTING BEDS. LANDSCAPE CONTRACTOR TO PROVIDE SAMPLE TO LANDSCAPE ARCHITECT OR OWNER'S REPRESENTATIVE FOR APPROVAL.
- PLACE 4" OF MULCH IN ALL TREE SAUCERS. PLANTING BEDS RECEIVING MULCH ARE TO BE FREE OF WEEDS AND GRASS.
- THE CONTRACTOR SHALL PROVIDE ALL WATER, WATERING DEVICES AND LABOR NEEDED TO IRRIGATE PLANT MATERIALS UNTIL ACCEPTANCE OF THE PROJECT'S PLANT MATERIALS CONDITION.
- LANDSCAPE CONTRACTOR TO REMOVE TREE STAKES AND ALL DEAD WOOD ON TREES ONE YEAR AFTER PROVISIONAL/FINAL ACCEPTANCE.
- REPORT ANY DISCREPANCIES IN THE PLANTING PLAN TO THE LANDSCAPE ARCHITECT PRIOR TO STARTING CONSTRUCTION.

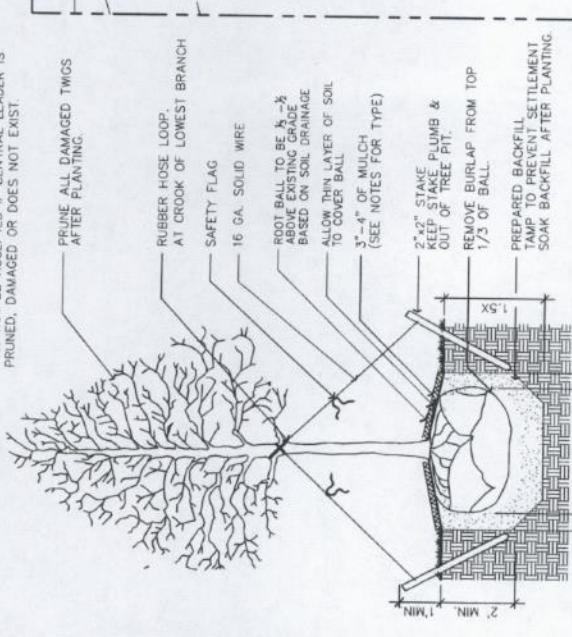


1 TREE PLANTING DETAIL
IN TURF AREAS
NO SCALE

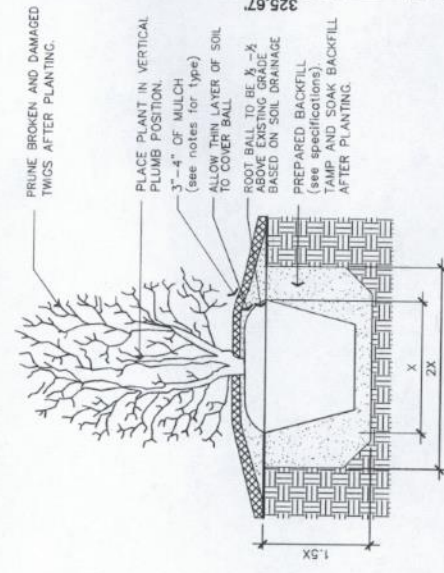

2 SHRUB PLANTING DETAIL
NO SCALE

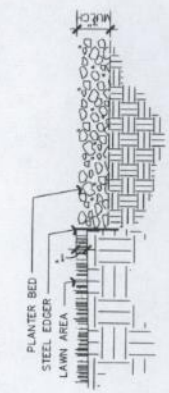

3 EDGER DETAIL
NO SCALE

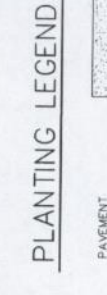

PLANTING LEGEND
PAVEMENT

PLANT MATERIAL SCHEDULE


QTY.	COMMON NAME	BOTANICAL NAME	SIZE/REMARKS
2	SHADE TREES		
1	AUTUMN BLAZE MAPLE	ACER RUBRUM 'AUTUMN BLAZE'	2" CAL.
1	CHINESE PISTACHE	CHINESE PISTACHIA	2" CAL.
1	RED OAK	QUERCUS RUBRA	2" CAL.
5	EVERGREEN TREE		
	CANAERTI JUNIPER	JUNIPERUS VIRGINIAN 'CANAERTI'	6" MIN. HT.
	DECIDUOUS SHRUBS		
	EVERGREEN SHRUBS		
28	KALLAY PRITZER JUNIPER	JUNIPERUS CHINENSIS PRITZERIANA	3 GAL.
	ORNAMENTAL GRASSES & PERENNIALS		

LANDSCAPE CODE CALCULATIONS

LANDSCAPED STREET YARD REQUIRED:
 Make Road
 3250 / 500 = 6.5 or soy 7 trees required
 4 Shrub Trees + 3 evergreen trees = 7 trees provided

PARKING LOT SCREENING AND LANDSCAPING:
 Parking lot is screened w/shrubs
 Existing Lot Trees Required
 3250 / 20 = 162.5 trees required
 22 Total slots / 20 = 1 tree required
 (up to one-half of req'd street yard trees may be used to satisfy pkg. lot trees)

SHRUBS REQUIRED:
 Buffer required to south along wast
 85 / 40 = 2 trees required & provided

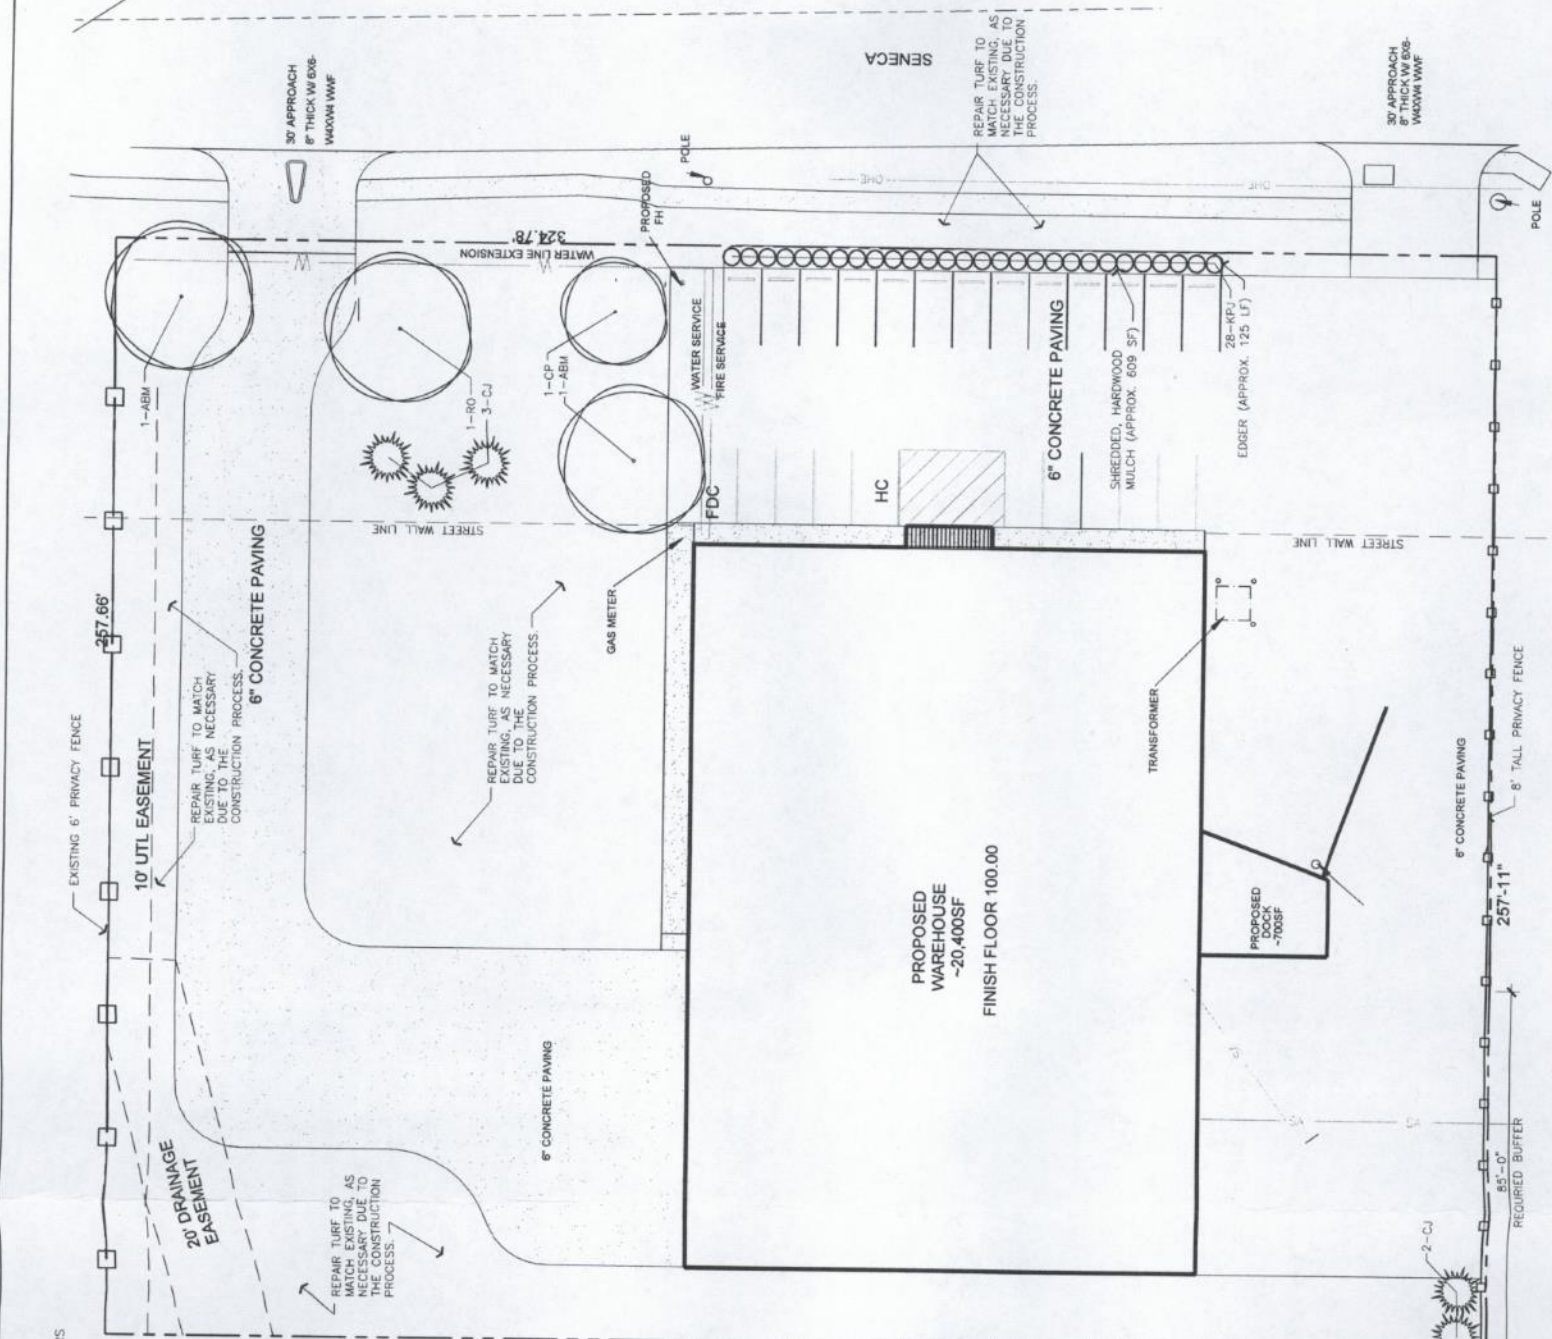

SITE PLANTING PLAN
1" = 20'-0"

LANDSCAPE PLAN

PUB 46

7/14/22
N/S

UTILITIES SHOWN REPRESENT THE BEST INFORMATION AVAILABLE. OR DESIGN ADDITIONAL UTILITIES MAY BE PRESENT OR DESIGNED PRIOR TO THE START OF CONSTRUCTION. THE CONTRACTOR SHALL BE RESPONSIBLE FOR DETERMINING THE EXACT LOCATION, DEPTH AND SIZE OF ALL UNDERGROUND UTILITIES PRIOR TO CONSTRUCTION. THE CONTRACTOR SHALL BE LIABLE FOR ANY DAMAGE CAUSED BY THE FAILURE TO DO SO.


S & S LEASING
4211 S. Seneca
Wichita, KS

TERI ANREAS FARHA
Wichita, KS
terifarha@cox.net

PLANTING PLAN
DATE
OCTOBER 4, 2021
NOVEMBER 15, 2021

LS1.0

LANGE SENECA STREET INDUSTRIAL PLANNED UNIT DEVELOPMENT PUD #46

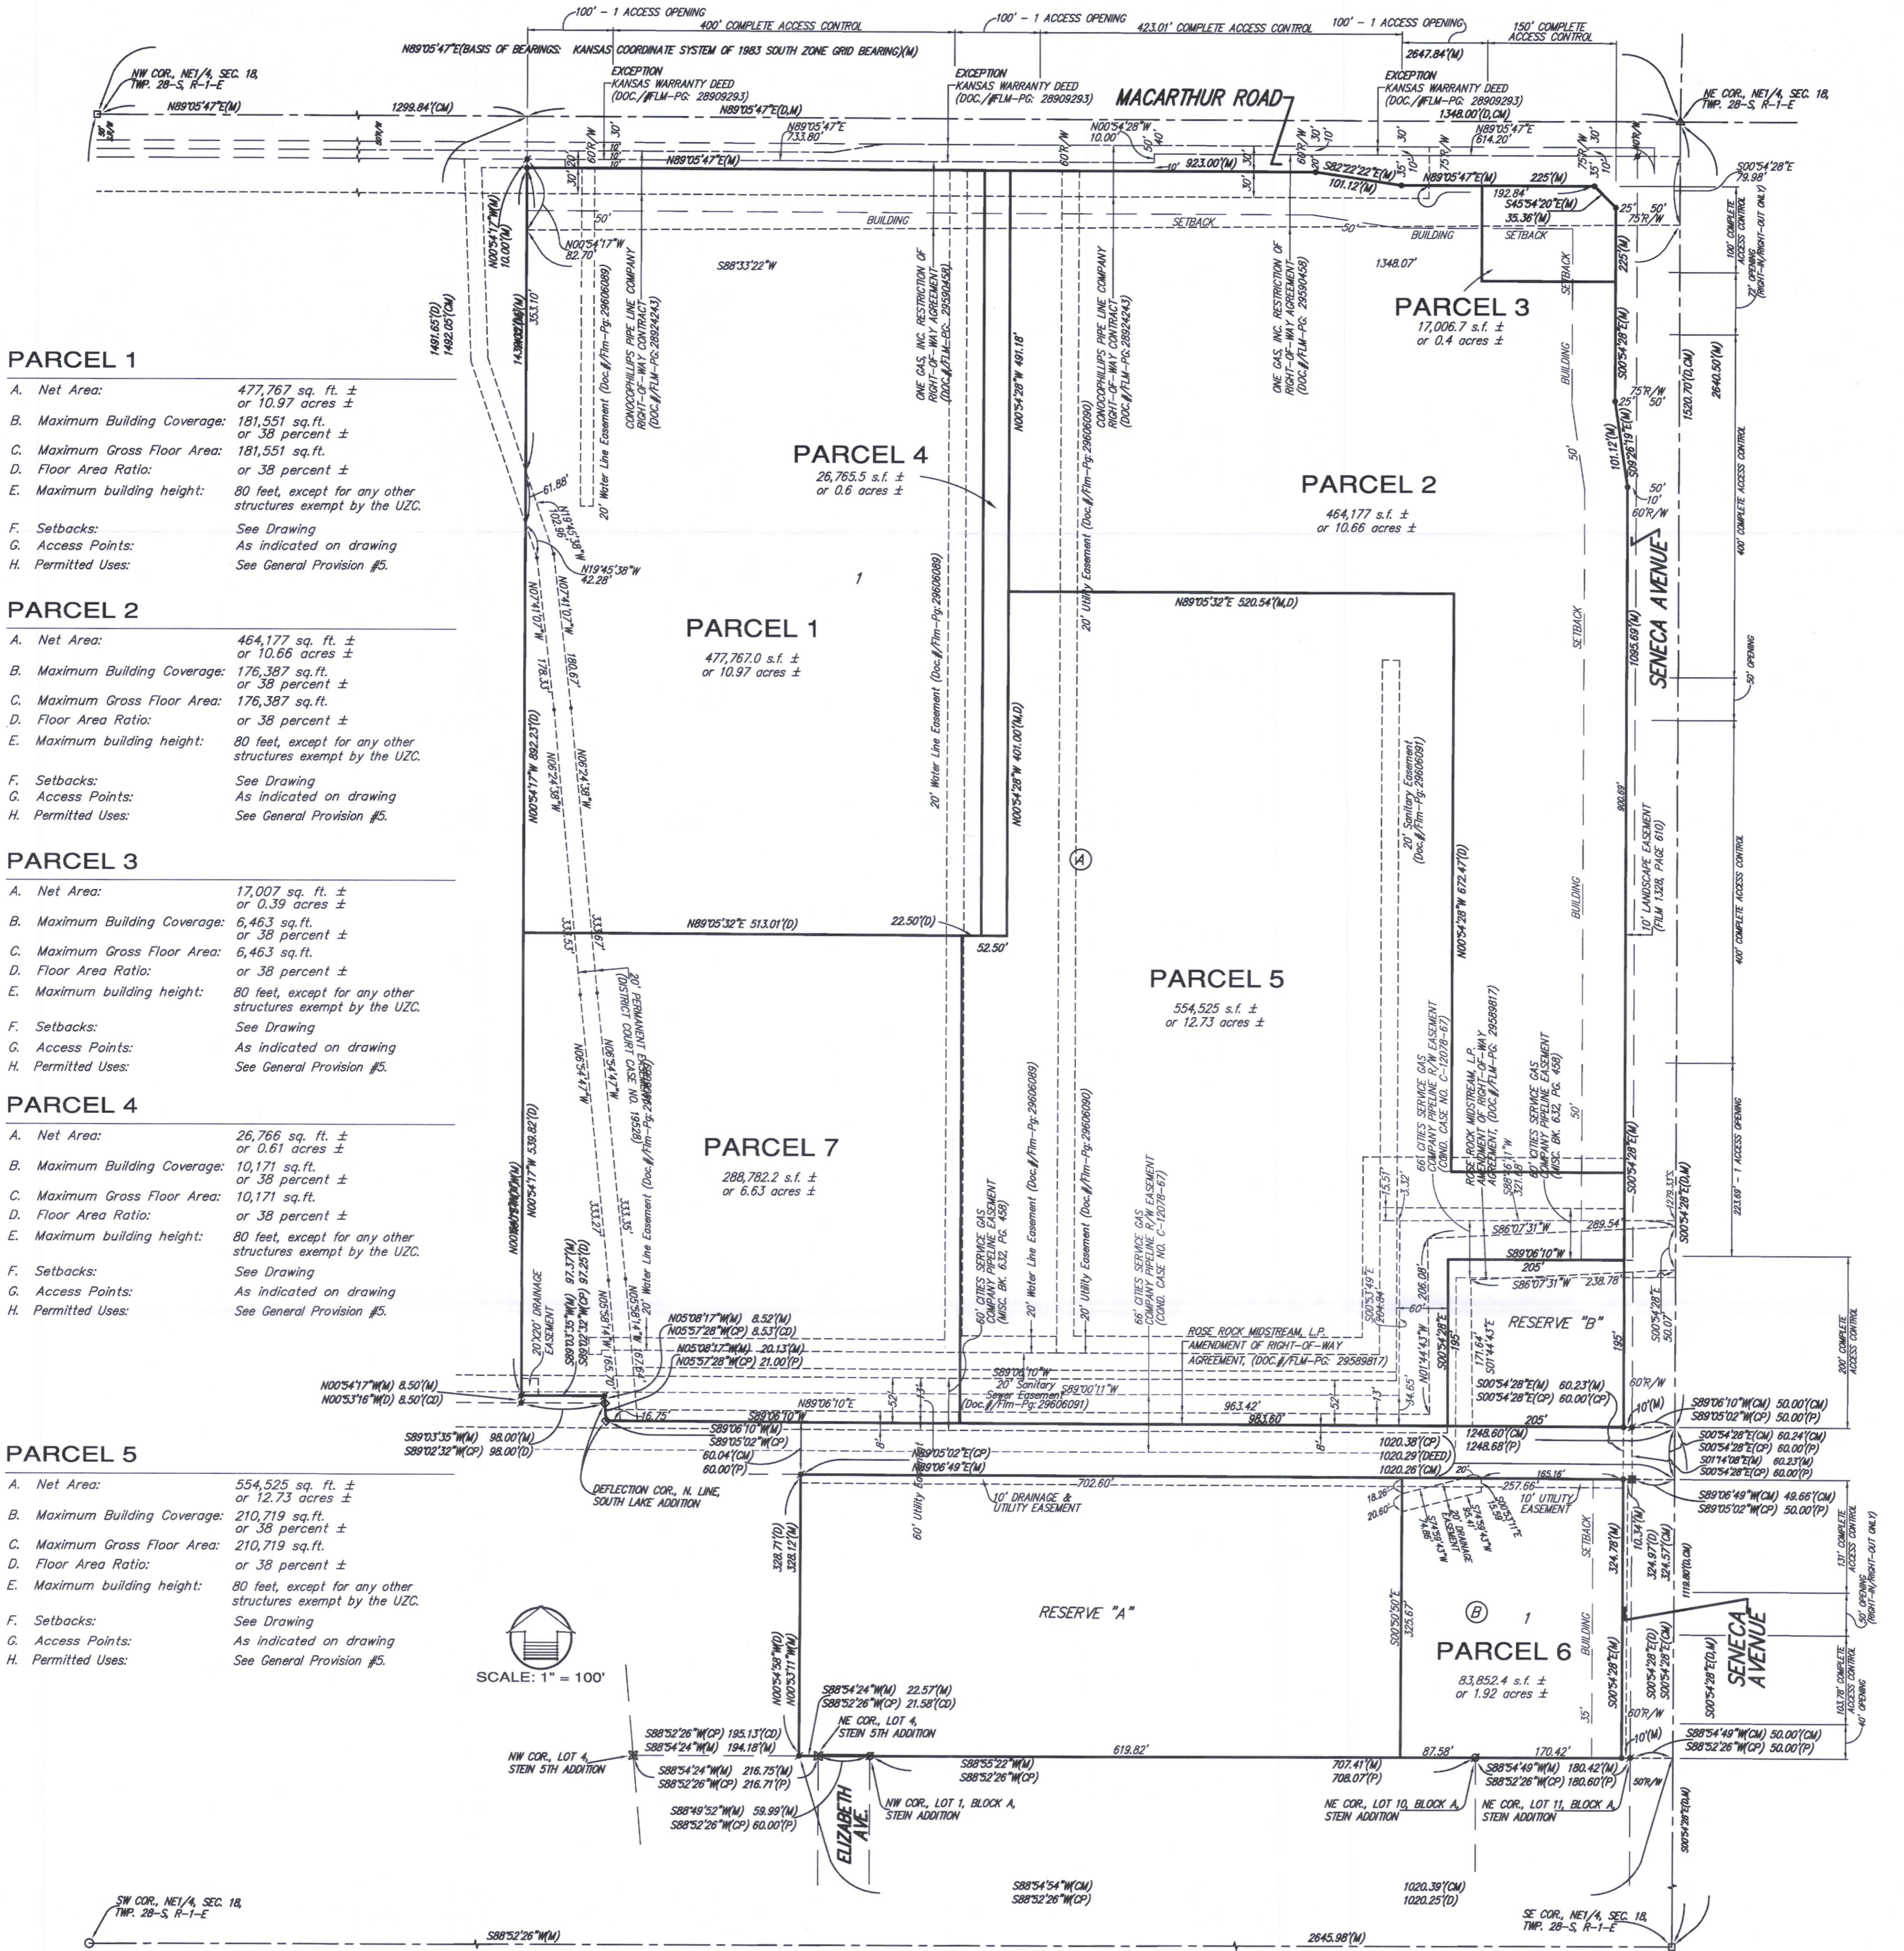

PARCEL 1

A. Net Area:	477,767 sq. ft. ± or 10.97 acres ±
B. Maximum Building Coverage:	181,551 sq. ft. or 38 percent ±
C. Maximum Gross Floor Area:	181,551 sq. ft.
D. Floor Area Ratio:	or 38 percent ±
E. Maximum building height:	80 feet, except for any other structures exempt by the UZC.
F. Setbacks:	See Drawing
G. Access Points:	As indicated on drawing
H. Permitted Uses:	See General Provision #5.

PARCEL 2

A. Net Area:	464,177 sq. ft. ± or 10.66 acres ±
B. Maximum Building Coverage:	176,387 sq. ft. or 38 percent ±
C. Maximum Gross Floor Area:	176,387 sq. ft.
D. Floor Area Ratio:	or 38 percent ±
E. Maximum building height:	80 feet, except for any other structures exempt by the UZC.
F. Setbacks:	See Drawing
G. Access Points:	As indicated on drawing
H. Permitted Uses:	See General Provision #5.

PARCEL 3

A. Net Area:	17,007 sq. ft. ± or 0.39 acres ±
B. Maximum Building Coverage:	6,463 sq. ft. or 38 percent ±
C. Maximum Gross Floor Area:	6,463 sq. ft.
D. Floor Area Ratio:	or 38 percent ±
E. Maximum building height:	80 feet, except for any other structures exempt by the UZC.
F. Setbacks:	See Drawing
G. Access Points:	As indicated on drawing
H. Permitted Uses:	See General Provision #5.

PARCEL 4

A. Net Area:	26,766 sq. ft. ± or 0.61 acres ±
B. Maximum Building Coverage:	10,171 sq. ft. or 38 percent ±
C. Maximum Gross Floor Area:	10,171 sq. ft.
D. Floor Area Ratio:	or 38 percent ±
E. Maximum building height:	80 feet, except for any other structures exempt by the UZC.
F. Setbacks:	See Drawing
G. Access Points:	As indicated on drawing
H. Permitted Uses:	See General Provision #5.

PARCEL 5

A. Net Area:	554,525 sq. ft. ± or 12.73 acres ±
B. Maximum Building Coverage:	210,719 sq. ft. or 38 percent ±
C. Maximum Gross Floor Area:	210,719 sq. ft.
D. Floor Area Ratio:	or 38 percent ±
E. Maximum building height:	80 feet, except for any other structures exempt by the UZC.
F. Setbacks:	See Drawing
G. Access Points:	As indicated on drawing
H. Permitted Uses:	See General Provision #5.

PARCEL 6

A. Net Area:	83,852 sq. ft. ± or 1.92 acres ±
B. Maximum Building Coverage:	50,000 sq. ft. or 59.6 percent ±
C. Maximum Gross Floor Area:	50,000 sq. ft.
D. Floor Area Ratio:	or 59.6 percent ±
E. Maximum building height:	50 feet, except for any other structures exempt by the UZC.
F. Setbacks:	See Drawing
G. Access Points:	Two (2) access drives to Seneca Street as indicated on drawing
H. Permitted Uses:	See General Provision #5.

PARCEL 7

A. Net Area:	288,782 sq. ft. ± or 6.63 acres ±
B. Maximum Building Coverage:	109,737 sq. ft. or 38 percent ±
C. Maximum Gross Floor Area:	109,737 sq. ft.
D. Floor Area Ratio:	or 38 percent ±
E. Maximum building height:	80 feet, except for any other structures exempt by the UZC.
F. Setbacks:	See Drawing
G. Access Points:	As indicated on drawing
H. Permitted Uses:	See General Provision #5.

RESERVES A & B

A. Reserve A Net Area:	229,255 sq. ft. ± or 5.26 acres ±
B. Reserve B Net Area:	39,975 sq. ft. ± or 0.92 acres ±
C. Permitted Uses:	Reserve "A" is hereby reserved for landscaping, open space, lakes, drainage purposes, utilities as confined to easement, and communication systems and related appurtenances as confined to easement. Reserve "B" is hereby reserved for landscaping, open space, lakes, drainage purposes, and pipelines and related appurtenances as confined to easement. Reserves "A" and "B" shall be owned and maintained by the owner of Lot 1, Block A.

GENERAL PROVISIONS:

1. Total Land Area: 2,182,115 sq. ft. ± or 50.09 acres
Total Gross Floor Area: 745,032 sq. ft.
Total Floor Area Ratio: 38 percent
2. Parking requirements shall be calculated at 1 parking space per 1,000 square feet of building area. Parking areas may be surfaced with crushed rock or similar material.
3. Setbacks are as indicated on the P.U.D. drawing.
4. A Drainage Plan shall be submitted to Public Works Department for approval. Required guarantees for drainage shall be provided at the time of platting improvements.
5. Uses in Parcels 1-7 shall be limited to those permitted-by-right in the "L" Limited Industrial district, except the following: correctional facility; correctional placement residence; limited and general; day reporting center; kennel; boarding/breeding/training; night club in the city; pawn shop; secondhand store; sexually oriented business in the city or the county; tattooing and body piercing facility (city); tavern and drinking establishment; asphalt or concrete plant, limited and general; and grain storage. Parcel 6 may permit single-family, two-family, and multi-family residential uses.
6. Access shall be limited to three openings to MacArthur Road, and six openings to Seneca Street as indicated on the Plan, and as approved by the City Engineer. There shall be no access permitted to the private access drive indicated on the plan without authorization from the property owner. One access opening may be up to 36 feet in width to accommodate truck traffic on each frontage for Parcels 1-7.
7. Screening shall be per Unified Zoning Code; however, any fences or walls shall be constructed of a consistent pattern and color.
8. Landscaping will be per the Landscape Ordinance.
9. Storage of merchandise shall be allowed outside an enclosed building only in compliance with the general screening standards of the Unified Zoning Code and the following additional standards: (1) no outdoor storage or work areas shall be permitted in any building setback; and (2) no required off-street parking space or loading area shall be utilized for storage. Outdoor storage areas may be surfaced with crushed rock or similar material.

LEGAL DESCRIPTION:

10. Roof-mounted equipment and loading docks, trash receptacles, ground level heating, air conditioning and mechanical equipment, free-standing coolers or refrigeration units, outdoor storage including portable storage containers, outdoor work areas or similar uses shall be screened from ground level view along MacArthur Road and Seneca Street, and any residentially-zoned property.
11. Setbacks shall be as shown on the plan.
12. No overhead doors or loading docks within 50 feet of residential zoning.
13. All signs shall be limited to signs that would be allowed in the "LC" Limited Commercial zoning district; no off-site, billboard or portable signs shall be permitted except for off-site signs advertising uses located within this tract that shall be allowed to have signage placed on signs fronting MacArthur Road and Seneca Street.
14. The design layout shown on the plan illustrates only one development concept. Slight modifications to the location of improvements may be permitted, provided they meet all requirements of this plan.
15. Amendments, adjustments or interpretations to this P.U.D. shall be done in accordance with the Unified Zoning Code.
16. Development may be phased based on the ability to provide adequate water and sanitary sewer infrastructure.
17. The Transfer of title of all or any portion of land included within the Planned Unit Development (or any amendments thereto) does not constitute a termination of the plan or any portion thereof, but said plan shall run with the land and be binding upon present owners, their successors and assigns.
18. The development of this property shall proceed in accordance with the development plan as recommended for approval by the Planning Commission and approved by the Governing Body, and any substantial deviation of the plan, as determined by the Zoning Administrator or the Director of Planning, shall constitute a violation of the building permit authorizing construction of the proposed development.
19. Any major changes in this development plan shall be submitted to the Planning Commission and to the Governing Body for their consideration.

REVISIONS:

Draft Planned Unit Development Filed:	January 12, 2015
Draft Planned Unit Development Revised:	January 27, 2015
Approved by MAPC:	February 19, 2015
Revised Layout:	March 2, 2015
Approved by City Council (PUD2015-01):	March 24, 2015
Revised per Adjustment (PUD2016-09):	October 12, 2016
Revised per Adjustment (PUD2018-04):	October 18, 2018
Revised per Adjustment (PUD2019-11):	September 30, 2019

APPROVED PUD

MAY 2-19-2015

WCC 3-24-2015

MATD Copy 1 of 4


PUD #46

LANGE
SENECA STREET INDUSTRIAL
PLANNED UNIT DEVELOPMENT



BAUGHMAN

LANGE SENECA STREET INDUSTRIAL PLANNED UNIT DEVELOPMENT PUD #46

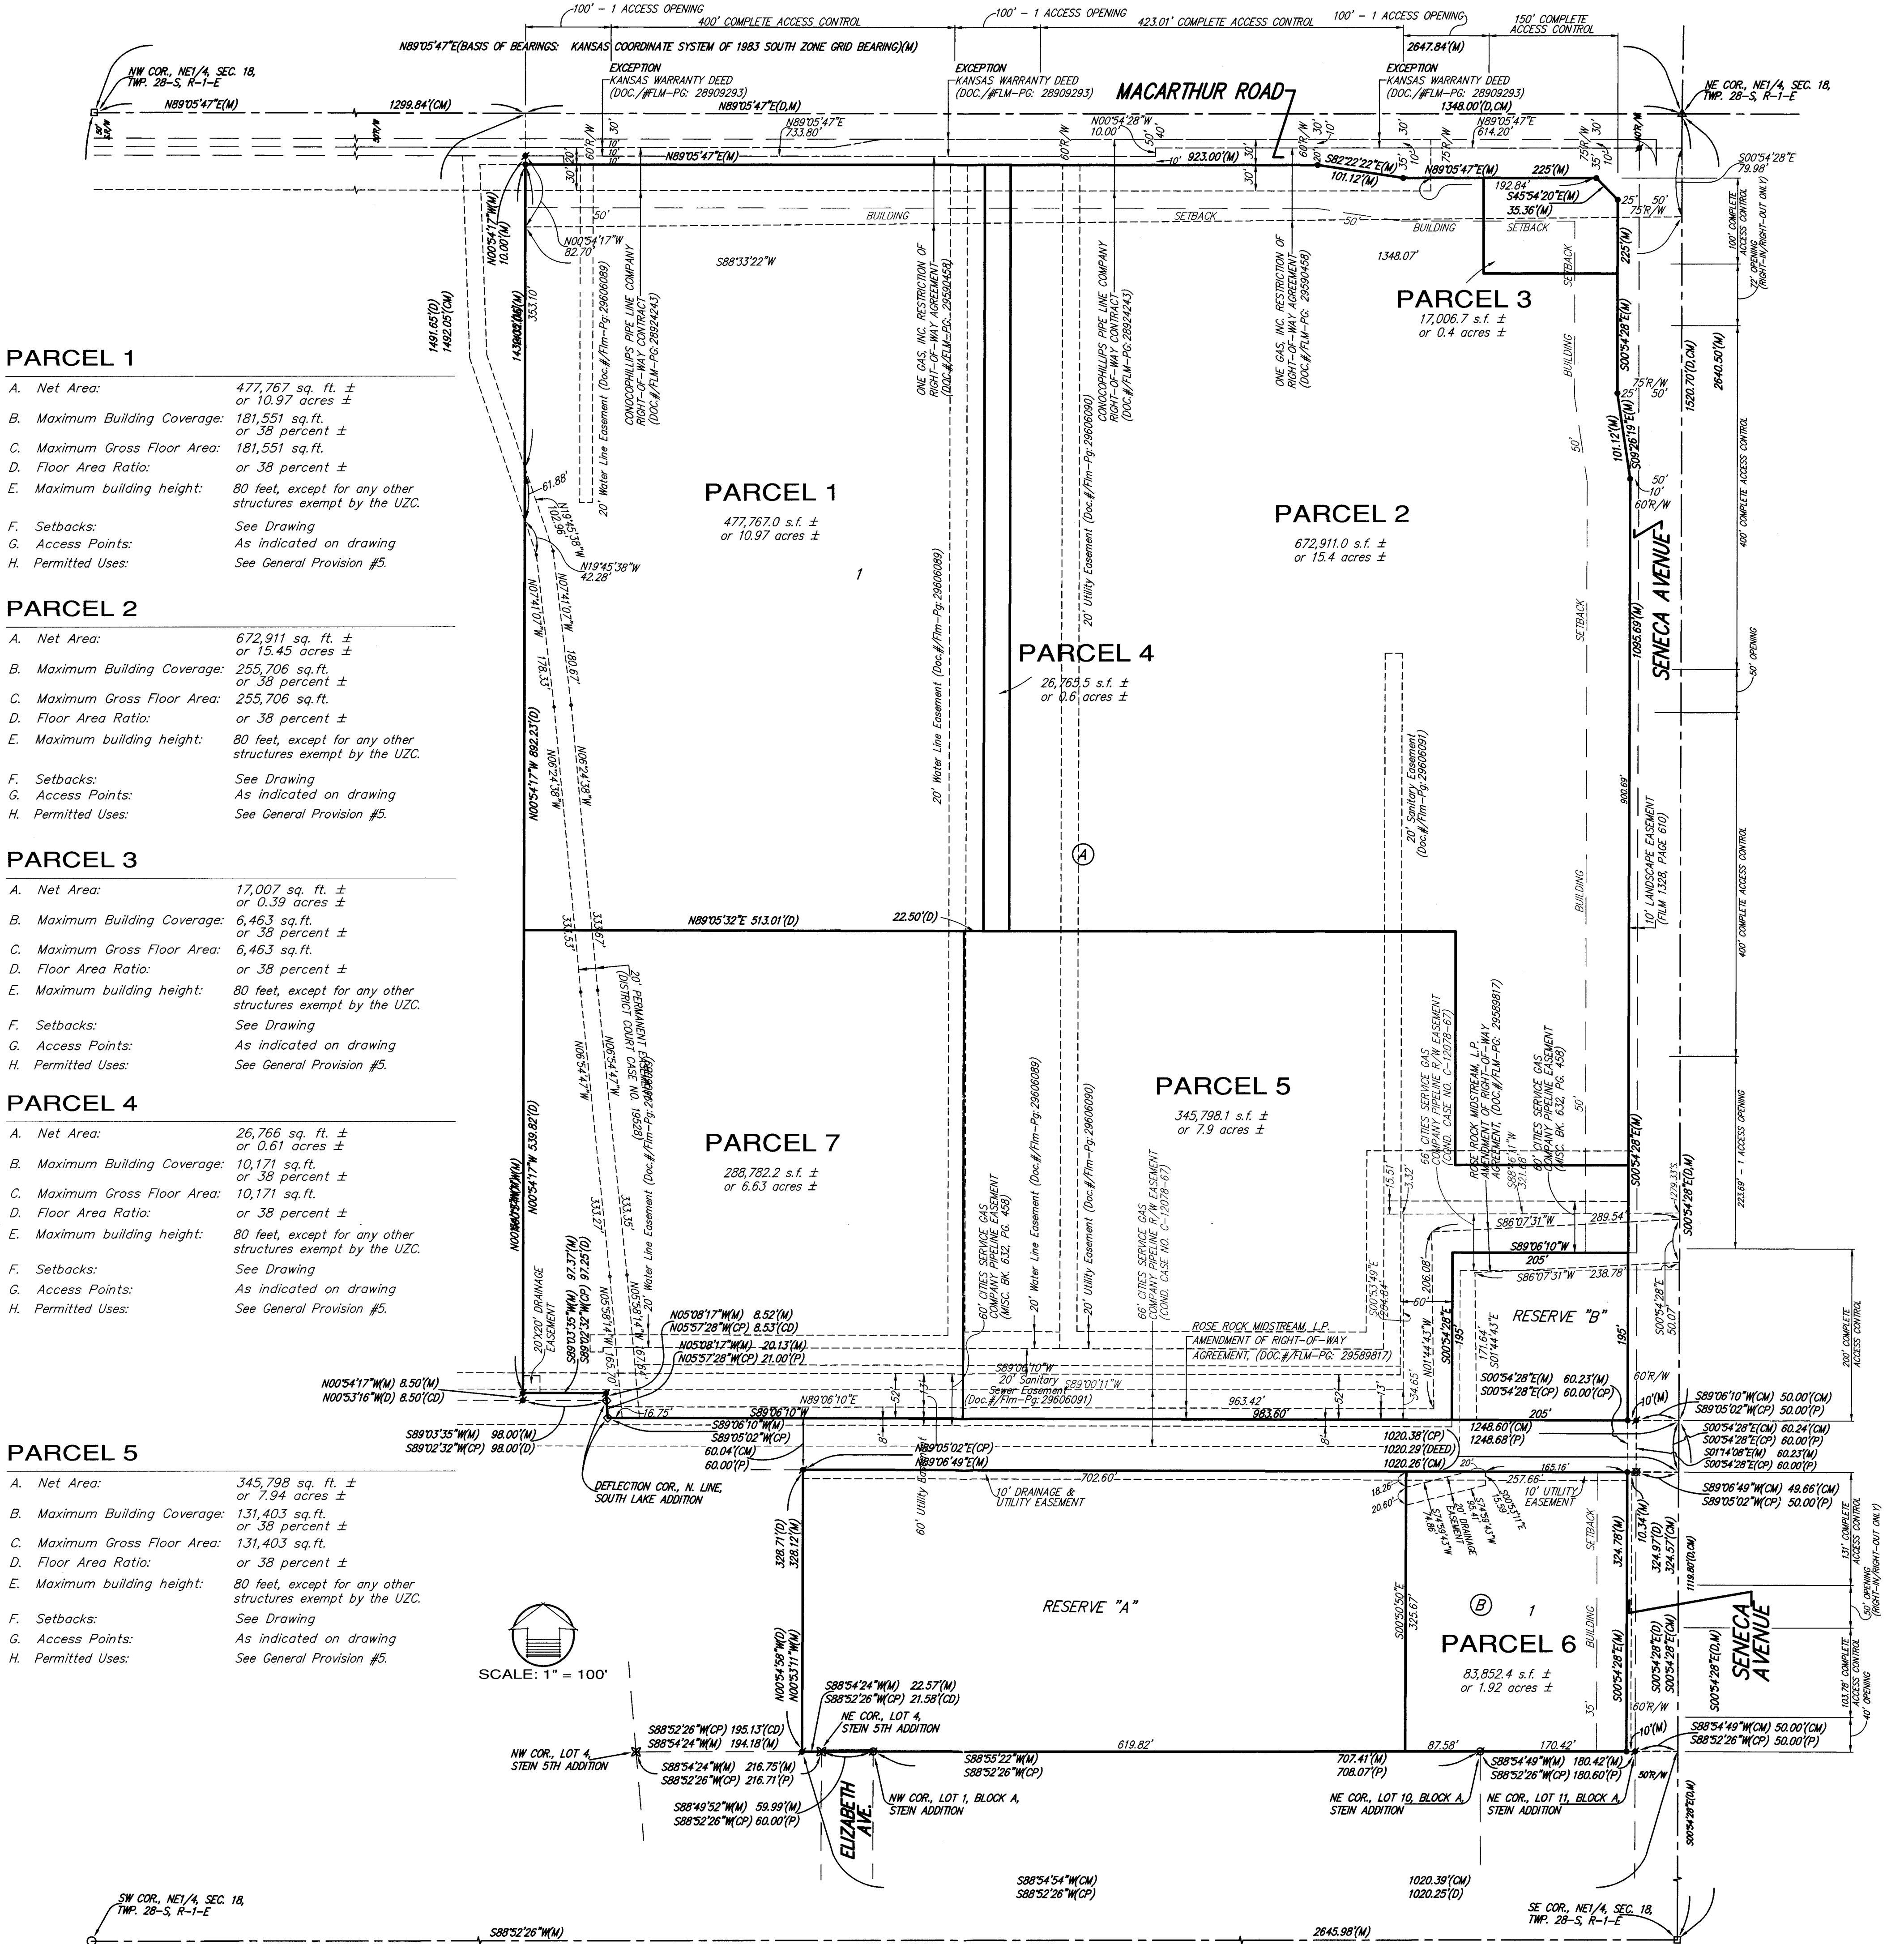

PARCEL 1

A. Net Area: 477,767 sq. ft. ± or 10.97 acres ±
 B. Maximum Building Coverage: 181,551 sq. ft. or 38 percent ±
 C. Maximum Gross Floor Area: 181,551 sq. ft. or 38 percent ±
 D. Floor Area Ratio: or 38 percent ±
 E. Maximum building height: 80 feet, except for any other structures exempt by the UZC.
 F. Setbacks: See Drawing
 G. Access Points: As indicated on drawing
 H. Permitted Uses: See General Provision #5.

PARCEL 2

A. Net Area: 672,911 sq. ft. ± or 15.45 acres ±
 B. Maximum Building Coverage: 255,706 sq. ft. or 38 percent ±
 C. Maximum Gross Floor Area: 255,706 sq. ft. or 38 percent ±
 D. Floor Area Ratio: or 38 percent ±
 E. Maximum building height: 80 feet, except for any other structures exempt by the UZC.
 F. Setbacks: See Drawing
 G. Access Points: As indicated on drawing
 H. Permitted Uses: See General Provision #5.

PARCEL 3

A. Net Area: 17,007 sq. ft. ± or 0.39 acres ±
 B. Maximum Building Coverage: 6,463 sq. ft. or 38 percent ±
 C. Maximum Gross Floor Area: 6,463 sq. ft. or 38 percent ±
 D. Floor Area Ratio: or 38 percent ±
 E. Maximum building height: 80 feet, except for any other structures exempt by the UZC.
 F. Setbacks: See Drawing
 G. Access Points: As indicated on drawing
 H. Permitted Uses: See General Provision #5.

PARCEL 4

A. Net Area: 26,766 sq. ft. ± or 0.61 acres ±
 B. Maximum Building Coverage: 10,171 sq. ft. or 38 percent ±
 C. Maximum Gross Floor Area: 10,171 sq. ft. or 38 percent ±
 D. Floor Area Ratio: or 38 percent ±
 E. Maximum building height: 80 feet, except for any other structures exempt by the UZC.
 F. Setbacks: See Drawing
 G. Access Points: As indicated on drawing
 H. Permitted Uses: See General Provision #5.

PARCEL 5

A. Net Area: 345,798 sq. ft. ± or 7.94 acres ±
 B. Maximum Building Coverage: 131,403 sq. ft. or 38 percent ±
 C. Maximum Gross Floor Area: 131,403 sq. ft. or 38 percent ±
 D. Floor Area Ratio: or 38 percent ±
 E. Maximum building height: 80 feet, except for any other structures exempt by the UZC.
 F. Setbacks: See Drawing
 G. Access Points: As indicated on drawing
 H. Permitted Uses: See General Provision #5.

PARCEL 6

A. Net Area: 83,852 sq. ft. ± or 1.92 acres ±
 B. Maximum Building Coverage: 50,000 sq. ft. or 59.6 percent ±
 C. Maximum Gross Floor Area: 50,000 sq. ft. or 59.6 percent ±
 D. Floor Area Ratio: or 59.6 percent ±
 E. Maximum building height: 50 feet, except for any other structures exempt by the UZC.
 F. Setbacks: See Drawing
 G. Access Points: Two (2) access drives to Seneca Street as indicated on drawing
 H. Permitted Uses: See General Provision #5.

PARCEL 7

A. Net Area: 288,782 sq. ft. ± or 6.63 acres ±
 B. Maximum Building Coverage: 109,737 sq. ft. or 38 percent ±
 C. Maximum Gross Floor Area: 109,737 sq. ft. or 38 percent ±
 D. Floor Area Ratio: or 38 percent ±
 E. Maximum building height: 80 feet, except for any other structures exempt by the UZC.
 F. Setbacks: See Drawing
 G. Access Points: As indicated on drawing
 H. Permitted Uses: See General Provision #5.

RESERVES A & B

A. Reserve A Net Area: 229,255 sq. ft. ± or 5.26 acres ±
 B. Reserve B Net Area: 39,975 sq. ft. ± or 0.92 acres ±
 C. Permitted Uses: Reserve "A" is hereby reserved for landscaping, open space, lakes, drainage purposes, utilities as confined to easement, and communication systems and related appurtenances as confined to easement. Reserve "B" is hereby reserved for landscaping, open space, lakes, drainage purposes, and pipelines and related appurtenances as confined to easement. Reserves "A" and "B" shall be owned and maintained by the owner of Lot 1, Block A.

GENERAL PROVISIONS:

- Total Land Area: 2,182,115 sq. ft. ± or 50.09 acres
 Total Gross Floor Area: 745,032 sq. ft.
 Total Floor Area Ratio: 38 percent
- Parking requirements shall be calculated at 1 parking space per 1,000 square feet of building area. Parking areas may be surfaced with crushed rock or similar material.
- Setbacks are as indicated on the P.U.D. drawing.
- A Drainage Plan shall be submitted to Public Works Department for approval. Required guarantees for drainage shall be provided at the time of platting improvements.
- Uses in Parcels 1-7 shall be limited to those permitted by-right in the "I" Limited Industrial district, except the following: correctional facility, correctional placement residence, limited and general; day reporting center; kennel, boarding/breeding/training; night club in the city; pawn shop; secondhand store; sexually oriented business in the city or the county; tattooing and body piercing facility (city); tavern and drinking establishment; asphalt or concrete plant, limited and general; and grain storage. Parcel 6 may permit single-family, two-family, and multi-family residential uses.
- Access shall be limited to three openings to MacArthur Road, and six openings to Seneca Street as indicated on the Plan, and as approved by the City Engineer. There shall be no access permitted to the private access drive indicated on the plan without authorization from the property owner. One access opening may be up to 36 feet in width to accommodate truck traffic on each frontage for Parcels 1-7.
- Screening shall be per Unified Zoning Code; however, any fences or walls shall be constructed of a consistent pattern and color.
- Landscaping will be per the Landscape Ordinance.
- Storage of merchandise shall be allowed outside an enclosed building only in compliance with the general screening standards of the Unified Zoning Code and the following additional standards: (1) no outdoor storage or work areas shall be permitted in any building setback; and (2) no required off-street parking space or loading area shall be utilized for storage. Outdoor storage areas may be surfaced with crushed rock or similar material.
- Roof-mounted equipment and loading docks, trash receptacles, ground level heating, air conditioning and mechanical equipment, free-standing coolers or refrigeration units, outdoor storage including portable storage containers, outdoor work areas or similar uses shall be screened from ground level view along MacArthur Road and Seneca Street, and any residentially-zoned property.
- Setbacks shall be as shown on the plan.
- No overhead doors or loading docks within 50 feet of residential zoning.
- All signs shall be limited to signs that would be allowed in the "LC" Limited Commercial zoning district; no off-site, billboard or portable signs shall be permitted except for off-site signs advertising uses located within this tract that shall be allowed to have signage placed on signs fronting MacArthur Road and Seneca Street.
- The design layout shown on the plan illustrates only one development concept. Slight modifications to the location of improvements may be permitted, provided they meet all requirements of this plan.
- Amendments, adjustments or interpretations to this P.U.D. shall be done in accordance with the Unified Zoning Code.
- Development may be phased based on the ability to provide adequate water and sanitary sewer infrastructure.
- The Transfer of title of all or any portion of land included within the Planned Unit Development (or any amendments thereto) does not constitute a termination of the plan or any portion thereof, but said plan shall run with the land and be binding upon present owners, their successors and assigns.
- The development of this property shall proceed in accordance with the development plan as recommended for approval by the Planning Commission and approved by the Governing Body, and any substantial deviation of the plan, as determined by the Zoning Administrator or the Director of Planning, shall constitute a violation of the building permit authorizing construction of the proposed development.
- Any major changes in this development plan shall be submitted to the Planning Commission and to the Governing Body for their consideration.

LEGAL DESCRIPTION:

Lot 1, Block A; TOGETHER WITH Lot 1, Block B; TOGETHER WITH Reserves A and B, Cross Gate Addition, Wichita, Sedgewick County, Kansas.

REVISIONS:

Revision	Date	Description
1	January 12, 2015	Draft Planned Unit Development Filed
2	January 23, 2015	Draft Planned Unit Development Revised
3	February 19, 2015	Approved by MAPC
4	March 2, 2015	Revised Layout
5	March 24, 2015	Approved by City Council (PUD2015-01)
6	October 12, 2016	Revised per Adjustment (PUD2016-03)
7	October 19, 2018	Revised per Adjustment (PUD2018-04)

APPROVED PUD


MAPC 2-19-2015 *klm*
 WCC 3-24-2015 *klm*
 MAPD Copy 1 of 4

PUD #46

LANGE
 SENECA STREET INDUSTRIAL
 PLANNED UNIT DEVELOPMENT



BAUGHMAN

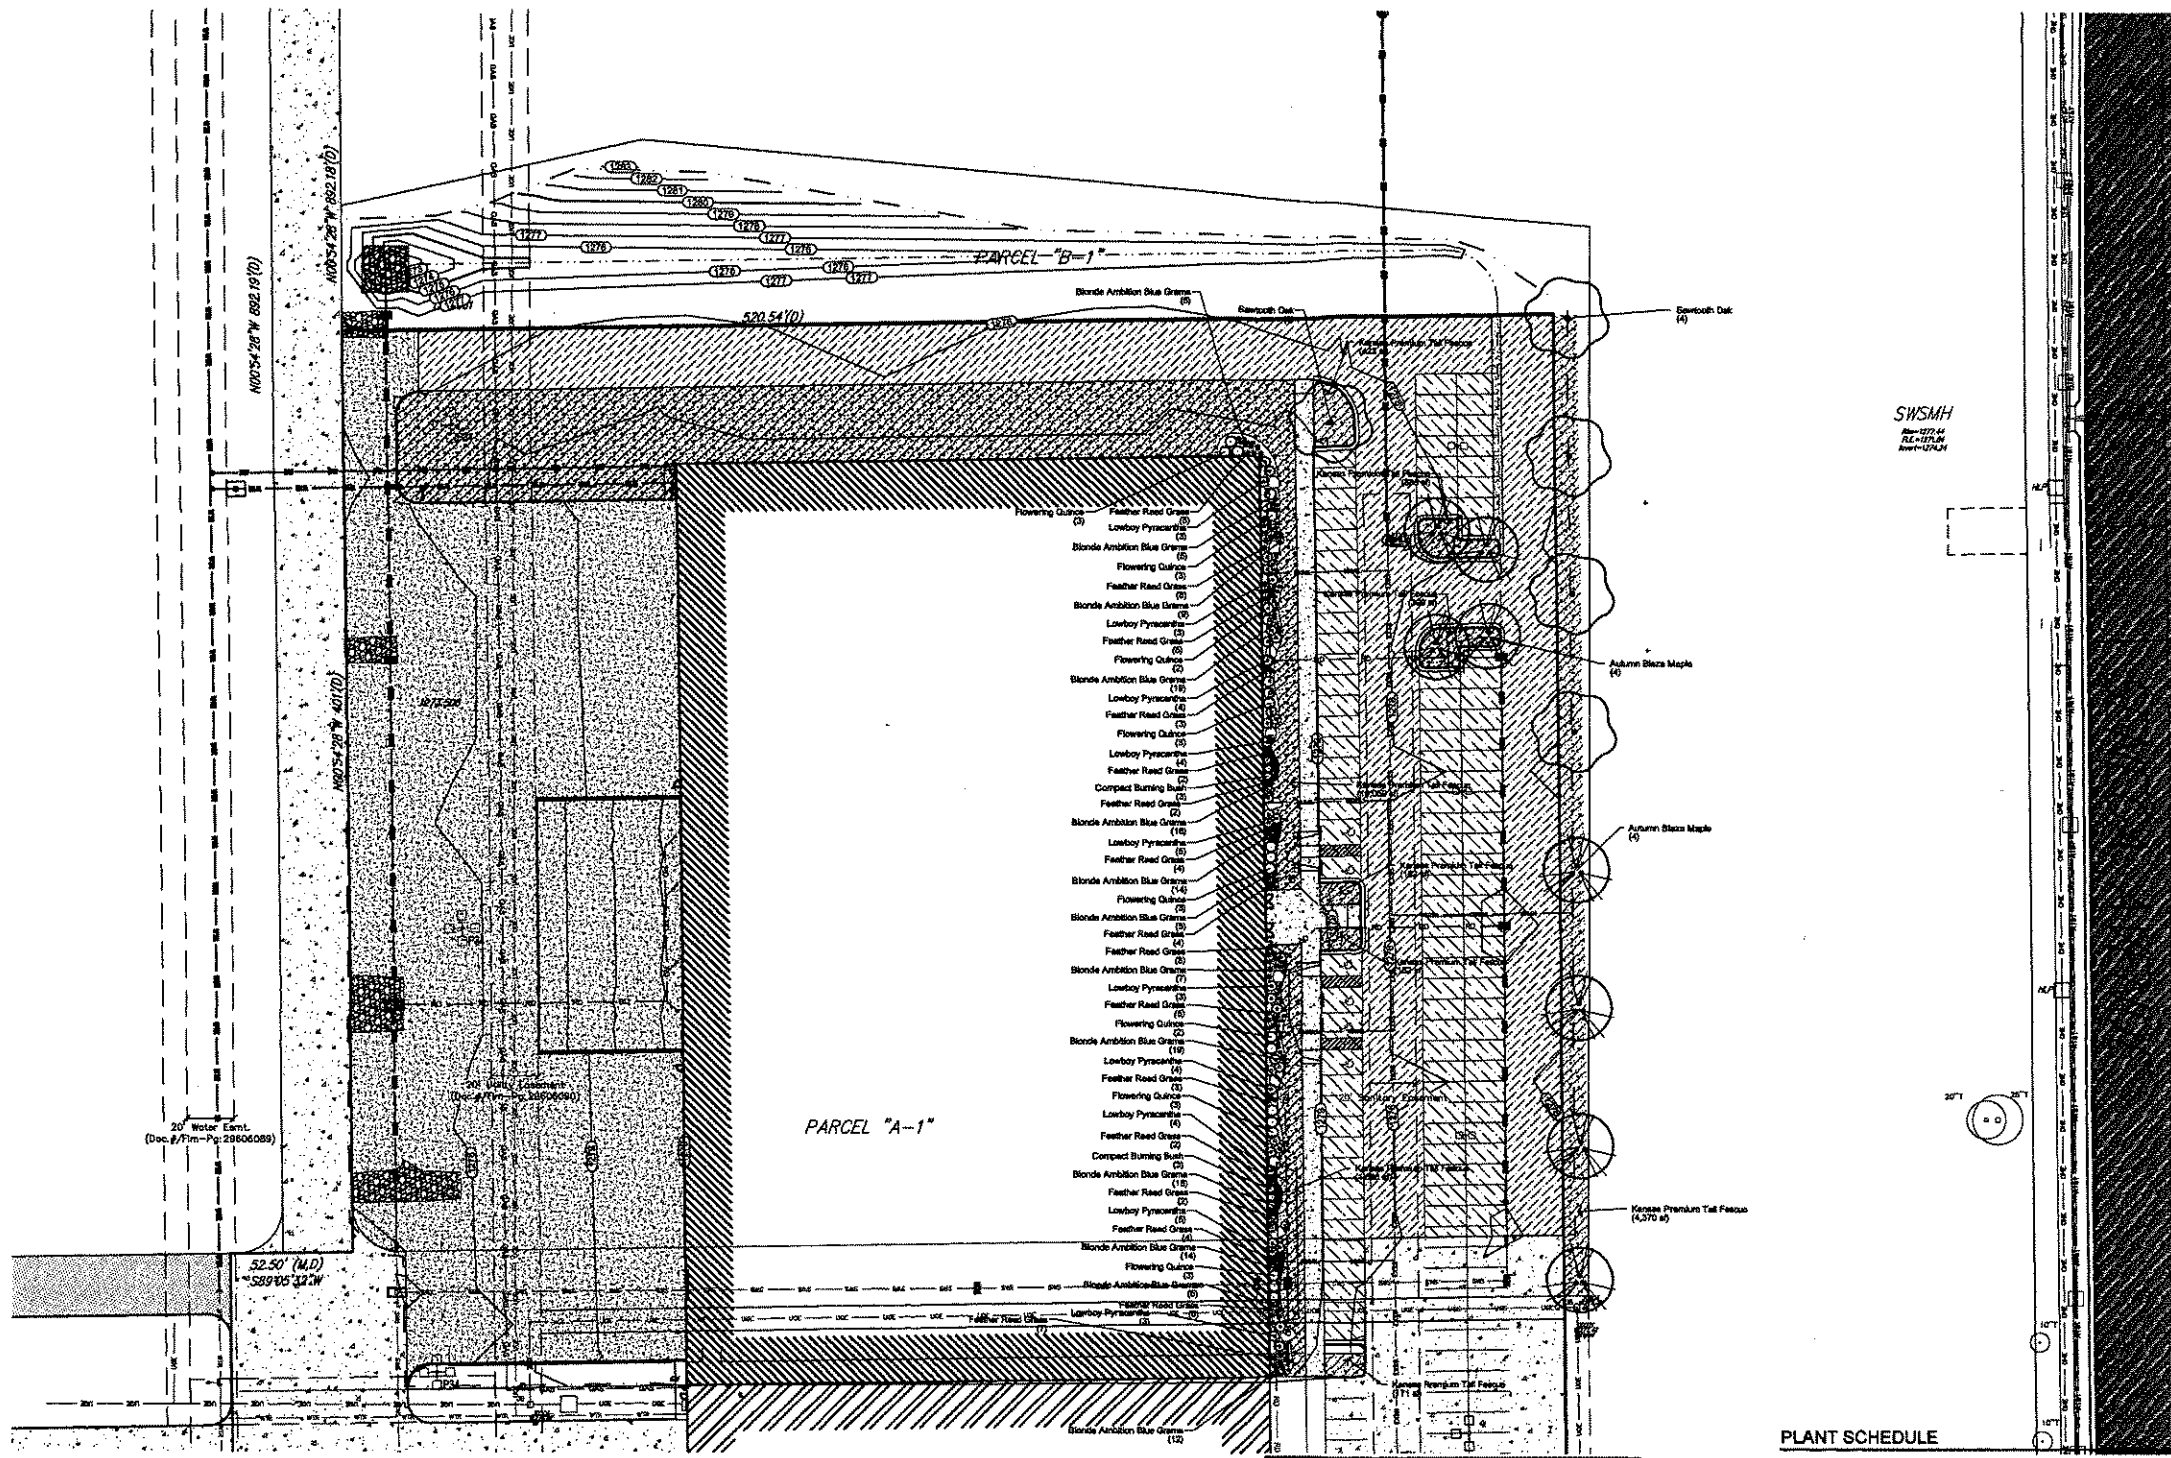

LANDSCAPE NOTES

- All landscape work shall be done in accordance with industry standards.
- All areas called out as seeded shall be seeded at 2.5 to 3 lbs per 1,000 sq ft and fertilized at 40 lbs per acre.
- Trees with broken leaders or no central leader will not be accepted.
- All planting beds shall be prepared by killing all existing vegetation with Round-Up (or equal) according to label directions. A Pre-emergent herbicide such as Trifluralin (5%) (or equal) shall be applied per label directions. All planting beds to receive 2" organic matter (such as cotton bur mulch, compost, or humus) and shall be rototilled in to a depth of 10-12".
- Mulch all planting beds with min. 2" of mulch. Mulch all tree mulcher runs with min. 3" of mulch. Mulch material to be premium cedar mulch of uniform consistency.
- Metal edging shall be used to separate all turf areas from planting beds. Edging shall be 10 gauge thickness, commercial grade, or approved equal.
- General Contractor to supply and place at a depth of 4", all topsoil on site within the limits of construction.
- Topsoil hauled onto site shall be fertile, friable, natural loam topsoil, of uniform quality characteristic of representative local soils which produces heavy growth of crops, grass, or other vegetation. It shall be free of trash, or other matter toxic to plant growth.
- Topsoil shall be delivered in an unfrozen and non-muddy condition and shall be subject to approval by the Landscape Architect.
- Prior to any excavation for landscaping purposes the location of underground utilities shall be determined by calling Kansas One Call at 847-347070/800-344-7233. Contractor shall be responsible for any damage done to existing utilities.
- Report any discrepancies in the planting plan to the Landscape Architect, prior to starting construction.
- The Landscape Contractor shall coordinate with the G.C. to gain site access to install the plants and maintain grounds, until final acceptance from owner. Upon final acceptance, the one (1) year guarantee period will begin.
- The Landscape Contractor shall coordinate with the G.C. to install the plants and maintain grounds, until final acceptance from owner.
- The Landscape Contractor shall submit bid with unit prices for all plants, including mulch, installation, 1 year guarantee, bed preparation, fertilizer, etc.
- The Landscape Contractor is responsible for any damage done to the exterior of the building or any part of the parking lot when installing or maintaining the plantings before final acceptance.
- Final planting season shall be September 1 thru October 31. Spring planting season shall be April 1 thru June 30. For grass seeding, fall season shall be September 1 thru mid October. Spring season for seeding shall be from March 15 thru mid May.
- Landscape to be watered manually. If automatic system is requested by owner, contractor to consult irrigation notes below.

IRRIGATION NOTES

- All irrigation work is to be installed in compliance with all local codes and regulations.
- Irrigation Contractor shall design system so turf heads are on separate zones from shrub spray heads.
- The Irrigation Contractor DOES NOT START irrigation construction until final shop drawings are submitted and approved to the Landscape Architect and/or Owner prior to construction for final approval which includes: Pipe, Rainbird, Toro, Hunter products, or approved equal, which will illustrate type of head, head coverage, valve location, piping and accessories, and main line location. Included in shop drawings show zone pressure, valve size, GPM requirements and pipe sizing. Also specify a rain switch or moisture sensing device per City Codes.
- Prior to construction, Irrigation Contractor to locate all exist and proposed utilities and electrical wiring.
- Contractor shall not install irrigation system when any obstructions in the field exist. Contact the Landscape Architect for clarification before proceeding around obstructions.
- All irrigated turf areas shall be head-to-head coverage with triangle spacing where possible. Contractor is responsible for adequate coverage in shrub bed zones using drip system and/or spray heads. Per Owner's request, the Buffalo Grass will not be irrigated.
- Heads to be adjusted to not spray on buildings, walls, or drives. Spray heads will be located nearest to planting bed edge using funny pipe and fittings. Spray heads to be located and sized so not to be susceptible to damage by automobile overhangs.
- Irrigation Contractor shall coordinate with Paving Contractor to locate and install required irrigation lines slopping prior to any paving. Combine piping when possible to save on slopping material. Slopes to be min. .02" below finish grade. Verify final depth w/ Paving Contractor for adequate coverage.
- Automatic drainage valves to be located at the ends of lines and at the lowest points on the lines.
- Irrigation Contractor to verify location of water supply with GC prior to installation of system. Irrigation Contractor shall verify static pressure.
- Locate Irrigation Controller per Owner's direction.

PLANT SCHEDULE

TREES	QTY	BOTANICAL NAME	COMMON NAME	GHNT	GAL
	8	<i>Acer freemanii</i> 'Autumn Blaze'	Autumn Blaze Maple	B & B	3" Cal
	5	<i>Quercus acuminata</i>	Sawtooth Oak	B & B	
SHRUBS	QTY	BOTANICAL NAME	COMMON NAME	GHNT	POINTS
	145	<i>Bouteloua gracilis</i> 'Blonde Ambition'	Blonde Ambition Blue Grama	1 gal	
	60	<i>Calamagrostis x acutiflora</i> 'Karl Foerster'	Feather Reed Grass	2 gal	
	22	<i>Chamaeneris speciosa</i> 'Scarlet Storm'	Flowering Quince	3 gal	
	6	<i>Euonymus alatus</i> 'compactus'	Compact Burning Bush	3 gal	
	38	<i>Pyraeantha coccinea</i> 'Lowboy'	Lowboy Pyraeantha	3 gal	
GROUND COVERS	QTY	BOTANICAL NAME	COMMON NAME	GHNT	POINTS
	23,817 sf	<i>Festuca arundinacea</i>	Kansas Premium Tall Fescue		

LANDSCAPE ORDINANCE CALCULATIONS

Street Yard Requirements for Seneca	
Lot Width	485 ft
Average Lot Depth	320 ft
Square Footage Factor	20
Required Landscape Street Yard	8,302 Sq. Ft.
1 Shade Tree Required per 500 Sq. Ft.	19 Shade Trees required
Parking Lot Tree Requirement	
All parking stalls are beyond 150' from FL	
Total Trees Required	19 trees
	13 Shade Trees
	60 (6) Shrubs (10 Shrubs=1 Tree)
	19 total trees
	12,283 Sq. Ft. of Street Yard

LEGAL DESCRIPTION

Parcel A-1 of Lot 1, Cross Gate Addition, Wichita, Sedgewick County, Kansas.

SITE INFORMATION

Total Area:	554,525.5 sq. ft. (12.73 acres)
Disturbed Area:	260,000 sq. ft. (5.97 acres)
Building:	
Existing Building:	100,000 sq. ft. (2.30 acres)
Proposed Building:	100,000 sq. ft. (2.30 acres)
Impervious Area, pre-constr:	
Existing Impervious Area:	236,603 sq. ft. (5.43 acres)
Demo Impervious Area:	19,811 sq. ft. (0.46 acres)
Proposed Impervious Area:	199,811 sq. ft. (4.53 acres)
Impervious Area, post-constr:	416,471 sq. ft. (9.56 acres)

BENCHMARKS

BM#1: Mag w/ Baughman Washer, west edge of pavement, 376' S. of NW corner of Res. C. Elev. = 1278.57 (NAVD 88)
 BM#2: "crowfoot", NW corner of

LANDSCAPE PLAN
 Scale 1" = 30'-0"

LANDSCAPE PLAN
 APPROVED 1/22/20 BY NES
 PJD-46



COSMIC PET EXPANSION
 1315 W MacArthur Rd, #600 & #500
 Wichita, Kansas



L1.0
 LANDSCAPE PLAN