

DEVELOPMENT GUIDELINES

1. Area: The total development contains 8.554 acres of land more or less.

2. Parcel Descriptions:

Parcel 1

Gross Area = 7.086 Ac or 308,677 s.f.
Maximum Height of Unoccupied Architectural Elements = 55 feet
Maximum Height of Occupied Space = 40 feet/2-story maximum
Maximum Coverage = 30%
Max. Gross Floor Area = 35%
Setbacks - 35' except on the north end of Parcel 1 and where adjacent to Parcel 2 which shall be 0' (see G.P.B)

Parcel 2

Gross Area = 0.345 Ac or 15,060 s.f.
Maximum Height of Unoccupied Architectural Elements = 55 feet
Maximum Height of Occupied Space = 40 feet/2-story maximum
Maximum Coverage = 50%
Max. Gross Floor Area = 50%
Setbacks - 0' adjacent to Parcel 1 (see G.P.B)

Parcel 3

Gross Area = 1.123 Ac or 48,951 s.f.
Maximum Building Height = 35 feet
Maximum Coverage = 30%
Max. Gross Floor Area = 35%
Setbacks: 35' Front (east)
35' Rear (west)
25' Side (north)
0' Side (south) subject to appropriate fire wall / separation

3. The following uses are permitted for all Parcels within the C.U.P.:

A. ALLOWABLE USES: For Parcels 1 and 2 all uses permitted within the LC Zoning District. Additionally, restaurants serving liquor are allowed, provided that food is the primary service of the establishment, and also restaurants having outdoor seating are allowed within 200 feet of residential zoning by right per (CUP Amendment #1) Article III, Sec. III-D, 6.w.
Parcel 3 shall be limited to the following GO Zoning District uses: Bank and/or Financial Institution with Drive Thru's permitted by right, and Office general.

B. EXCLUDED LC USES: No Parcels within this C.U.P. shall allow use of Adult entertainment establishment, Residential use, Cemetery, Church or place of worship, School K-12, College or university, Community assembly, Convalescent care facility, Group home, Hospital, Recycling process center, Reverse vending machine, Pawn shop, Utility, Car wash, Construction sales and service, Nightclub, Tavern and drinking establishment, Vehicle repair, Vocational school, Wireless communication facility, Asphalt or concrete plant, Storage.

C. The uses permitted by the C.U.P. are only those uses permitted by right and not by conditional use unless specifically identified.

4. Architectural Controls:

All building within the C.U.P. shall share a uniform architectural character, color, and same predominate exterior building material, as approved by the Director of Planning. Building walls and roofs must have predominately earth-tone colors, with vivid colors limited to incidental accents, and must employ materials similar to surrounding residential areas.

5. Title:

The transfer of the title on all or any portion of the land included in the Community Unit Plan does not constitute a termination of the plan or any portion thereof; but said plan shall run with the land for commercial development and be binding upon the present owners, their successors and assigns. However, the Director of the MAPD, with the concurrence of the Zoning Administrator, may approve minor adjustments to the conditions in this overlay, consistent with the approved development plan, without filing a formal ordinance amendment.

6. Landscaping for this site shall be required as follows:

A. Landscaped street yards, buffers, and parking lot landscaping and Screening - Shall be in accordance with the City of Wichita Landscape Ordinance, unless otherwise stated below.

B. No landscaping shall be required adjacent to existing screen wall along the westerly boundary of Parcel 1, so long as there is code compliant screening and landscaping on the abutting property. Berming and landscaping on top of the berm was installed by the CUP development for the benefit and maintenance of the adjoining Homeowners Association as a condition of development.

C. A 12 foot wide landscape buffer shall run parallel with the west and north property lines of Parcel 3 where abutting residential areas/zoning. Said landscape buffer may be reduced to allow for a drive isle on the north, so long as the landscaping within that portion of the buffer meets or exceeds 1.5 times the requirements of the Landscape Ordinance.

D. A landscape plan shall be prepared by a Kansas licensed Landscape Architect for the above referenced landscaping, indicating the type, location, and specifications of all plant material. This plan shall be submitted to the Metropolitan Area Planning Department (MAPD) for its review and approval prior to issuance of any building permit(s).

E. A financial guarantee for the plant material approved on the landscape plan for that portion of the C.U.P. being developed shall be required prior to issuance of any occupancy permit, if the required landscape has not been planted.

7. Screening for this site shall be required as follows:

A. Rooftop mechanical equipment shall be screened from ground level view per Wichita-Sedgwick County Unified Zoning Code or as stated below.

B. Trash receptacles, loading docks, outdoor storage, and loading areas shall be appropriately screened to reasonably hide them from ground view except, if not visible from public rights-of-way or if not directly visible from ground view from adjoining residential areas/zoning. The screening materials shall be consistent with materials and colors of the supported buildings. Trash enclosures shall be allowed within 20 feet of property line if not visible from public rights-of-way but shall not be closer than 5 feet from the westerly property lines. Trash enclosures are not permitted along north boundary of Parcel 3 and there shall be no outdoor storage allowed on Parcel 3.

C. Outdoor display and storage shall be subject to all conditions of Article III, Sec. III-B.14.e for Parcels 1 and 2.

D. Screening adjacent to existing SF-5 zoned property to be provided by existing concrete wall. No screening shall be required on or adjacent to Parcel 2 or along the north line of Parcel 1. No landscaping shall be required adjacent to existing screen wall per G.P.B.B.

E. Unless otherwise noted hereon, screening shall be in accordance with the Wichita-Sedgwick County Unified Zoning Code, Section IV and Section III-C.2.b.

8. Setbacks:

Setbacks are as indicated on the C.U.P. drawing or as specified in Wichita-Sedgwick County Unified Zoning Code. If contiguous Parcels are to be developed under the same ownership, setbacks between those Parcels are not required. Parcel 2 has zero building setback, provided appropriate fire walls and/or building separations are provided. Also see Parcel Description.

9. Signs: As permitted under the Sign Code of the City of Wichita, additionally, the following conditions apply:

A. All parcels shall adhere to the requirements of the Sign Code for the City of Wichita for LC Zoning District, except as provided herewith.

B. No flashing, animated or moving, portable, billboard, banner, off-site, or pennant signs shall be permitted except however, two electronic message signs are allowed along Webb Road; one on Parcel 1 and one on Parcel 3.

C. All signs along and adjacent to 13th and Webb streets shall be monument type signs with a maximum height of 20 feet, except for Parcel 3 where no monument signs shall exceed 12 feet in height.

D. Eight monument signs are permitted: Five along Webb Road and three along 13th Street. The sign areas shall be limited to a maximum of 150 square feet each along Webb Road and 145 square feet each along 13th Street. Standalone development identification signs shall count against the above total allowed seven monument signs. Development identification signs may also have tenant signage. No illuminated monument signs over 10 square feet are allowed within the north 150 feet of Parcel 3.

E. The minimum distance between monument signs shall be 120 feet, except tenant signs may be located a minimum distance of 50 feet when adjacent to a development identification only sign.

F. Building signage shall be permitted within the C.U.P. Building signage on Parcels 1 and 2 shall be limited to 20% of the wall area with no single tenant sign exceeding 400 square feet in area, and there shall be no more than six signs for each tenant (business) on each building elevation. Buildings signage on Parcel 3 shall be limited to a total of 250 square feet. There shall be no building signage along the westerly facades of any buildings on Parcels 1 and 3 abutting the western boundary of the CUP, nor shall any building signage of any kind be allowed on any buildings facing the northerly line of Parcel 3, except for illuminated Drive Thru /ATM signage cumulatively not to exceed 6 square feet in area is allowed. Such Drive Thru signage shall be illuminated during business hours only; such ATM signage may be illuminated outside business hours.

G. Accent lighting of monument and directional/way-finding signs shall be permitted.

H. Window signage shall be limited to 25% of window area.

I. Directional signs are permitted and shall not exceed 10 square feet in area each.

J. One temporary sign of 70 square feet that will have its message replaced three times during an 90 day time period is allowed. The 90 day time period shall begin running from the time the sign permit is issued.

10. Lighting:

A. Lighting shall be in accordance with the Wichita-Sedgwick County Unified Zoning Code, Section IV.

B. All Parcels shall share similar or consistent parking lot lighting elements (i.e. fixtures, poles and lamps and etc.), as approved by the Director of the MAPD.

C. All lighting shall be shielded to direct light disbursement in a downward direction and directed away from residential areas.

D. Light poles including above ground bases shall be limited to 28 feet tall and no light poles shall be within 100 feet of residential zoning, except however on the north line of Parcel 3, where two light poles may be located no closer than 12 feet of the north property line having a maximum height of 15 feet with shielding to cast light in a downward direction and directed away from residential areas/zoning to the north; and except however on the east line of Parcel 3, where one light pole may be located no closer than 30 feet of the west property line having a maximum height of 15 feet with shielding to cast light in a downward direction and directed away from residential areas/zoning to the west. No wall-pack lighting is allowed within the north 150 feet of Parcel 3, unless however such wall-pack lighting is shielded to cast light in a downward direction and directed away from residential areas/zoning and such wall-pack shall not be placed higher than 10 feet off the ground.

E. Extensive use of back lit canopies and neon or fluorescent tube lighting on buildings is not permitted.

11. Parking:

All Parcels, shall be in accordance with the Wichita-Sedgwick County Unified Zoning Code, Section IV, unless otherwise specified.

12. No occupancy permits shall be issued for any development without services by municipal water and sewer services.

13. The following transportation improvements and Parcel access shall be provided:

A. Cross-lot circulation agreements shall be required at the time of platting to assure internal vehicular movement between Parcels within the C.U.P. if platting as one lot and developed under one ownership.

B. Guarantees for specific street improvements for 13th and Webb road shall be determined at the time of platting by the Traffic Engineer.

C. Access controls shall be per VAC2013-0008, or as amended.

14. Grading Plans:

A lot grading plan will be prepared in conformance with the Drainage Concept Plan for review prior to the issuance of a Building Permit. A drainage plan shall be submitted to the City Engineer for approval. Required guarantees for drainage shall be provided at the time of platting.

15. All new utilities shall be installed underground.

16. Final determination of minimum pad elevations (at least 2 feet higher than the 100 year flood elevation), street right-of-way, easements, reserves, and pavement widths on public private streets shall be resolved at the time of platting.

17. The development of this property shall proceed in accordance with the development plan as recommended for approval by the Planning Commission and approved by the Governing Body, and any substantial deviation of the plan, as determined by the Zoning Administrator and the Director of Planning, shall constitute a violation of the building permit authorizing construction of the proposed development.

18. Any major changes within this Community Development Plan shall be submitted to the Planning Commission and the Governing Body for their consideration. Amendments, adjustments, or interpretations to the C.U.P. shall be done in accordance with the Unified Zoning Code.

19. Music played outdoors between the hours of 10 PM and 9 AM shall be prohibited. Trash pickup/removal during these hours is also prohibited.

20. A pedestrian circulation plan shall be approved by the Planning Director prior to the issuance of building permits. Said plan shall link all buildings in the development with the arterial sidewalks on Webb Road and 13th Street North.

21. Fire lanes shall be in accordance with the Fire Code of the City of Wichita. No parking shall be allowed in said fire lanes, provided however, they may be used for passenger loading and unloading. The Fire Chief or the designated representative shall review and approve the location and design of all fire lanes. Fire hydrant installation and paved access to all building sites shall be provided for each phase of construction prior to the issuance of building permits.

LEGEND

- Existing Trees

- Existing Evergreens

- Existing Masonry Wall

LEGAL DESCRIPTION

Lot 1, Block 1, Foliage Center Addition, an addition to Wichita, Sedgwick County, Kansas, TOGETHER WITH, Lot 1, Block 1, Foliage Center Second Addition, an addition to Wichita, Sedgwick County, Kansas.

N. Foliage Dr.

COMMUNITY UNIT PLAN DP-282
FOLIAGE CENTER


DEVELOPER / OWNER: Beech Lake Investments, LLC 1223 N. Rock Rd. Bldg H, Suite 200 Wichita, KS 67206 (316) 636-2100

Amendment #2 CUP2014-25 Sept. 11, 2014
Amendment #1 CUP2014-17/ZON2014-14 Sept. 9, 2014
A.A.#3 CUP2014-10 April 28, 2014
A.A.#2 CUP2013-39 Nov. 4, 2013
A.A.#1 CUP2008-20 June 9, 2008
CUP2005-09 / ZON2005-06


PER CUP 2014-25
APPROVED CUP
DATE: 9-11-14 DM
MAPD COPY 1 of 2

SE. Cor., SE ¼,
Sec. 8, T27S,
R2E, 6th P.M.

MKEC Engineering, Inc.
411 N. Webb Rd.
Wichita, KS 67206

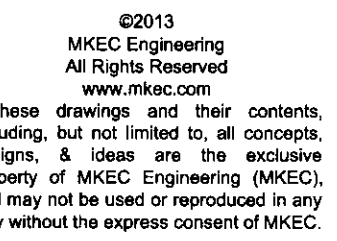

I-100

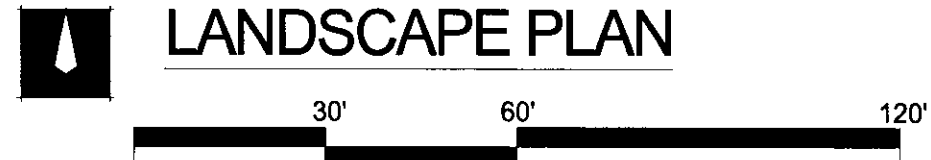


J:\CIVIL\04274\DWG\WHOLEFOODS\LANDSCAPE PLAN - NORTH.DWG
PLOT DATE: Tuesday, August 20, 2013 @ 03:11 PM

PAVING AND INCIDENTAL DRAINAGE PLANS FOR

WHOLE FOODS MARKET


13TH & WEBB WICHITA, KS

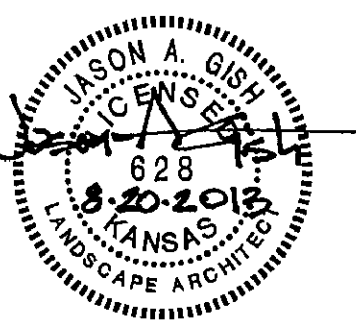

©2013
MKEC Engineering
All Rights Reserved
www.mkec.com
These drawings and their contents, including, but not limited to, all concepts, designs, & ideas are the exclusive property of MKEC Engineering (MKEC), and may not be used or reproduced in any way without the express consent of MKEC.

LANDSCAPE PLAN

PROJECT NO.	0401012274	
DATE	8/19/2013	
SCALE	1"=30'	
DESIGNED	DRAWN	CHECKED
MKEC	RKO	JAG
#	#####	
NO.	REVISION	DATE

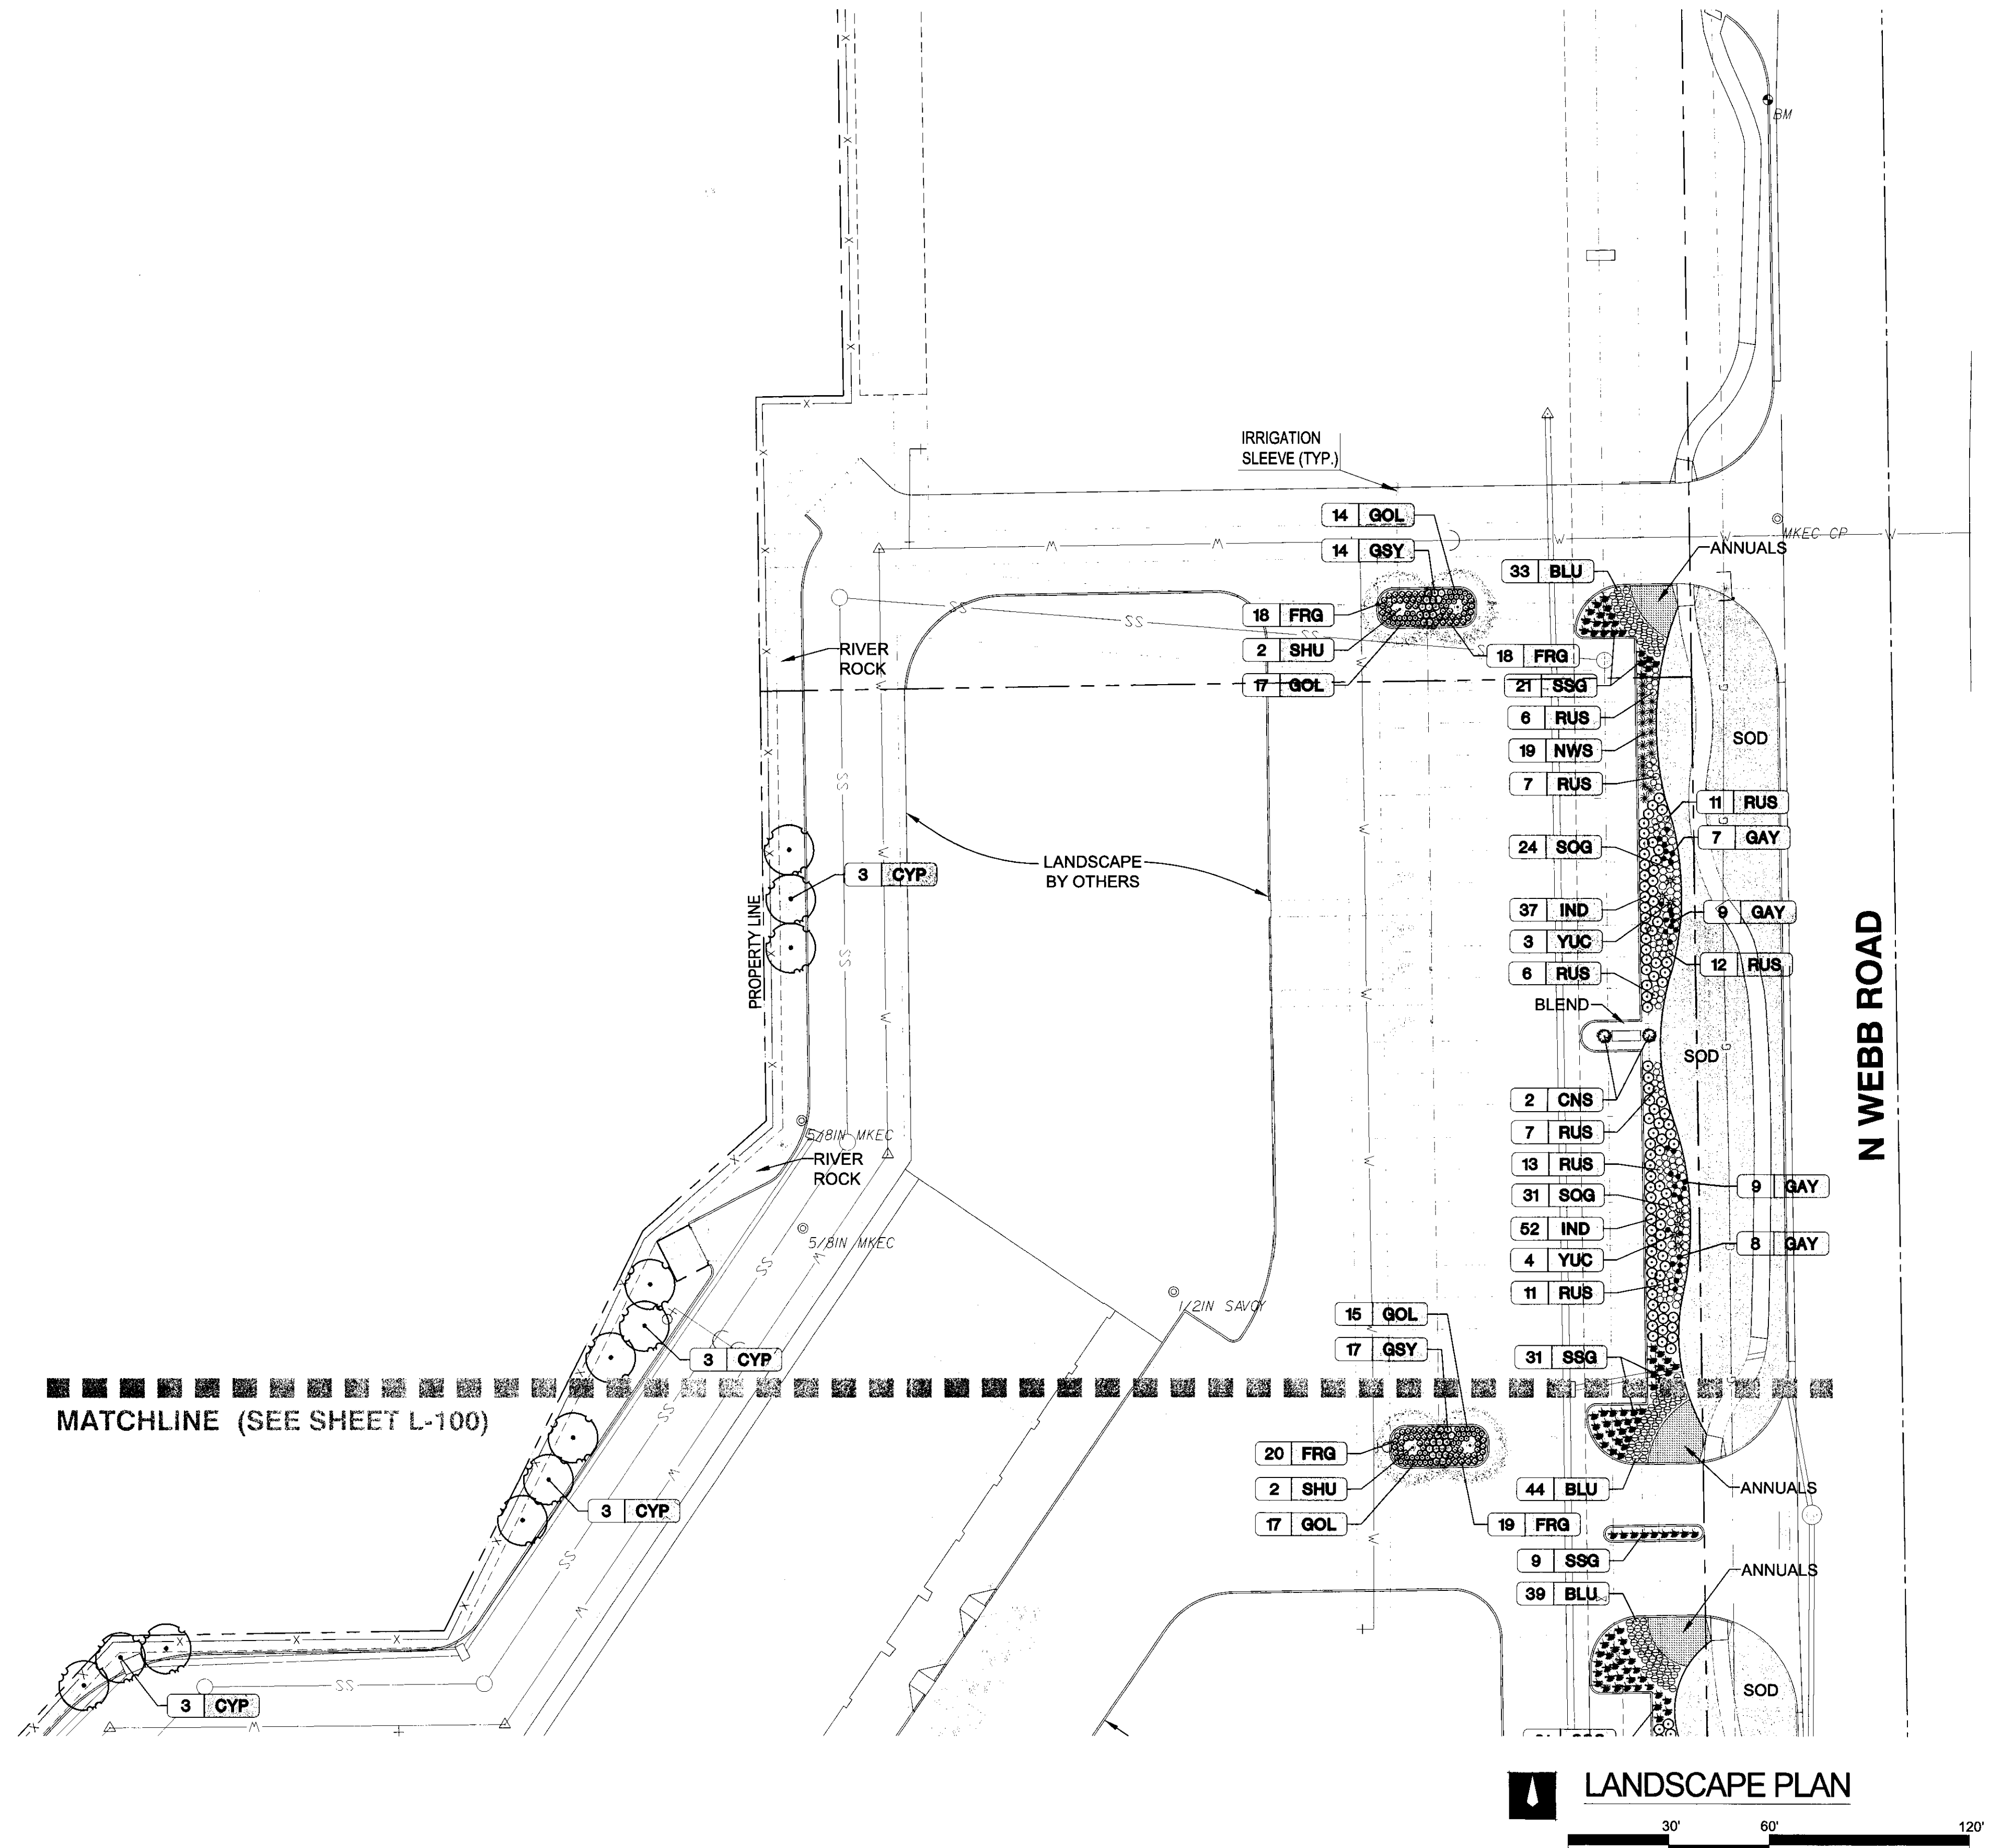

- RELATED TO THE LANDSCAPE AND IRRIGATION.
2. LANDSCAPE CONTRACTOR IS TO VERIFY THE LOCATION OF ALL UNDERGROUND UTILITIES (INCLUDING THOSE INDICATED ON THE PLAN) PRIOR TO INSTALLATION OF PLANT MATERIAL. UTILITIES CAN BE FLAGGED BY CALLING 811, OR 1-800-344-7233, OR ONLINE AT www.kansasonecall.com. DAMAGE TO UTILITIES SHALL BE AVOIDED DURING THE COURSE OF WORK. THE LANDSCAPE CONTRACTOR IS RESPONSIBLE FOR REPAIRING ANY AND ALL DAMAGE TO UTILITIES, STRUCTURES, SITE APPURTENANCES, ETC. WHICH OCCUR AS A RESULT OF THE LANDSCAPE CONSTRUCTION.
3. LANDSCAPE CONTRACTOR SHALL COORDINATE WITH THE MASS GRADING CONTRACTOR TO INSURE THEY THOROUGHLY RIP AND ALLEVIATED ALL COMPACTED SOILS FROM THEIR HAULING AND PLACEMENT OPERATIONS.
4. ALL WATER REQUIRED FOR LANDSCAPE OPERATIONS AND FOR ESTABLISHING LANDSCAPE ON THIS SITE WILL BE PROVIDED BY THE OWNER FROM ON-SITE SOURCES AND SUPPLIED TO THE LANDSCAPE CONTRACTOR AT NO CHARGE.
5. PLANTING DATES FOR PLANT MATERIAL SHALL BE DURING THE MONTHS BETWEEN FEB. 15TH AND MAY 31ST OR SEPT. 15TH AND DEC. 15. PLANTING SHALL ONLY BE CONDUCTED WHEN THE GROUND IS NOT FROZEN, SNOW-COVERED, OR IN AN OTHERWISE UNSUITABLE CONDITION FOR PLANTING. DEVIATION FROM THE ABOVE PLANTING DATES WILL ONLY BE PERMITTED WITH APPROVAL FROM THE OWNER'S REPRESENTATIVE.
6. MULCHED LANDSCAPE BED EDGES SHALL BE LINED WITH PRO-STEEL EDGING (OR APPROVED EQUAL).
7. MULCH ADJACENT TO BUILDINGS SHALL BE SIX (6) INCHES LOWER THAN BUILDING FINISH FLOOR ELEVATION.
8. PLANTING SOIL AMENDMENTS FOR ALL BED AREAS SHALL BE THOROUGHLY MIXED INTO PLANTING BACKFILL TOPSOIL.
9. ALL SHRUB/PERENNIAL PLANTING BEDS SHALL BE TREATED WITH A PRE-EMERGENT HERBICIDE SUCH AS TREFLAN OR EQUAL. APPLY AS PER MANUFACTURER'S RECOMMENDATION. THE PRE-EMERGENT SHALL NOT BE APPLIED UNTIL AFTER ALL PLANTING AND MULCHING WITHIN THESE AREAS ARE COMPLETE. DO NOT DISTURB AREAS AFTER APPLICATION. WATER IN AS DIRECTED.
10. INSTALL 3" MIN. DEPTH BARK MULCH IN ALL PLANTING BED AREAS AND WITHIN A 3' DIAMETER CIRCLE AROUND ALL TREES PLANTED IN LAWN AREAS. SUBMIT 1 CU/FT SAMPLE FOR APPROVAL. PULL MULCH AWAY FROM TREE TRUNKS WITHIN 3" OF TRUNK.
11. IF POSSIBLE, BASED ON TIME OF YEAR SITE IS READY FOR LANDSCAPING, PLANT TREES PRIOR TO ROUTING/INSTALLING IRRIGATION LINES AND SUSTAIN TEMPORARILY BY WATERING WITH IRRI-GATOR® SLOW DRIP IRRIGATION BAGS OR BY HAND WATERING. FOLLOW TREE PLANTING WITH INSTALLATION OF IRRIGATION SYSTEM, THEN BY SODDING AND SEEDING (IF APPLICABLE).
12. FESCUE SOD SHALL BE HARVESTED & PLACED BETWEEN THE DATES OF APRIL 1ST AND JUNE 15TH UNLESS OTHERWISE APPROVED BY THE OWNER'S REPRESENTATIVE. IT IS THE CONTRACTOR'S RESPONSIBILITY TO WATER ALL SOD UNTIL LANDSCAPE JOB IS COMPLETE.
13. AREAS DENOTED AS 'SOD' SHALL BE PLANTED WITH THE FOLLOWING GRASS TYPE:
SOD:
GRAND N'W FESCUE/BLUE MIXTURE, OBTAINABLE FROM CRANMER GRASS FARM, INC., 6121 N. 119TH, MAIZE, KANSAS 67101, PH# (316) 722-7230.
FERTILIZER:
SEE SPECIFICATIONS
14. ALL SOD AREAS SHALL BE INSTALLED AS FOLLOWS: AFTER FINAL GRADE IS ESTABLISHED AND ALL SOIL AREAS DRAIN AS INTENDED, AND ALL SURFACE IRREGULARITIES HAVE BEEN REMOVED, THOROUGHLY PREPARE SODBED BY TILLING TO A MINIMUM DEPTH OF 3" AND HARROWING. ROLL SOD FOLLOWING LAYING FOR GOOD SOD/SOIL CONTACT AND KEEP IN A MOIST (BUT NOT SATURATED) CONDITION FOR FIRST TWO WEEKS TO PROMOTE GOOD ROOTING. FERTILIZE WITH 1 LB. ACTUAL NITROGEN PER 1,000 S.F. AT TIME OF PLANTING.

DP 202 PERD CIRC
APPROVED

William J. Lee
Date: 8-8-14

LEGAL DESCRIPTION

All of lot 1, block 1 Foliage Center Addition, an addition to Wichita, Sedgwick County, Kansas, together with, the south 43.00 feet of lot 1, block 1 Foliage Center Second Addition, an addition to Wichita, Sedgwick County, Kansas

Waterfront Plaza

Wichita, KS	PHASE 1	PHASE 2	PARKING REQ'D
"A" - WHOLE FOODS	30,800	0	124 stalls at 4:1
"B" - SMALL SHOP - (NO RESTAURANTS)	4,873	0	20 stalls at 4:1
"C" - SMALL SHOPS - (NO RESTAURANTS)	15,400	0	62 stalls at 4:1
"D" - SMALL SHOPS - (NO RESTAURANTS)	0	12,192	49 stalls at 4:1
FUTURE "E" BUILDING - RESTAURANT	0	4,000	62+185 seats at 3:1
TOTAL S.F.	51,273	16,192	
PARKING REQ'D PER PHASE	206	111	317
EXISTING PHASE 1 PARKING	329		
PHASE 2 PARKING		18+23	
TOTAL PHASE 1 & 2 PARKING PROVIDED			367
TOTAL H.C. STALLS REQUIRED	8	2	10
TOTAL PHASE 1 & 2 H.C. STALLS SHOWN			11


TOTAL SITE AREA = 523,737 S.F. AS LISTED ON CUP-182

TOTAL NON-PERVIOUS AREAS WITHIN PROPERTY INCLUDING PHASE 1 AND PHASE 2 PAVING, AND SIDEWALKS = 217,772 S.F.

TOTAL PERVIOUS AREAS = 30,500 S.F.

TOTAL BUILDING AREA = 67,465 S.F.

LEASING CONTRACT WITH WHOLE FOODS ONLY ALLOWS FOR (1) RESTAURANT TO BE PLACED ON THE WATERFRONT PLAZA PROJECT.

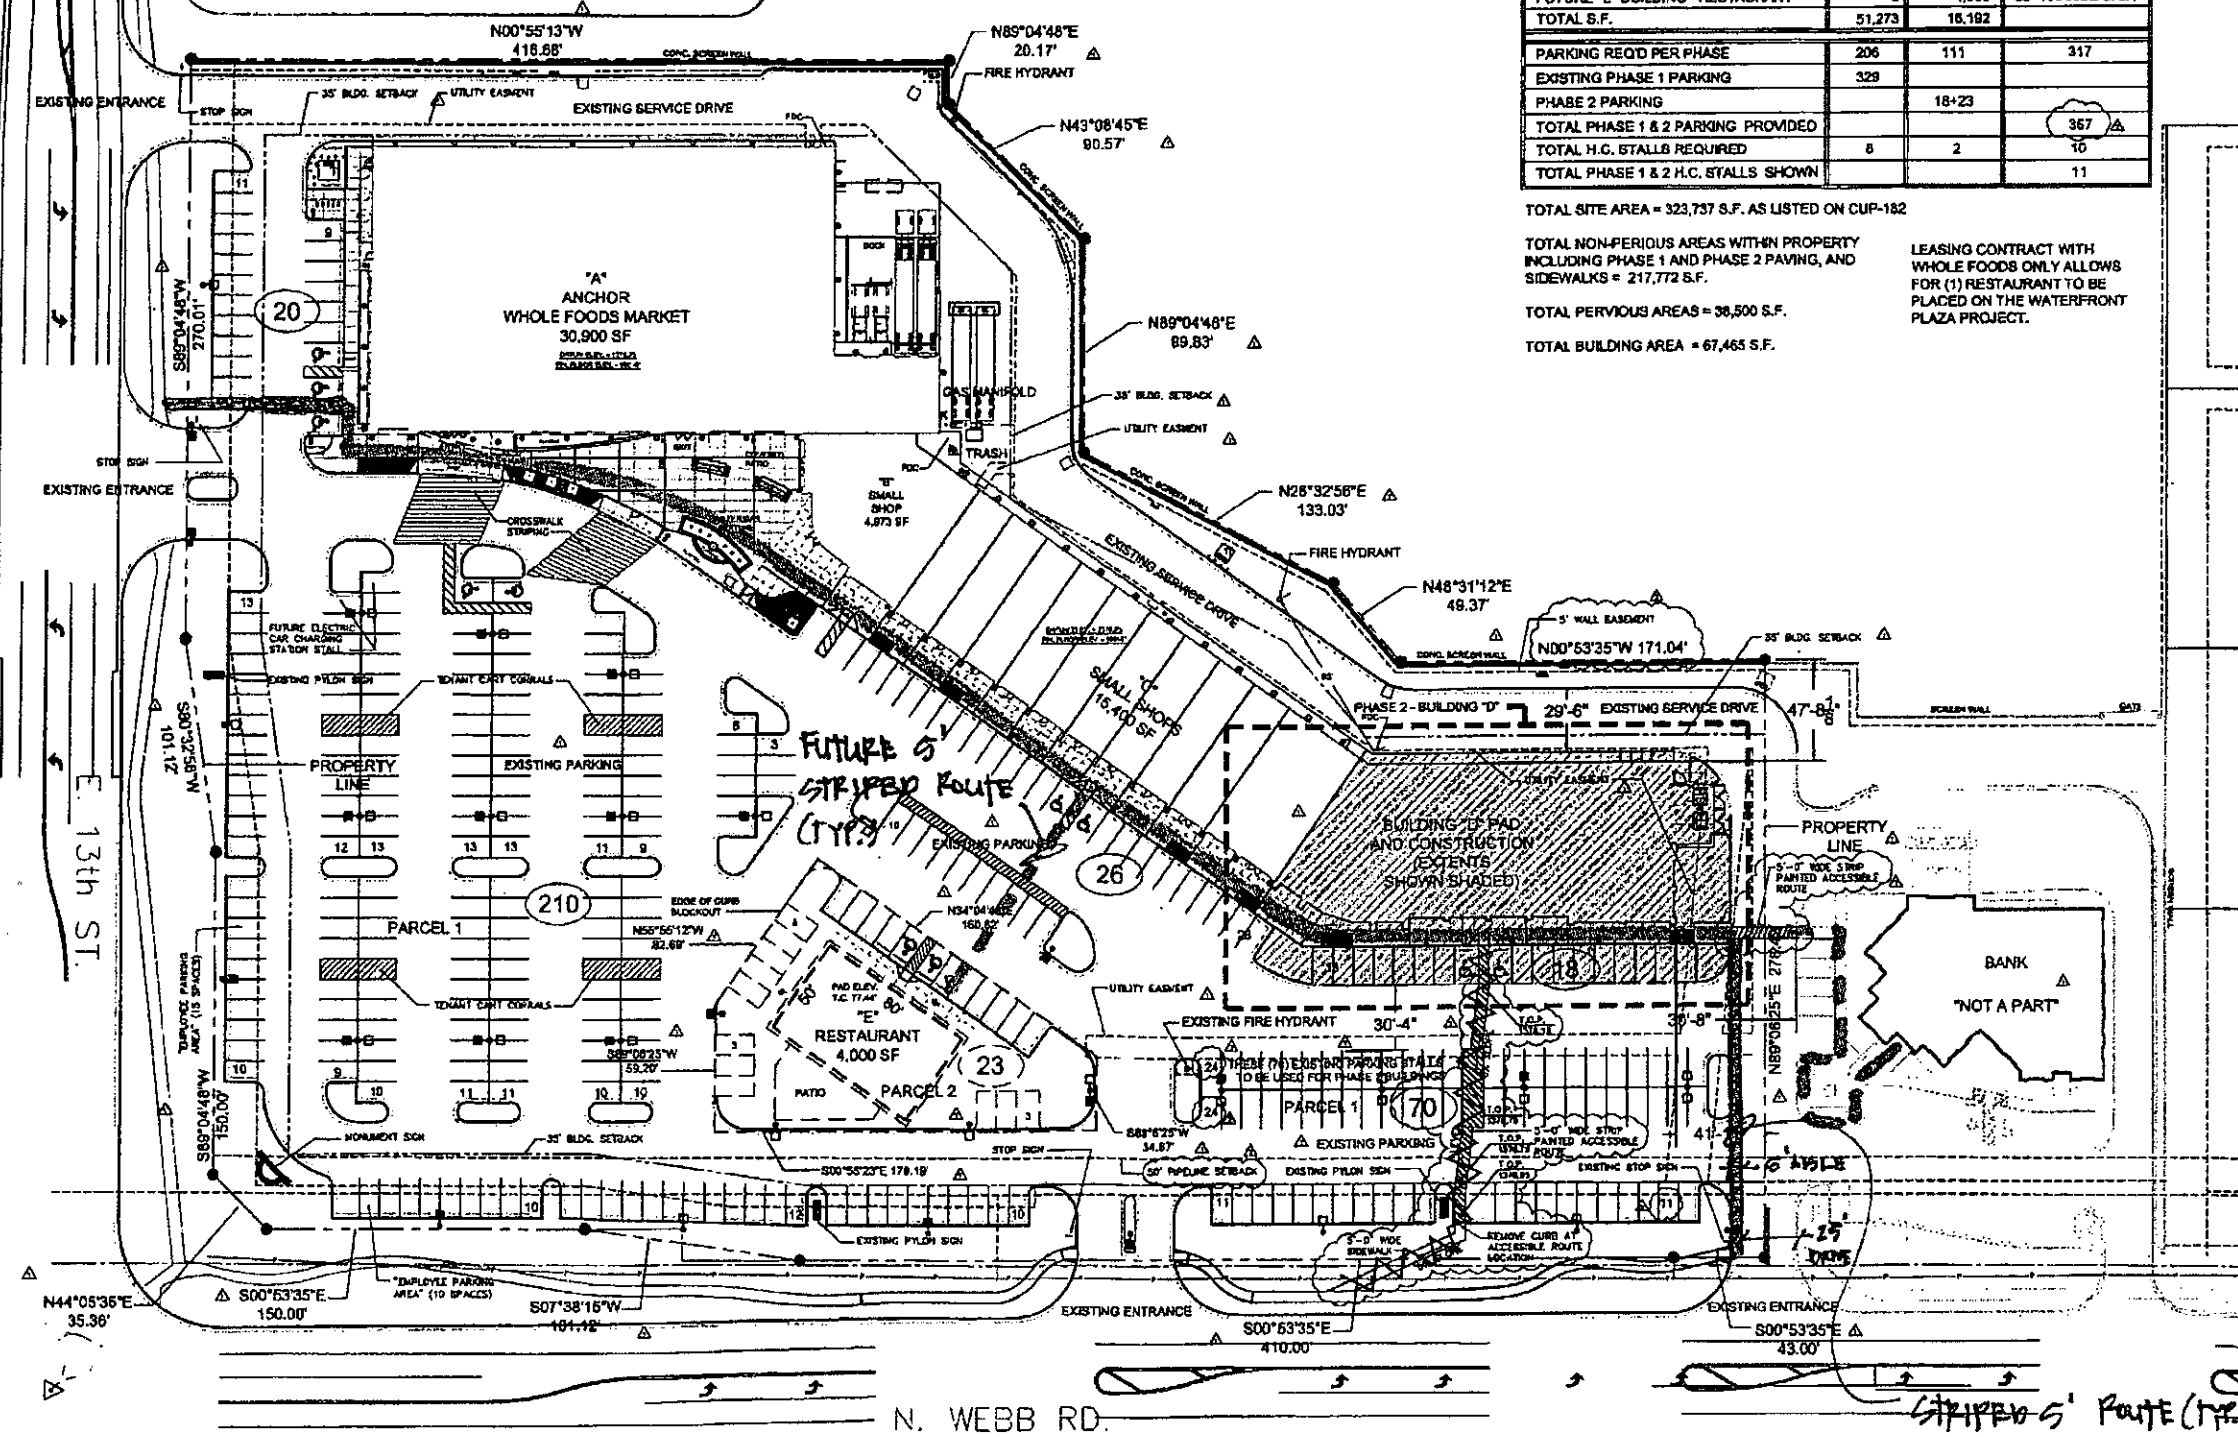


**PHASE 2 BUILDING D
WATERFRONT PLAZA:
1423 NORTH WEBB ROAD
WICHITA, KS**

LawKingtonArchitecture
Engineering • Planning • Interiors • Landscapes



LawKingtonArchitecture
345 Riverway, Wichita, KS 67203
T 316 266 0230 F 316 266 0205
CONTACTED SALES AT
BRIAN @
ONE.OOO
PROJECT NUMBER:

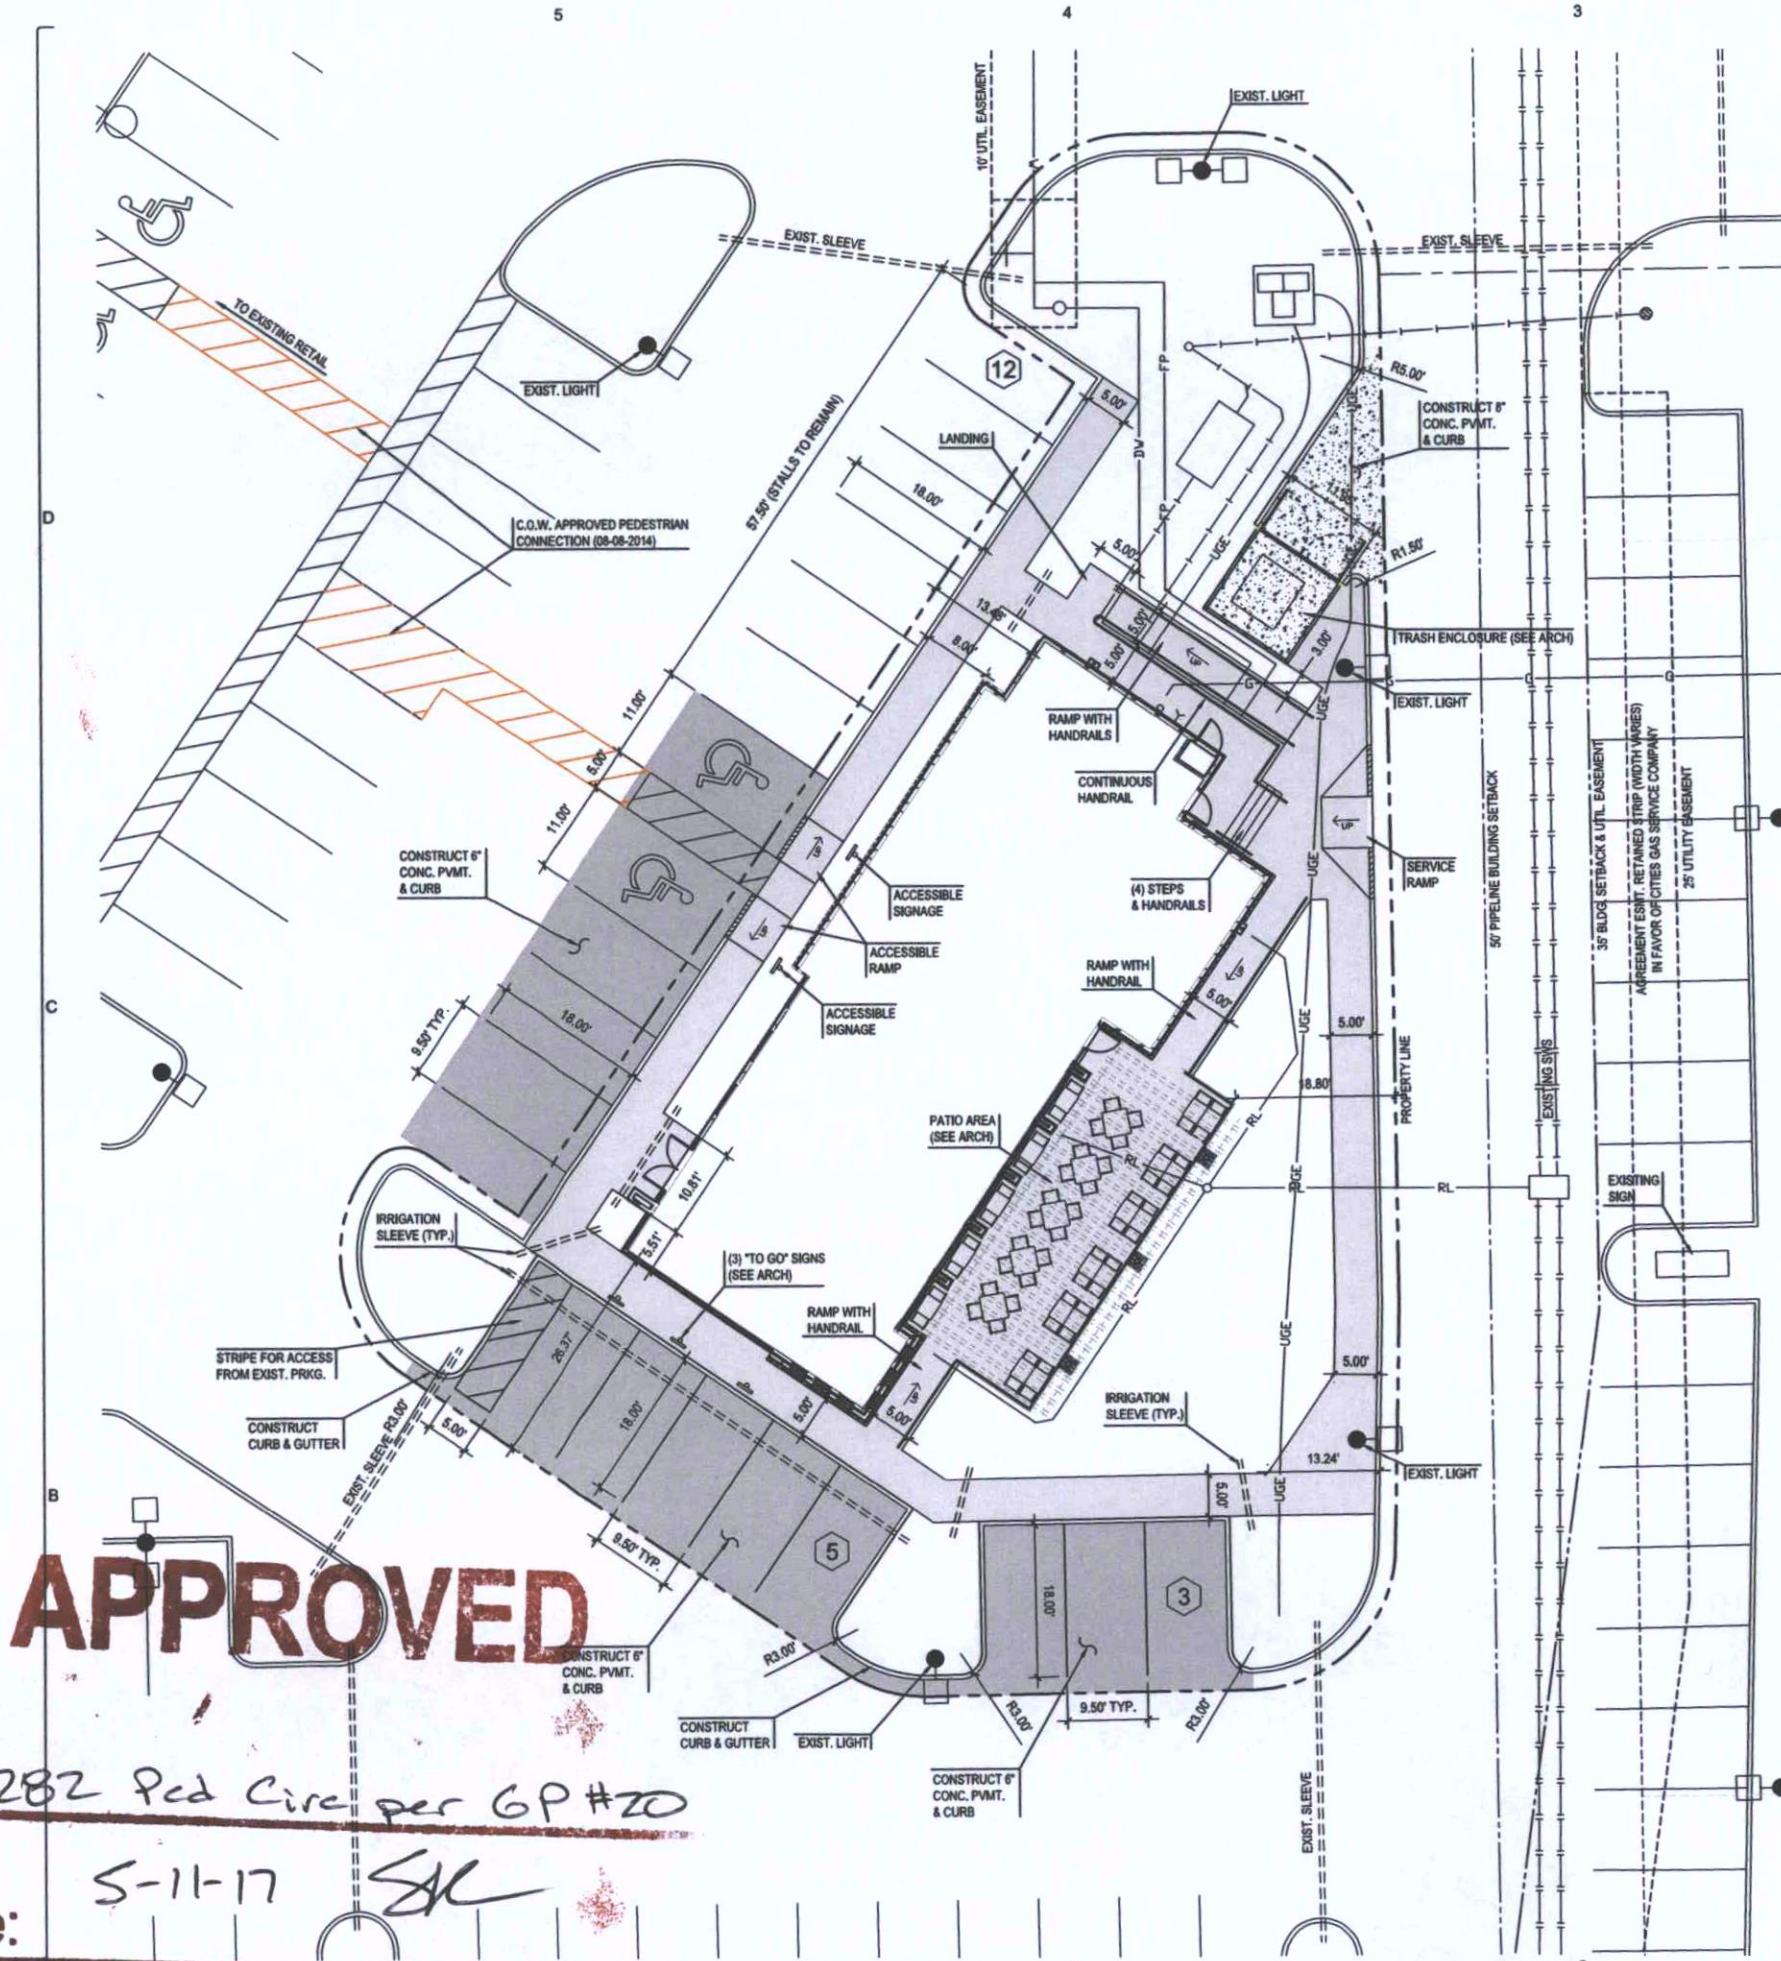

PAVING NOTES

- 1. ALL PAVEMENT, SIDEWALKS, CURB & GUTTER SHALL BE CONSTRUCTED IN ACCORDANCE WITH CITY OF WICHITA SPECIFICATIONS.
- 2. ALL DIMENSIONS ARE SHOWN TO FACE OF CURB UNLESS OTHERWISE NOTED.
- 3. "S" SHALL BE STAMPED INTO THE TOP OF CURB AT SLEEVE LOCATIONS.
- 4. REFER TO GEOTECHNICAL REPORT FOR PAVEMENT SUBGRADE OPTIONS AND SPECIFICATIONS.
- 5. EXISTING UTILITY VAULTS, RISERS, ETC. SHALL BE ADJUSTED VERTICALLY TO MATCH TOP OF PAVEMENT OR MOVED WHEN IN CONFLICT WITH NEW PROPOSED ROADS, PARKING AND WALKS.
- 6. INSTALL IRRIGATION SLEEVES IN THE LOCATIONS NOTED ON THE PLANS. TWO SLEEVES ARE REQUIRED IN EACH LOCATION: ONE (1) 1/2" AND ONE (1) 4" PVC CLASS 200 SDR 21 SLEEVES. BOTH SHALL EXTEND 18" BEYOND THE BACK OF CURB, BUILDING, OR SIDEWALK AND BE MARKED. INSTALL TEMPORARY T-POST MARKER AT SLEEVE ENDS.
- 10. CONTRACTOR SHALL COORDINATE ALL SLEEVING LOCATIONS WITH OTHER UTILITIES. ADDITIONAL SLEEVES MAY BE REQUIRED FOR OTHER USES SUCH AS LIGHTING, ETC.
- 11. SIDEWALKS SHALL NOT EXCEED 2% CROSS SLOPE OR 5% LONGITUDINAL SLOPE.
- 12. IN GENERAL, JOINT SPACING SHALL NOT EXCEED 24 TIMES THE CONCRETE THICKNESS.
- 13. BITUMINOUS IMPREGNATED FIBER BOARD TO BE PLACED AT FULL DEPTH OF CONCRETE BEHIND CURB ADJACENT TO DRIVEWAYS OR SIDEWALKS AND AT DIRECTION CHANGES OF CONCRETE WALKS. EXPANSION JOINTS ADJACENT TO & WITHIN CONCRETE SIDEWALKS SHALL BE 1/2" JOINTS WITH BITUMINOUS IMPREGNATED FIBER BOARD WITH A GREENSTREAK FIBER BOARD CAP. INSTALL CAP AND SELF-LEVELING SEALANT PER MANUFACTURER'S SPECIFICATIONS.
- 14. ALL VALLEY GUTTERS SHALL HAVE #4 REBAR @ 10" O.C. E.W. PLACED WITHIN THE TOP THIRD OF THE SLAB. REINFORCING SHALL BE SUPPORTED WITH SANDPLATE BAR CHAIRS @ 4" O.C., OR APPROVED EQUAL.
- 15. REFER TO GRADING PLAN FOR DETERMINATION OF CURB TYPE (REVERSE OR FULL) TO BE CONSTRUCTED.
- 16. CONTRACTOR SHALL SUBMIT PROPOSED JOINTING PLAN FOR ENGINEER'S APPROVAL PRIOR TO CONSTRUCTION.

SIGNAGE AND STRIPING NOTES

- 1. THE CONTRACTOR SHALL BE RESPONSIBLE FOR ALL SITE SIGNAGE AND STRIPING AS SHOWN ON THE PLANS. ACCESSIBLE SIGNS SHALL MATCH EXISTING ON-SITE SIGNAGE.
- 2. ALL SIGNS TO BE PLACED 2 FEET OFF THE BACK OF CURB UNLESS OTHERWISE NOTED/DEPICTED.
- 3. PAINT ALL PARKING STALLS WITH 4 INCH WIDE WHITE STRIPE. ALL HATCHED AREAS SHALL BE PAINTED WITH A 4 INCH WIDE, WHITE STRIPE, 45 DEGREES TO PARKING STALL AT 3" O.C.
- 4. APPLY ALL PAVEMENT MARKINGS WITH TWO COATS OF VOC COMPLIANT, LOCAL DOT APPROVED, UNDILUTED, SOLVENT BASE OF LATEX TRAFFIC PAINT.


LEGAL DESCRIPTION

A TRACT OF LAND LYING WITHIN A PORTION OF LOT 1, BLOCK 1, FOLIAGE CENTER ADDITION, AN ADDITION TO WICHITA, SEDGWICK COUNTY, KANSAS, SAID TRACT BEING MORE PARTICULARLY DESCRIBED AS FOLLOWS:
COMMENCING AT THE NORTHEAST CORNER OF SAID LOT 1; THENCE ALONG THE EAST LINE OF SAID LOT 1 ON A PLATTED BEARING OF 50°53'30"E, 265.33 FEET; THENCE S89°43'37"W, 58.70 FEET TO THE POINT OF BEGINNING; THENCE S00°52'27"E, 126.97 FEET; THENCE S01°02'44"W, 28.83 FEET TO A POINT ON A CURVE TO THE RIGHT, SAID CURVE HAVING A RADIUS OF 17.00 FEET, A CENTRAL ANGLE OF 88°03'41", A CHORD BEARING OF S45°04'35"W, AND A CHORD DISTANCE OF 23.83 FEET; THENCE ALONG SAID CURVE TO THE RIGHT, 26.13 FEET; THENCE S89°06'25"W, 38.48 FEET TO A POINT ON A CURVE TO THE RIGHT, SAID CURVE HAVING A RADIUS OF 17.00 FEET, A CENTRAL ANGLE OF 34°57'12", A CHORD BEARING OF N73°23'48"W, AND A CHORD DISTANCE OF 10.21 FEET; THENCE ALONG SAID CURVE TO THE RIGHT, 16.37 FEET; THENCE N85°50'12"W, 52.94 FEET TO A POINT ON A CURVE TO THE RIGHT, SAID CURVE HAVING A RADIUS OF 17.00 FEET, A CENTRAL ANGLE OF 80°00'00", A CHORD BEARING OF N10°50'12"W, AND A CHORD DISTANCE OF 24.04 FEET; THENCE ALONG SAID CURVE TO THE RIGHT, 26.70 FEET; THENCE N34°04'48"E, 1.00 FEET TO A POINT ON A CURVE TO THE RIGHT, SAID CURVE HAVING A RADIUS OF 5.00 FEET, A CENTRAL ANGLE OF 90°00'00", A CHORD BEARING OF N79°04'48"E, AND A CHORD DISTANCE OF 7.87 FEET; THENCE ALONG SAID CURVE TO THE RIGHT, 7.85 FEET; THENCE S55°50'12"E, 13.00 FEET; THENCE N41°04'48"E, 11.00 FEET; THENCE N85°50'12"W, 13.00 FEET TO A POINT ON A CURVE TO THE RIGHT, SAID CURVE HAVING A RADIUS OF 5.00 FEET, A CENTRAL ANGLE OF 90°00'00", A CHORD BEARING OF N10°50'12"W, AND A CHORD DISTANCE OF 7.87 FEET; THENCE ALONG SAID CURVE TO THE RIGHT, 7.85 FEET; THENCE N34°04'48"E, 8.01 FEET TO A POINT ON A CURVE TO THE RIGHT, SAID CURVE HAVING A RADIUS OF 17.00 FEET, A CENTRAL ANGLE OF 80°00'00", A CHORD BEARING OF N81°34'48"E, AND A CHORD DISTANCE OF 15.70 FEET; THENCE ALONG SAID CURVE TO THE RIGHT, 15.32 FEET; THENCE N89°04'48"E, 11.88 FEET TO A POINT ON A CURVE TO THE RIGHT, SAID CURVE HAVING A RADIUS OF 17.00 FEET, A CENTRAL ANGLE OF 80°00'00", A CHORD BEARING OF S45°50'12"E, AND A CHORD DISTANCE OF 24.04 FEET; THENCE ALONG SAID CURVE TO THE RIGHT, 26.70 FEET TO THE POINT OF BEGINNING.
SAID TRACT CONTAINS: 13.743 SQUARE FEET OR 0.31 ACRES OF LAND, MORE OR LESS.

LEGEND

- EXISTING SANITARY SEWER
- EXISTING GAS LINE
- EXISTING WATER LINE
- EXISTING STORM SEWER
- EXISTING UNDERGROUND TELEPHONE
- 8" CONCRETE PAVEMENT
- 6" CONCRETE PAVEMENT
- SIDEWALK
- STALL NUMBER COUNT

PAVING & DIMENSIONING PLAN

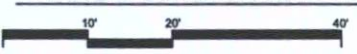

Zoës Kitchen
East Wichita

13th & Webb
Wichita, Kansas



starr
design

1435 West Morehead St, Suite 240
Charlotte, NC 28208
P: 704.377.8200 F: 704.377.8201
www.starrdesignteam.com



PERMIT &
CONSTRUCTION SET
4/17/2017

No.	Description	Date

Paving &
Dimensioning Plan

C2.0

16ZK026 | © Starr Design, PLLC
2014

NOTES:

1) SIGN PACKAGE IS FOR DESIGN INTENT ONLY. ALL MEASUREMENTS TO BE FIELD VERIFIED. ALL SIGNAGE COMPONENTS TO BE COORDINATED W/ SIGNAGE VENDOR/MFR. SIGN SIZES, DETAILS, & OVERALL INSTALLATION TO MEET THE LANDLORDS REQUIREMENTS, AS WELL AS ALL SIGN ORDINANCES AND LOCAL CODES.

2) SIGN PACKAGE SUBJECT TO CHANGE ONCE BASE PLAN IS DESIGNED/APPROVED.

APPROVED



PP-282 Arch Rev per GP#4

Date: 5-11-17 *SK*

Page 1 of 4

SIGNAGE THIS ELEVATION:
TOTAL: 38 SF
ALLOWED: 20% OF 1664 SF = 332 SF

STUCCO 2 - FIELD PAINTED
BENJAMIN MOORE 1054
"SHERWOOD TAN"

GENERAL SHALE BRICK "WATERTON"

STUCCO 1 - FIELD PAINTED TO MATCH
WHITE "STONE"

3' - 2 3/4"
4' - 3 1/2"
VIF

4' - 3 1/4"
VIF

3' - 3 1/4"
4' - 3 1/4" x 3"
VIF

AWNING LIGHTING, TYP
CENTER BTWN JOINTS

WHITE FACES W/ BLACK OUTLINES
& RED(P-1) RETURNS, ILLUMINATED
CHANNEL LETTERS. CONTRACTOR TO
PROVIDE J-BOX & BLOCKING FOR
SIGNAGE IN COORDINATION W/ SIGN
VENDOR.
SIGNAGE: 27 SF
ELEVATION: 1664 SF

FABRIC AWNINGS

RED(P-1) VINYL ON STOREFRONT
BEHIND AWNINGS

BRUSHED ALUMINUM LETTERS ON 3/4"
STANDOFFS. SIGNAGE: 11 SF

DARK BRONZE STOREFRONT & CANOPY

1 WEST ELEVATION- SIGNAGE

1/8" = 1'-0"



Zoës Kitchen
East Wichita

1441 N. Webb Road
Wichita, Kansas

starr
design

Starr Design, PLLC
1435 West Morehead St, Suite 240
Charlotte, NC 28208
V: 704 377 5200
www.starrdesignteam.com

DATE: 2/27/2017
ORIGIN/DESCRIPTION:

COMMENTS:

ELEVATIONS

SP1.03

© Starr Design, PLLC | 16ZK026 | 2/27/2017

NOTES:

1) SIGN PACKAGE IS FOR DESIGN INTENT ONLY. ALL MEASUREMENTS TO BE FIELD VERIFIED. ALL SIGNAGE COMPONENTS TO BE COORDINATED W/ SIGNAGE VENDOR/MFR. SIGN SIZES, DETAILS, & OVERALL INSTALLATION TO MEET THE LANDLORDS REQUIREMENTS, AS WELL AS ALL SIGN ORDINANCES AND LOCAL CODES.

2) SIGN PACKAGE SUBJECT TO CHANGE ONCE BASE PLAN IS DESIGNED/APPROVED.

APPROVED

DP-282 Arch Rev per GP#4

STUCCO 1 - FIELD PAINTED TO MATCH WHITE "STONE"

Date: 5-11-17


Page 2 of 4

ZOES STRIPED AWNING

SIGNAGE THIS ELEVATION:

TOTAL: 22 SF

ALLOWED: 20% OF 753 SF = 150 SF

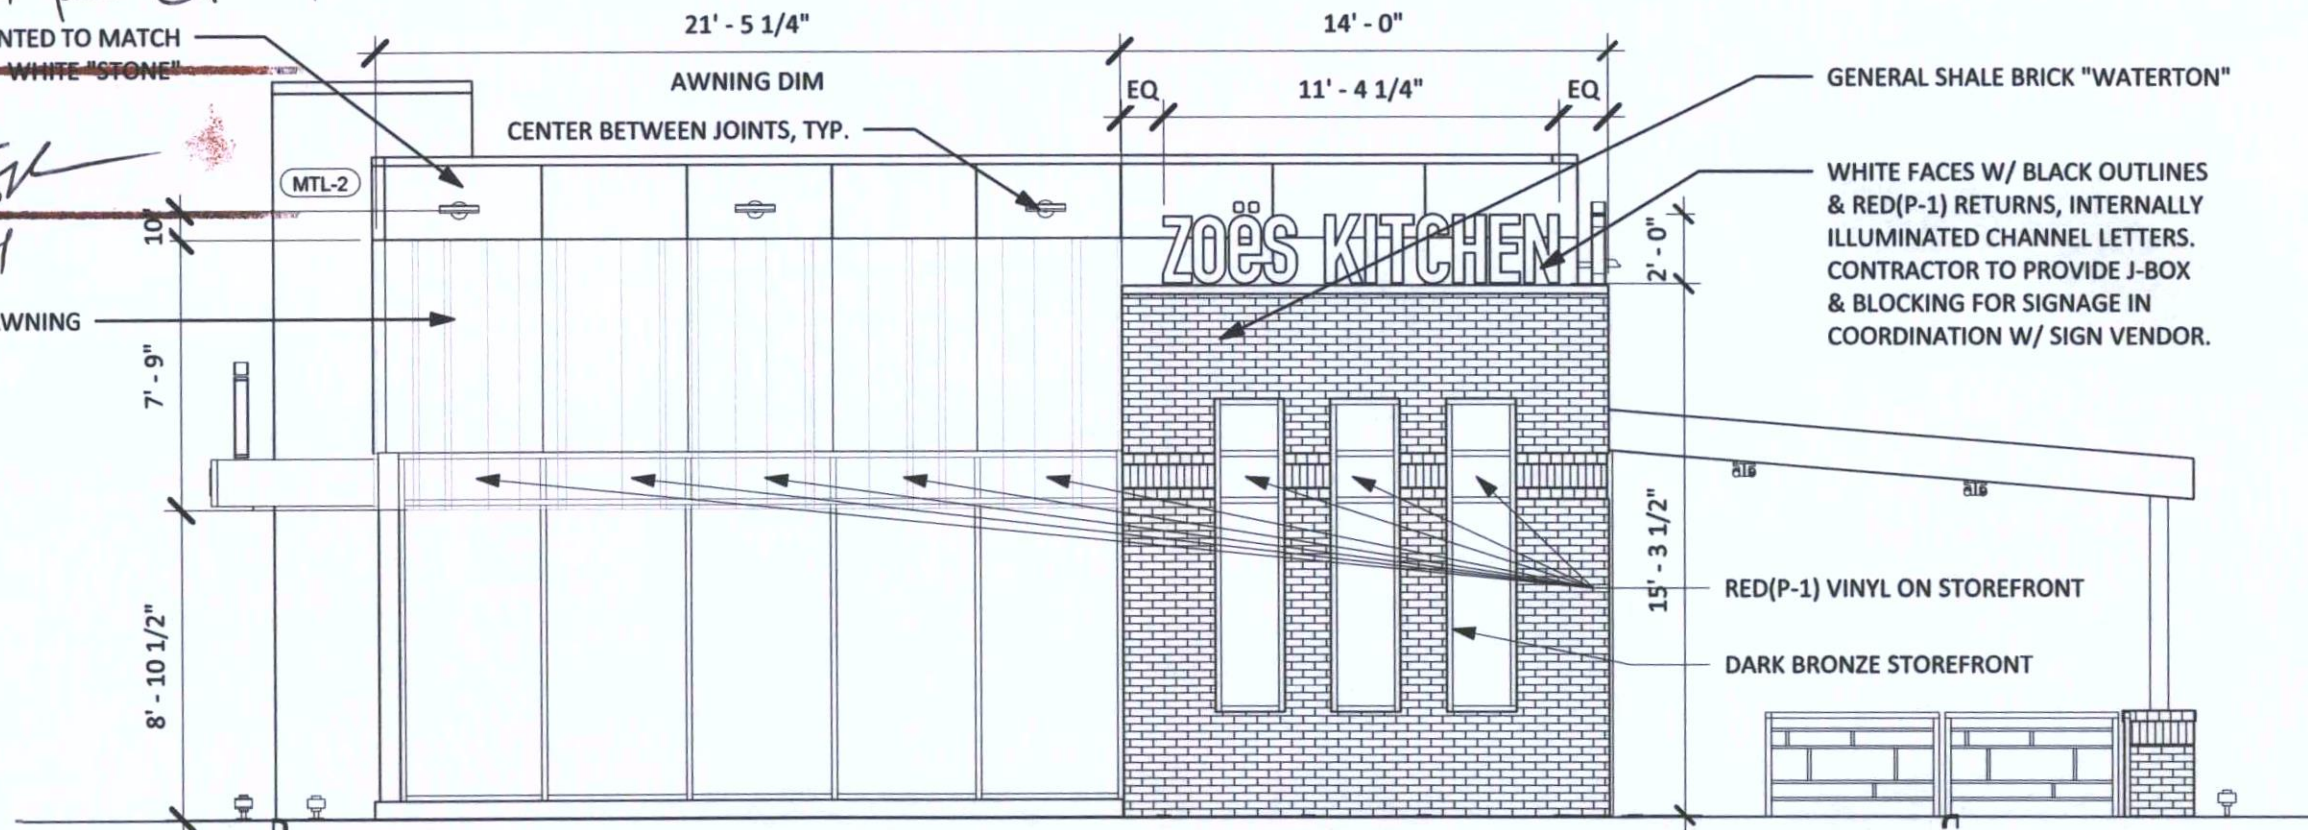

1 SOUTH ELEVATION - SIGNAGE
3/16\" = 1'-0"



**Zoës Kitchen
East Wichita**

1441 N. Webb Road
Wichita, Kansas

**starr
design**
branded

Starr Design, PLLC
1435 West Morehead St, Suite 240
Charlotte, NC 28208
V: 704 377 5200
www.starrdesignteam.com

DATE: 4/5/2017

ORIGIN/DESCRIPTION:

COMMENTS:

ELEVATIONS

SP1.04

© Starr Design, PLLC | 16ZK026 | 4/5/2017

NOTES:

1) SIGN PACKAGE IS FOR DESIGN INTENT ONLY. ALL MEASUREMENTS TO BE FIELD VERIFIED. ALL SIGNAGE COMPONENTS TO BE COORDINATED W/ SIGNAGE VENDOR/MFR. SIGN SIZES, DETAILS, & OVERALL INSTALLATION TO MEET THE LANDLORDS REQUIREMENTS, AS WELL AS ALL SIGN ORDINANCES AND LOCAL CODES.

2) SIGN PACKAGE SUBJECT TO CHANGE ONCE BASE PLAN IS DESIGNED/APPROVED.

APPROVED

PP-282 Arch Rev per GP#4

Date: 5-11-17 SK

Page 3 of 4

GENERAL SHALE BRICK "WATERTON"

STUCCO 1 - FIELD PAINTED TO MATCH WHITE "STONE"


STUCCO 2 - FIELD PAINTED BENJAMIN MOORE 1054 "SHERWOOD TAN"

SIGNAGE THIS ELEVATION:

TOTAL: 41 SF

ALLOWED: 20% OF 850 SF = 170 SF

DOOR & FRAME PAINTED TO MATCH STUCCO 2

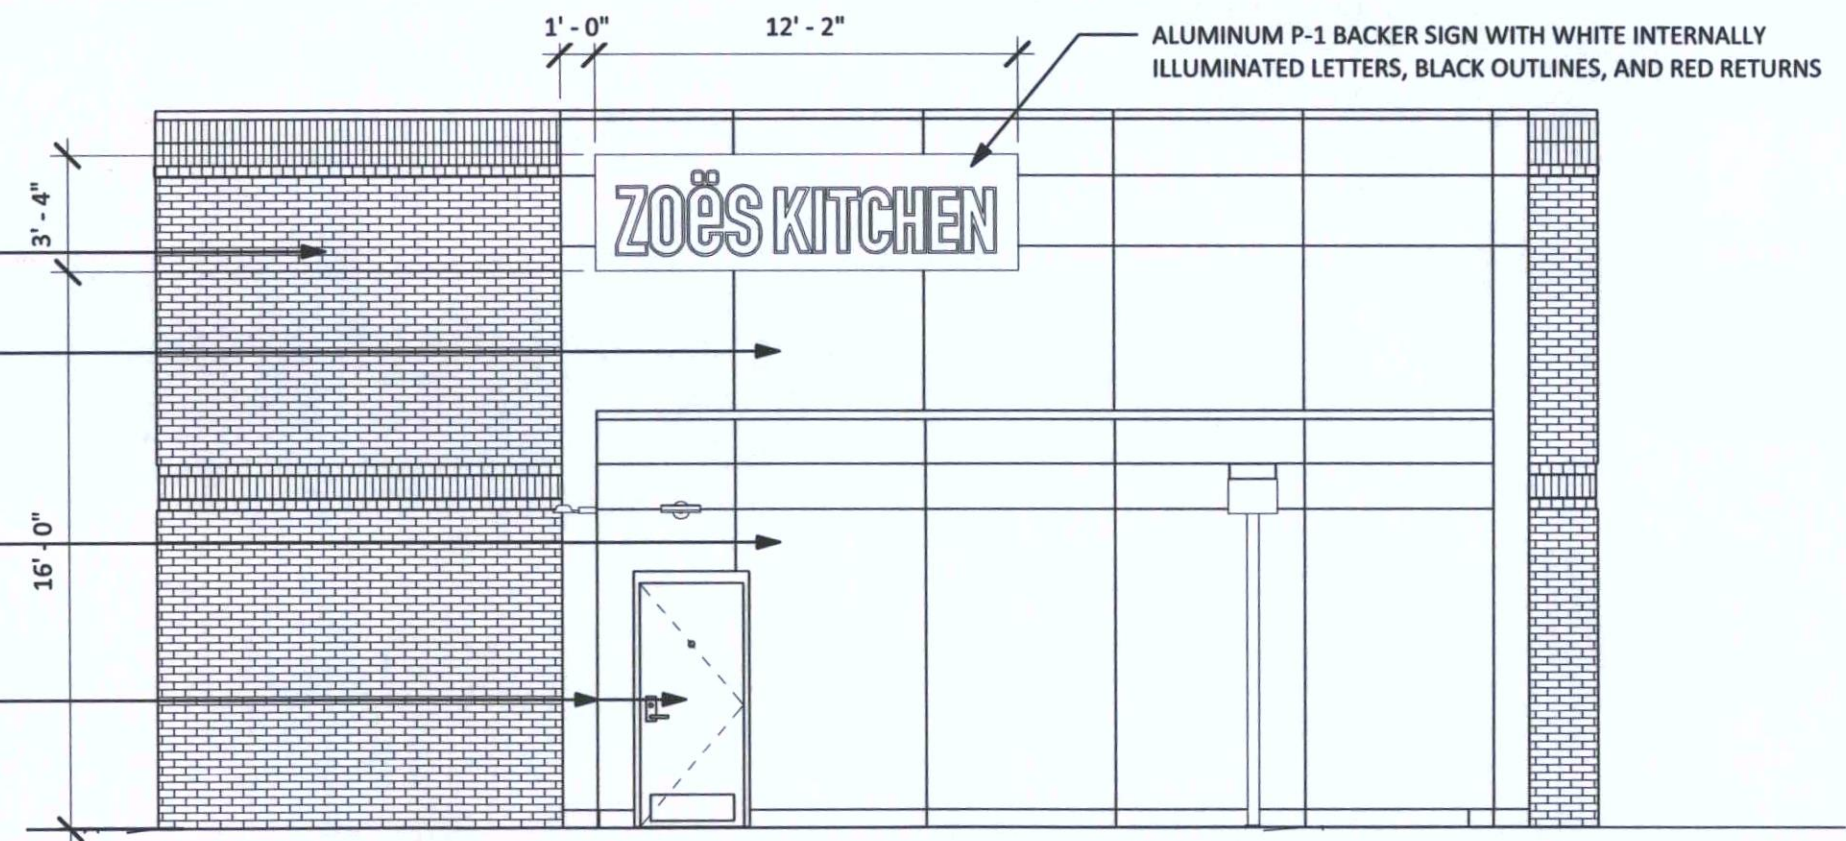

1 NORTH ELEVATION - SIGNAGE
3/16" = 1'-0"



**Zoës Kitchen
East Wichita**

1441 N. Webb Road
Wichita, Kansas

**starr
design** branded

Starr Design, PLLC
1435 West Morehead St, Suite 240
Charlotte, NC 28208
V: 704 377 5200
www.starrdesignteam.com

DATE: 5/11/2017

ORIGIN/DESCRIPTION:

COMMENTS:

ELEVATIONS

SP1.05

© Starr Design, PLLC | 16ZK026 | 5/11/2017

NOTES:

1) SIGN PACKAGE IS FOR DESIGN INTENT ONLY. ALL MEASUREMENTS TO BE FIELD VERIFIED. ALL SIGNAGE COMPONENTS TO BE COORDINATED W/ SIGNAGE VENDOR/MFR. SIGN SIZES, DETAILS, & OVERALL INSTALLATION TO MEET THE LANDLORDS REQUIREMENTS, AS WELL AS ALL SIGN ORDINANCES AND LOCAL CODES.

2) SIGN PACKAGE SUBJECT TO CHANGE ONCE BASE PLAN IS DESIGNED/APPROVED.


APPROVED

DP-282 Arch Rev per GP#4

WHITE FACED W/ BLACK OUTLINE & RED(P-1) RETURNS, INTERNALLY ILLUMINATED CHANNEL LETTERS. CONTRACTOR TO PROVIDE J-BOX & BLOCKING FOR SIGNAGE IN COORDINATION W/ SIGN VENDOR.

Date: 5-11-17 SK

Page 4 of 4

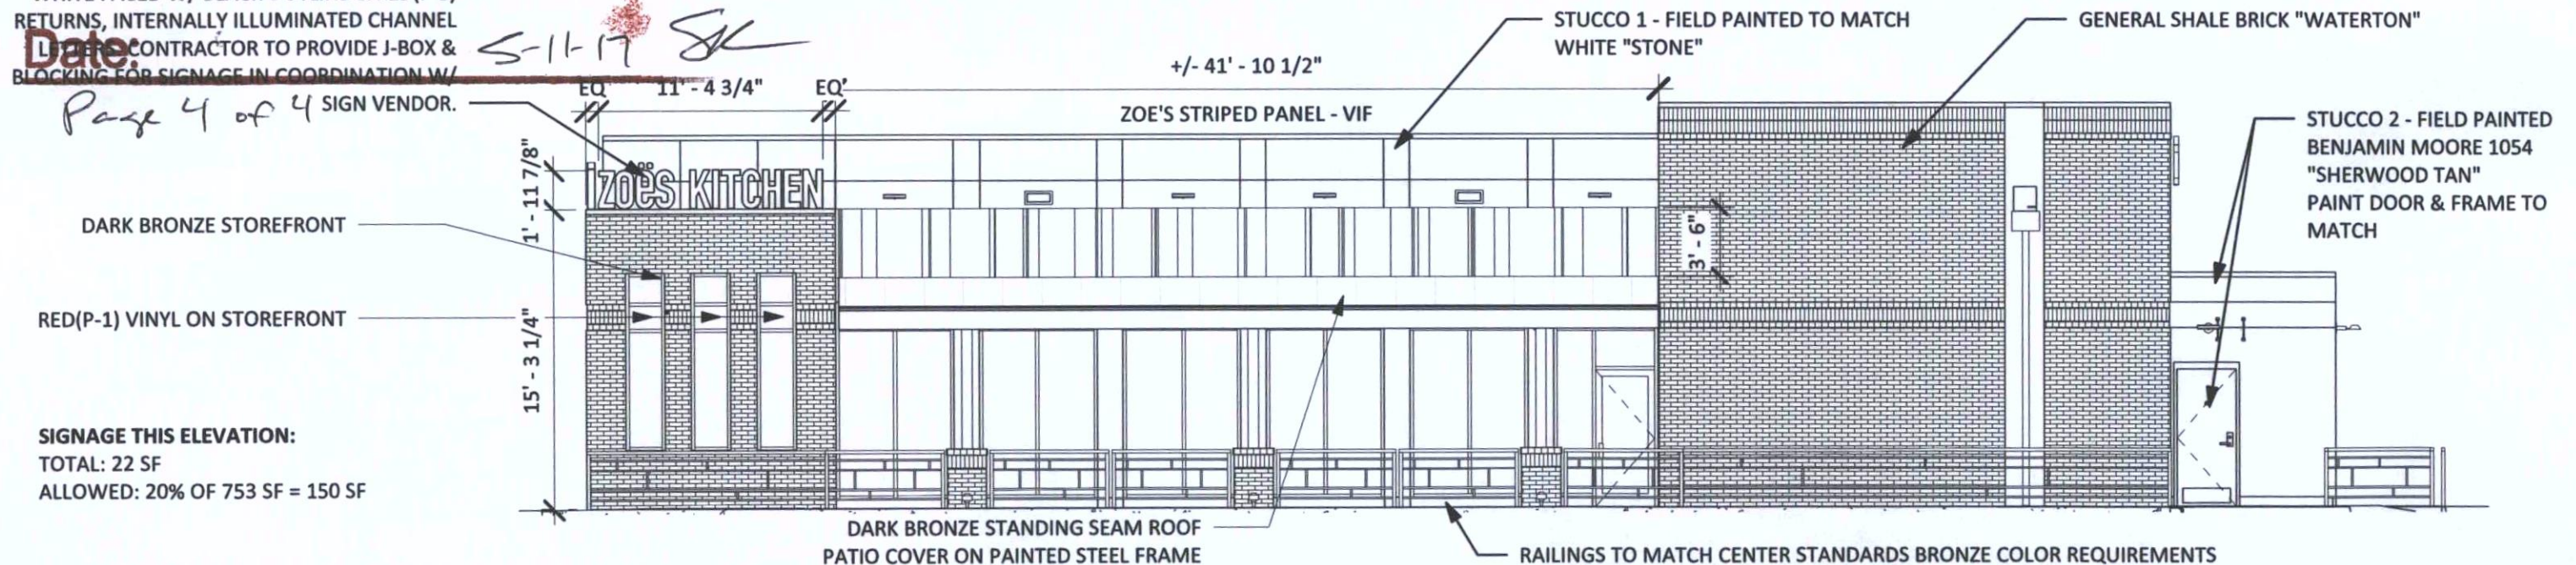

1 EAST ELEVATION SIGNAGE
1/8" = 1'-0"



Zoës Kitchen
East Wichita

1441 N. Webb Road
Wichita, Kansas

starr
design

Starr Design, PLLC
1435 West Morehead St, Suite 240
Charlotte, NC 28208
V: 704 377 5200
www.starrdesignteam.com

DATE: 5/11/2017
ORIGIN/DESCRIPTION:

COMMENTS:

ELEVATIONS

SP1.06

© Starr Design, PLLC | 16ZK026 | 5/11/2017

A circular professional seal for Andrew Ciarniello, a Licensed Professional Engineer in the State of New York. The seal contains the text "ANDREW CIARNIELLO", "LICENSED", "6885", and "ARCHITECT". A handwritten signature is written over the seal.


No.	Date	Issued	By
C1	07.14.17	SCHEMATIC SET	STAFF
C2	08.01.17	REVISED SCHEMATIC SET	STAFF
C3	08.06.17	REVISED SCHEMATIC SET	STAFF
C4	09.08.17	90% CHECK SET	STAFF
C5	09.26.17	ISSUED FOR LAND ORD. APPROVAL	STAFF
C6	09.26.17	ISSUED FOR DOB PERMIT APPROVAL	STAFF

NEW KENRDA SCOTT
SPACE 117
TOTAL AREA = 1,224 SF
SALES AREA = 650 SF
BOH AREA = 365 SF

Project	KENDRA SCOTT THE WATERFRONT SPACE 117 WICHITA, KS 67206
Drawing Title	STOREFRONT PLAN AND ELEVATION


Project No.	17039
Scale:	AS NOTED
Date:	06.30.17
Drawn By	STAFF
Checked By:	STAFF

A301

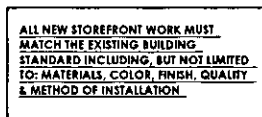

NEW SECONDARY SIGNAGE - ACRYLIC LETTERS - ADHERED TO EXISTING FACADE

- ALL SIGNAGE TO BE FURNISHED & INSTALLED BY GC. SIGN VENDOR TO BE APPROVED BY TENANT**
- 2" HIGH ACRYLIC LETTERS**
- COORDINATE LOCATION WITH LANDLORD**
- REFER TO SIGN VENDOR'S DRAWINGS FOR DETAILED DESCRIPTION**
- REFER TO ELEVATIONS FOR SIZE OF SIGN AND LETTERS**
- THE LIGHTING OF SIGNAGE SHALL BE CONTROLLED BY THE TENANT'S 24 HOUR TIME CLOCK SET IN ACCORDANCE TO THE CITY OF LOS ANGELES SPECIFICATIONS**
- JUNCTION BOX - CONNECT EACH ASSEMBLY AT THE LANDLORDS EXISTING JUNCTION BOX**
- SIGN VENDOR TO OBTAIN PERMIT AND SUBMIT SHOP DRAWING FOR LANDLORD APPROVAL**
- (SIGNS UNDER SEPARATE REVIEW AND PERMIT)**

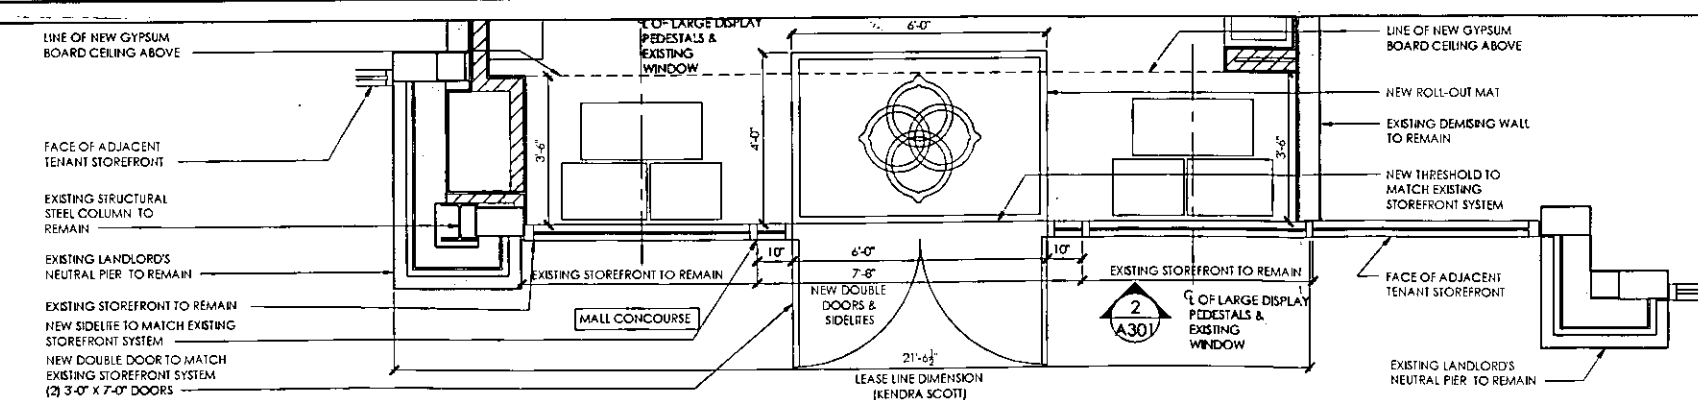

APPROVED

DP-282 Arch Rec per GP#4

Date: 10-24-17 

STOREFRONT PLAN

SCALE: 1/2" = 1'-0"



Wichita-Sedgwick County Metropolitan Area Planning Department

April 28, 2014

Beach Lake Investments, LLC
1223 N Rock Rd.
Wichita, KS 67206

Law Kingdon Architecture
345 Riverview, St. 200
Wichita, KS 67203

RE: CUP2014-10 - City Administrative Adjustment to CUP DP-282 to increase the permitted height of light standards from 25 feet to 28 feet located on the NW cor. of N. Webb Rd. and E. 13th Street N. (1423 North Webb Road).

Dear Applicants:


We received and reviewed your request for an administrative adjustment to the above-referenced community unit plan, DP-282 The Foliage Center Community Unit Plan (CUP). We understand that you wish to construct 25-foot tall light poles on 3-foot concrete bases for a total light height of 28 feet. The CUP currently restricts light pole height to 25 feet, and 14 feet within 100 feet of residential zoning. We understand from your letter that no light poles will be within 100 feet of residential zoning.

On the basis of our review, we find that adjusting the CUP in the manner stated in the above paragraph is consistent with the approved CUP and will not have an adverse effect on the CUP or on adjacent properties, nor will it be a substantial deviation of the original plan.

Our signatures below indicate that the CUP shall be adjusted as stated in this letter. This CUP adjustment shall not be deemed to alter any other provisions of the CUP except as expressly stated herein.

The "Development Application" signs may now be removed from the property. Please submit four (4) copies of the revised CUP drawing within 60 days in order for this adjustment to be considered final.


John L. Schlegel
Director of Planning

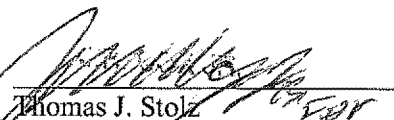
Thomas J. Stolz
MABCD Director

cc: JR Cox, MABCD
Paul Hays, MABCD
Pete Meitzner, CM District II
Alana Haynes, NA District II

City Hall • 10th Floor • 455 North Main • Wichita, Kansas 67202-1688

T 316.268.4421 F 316.268.4390

www.wichita.gov



Wichita-Sedgwick County Metropolitan Area Planning Department

August 28, 2014

MKEC Engineering, Consultants, Inc.
Attn: Brian Lindebak
411 North Webb Road
Wichita, KS 67206

RE: ZON2014-00014 and CUP2014-00017 – City zone change from GO General Office (GO) to Limited Commercial (LC) and amendment to CUP DP-282 the Foliage Center on property generally located northeast of East 13th Street North and North Webb Road.

Dear Ladies and Gentlemen:

At its regular meeting on **August 26, 2014**, the Wichita City Council considered the above captioned request. The action of the Council was to **APPROVE** the request as recommended by staff.

This is a reminder that the zoning notification signs should now be removed from the property. If you have any questions concerning this application, please contact our office at 268-4421.

Sincerely,

Dale Miller
Current Plans Manager
Current Plans Division

Copies to: Beech Lake Investment, LLC, 1717 N. Waterfront Parkway, Wichita, KS 67206
WCC II, Pete Meitzner, Mail Stop 1-13
Alana Haynes, N.A. II, Mail Stop 1-135
Paul Hays, OCI, Mailstop 1-72
J. R. Cox, OCI, Mailstop 1-72
Jeff Van Zandt, City Law, Mailstop 1-134
Julianne Kallman, Engineering, Mail Stop 1-71



Wichita-Sedgwick County Metropolitan Area Planning Department

September 12, 2014

MKEC
411 North Webb Road
Wichita, KS 67206

Beech Lake Investments
P.O. Box 782257
Wichita, KS 67278-2257

RE: CUP2014-00025 – City Amendment to The Foliage Center Community Unit Plan (CUP), DP-282 to add a GO General Office zoned parcel, establish use, landscape, screening, signage lighting and other development standards for the new parcel generally located at the northwest corner of East 13th Street North and North Webb Road.

Dear Gentlemen:

At its regular meeting on September 11, 2014, the Wichita - Sedgwick County Metropolitan Area Planning Commission (MAPC) considered the above captioned request. The action of the MAPC was to APPROVE the request, as amended during the meeting and described below:

General Provision 1. The total development contains 8.554 acres.

General Provision 2. Add Parcel 3 with the following development standards. Gross Area = 1.123 acs. or 48,951 s.f.; Maximum building height = 35 feet; Maximum coverage = 30 percent; Maximum Gross Floor Area = 35 percent and Setbacks: front 35 feet, rear 35 feet, side (north) 25 feet and side (south) 0 feet subject to appropriate fire wall separation.

General Provision 3.A. In addition to allowable uses described for Parcels 1 and 2, add: Parcel 3 shall be limited to the following GO zoning district use: "Bank or financial institution" with drive-thru permitted by right, and "office, general."

General Provision 6.C. A 12-foot wide landscape buffer shall run parallel with the west and north property lines of Parcel 3 where abutting residential areas/zoning. Said landscape buffer may be reduced to allow for a drive aisle on the north, so long as the landscaping with that portion of the buffer meets or exceeds 1.5 times the requirements of the Landscape Ordinance.

General Provision 7.B. Trash receptacles, loading docks, outdoor storage and loading areas shall be appropriately screened to reasonably hide them from ground view except, if not visible from public rights-of-way or if not directly visible from ground view from adjoining residential/zoning area. The screening materials shall be consistent with materials and colors of the supported buildings. Trash enclosures shall be allowed within 20 feet of property lines if not visible from public rights-of-way but

shall not be closer than five feet from the westerly property lines. *Trash enclosures are not permitted along the northern boundary of Parcel 3 and there shall be no outdoor storage on Parcel 3.*

General Provision 6.C. "no electronic signs are permitted on Parcel 3" is deleted.

General Provision 9.A. *All parcels* shall adhere to the requirements of the Sign Code for the City of Wichita for the *LC zoning district*, except as provided herewith:

General Provision 9.B. No flashing, *animated* or moving, portable, billboard, banner, *off-site* or pennant signs shall be permitted except; however, *two* electronic message signs *are* allowed along Webb Road, *one on Parcel 1 and one on Parcel 3.*

General Provision 9.C. All signs along and adjacent to 13th and Webb streets shall be monument type signs with a maximum height of 20 feet, *except for Parcel 3 where no monument sign shall exceed 12 feet in height.*

General Provision 9.D. *Eight* monument signs are permitted: *five* along Webb Road and three along 13th Street. The sign areas shall be limited to a maximum of 150 square feet each along Webb Road and 145 square feet each along 13th Street. Stand alone development identification signs shall count against the above total allowed seven monument signs. Development identification signs may also have tenant signage. *No illuminated monument signs over 10 square feet are allowed with the north 150 feet of Parcel 3.*

General Provision F. Building signage shall be permitted within the CUP. Building signage on *Parcels 1 and 2* shall be limited to 20 percent of the wall area with no single tenant sign exceeding 400 square feet in area, and there shall be no more than six signs for each tenant (business) on each building elevation. *Building signage on Parcel 3 shall be limited to a total of 250 square feet.* There shall be no building signage along the westerly facades of any buildings on Parcels 1 and 3 abutting the western boundary of the CUP *nor shall any building signage of any kind be allowed on any building facing the northerly line of Parcel 3, except for illumined drive-thru/ATM signage that is cumulatively not to exceed 6 square feet in area is allowed. Such drive-thru signage shall be illuminated during business hours only; such ATM signage may be illuminated outside business hours.*

General Provision 9. G. Accent lighting of monument and directional/way-finding signs shall be permitted.

General Provision 10.D. Light poles including above ground bases shall be limited to 28 feet tall and no light poles shall be within 100 feet of residential zoning, *except; however, on the north line of Parcel 3, two light poles may be located no closer than 12 feet of the north property line having a maximum height of 15 feet with shielding to cast light in a downward direction and directed away from residential areas/zoning to the north, and except however on the east line of Parcel 3, where one light pole may be located no closer than 30 feet of the west property line having a maximum height of 15 feet with shielding to cast light in a downward direction and directed away from residential areas/zoning to the west. No wall-pack lighting is allowed within the north 150 feet of Parcel 3, unless, however, such wall-pack lighting is shielded to cast light in a downward direction and directed away from residential areas/zoning and such wall-pack lighting shall not be placed higher than 10 feet off the ground.*


Property owners opposed to the application may file with the City Clerk signed written appeals or protests of the MAPC's recommendation. (Unsigned e-mails are not considered to be legal appeals.) Appeals or protests must be filed within 14 days of the MAPC's action or by 5:00 p.m. on September 25, 2014. In order to be considered a "valid" appeal or protest the signatures must reflect the correct and entire ownership of the property owners filing the appeal, and must be submitted to the City Clerk within 14 days of the conclusion of the MAPC hearing, by September 25, 2014, at 5:00 p.m.

Unless protests or appeals are filed, the action of the MAPC will be considered to be final and the application will have final approval. If there are appeals or protests, the application will be forwarded to the City Council for final consideration. If necessary, October 14, 2014, is the date the case would be heard by the City Council.

NOTICE: The public hearing on planning items is conducted by the MAPC under provisions of State Law. Adopted policy is that the City Council will not take additional testimony on zoning related applications and other issues for which the MAPC has held a public hearing. However, interested parties may file a written statement with the City Clerk by 5:00 p.m. on the Wednesday preceding this meeting, providing new facts on the issue or alleging an unfair hearing. The Council will determine from such statements whether to return the issue to the MAPC for reconsideration or to reverse their recommendation.

This is a reminder that the zoning notification signs should now be removed from the property. If you have any questions concerning this application, please contact our office at 268-4421.

Sincerely,

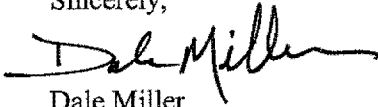A handwritten signature in black ink, appearing to read "Dale Miller". The signature is fluid and cursive, with the first name "Dale" and last name "Miller" clearly distinguishable.

Dale Miller
Current Plans Manager
Current Plans Division

Copies to: WCC II, Pete Meitzner, Mail Stop 1-13
 N.A. I, Alana Haynes, Mail Stop 1-135
 Jeff Van Zandt, City Law, Mailstop 1-134
 Julianne Kallman, Engineering, Mail Stop 1-71
 Country Place Estates HOA, Bill Johnson, 1542 N. Gateway Court, Wichita, KS 67206
 Foliage HOA, Daniel A. Flynn, 1710 Duckcross Cove, Wichita, KS 67206
 Equity Bank, 7701 E. Kellogg, Suite 100, Wichita, KS 67207



Wichita-Sedgwick County Metropolitan Area Planning Department

November 4, 2013

Beech Lake Investments, LLC
1223 North Rock Road, Building H, Suite 200
Wichita, KS 67206

Law/Kingdon Architecture
Attn: Glen Bailey
345 Riverview, Suite 200
Wichita, KS 67203

RE: Administrative Adjustment (CUP2013-00039) to increase the number of, and area of signage, on the east facing front of Whole Foods located in Parcel 1 of the Foliage Center Community Unit Plan ("CUP") DP-282 located at the northwest corner of North Webb Road and East 13th Street North.

Signage standards in DP-282 are detailed in General Provision 9A-K. General Provision 9A states that Parcels 1 and 2 are subject to the requirements of the Sign Code for the City of Wichita for the LC zoning district except as noted herewith. General Provision 9H states building signage shall be permitted within the CUP. Building signage shall be limited to 20% of the wall area with a maximum size of 150 square feet per elevation for 1 sign or may be divided into a maximum of 3 signs, 70 square feet per sign per elevation.

The applicant is requesting:

1. A main entry sign of up to 149.50 square feet plus (either the "Bread & Circus" or the "Whole Foods Market" sign).
2. One temporary sign of 64 square feet that will have its message replaced three times during an 86 day time period.
3. Five blade signs, 16.84 square feet each or a total of 84.2 square feet.

Items 1, 2 and 3 equal a total of 297.7 square feet.

We have reviewed your request and have approved the requested adjustments to Parcel 1 of DP-282 as described above, subject to the following standards:

1. Applicable permits for all signage shall be obtained and signage shall be installed in general conformance with the approved site plan and drawings last dated 9-30-13.
2. All temporary signs shall be removed at the end of the 86 day time period. The 86 day time period shall begin running from the time the sign permit is issued.

All other applicable development standards of the CUP shall apply unless specifically adjustment or amended.

City Hall • 10th Floor • 455 North Main • Wichita, Kansas 67202-1688


T 316.268.4421 F 316.268.4390


www.wichita.gov

Except as expressly stated above, this adjustment shall not be deemed to alter any other provisions of the CUP.

The zoning notification signs may now be removed from the property.

This adjustment shall not be effective until four revised copies of the CUP have been submitted to the Metropolitan Area Planning Department.

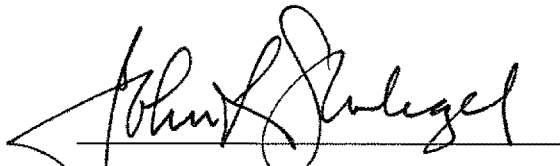

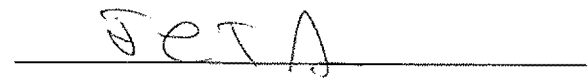John L. Schlegel
Director of Planning

Tom J. Stolz
Director of the Metropolitan Area Building and
Construction Department