

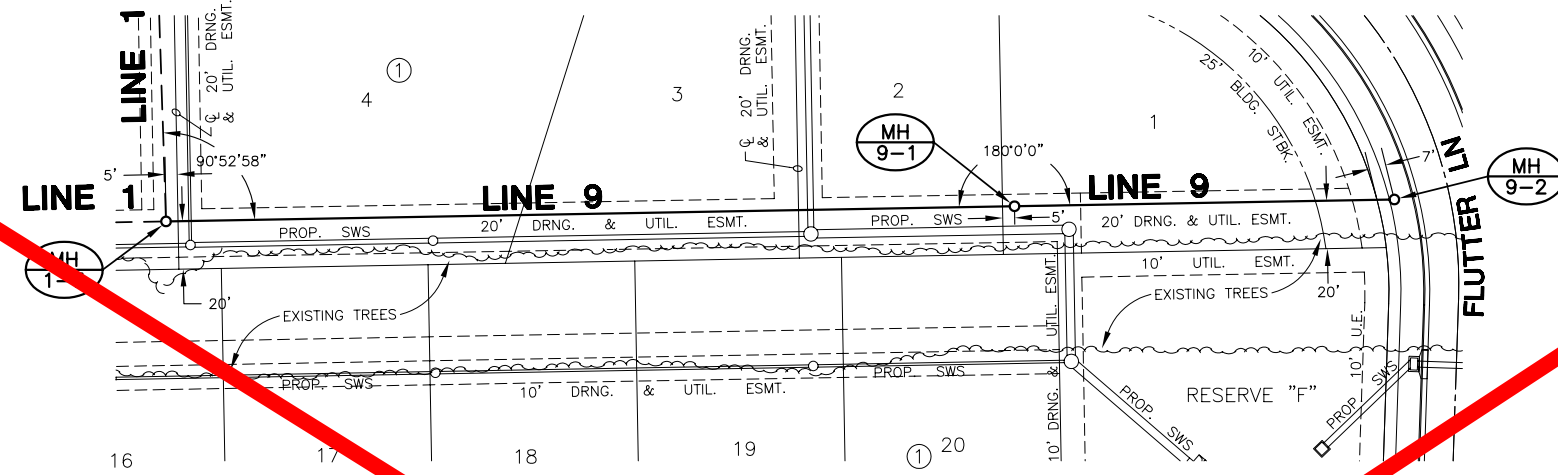


SEE REVISED SHEET

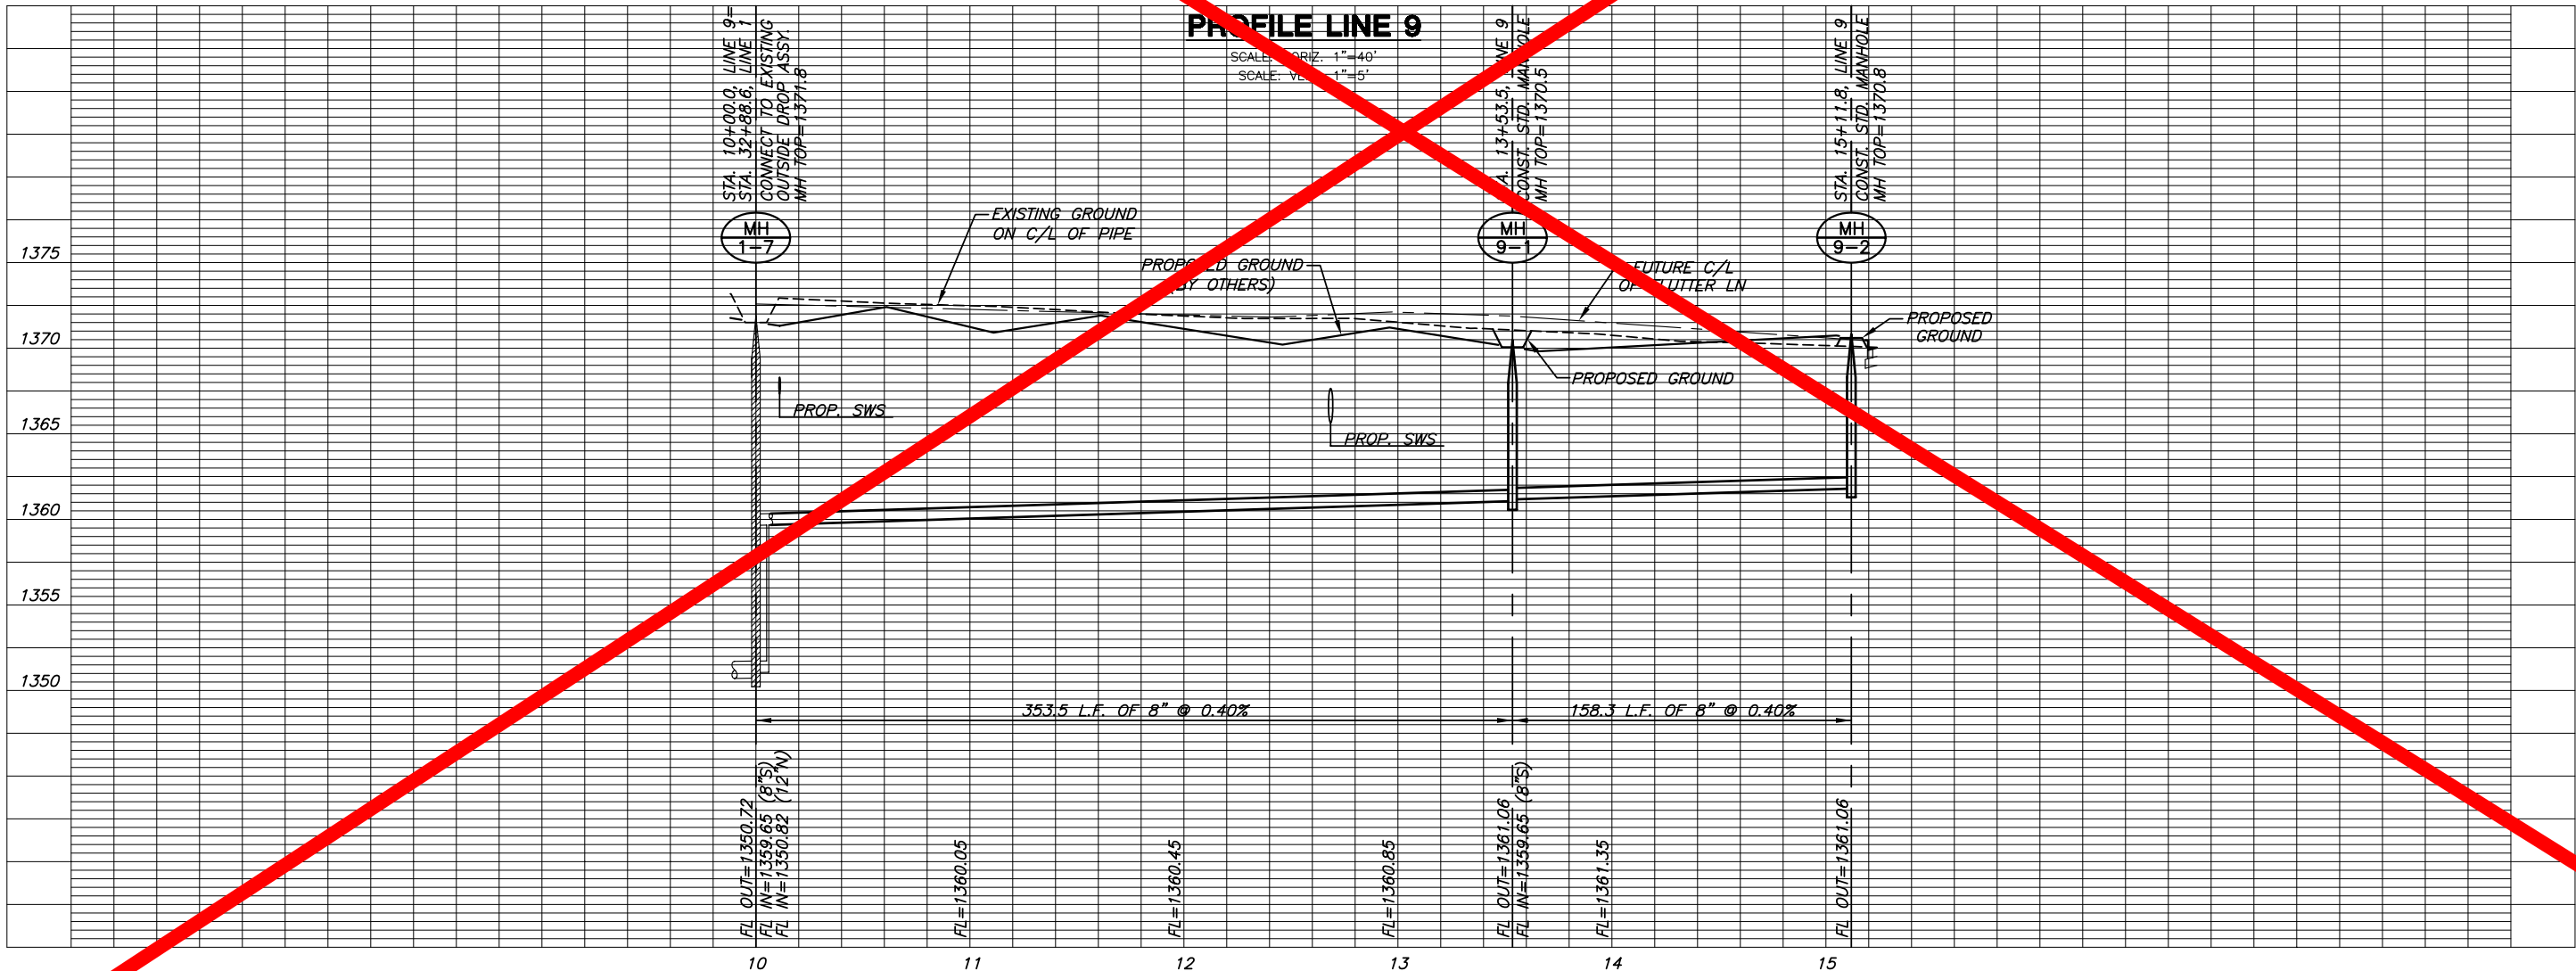

PLAN LINE 9

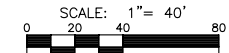

SANITARY SEWER PLANS FOR
MONARCH LANDING ADDITION
PHASE 1

LINE 9
SHEET TITLE
468-84317
PROJECT NUMBER

DESIGN BY: **DFL**
DRAWN BY: **DMU**
CHECKED BY: **GJA**

ISSUED: **January 2007**
REVISED:

SHEET: **12 of 20**

PLOTED: Wednesday, January 31, 2007 @ 07:13AM

J:\CIVIL\06201\DWG\PLAN\PH1\06201_LB9.DWG