

SEE REVISED SHEET


**SANITARY SEWER PLANS FOR
MONARCH LANDING ADDITION
PHASE 1**

LINES 10 & 11
SHEET TITLE
468-84317
PROJECT NUMBER



DFL
DESIGN BY
DMU
DRAWN BY
GJA
CHECKED BY

ISSUED
January 2007
REVISED


SHEET NO.
13 of 20

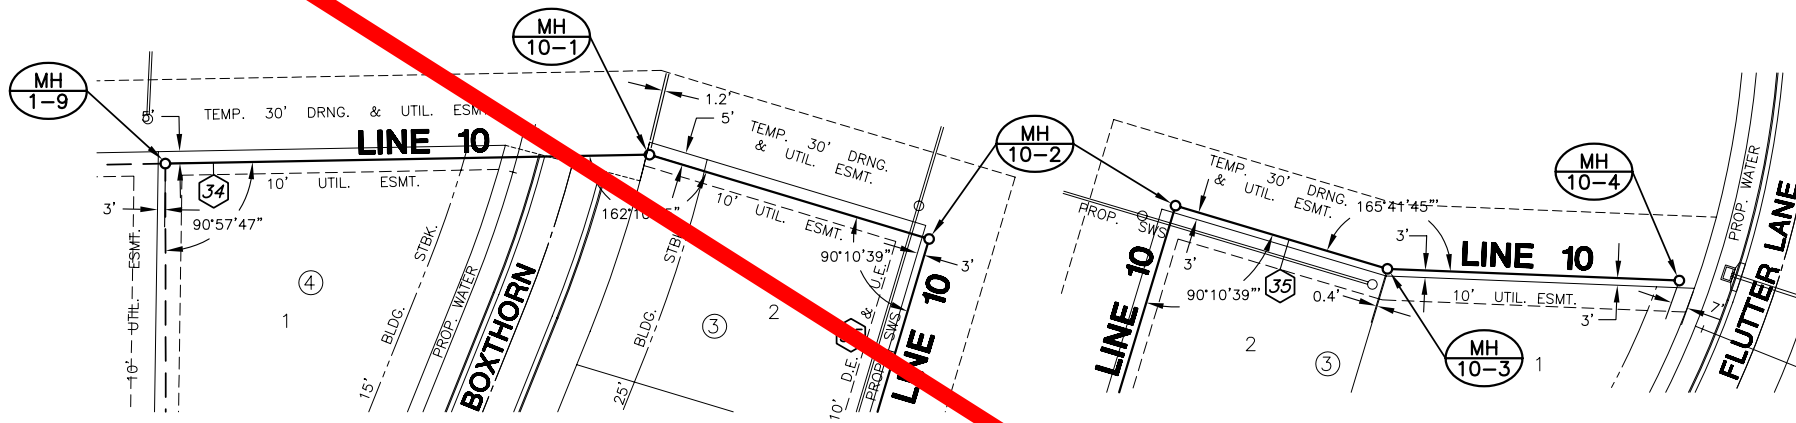

PLAN LINE 10

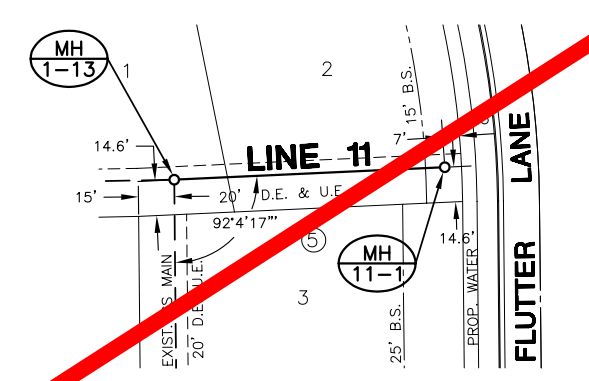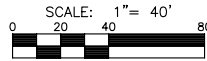

PLAN LINE 11

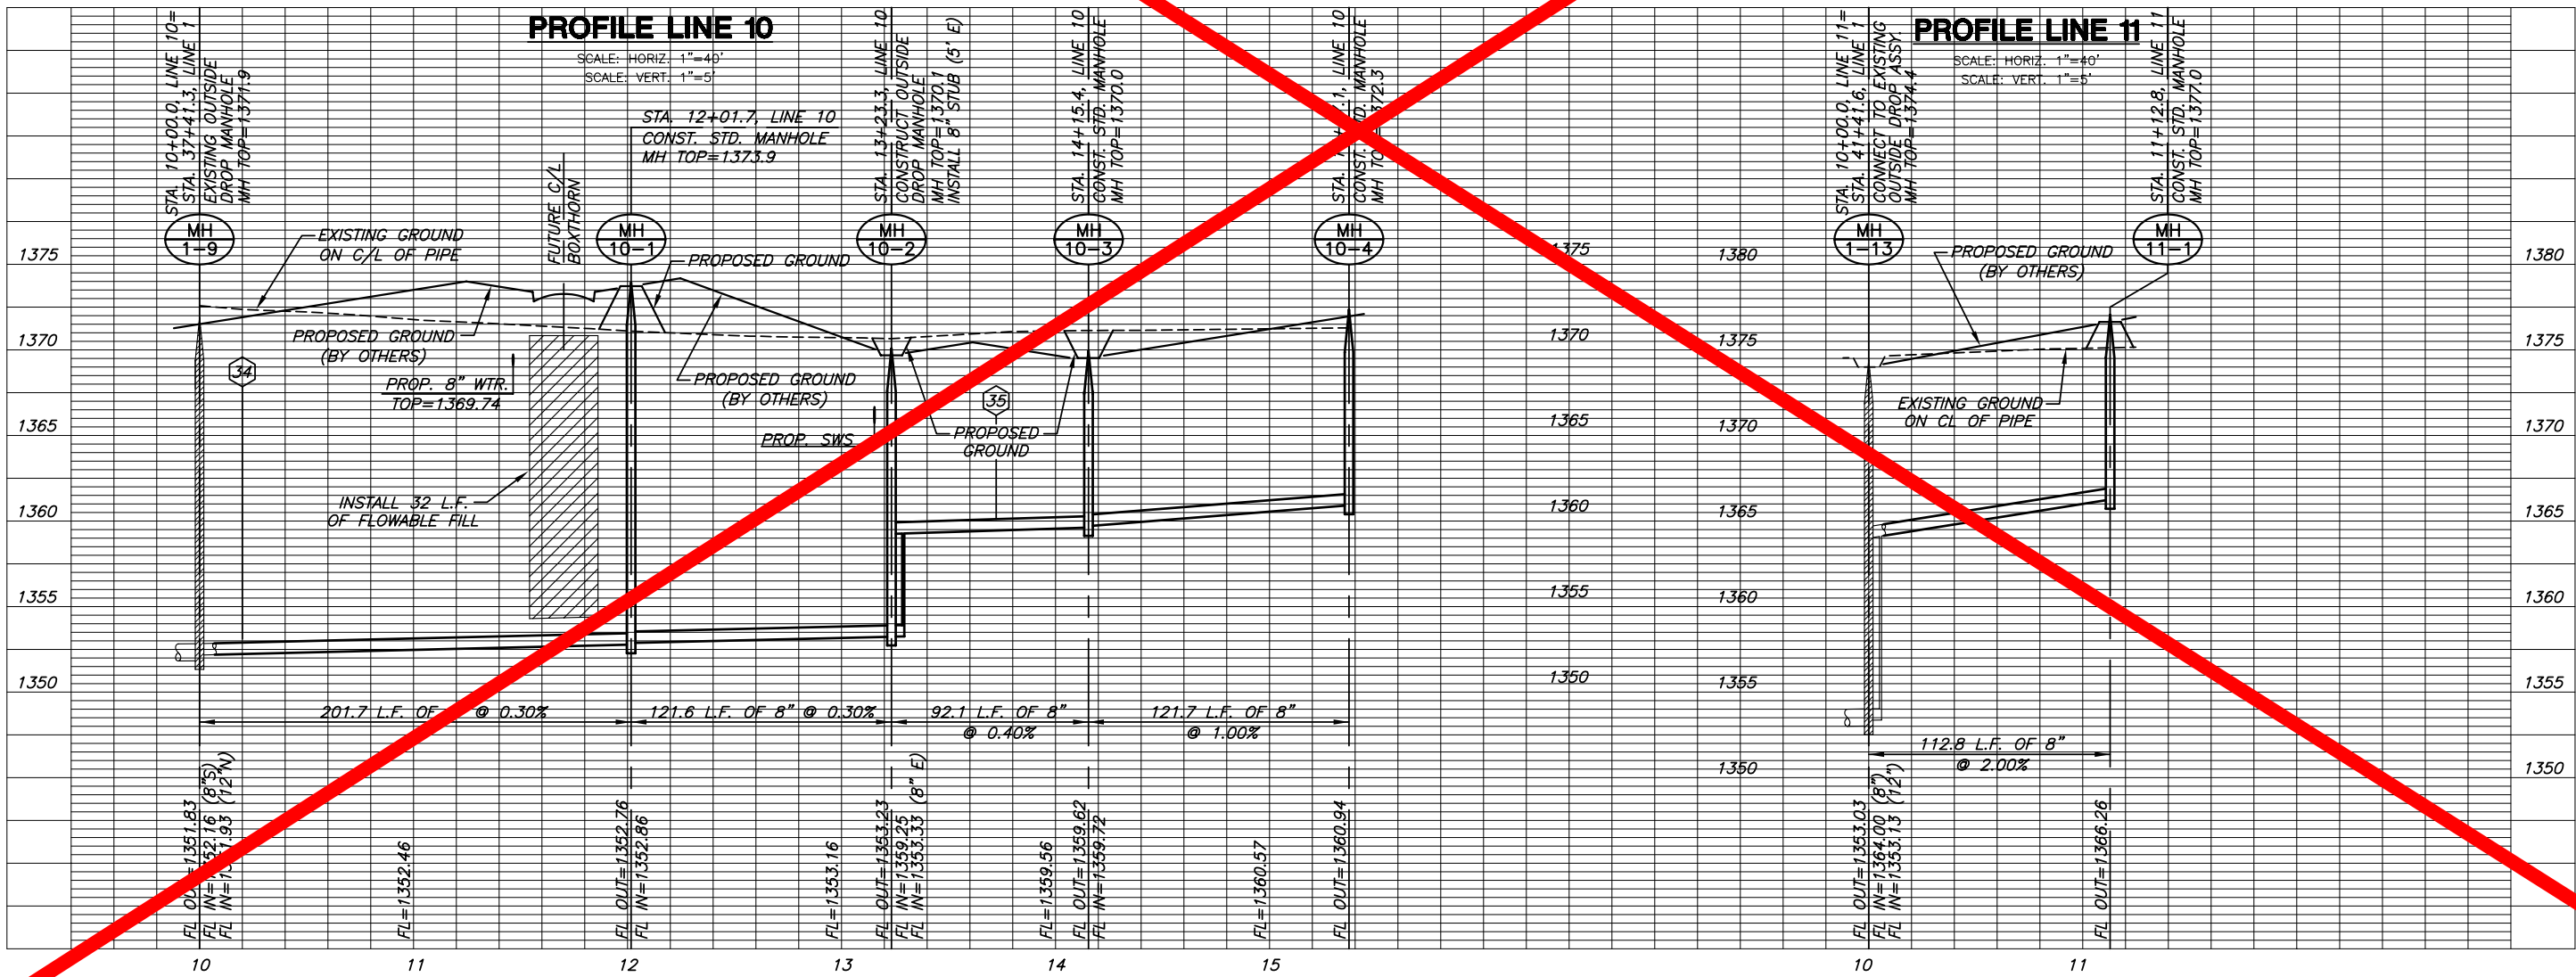

PLOTTED: Wednesday, January 31, 2007 @ 07:14AM

J:\CIVIL\0627\DWG\SAN\PH1\06201_LB10.DWG