


PAVED PLAN
1911
GILBERT
E.L. ESTELLE
W.L. VOLUTSIA

Gilbert E.L. Estelle W.L. Volutsia

30' E curb concr.

B.M. Elev. 108.79 "K" in Keeler Inter. SW Gilbert & Volutsia
 B.M. Elev. 108.21 "W" in Volutsia NWPL Morris.

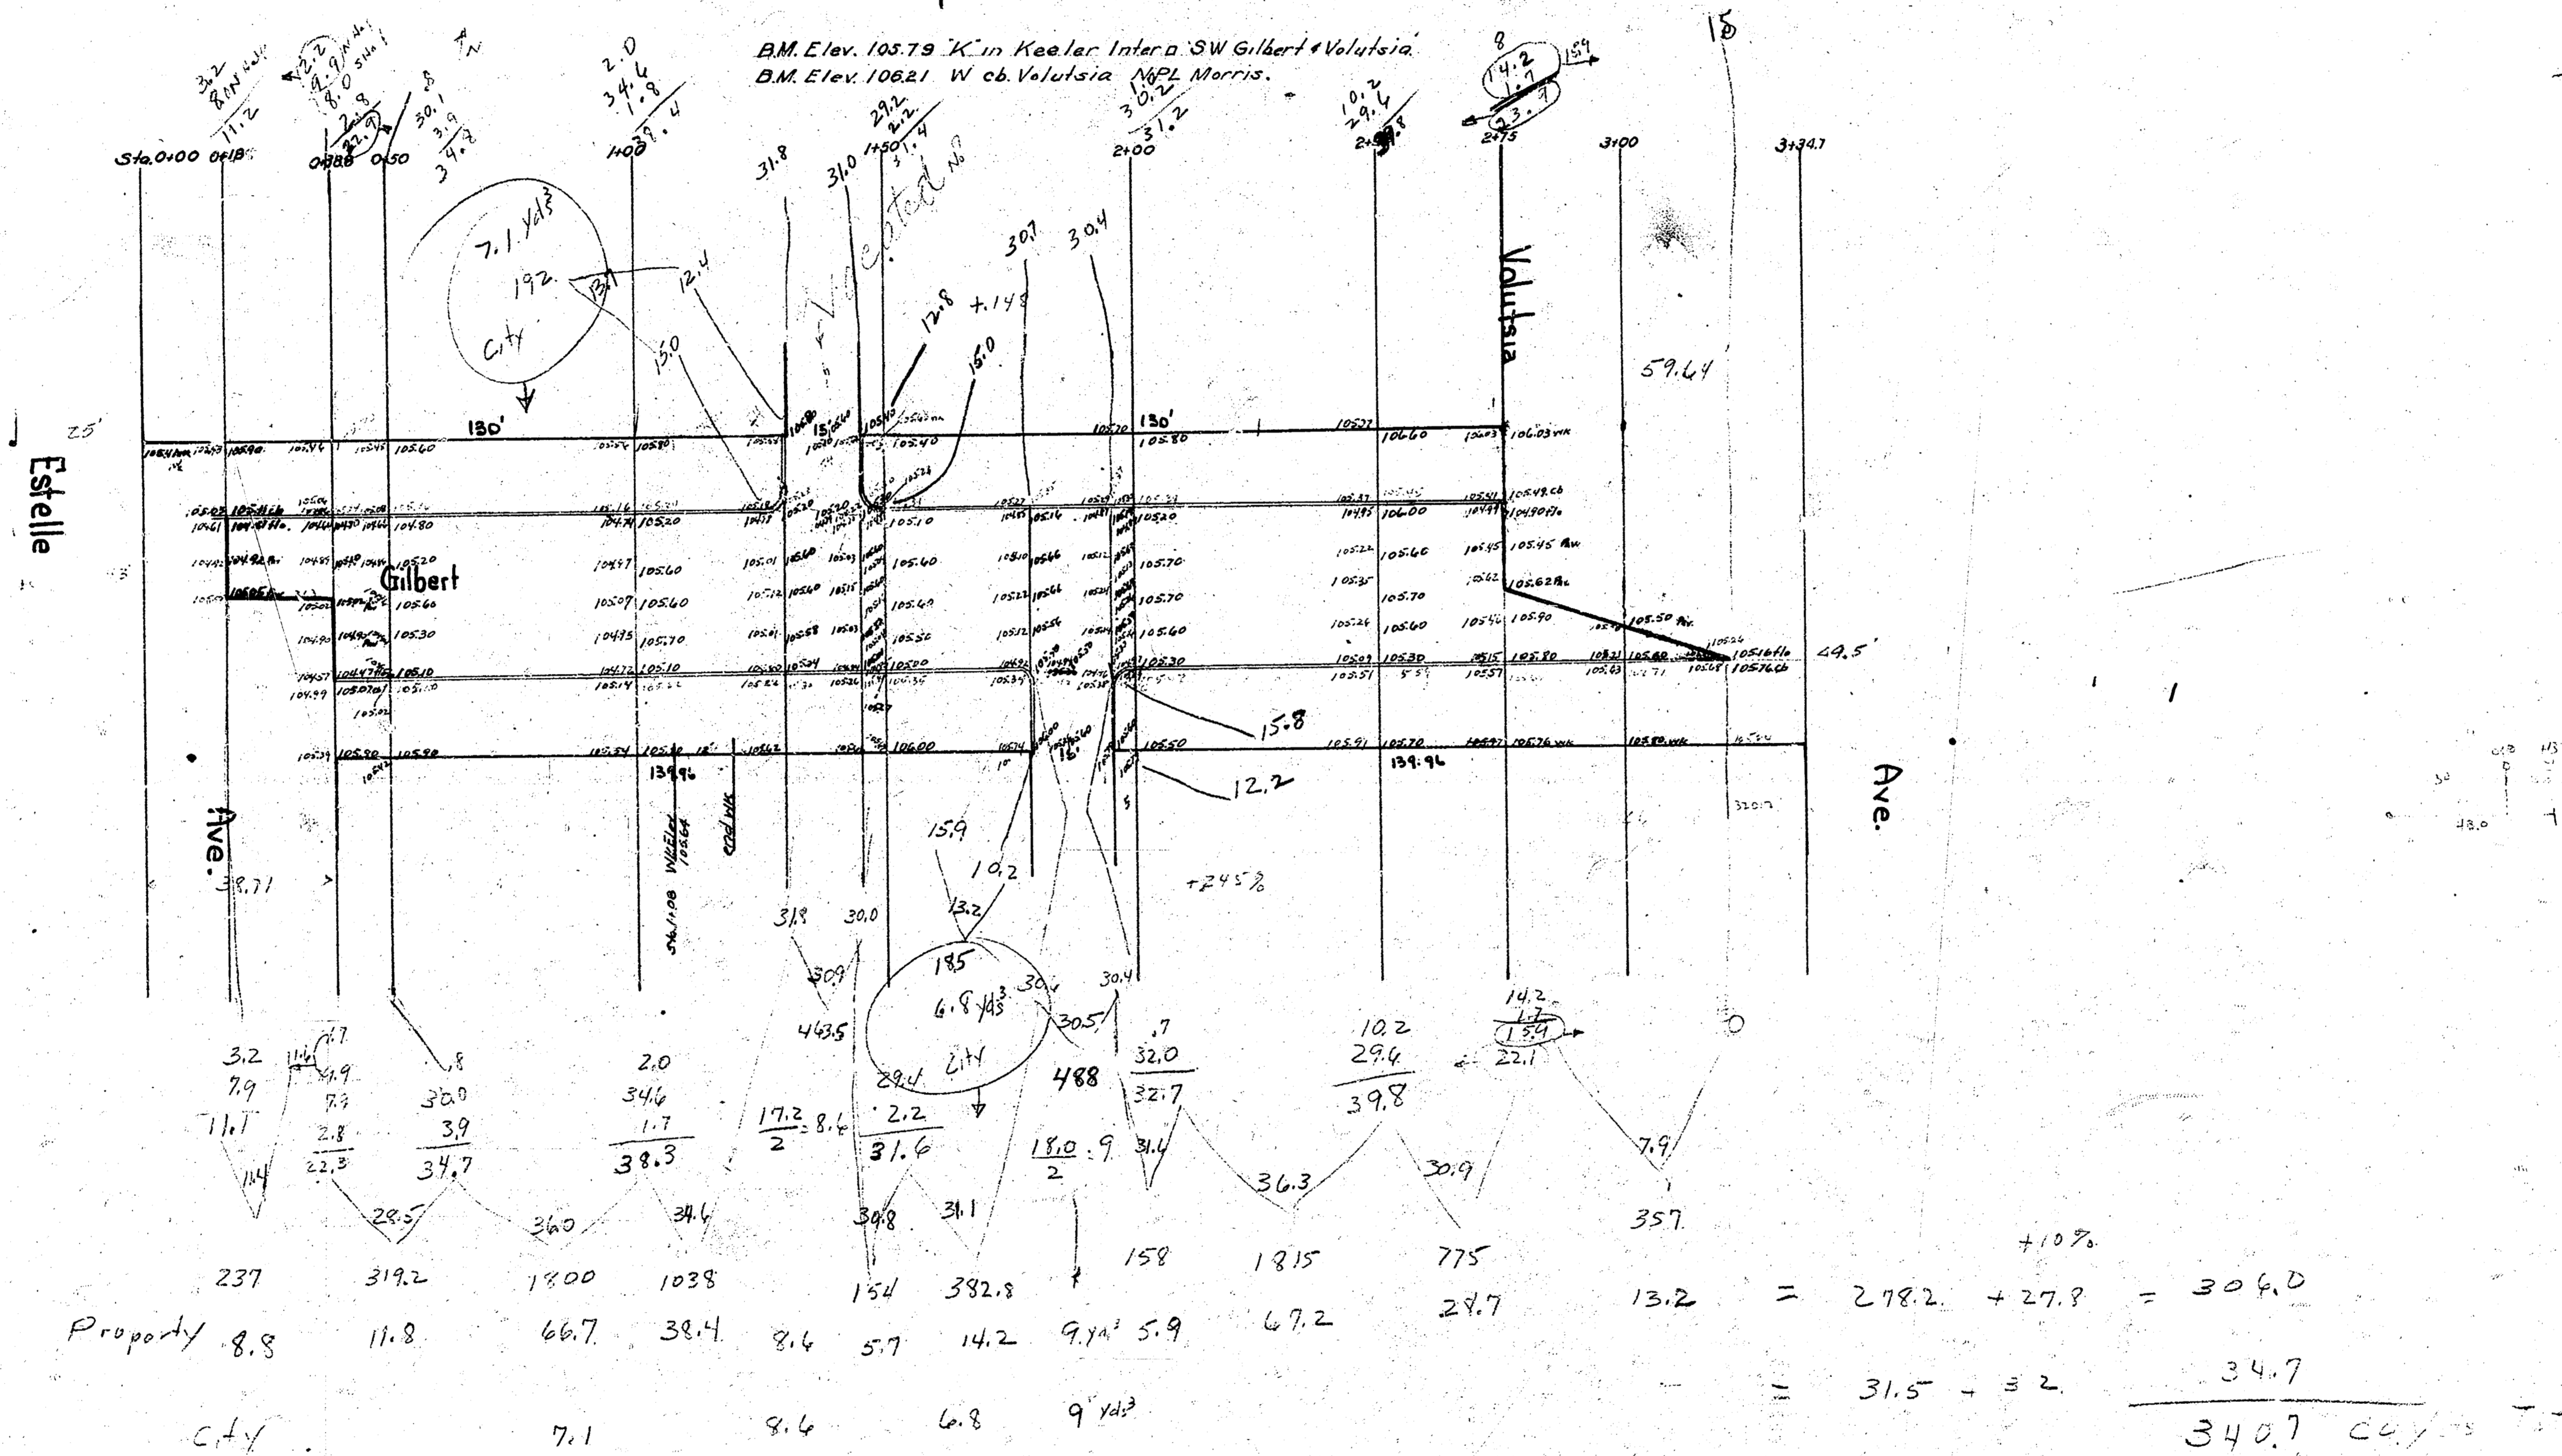

Survey Plan
 1940
 Gilbert St.
 E.L. Estelle
 To
 W.L. Volutsia