


NOTE TO CONTRACTOR & FIELD ENGINEER
 ENTRANCE PIPE WILL BE DISPOSED OF IN ACCORDANCE
 WITH INSTRUCTIONS OF DIRT CHECKER.

NOTE TO FIELD ENGINEER


1. CHAIN NORTH ON E. OF HOOD. E. HOOD HAS A DEFLECTION TO THE LEFT OF 0° 03' AT STA 0+0.
2. OBTAIN TIES TO IRON IN STREET BEFORE CONSTR. BEGINS.


B.M. "M" IN MUELLER ON FIRE HYD. N.E. COR. PAYNE & BELLE ELEV. 128.48
 STEP B.M. S.E. SIDE P. POLE N.W. COR. BELLE & HOOD ELEV. 129.47

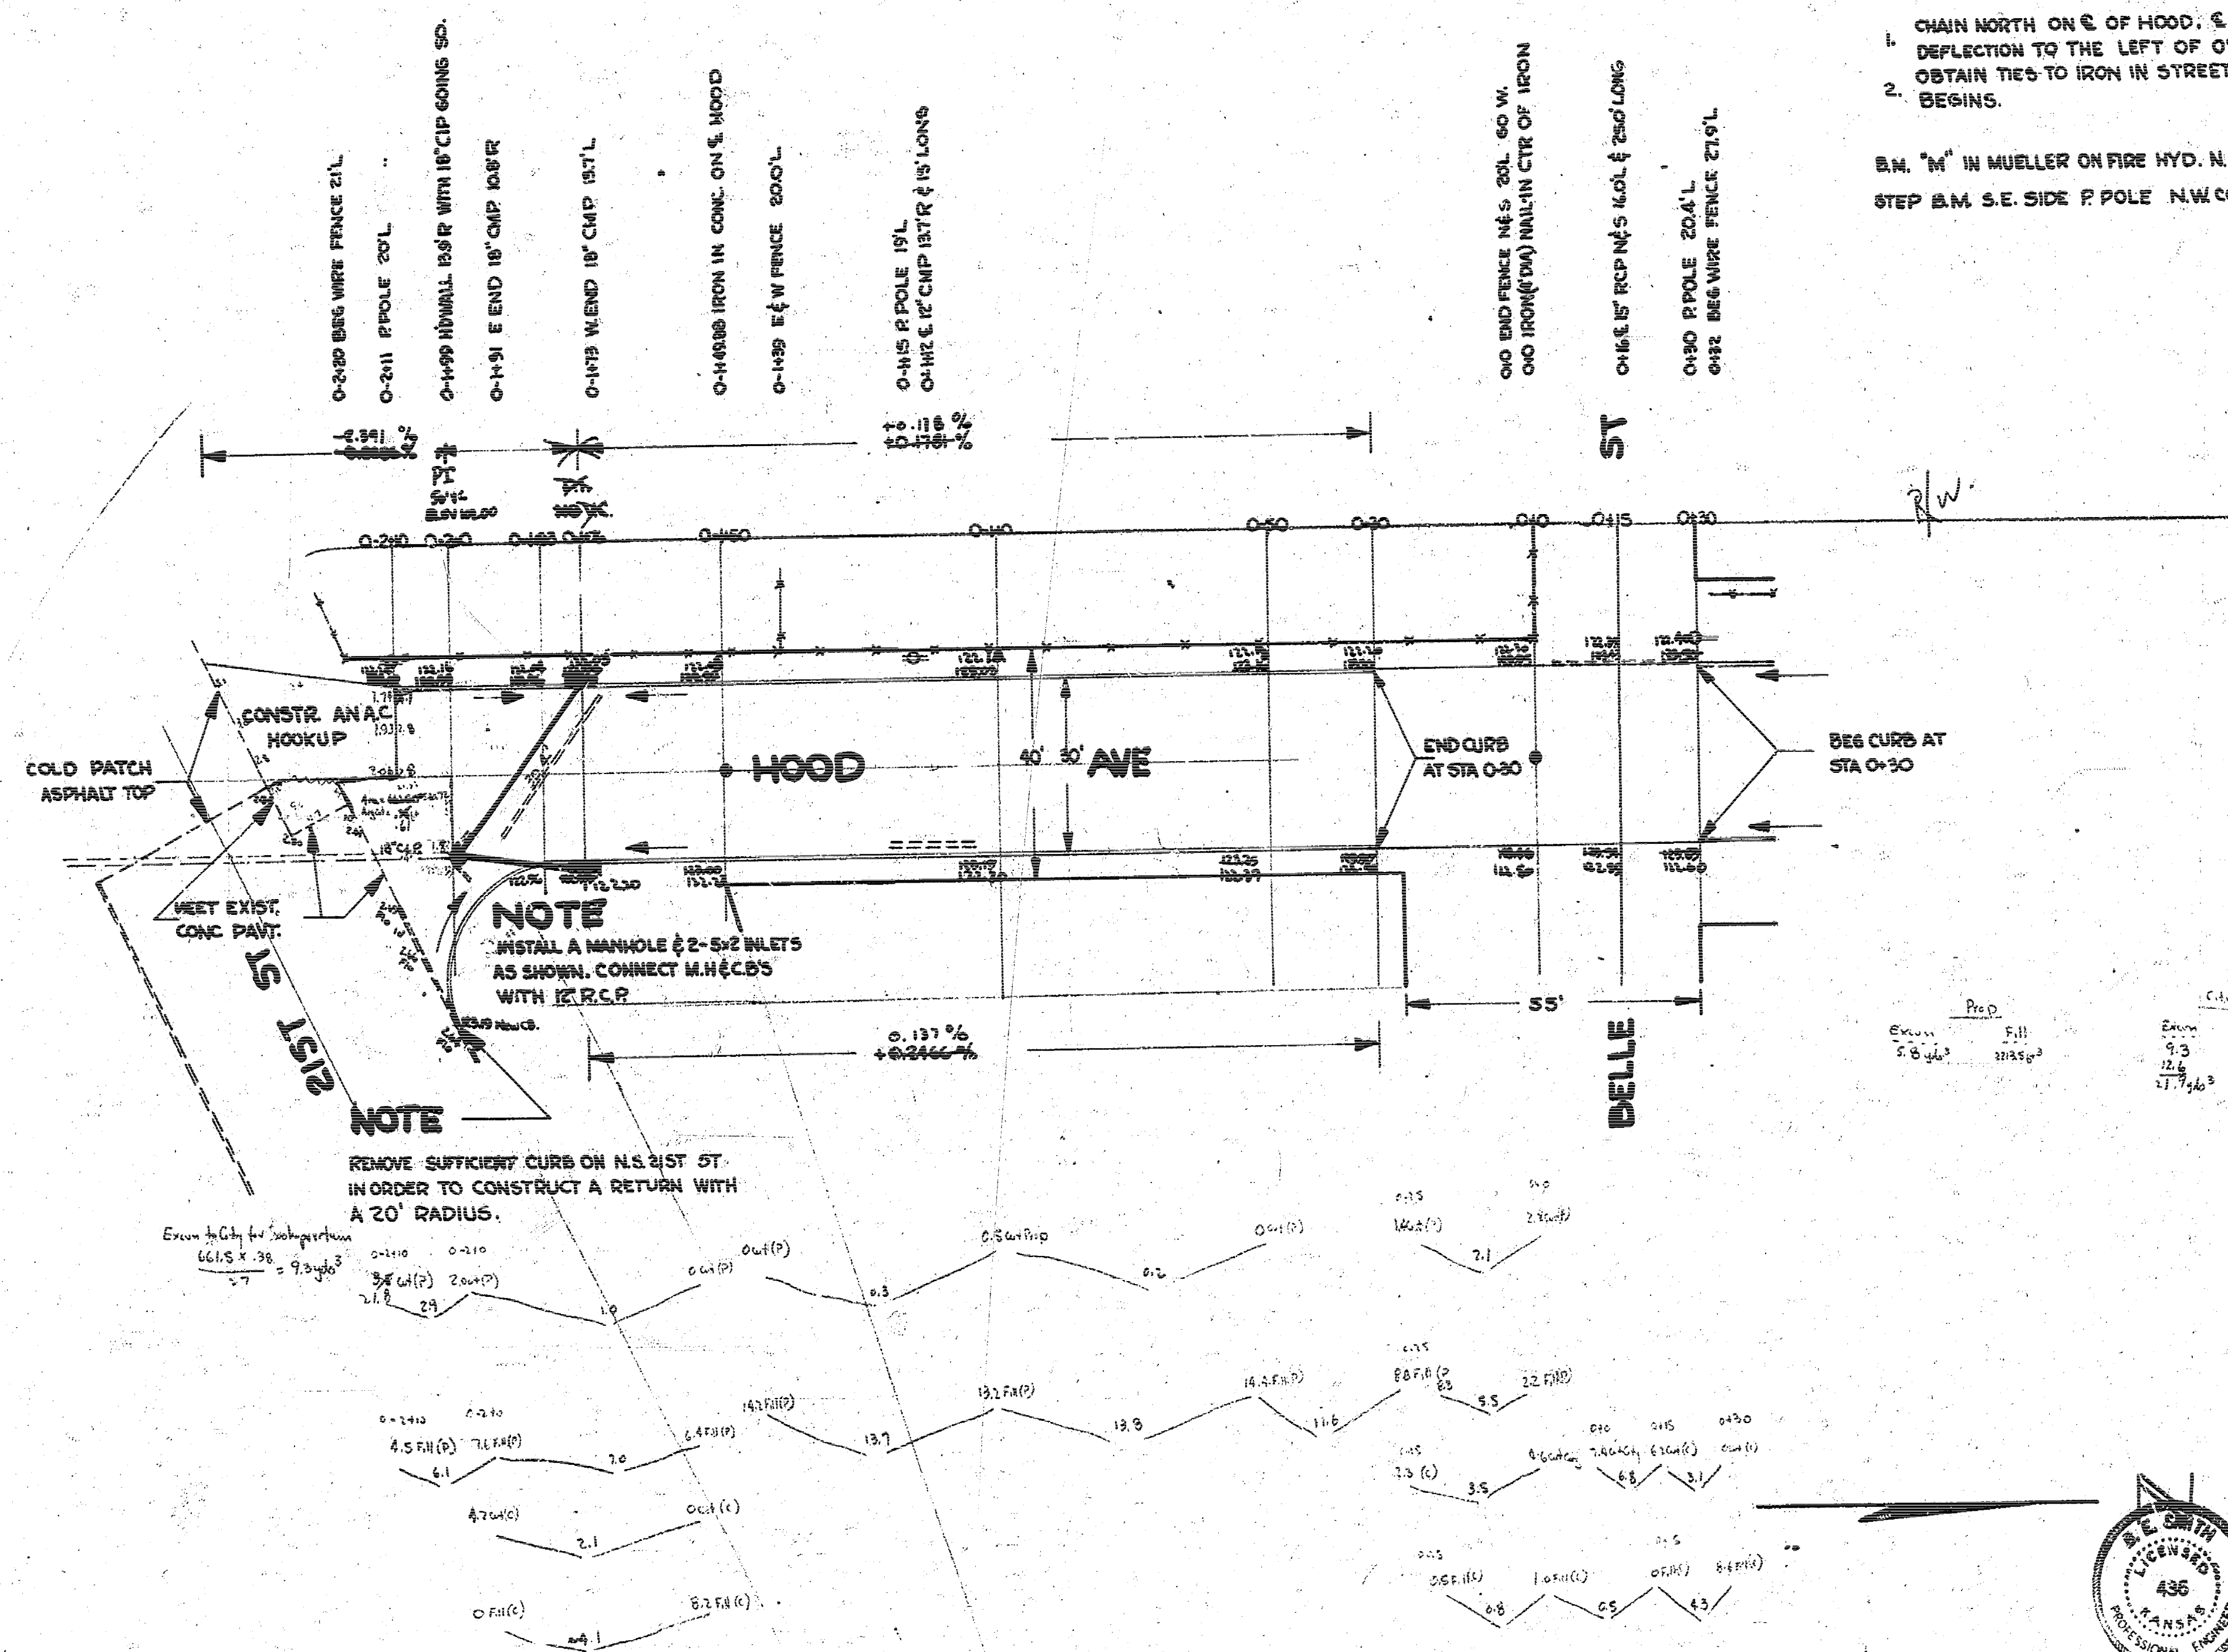



Revised 4-14-54 JD

HOOD AVE
 N.L. 21 ST TO S.L. 27TH
30' CONC & CURB
CITY OF WICHITA, KANSAS
 B.E. SMITH
 MAR 1954
 CITY ENGINEER
 PROJ. NO. C10-198

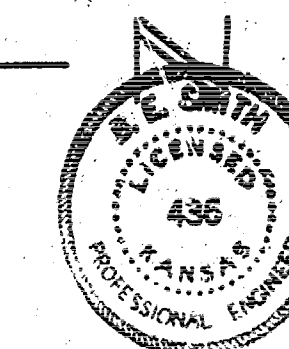

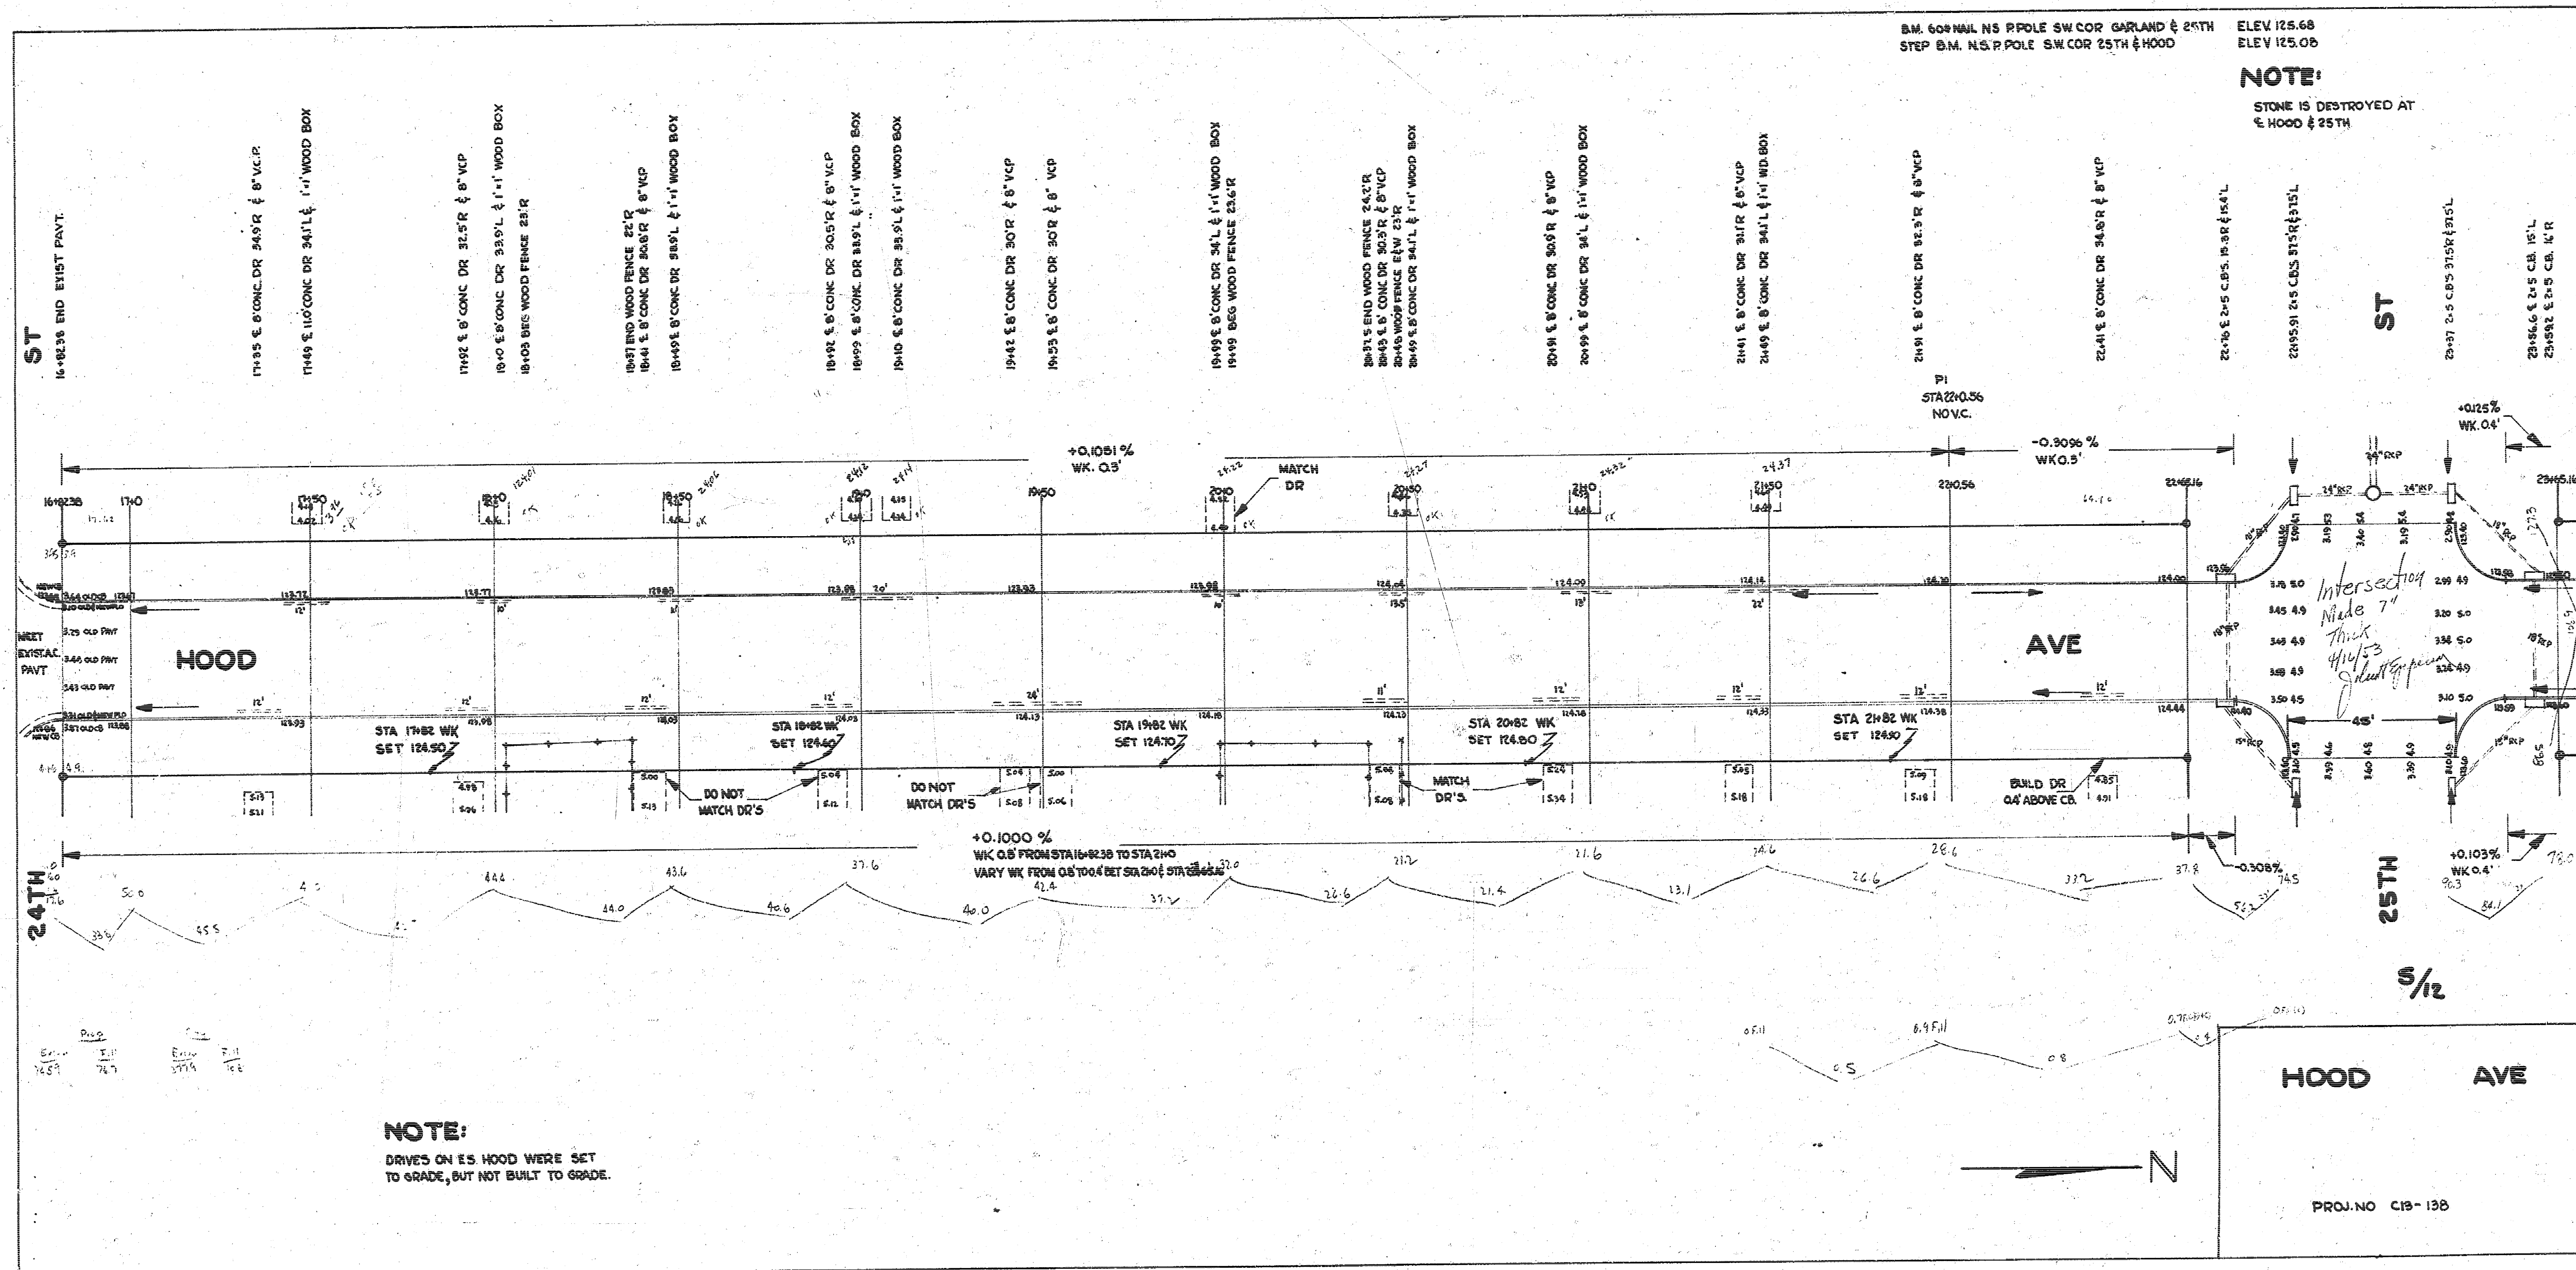

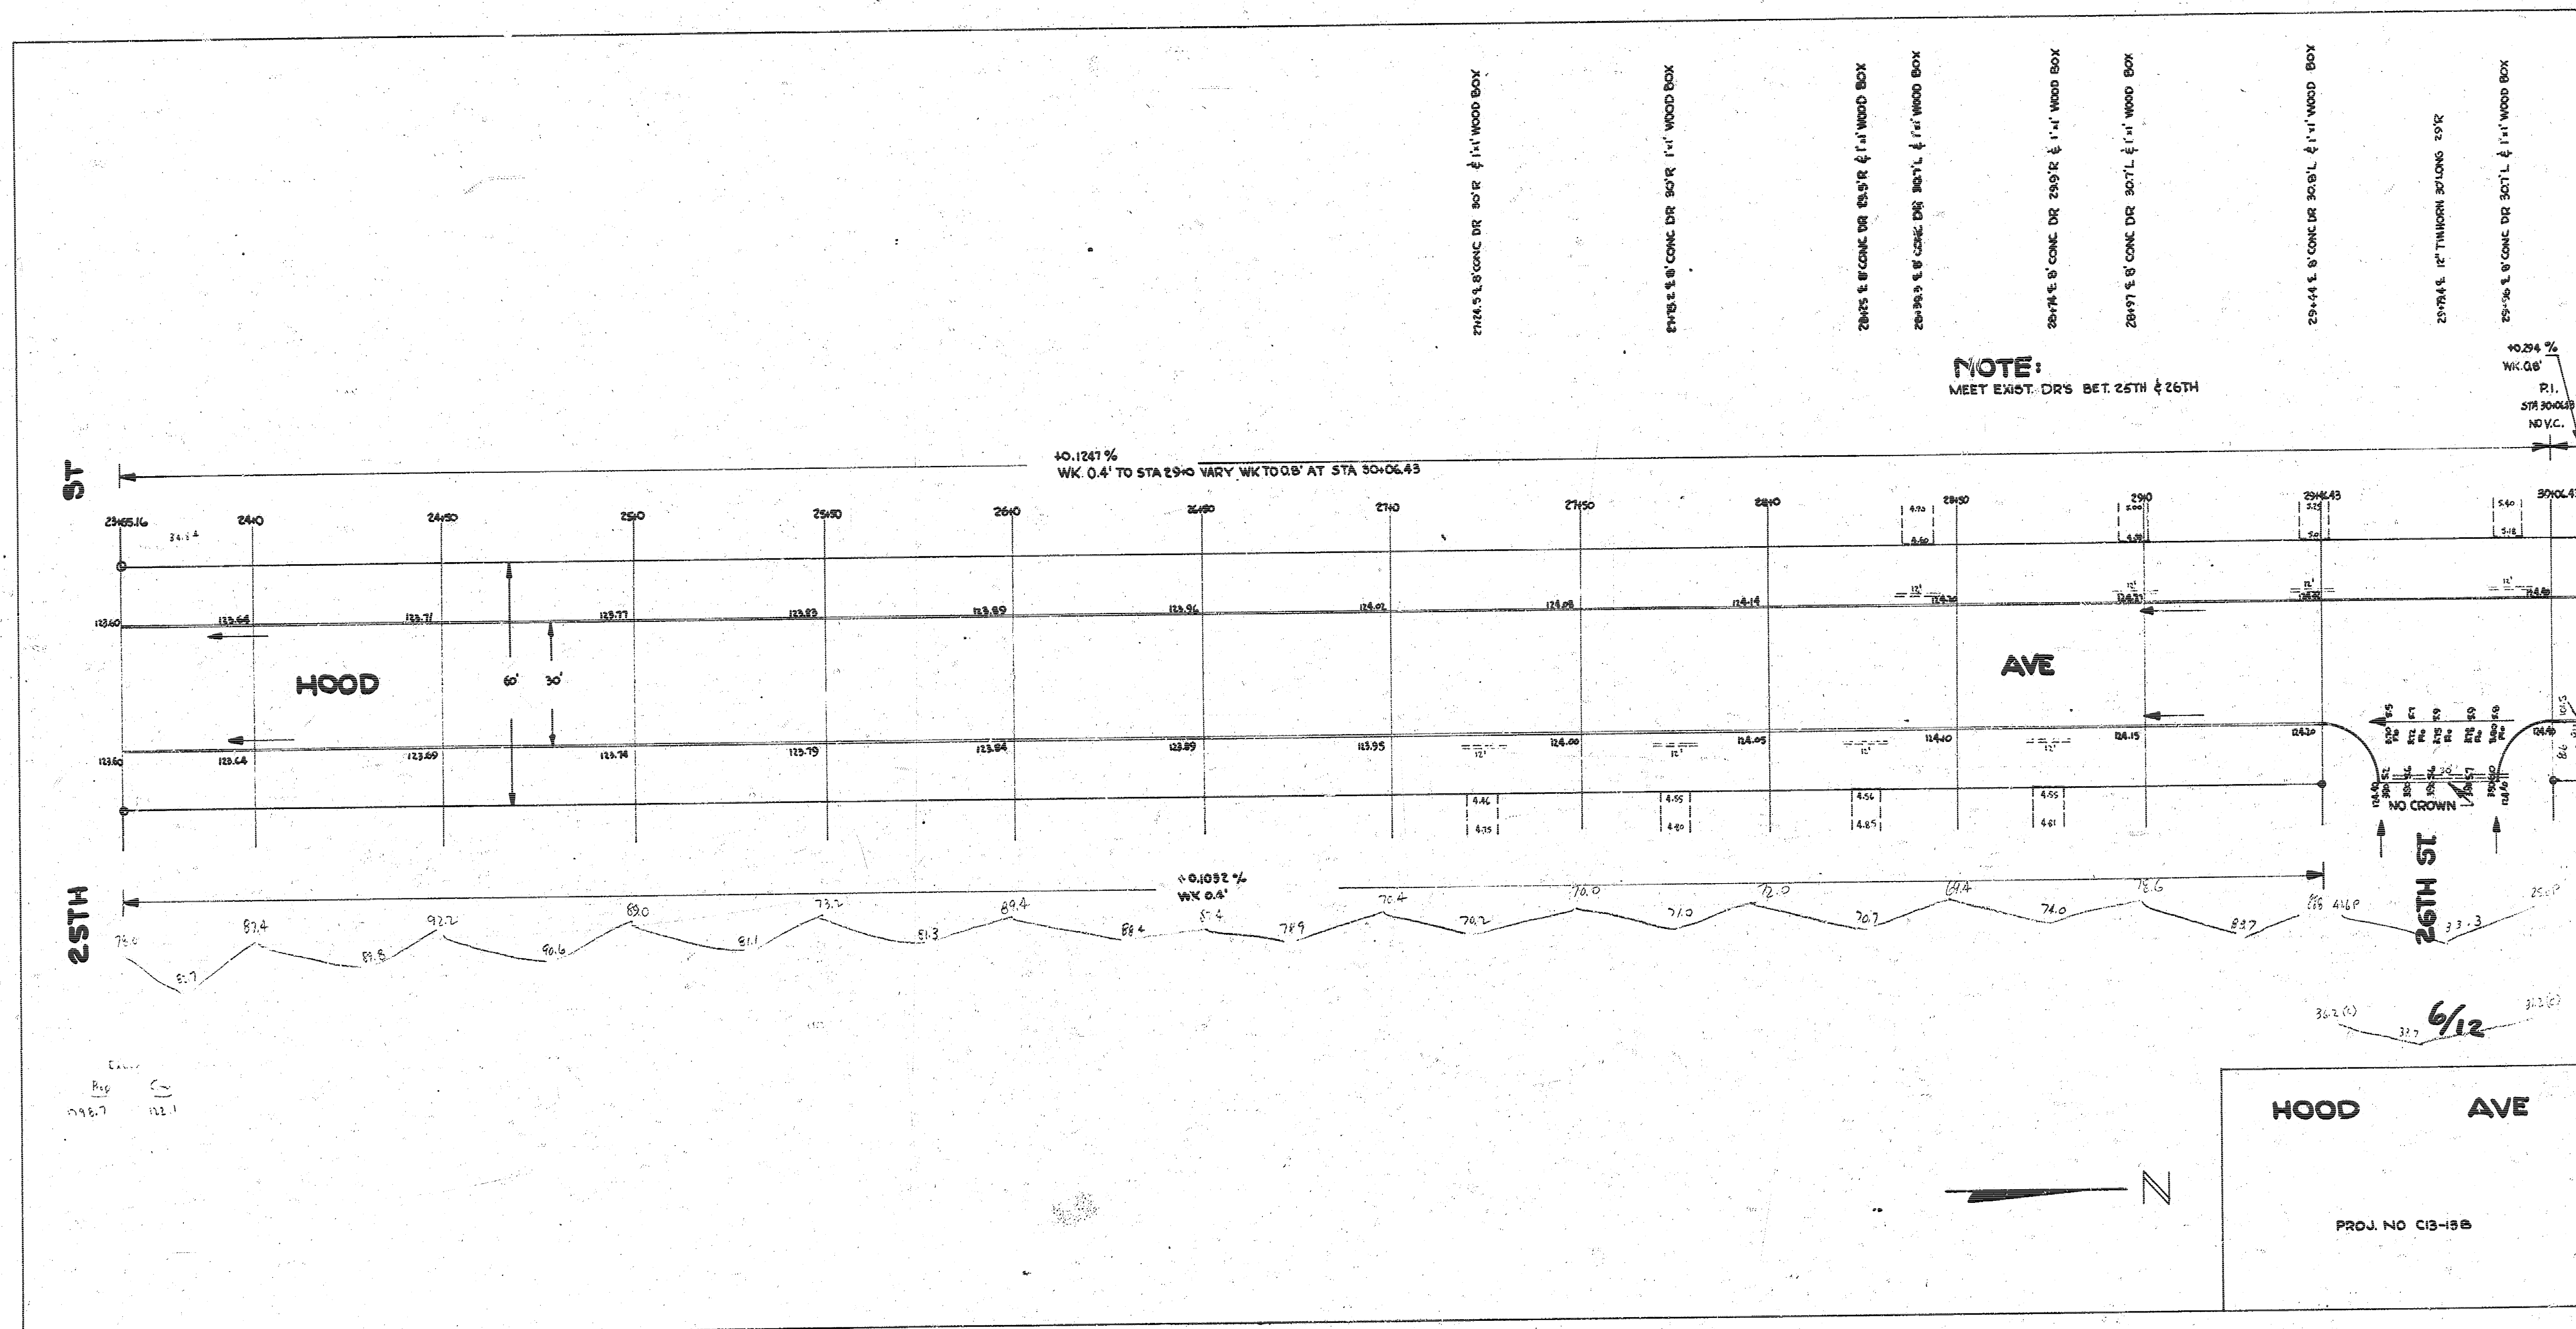

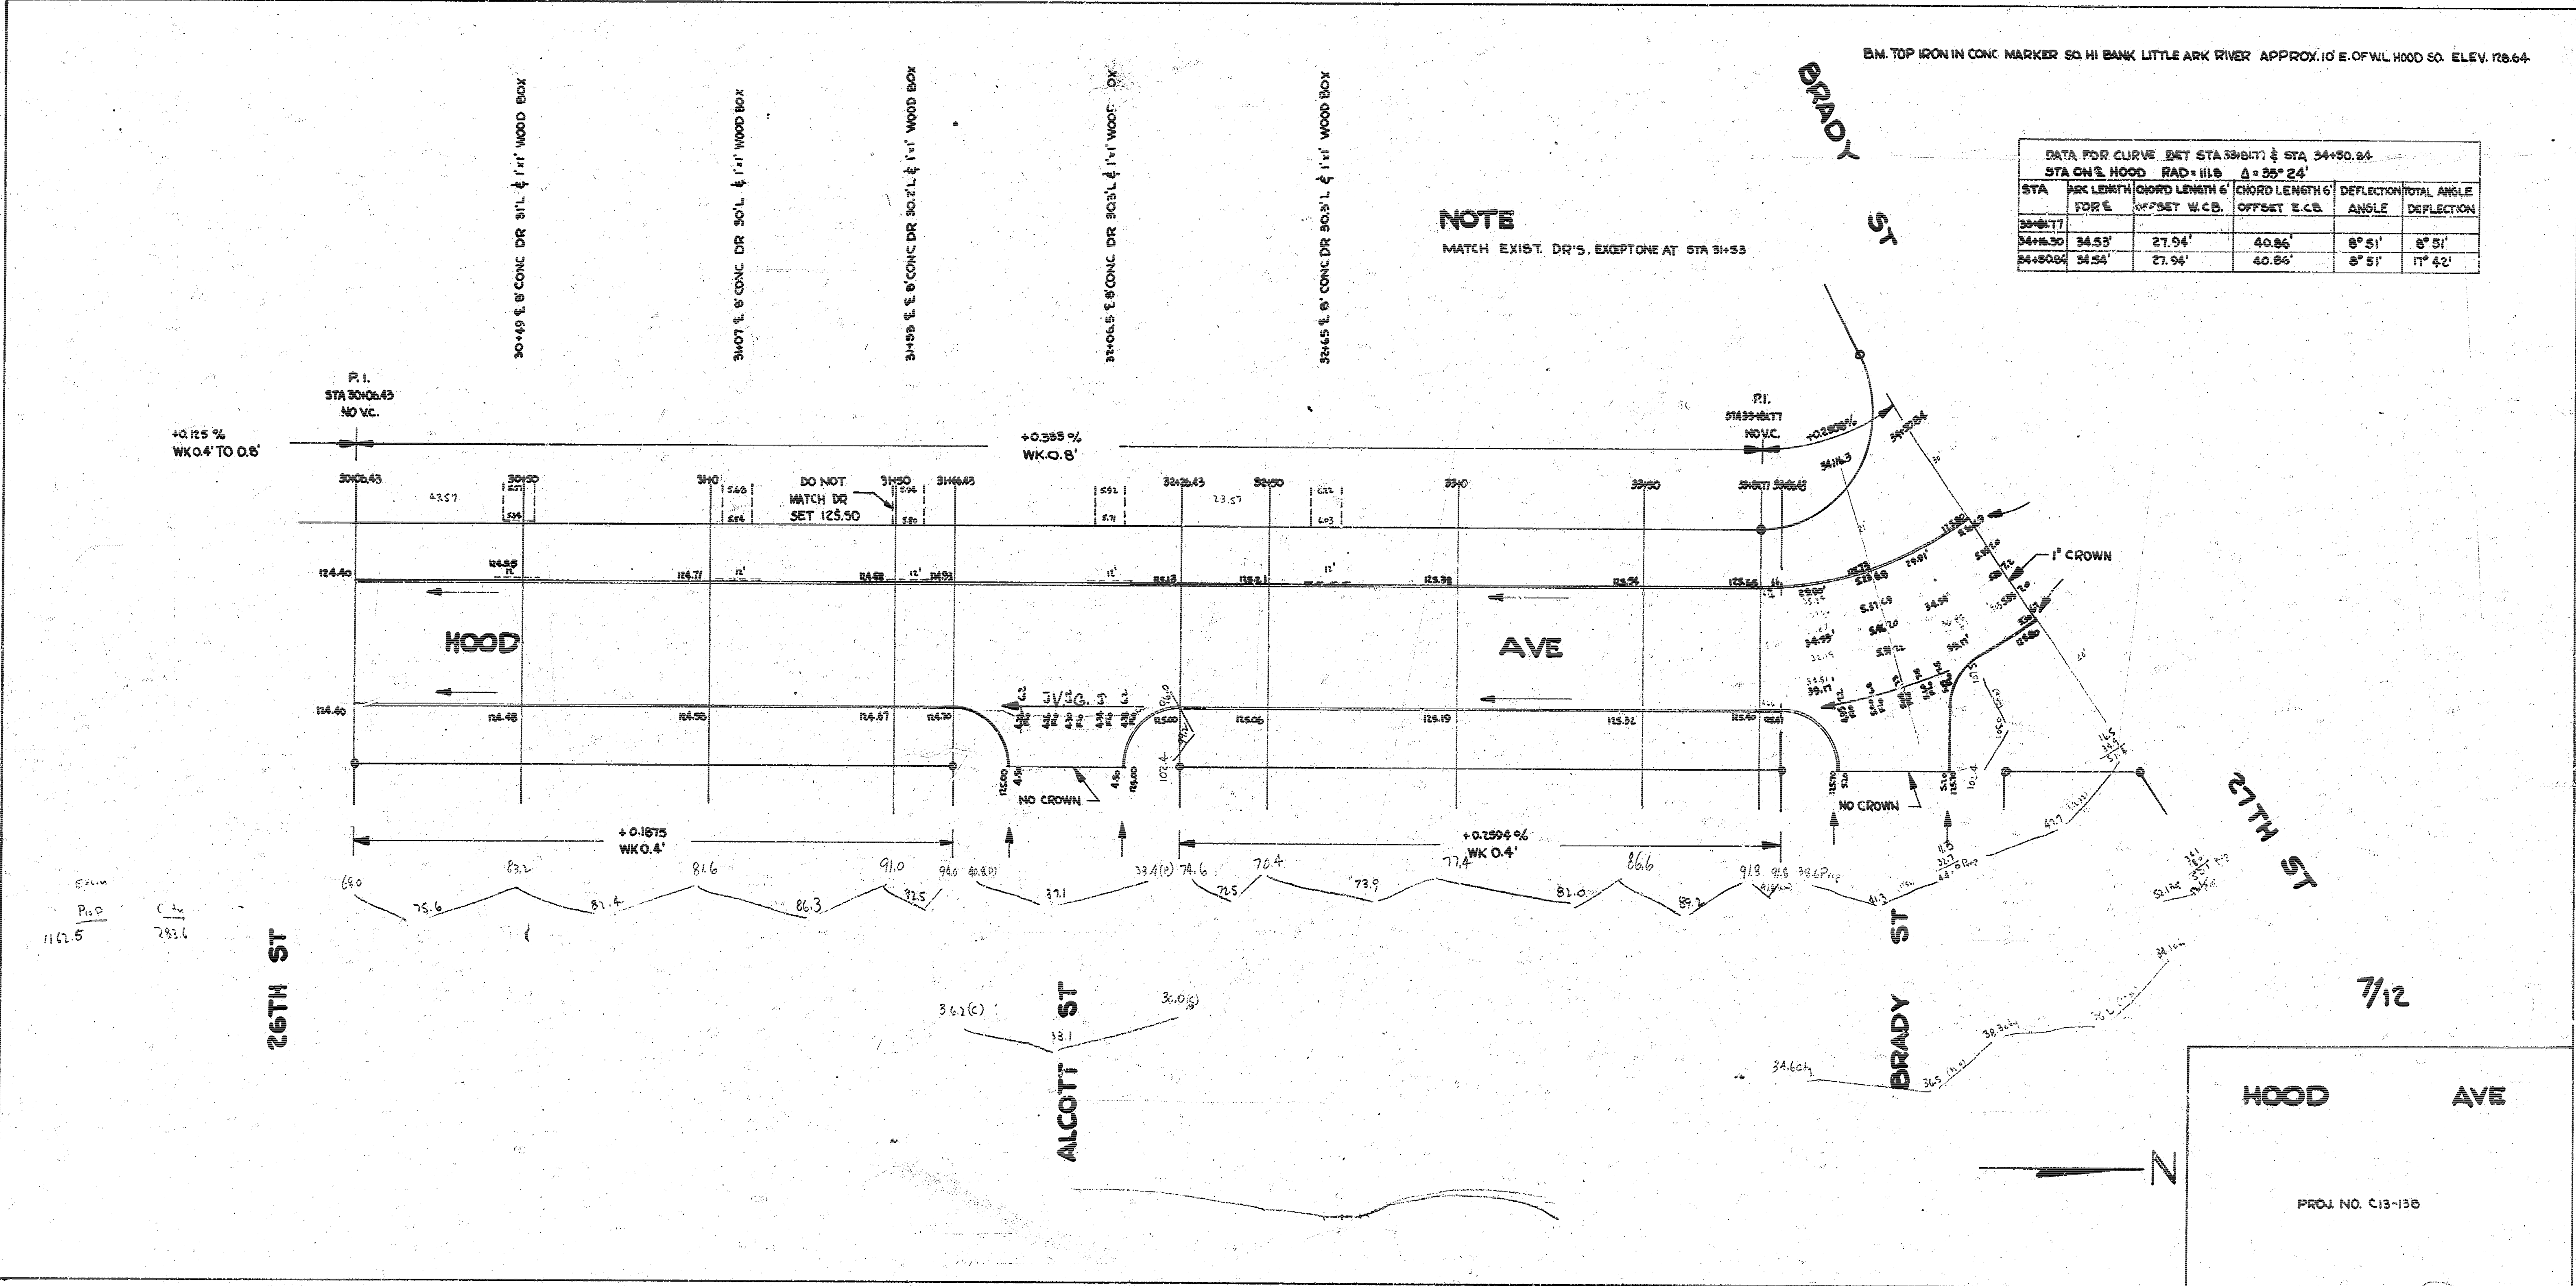

3187.3
154.0
3187.3
154.0

16.0
154.0
154.0

3085.1
158.0
3187.3