

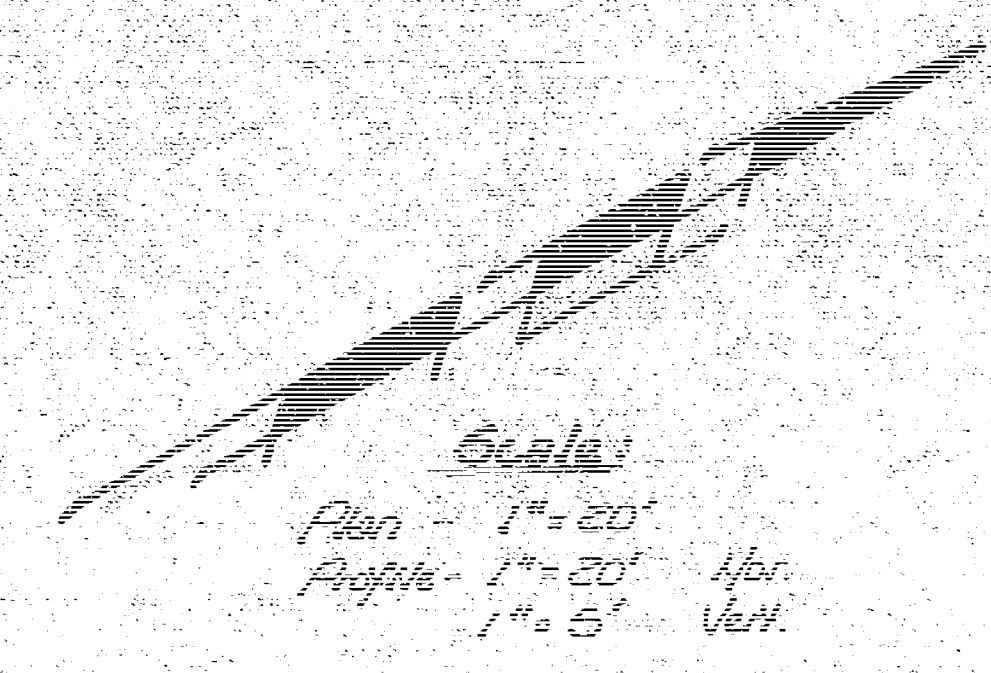
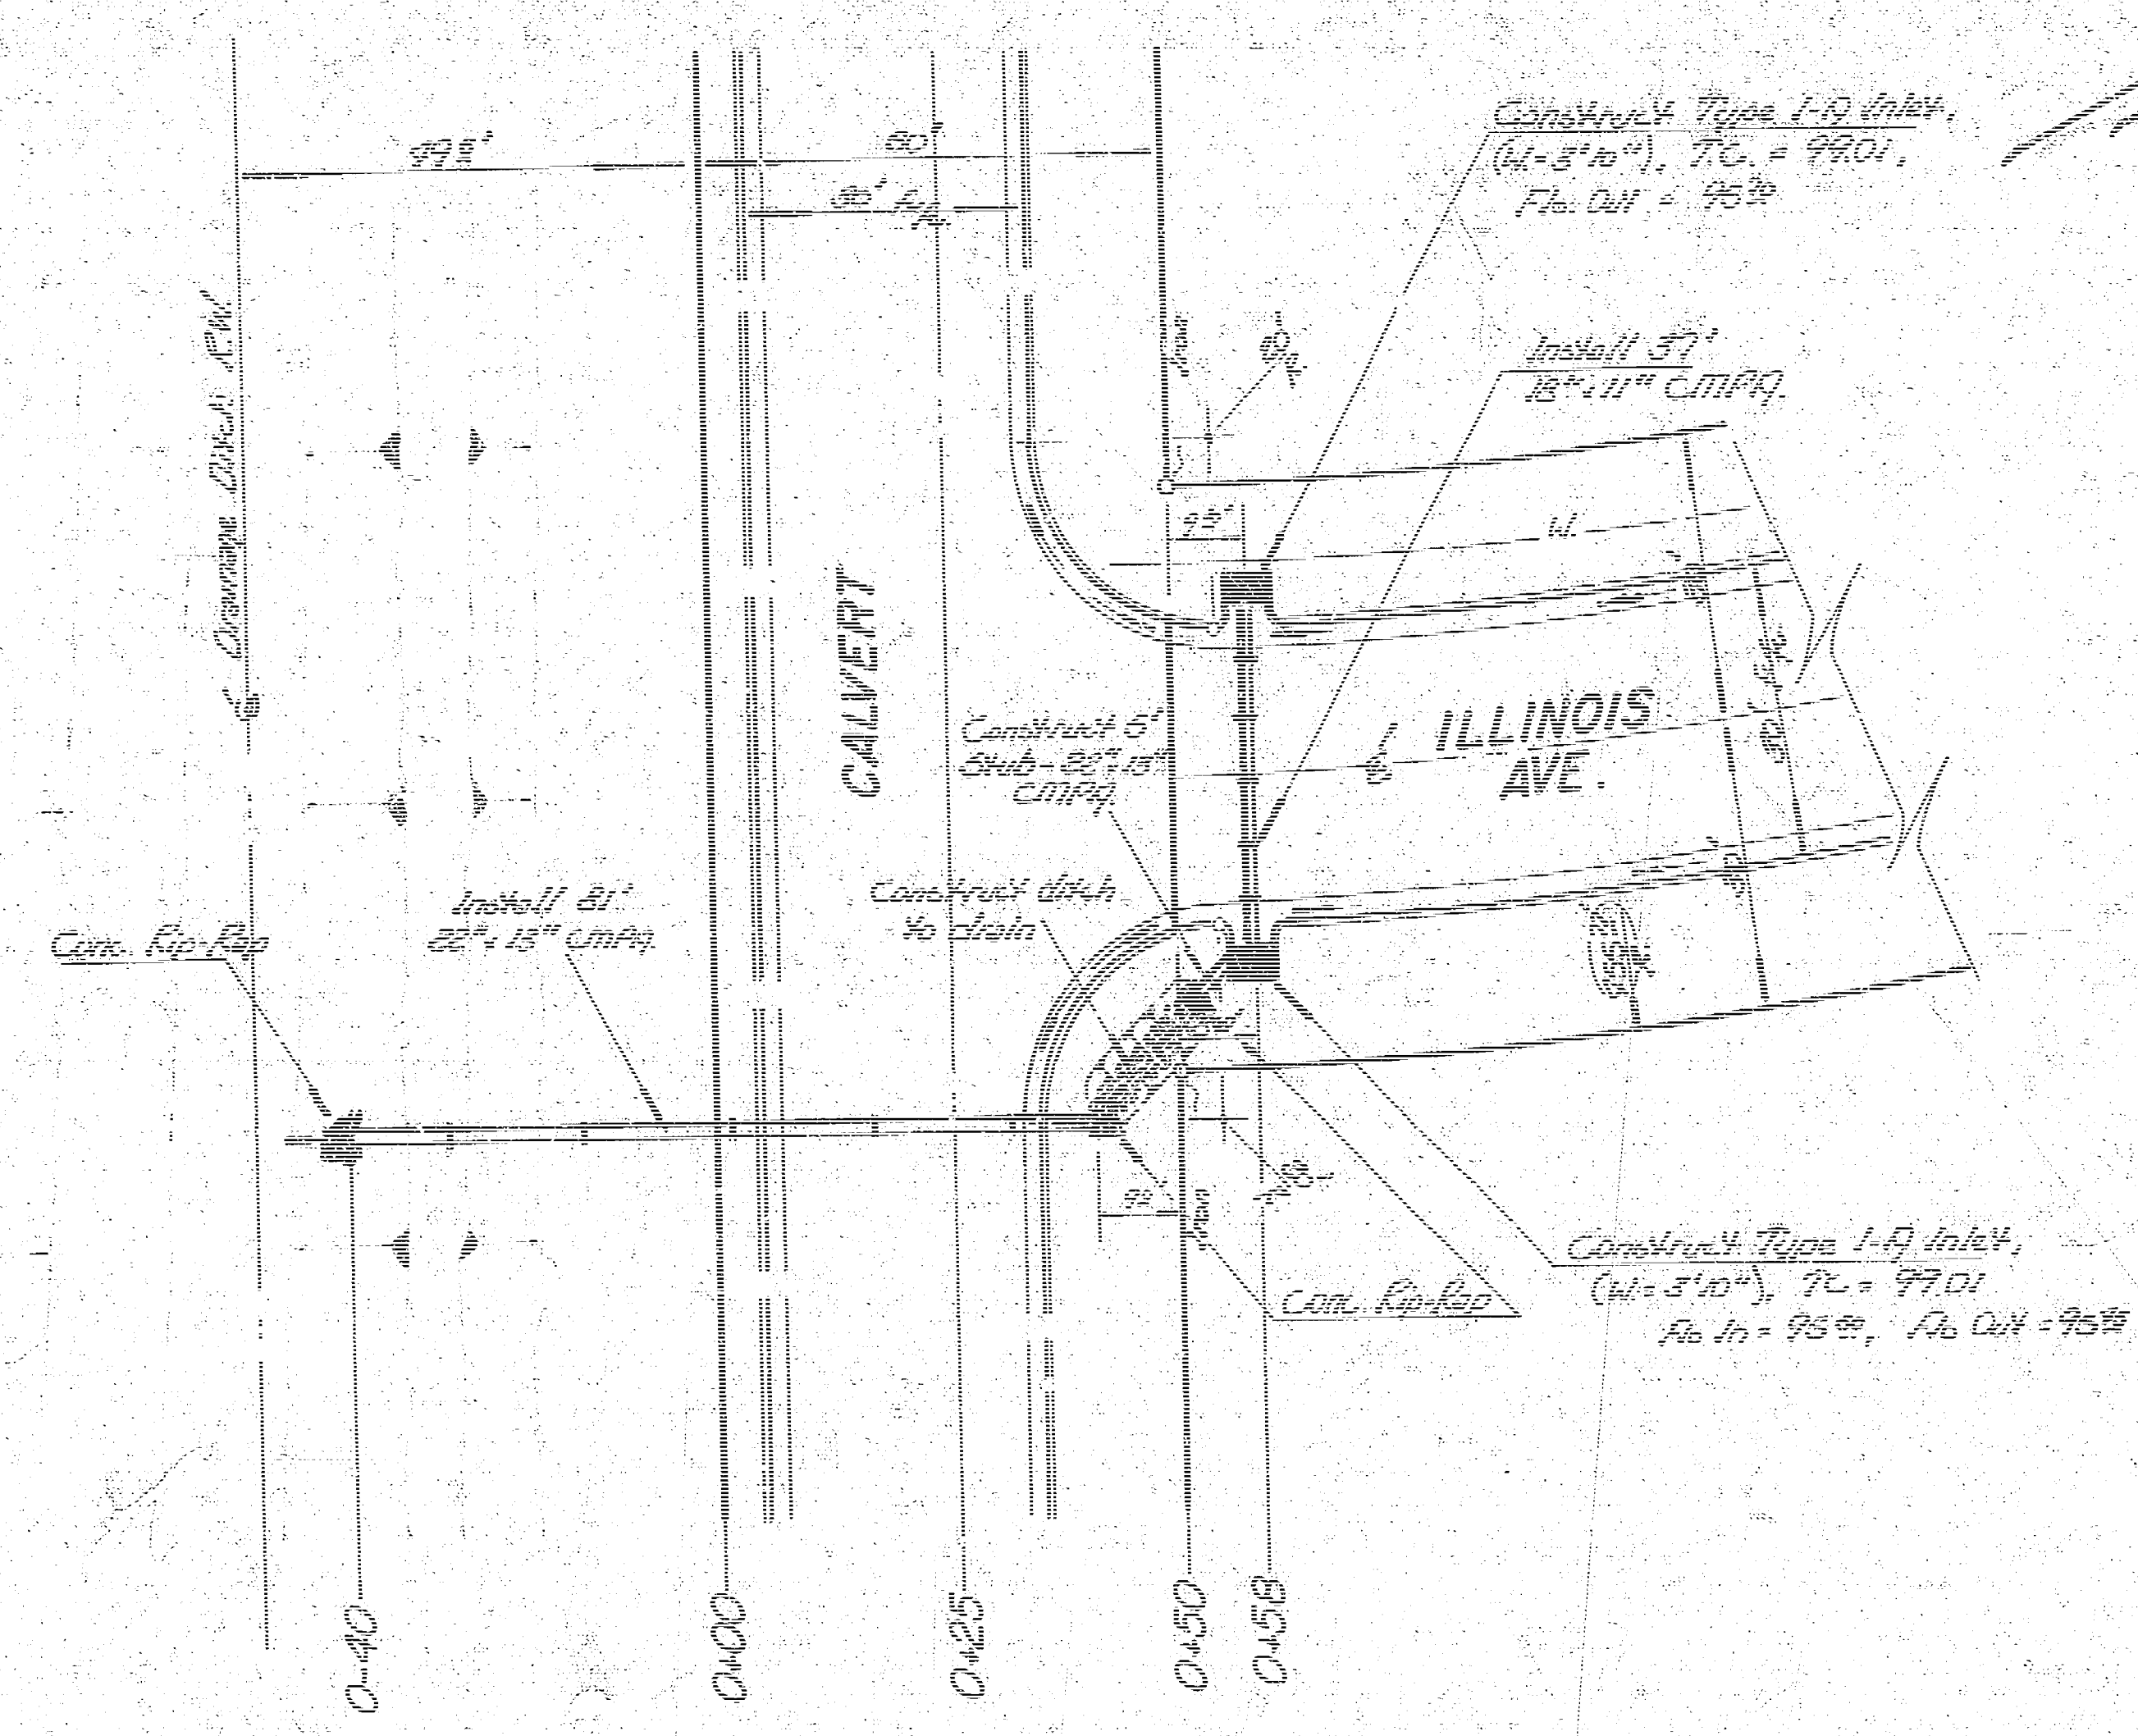


B.M. 10153 = Top Curbs West Return Conduit at Cor. 81st & Illinois Ave.

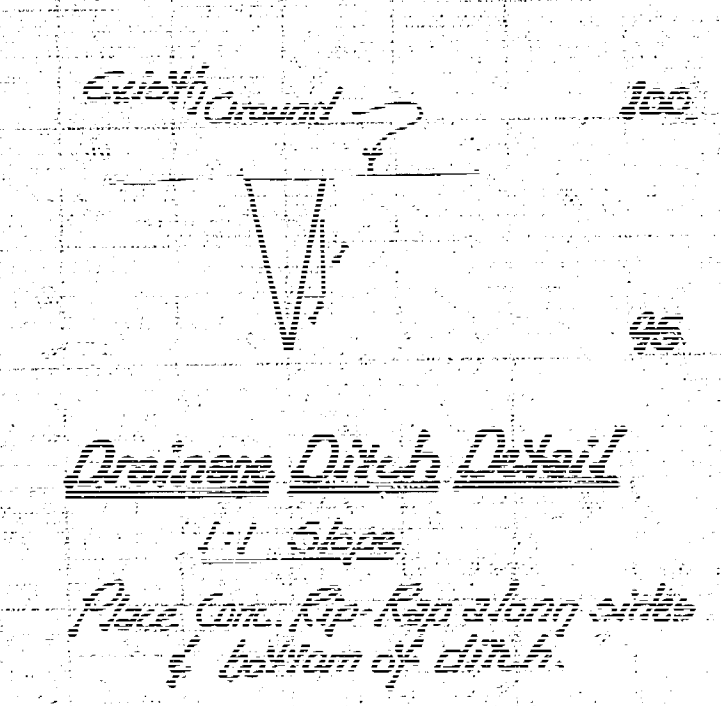

Note:
All Inlets to be Type 1-D Construction.
Conc. Rip-Rap is to be considered as incidental to L.P. Pipe.

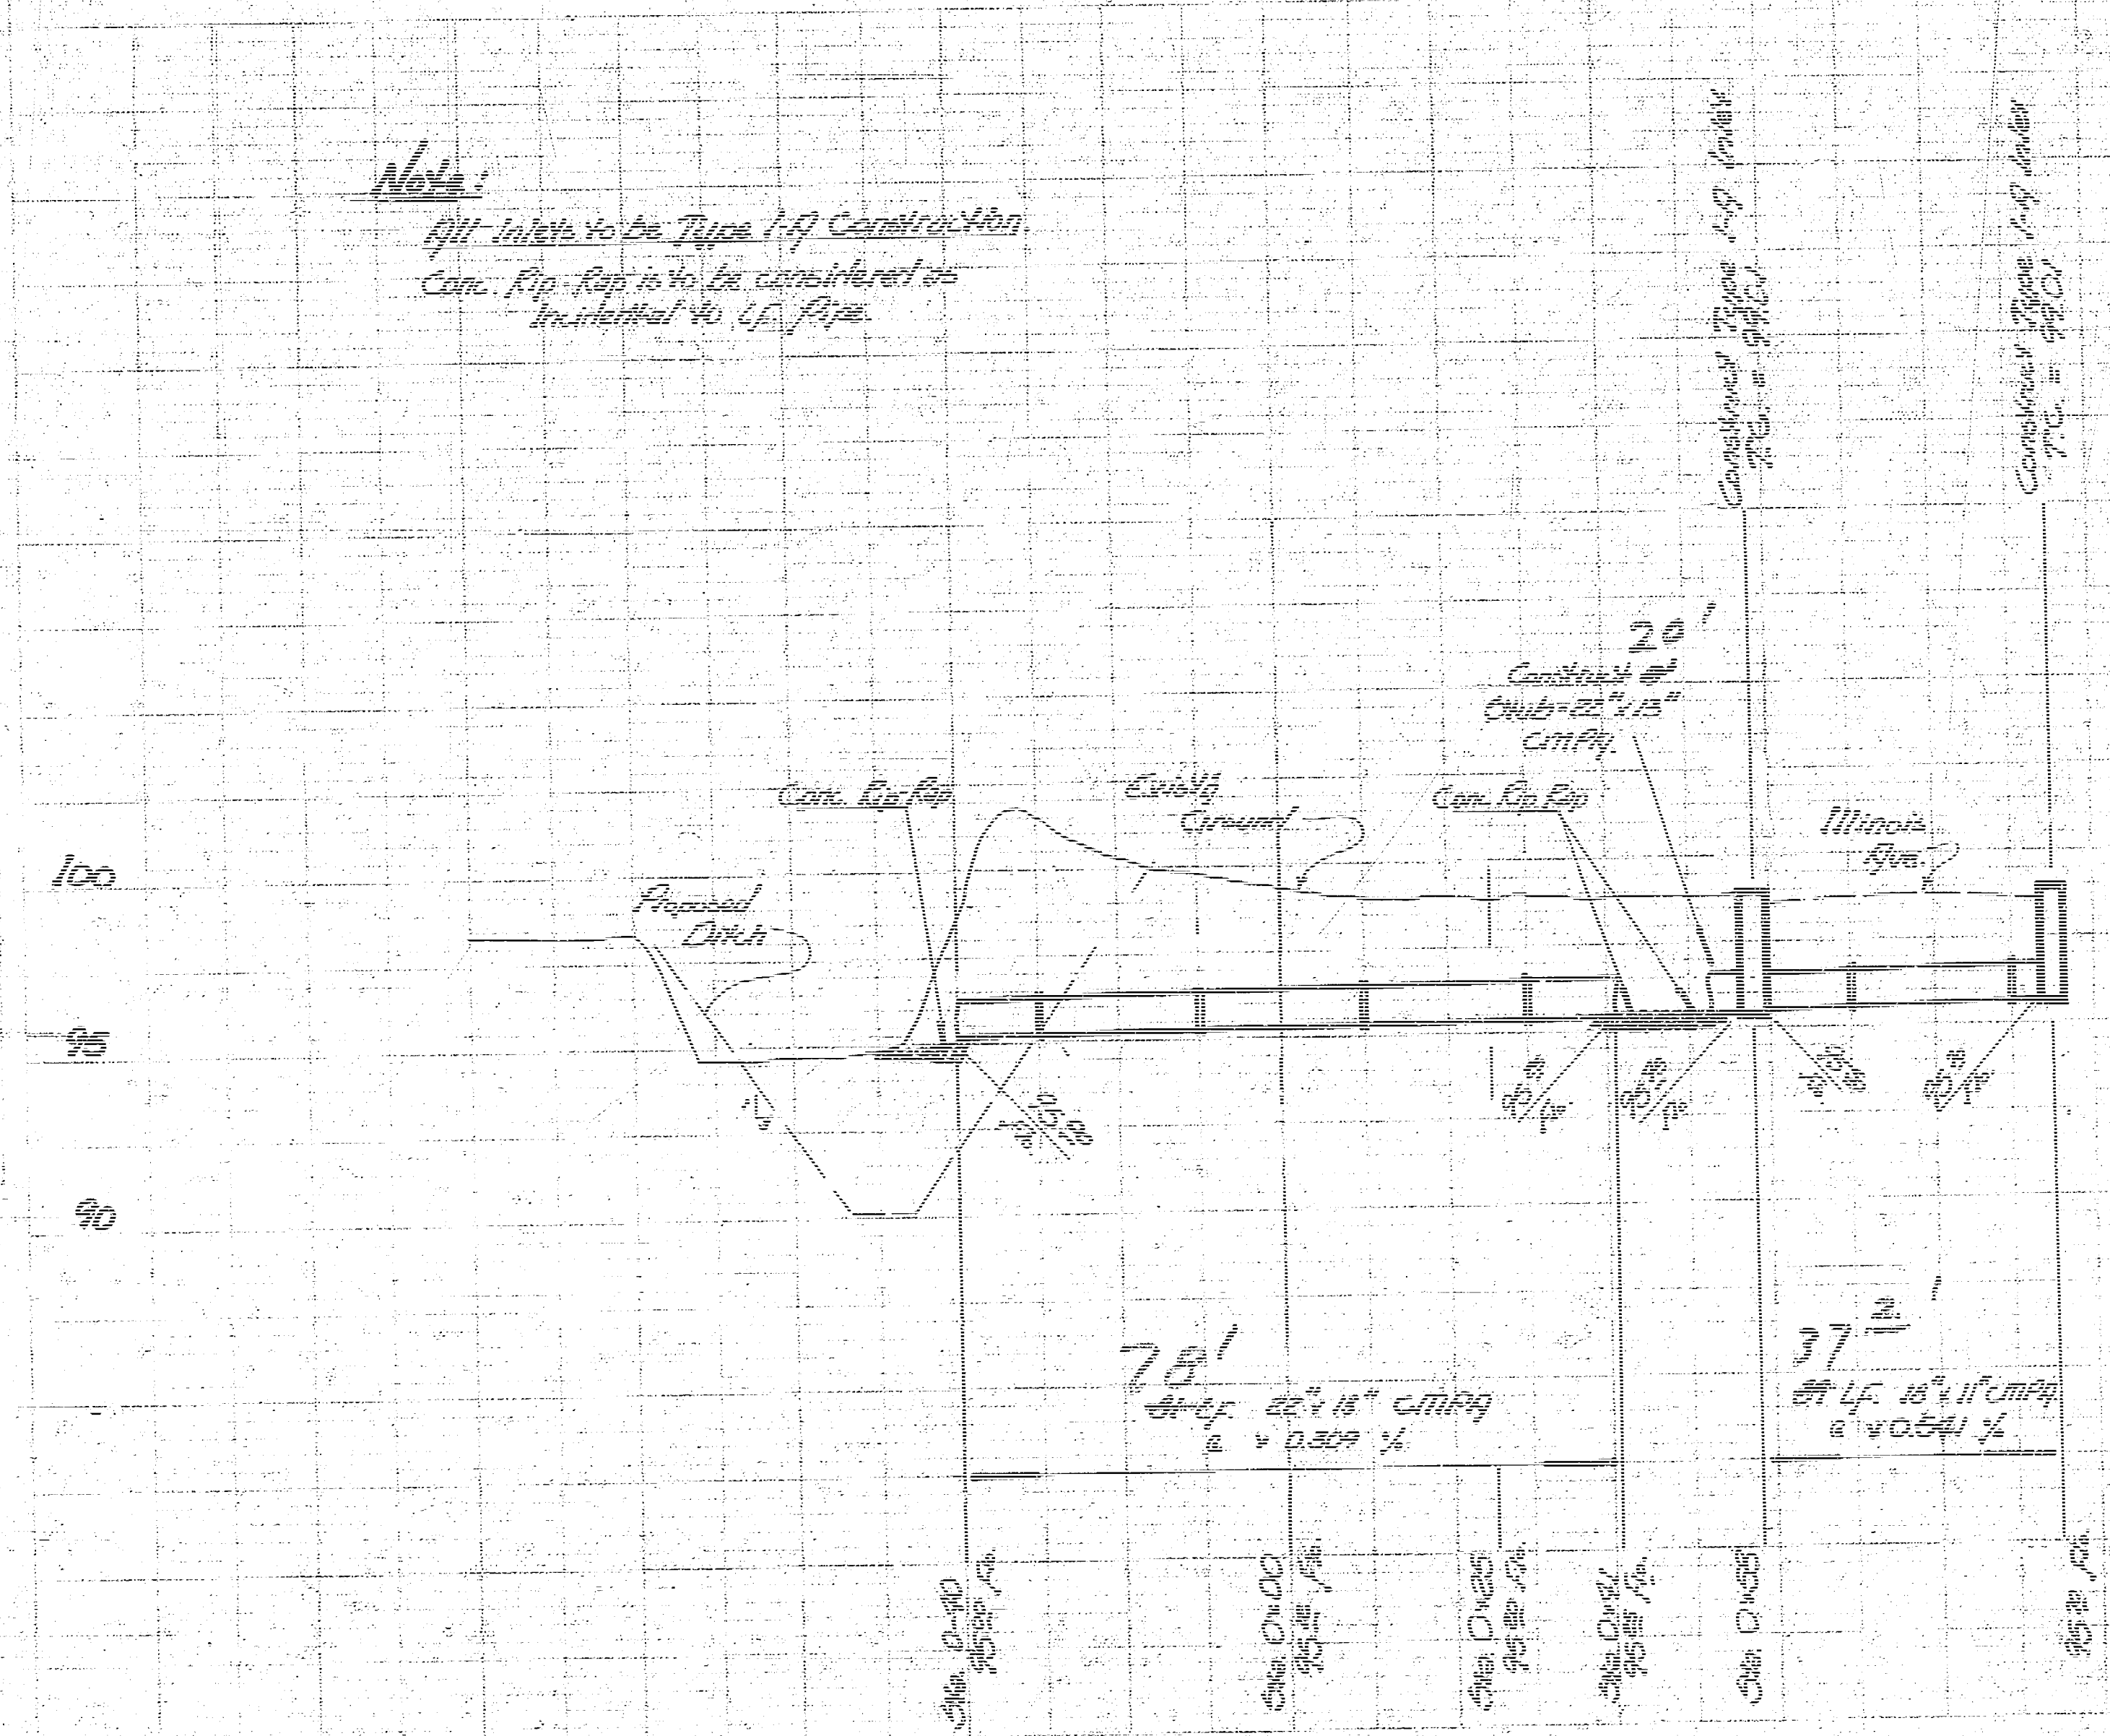

As built 3-31-78

INCIDENTAL DRAINAGE
In Connection w. Paving of
ILLINOIS AVE.

CITY OF WICHITA, KS.

R.W. Linn _____ City Engineer
Project No. _____ DAKS 575103
Date: _____