
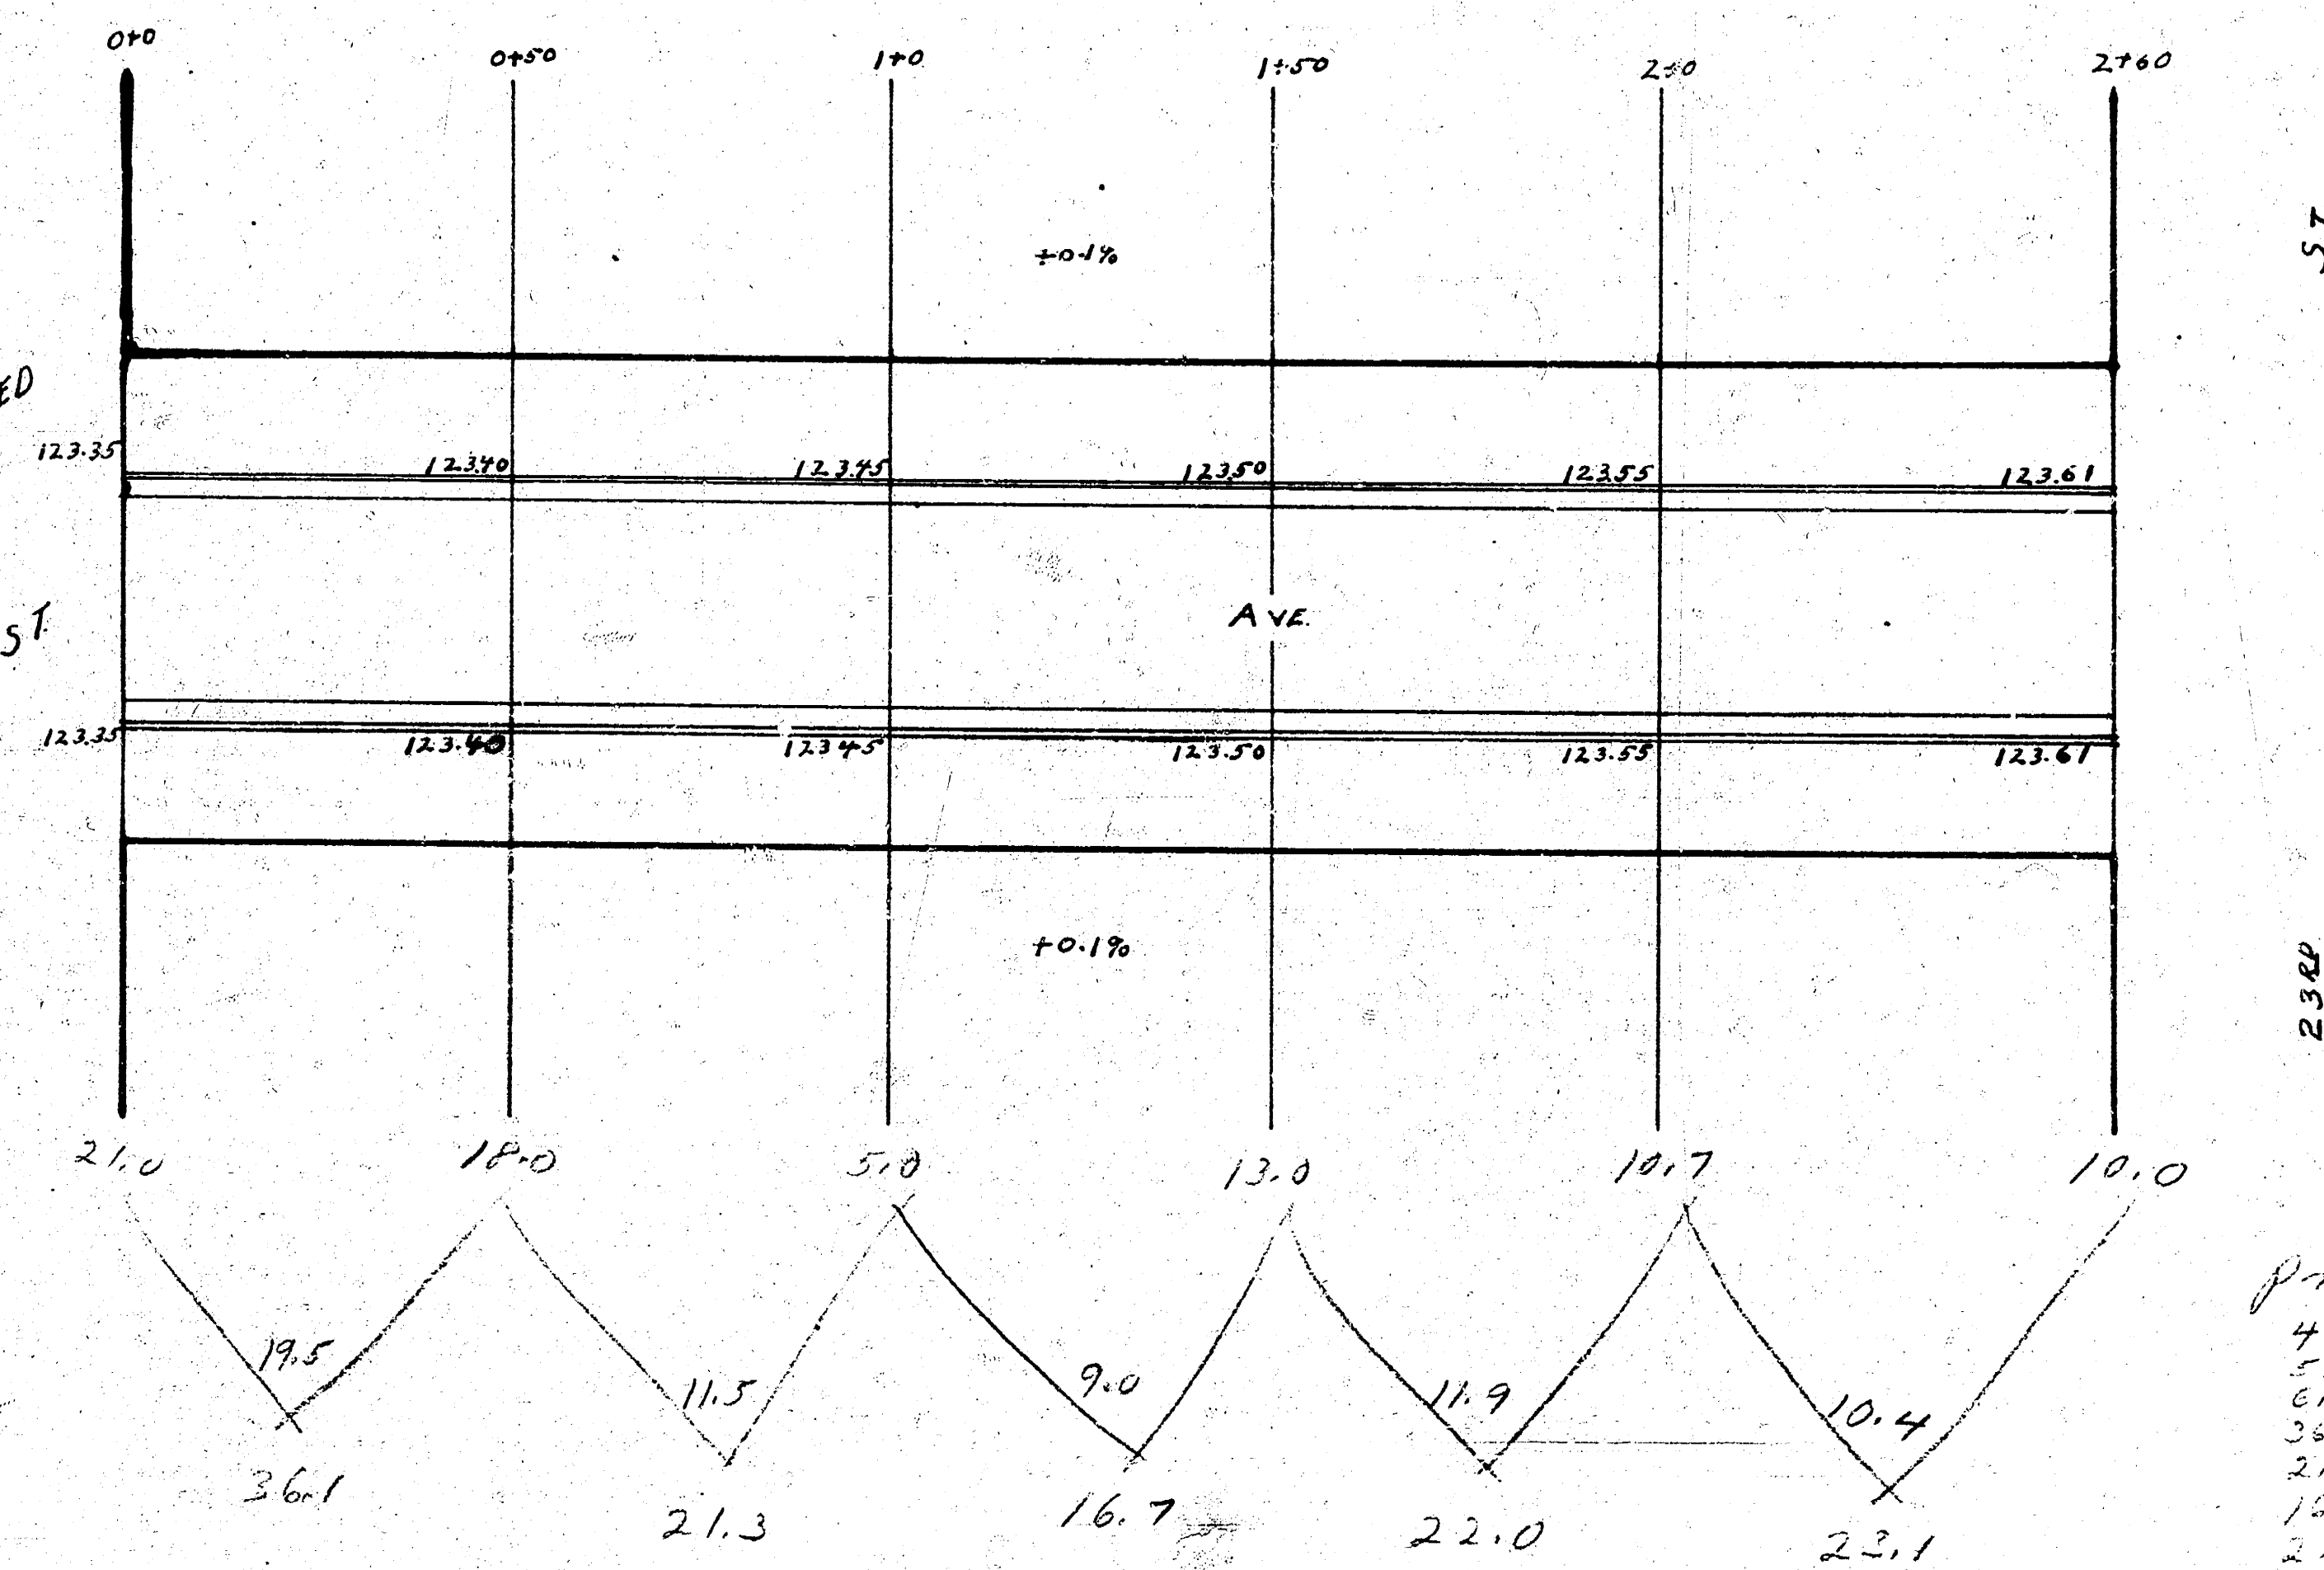


[illegible]

A circular postmark from St. Louis, Mo., dated April 19, 1917. The text "ST. LOUIS, MO." is curved along the top inner edge, and "APR 19 1917" is curved along the bottom inner edge. The number "438" is printed in the center.

$$\begin{array}{r}
 42.2 \\
 56.5 \\
 82.1 \\
 72.3 \\
 61.5 \\
 56.1 \\
 42.1 \\
 40.6 \\
 17.3 \\
 13.2 \\
 37.7 \\
 30.1 \\
 \hline
 564.1 \\
 +10\% \quad 56.4 \\
 \hline
 620.5
 \end{array}$$

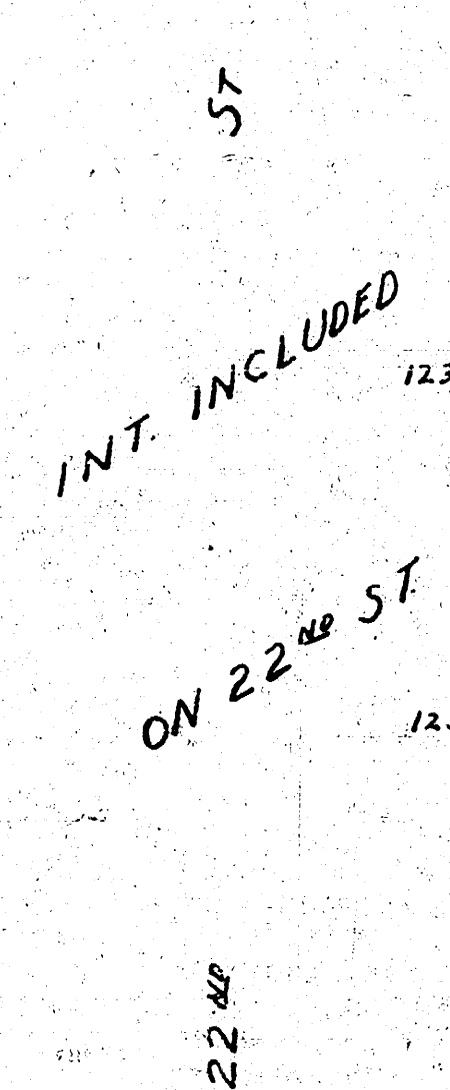

47.2
 51.7
 61.1
 36.1
 21.3
 15.7
 22.0
 22.1

 279.4
 + 1090 28.0

 307.4