



Revised Survey MS-G2-11/12
Plan/Notes

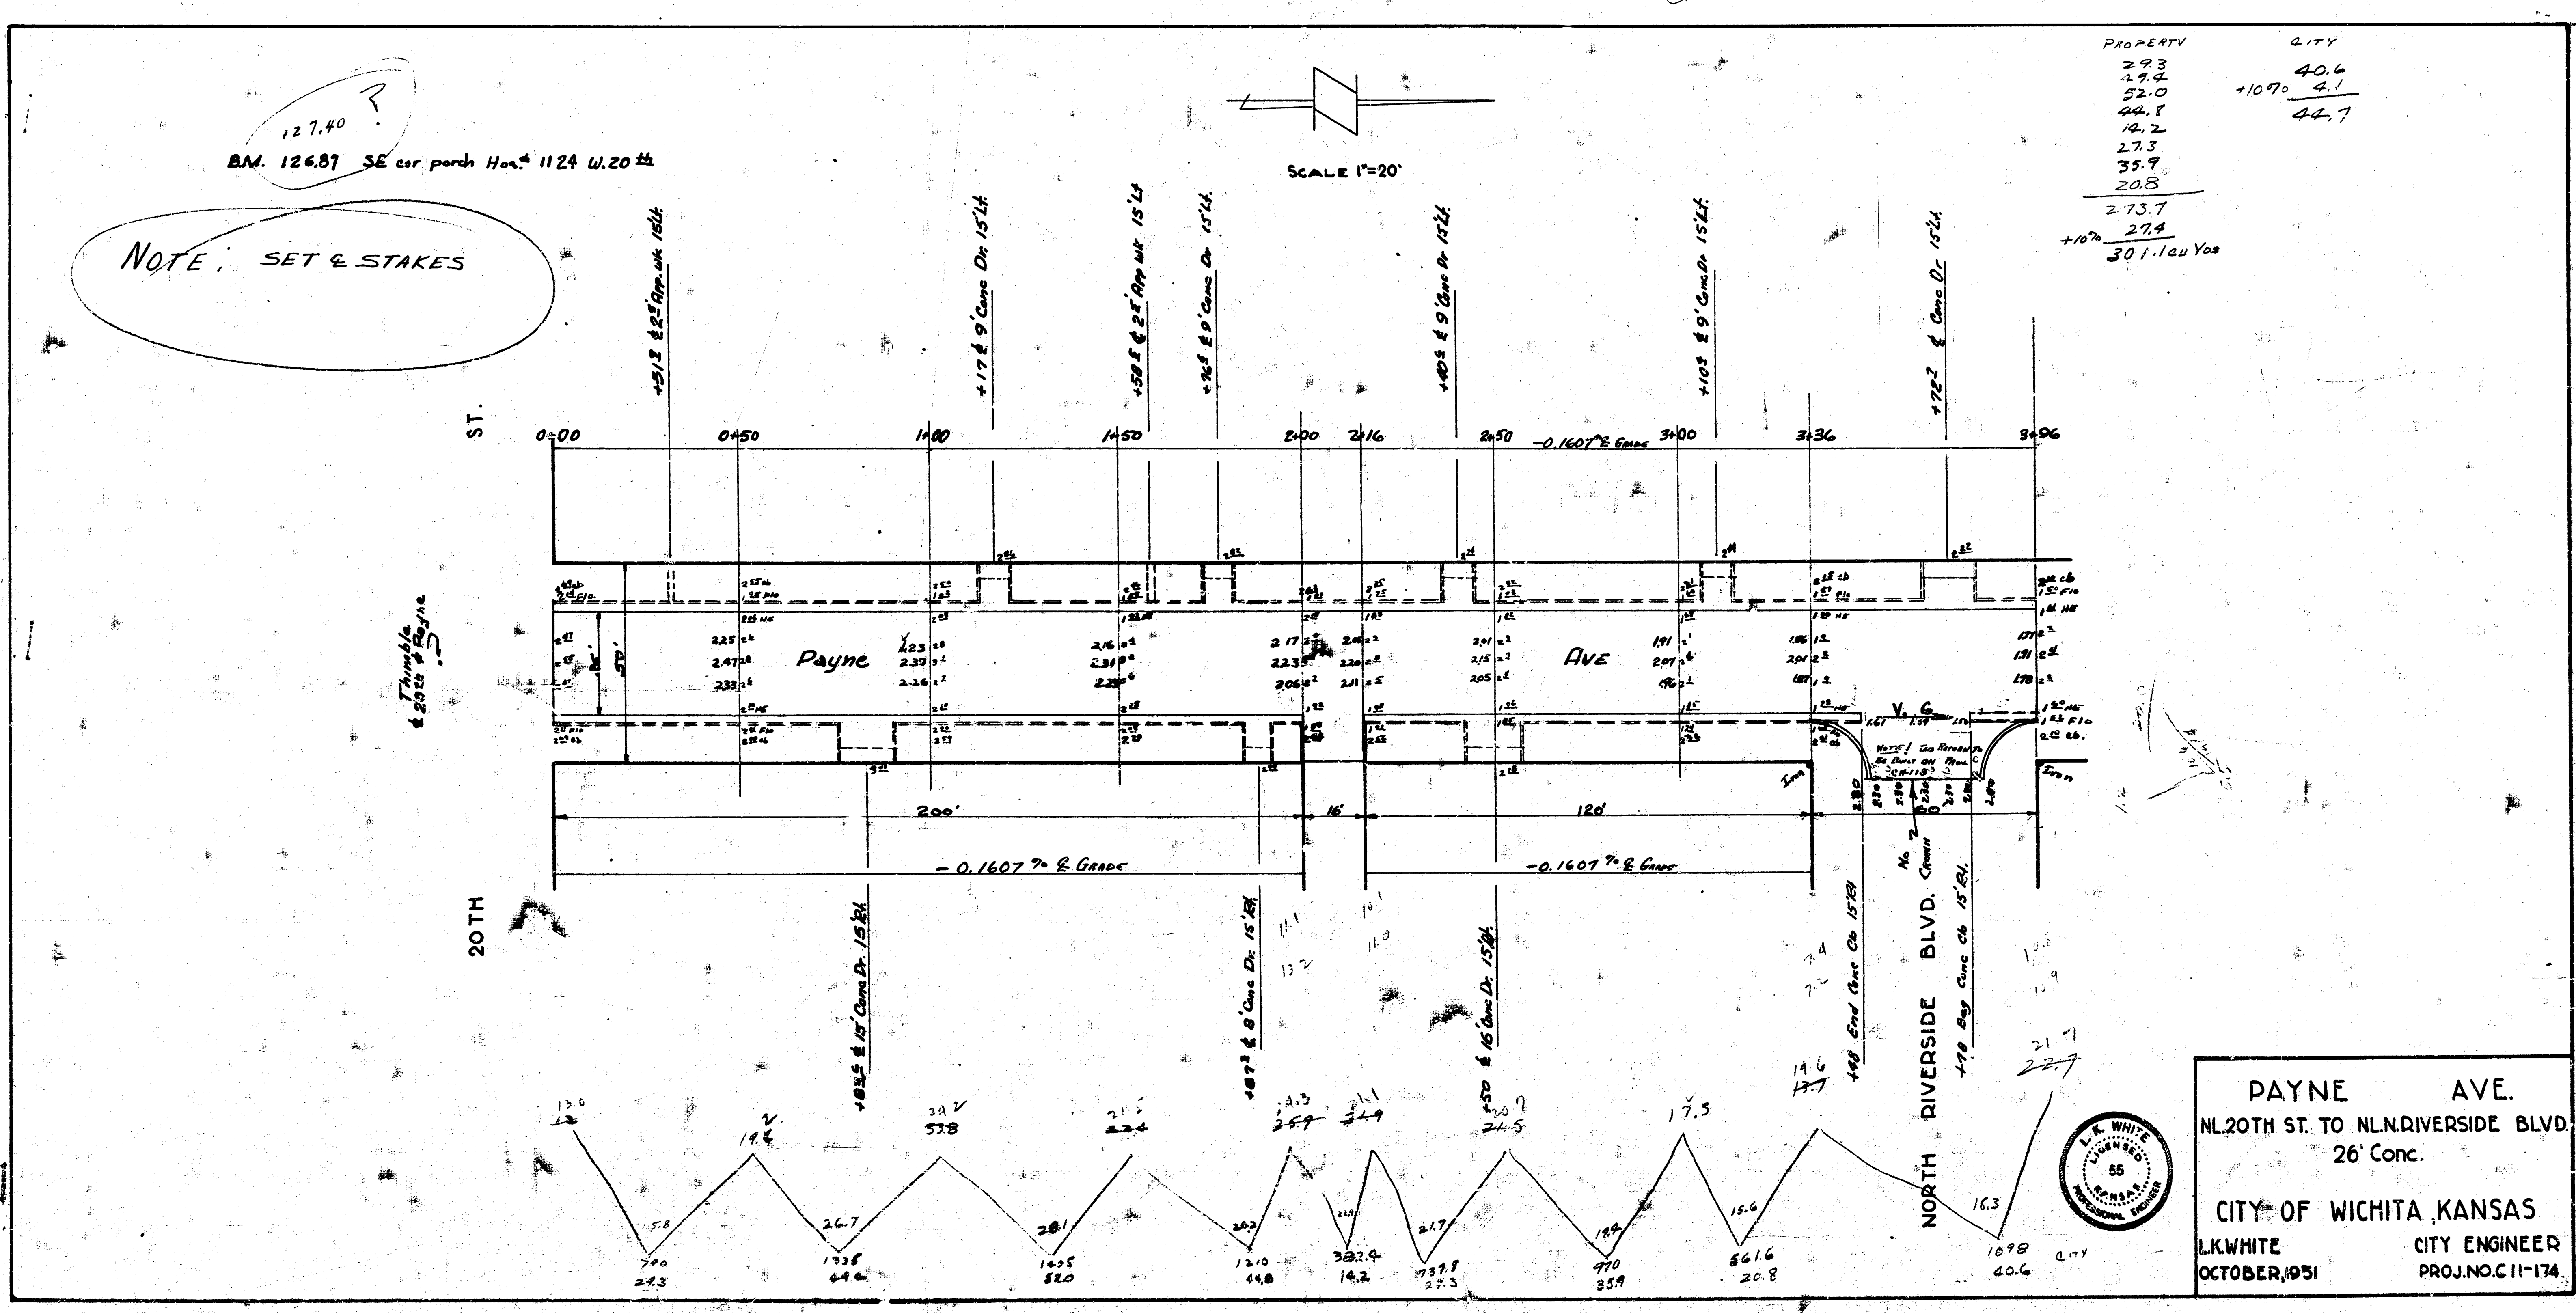

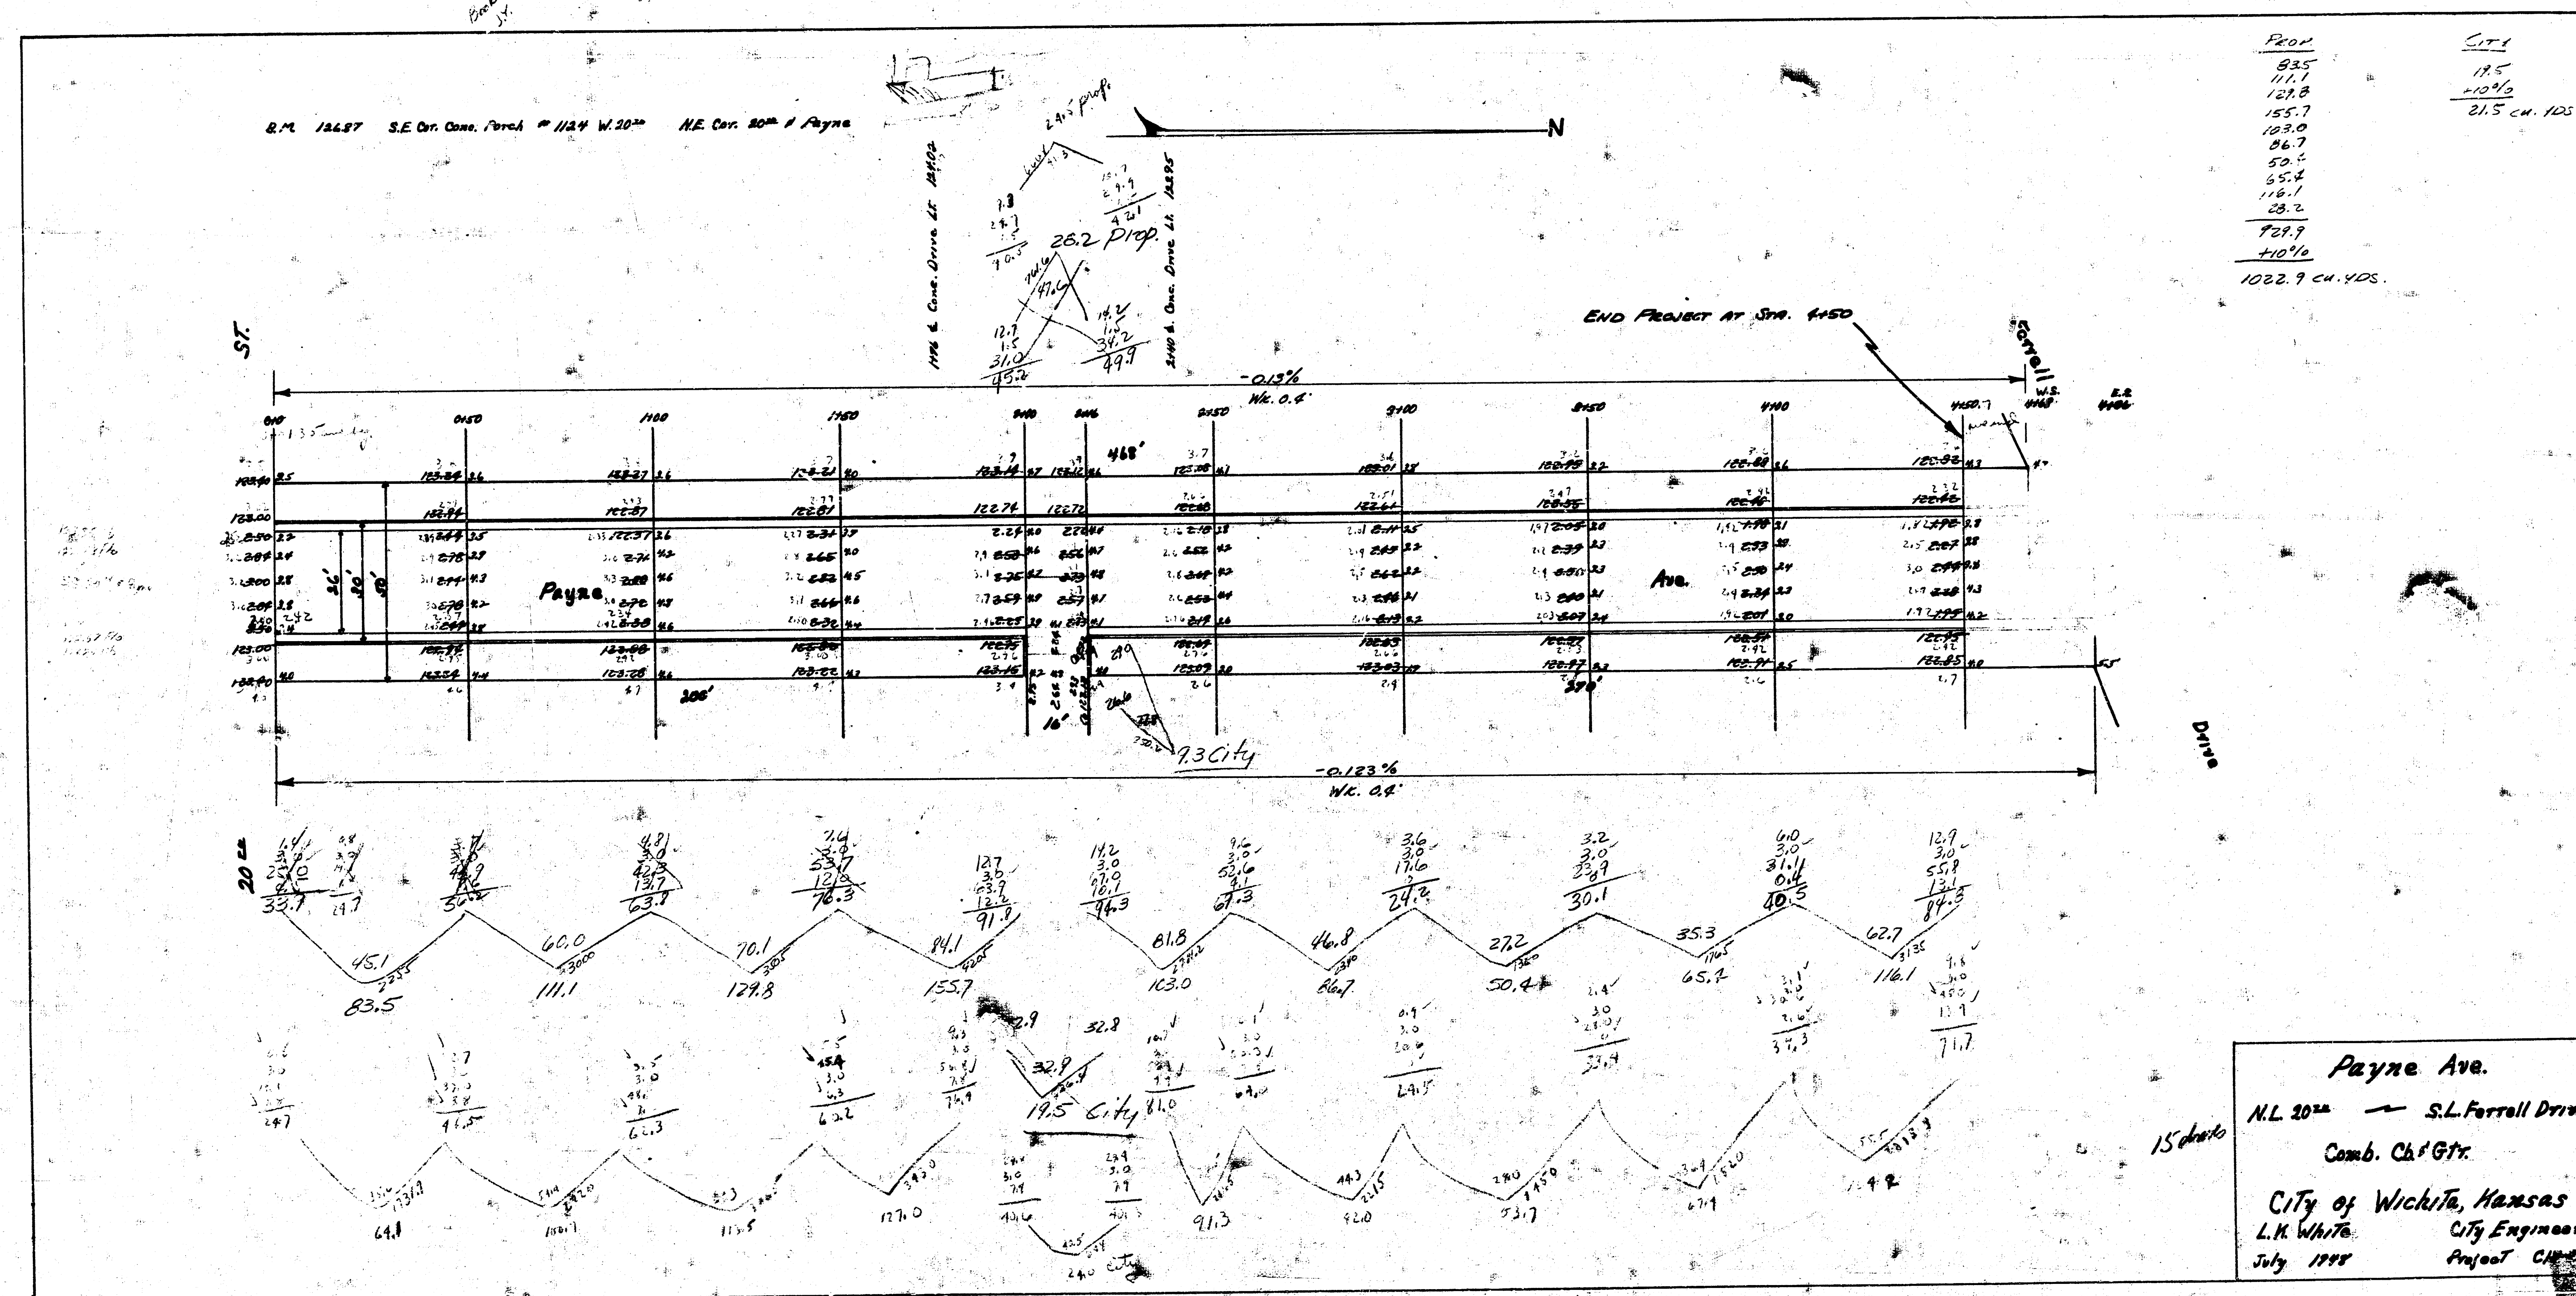



B.M. 112.40 "X" W SELLERS BACK WK. WSW COR. 18° & PAYNE
B.M. 124.45 "Z" IN ZOLLINGER CTR. WK. SO SE. 107° & PAYNE
B.M. 126.87 SE COR. CONC. PORCH NO. = 112.4 W 10° NE 120° PAYNE

N

PAYNE AVE.
N.L. 16" TO G.L. 20"
CURB & GUTTER
CITY OF WICHITA, KANSAS
CKWHITE CITY ENGINEER
MAY 1946

S.M. 122.44 "C" IN SOLLERS BACK W.K. W.S.W. COR. 10" & PAYNE
 S.M. 124.45 "C" IN ZOLLINGER CTR. W.K. S.O. SE. 19" & PAYNE
 S.M. 126.87 SE. COR. CONC. POREN 14" & 1124 W20" NE. 20" PAYNE

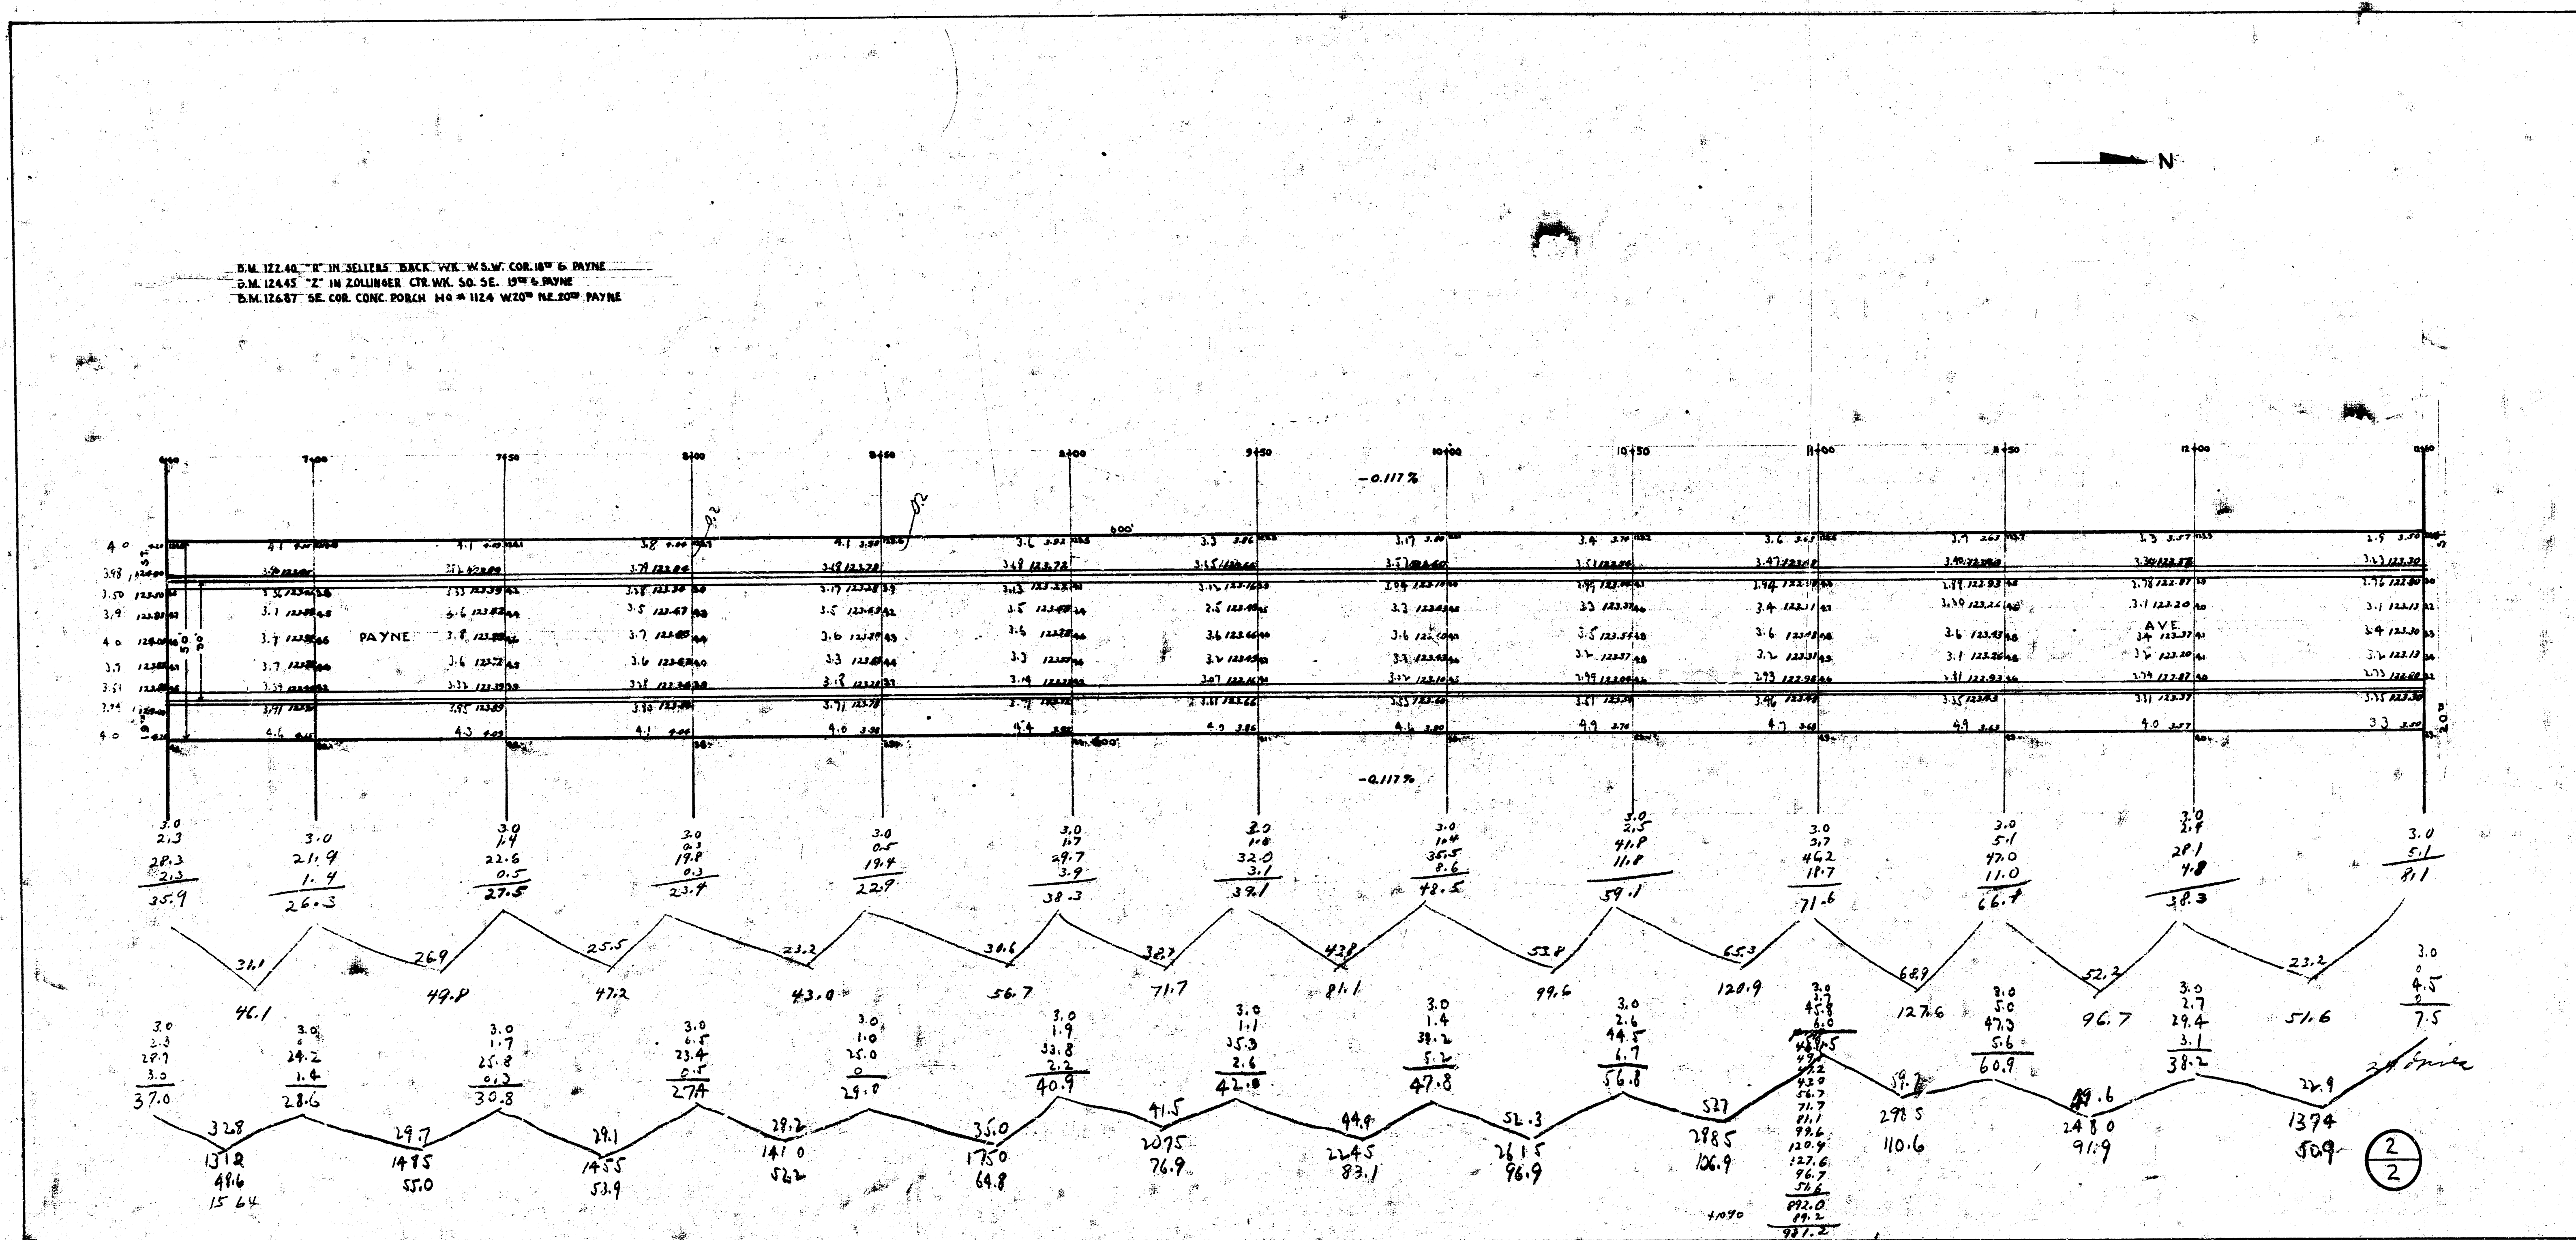

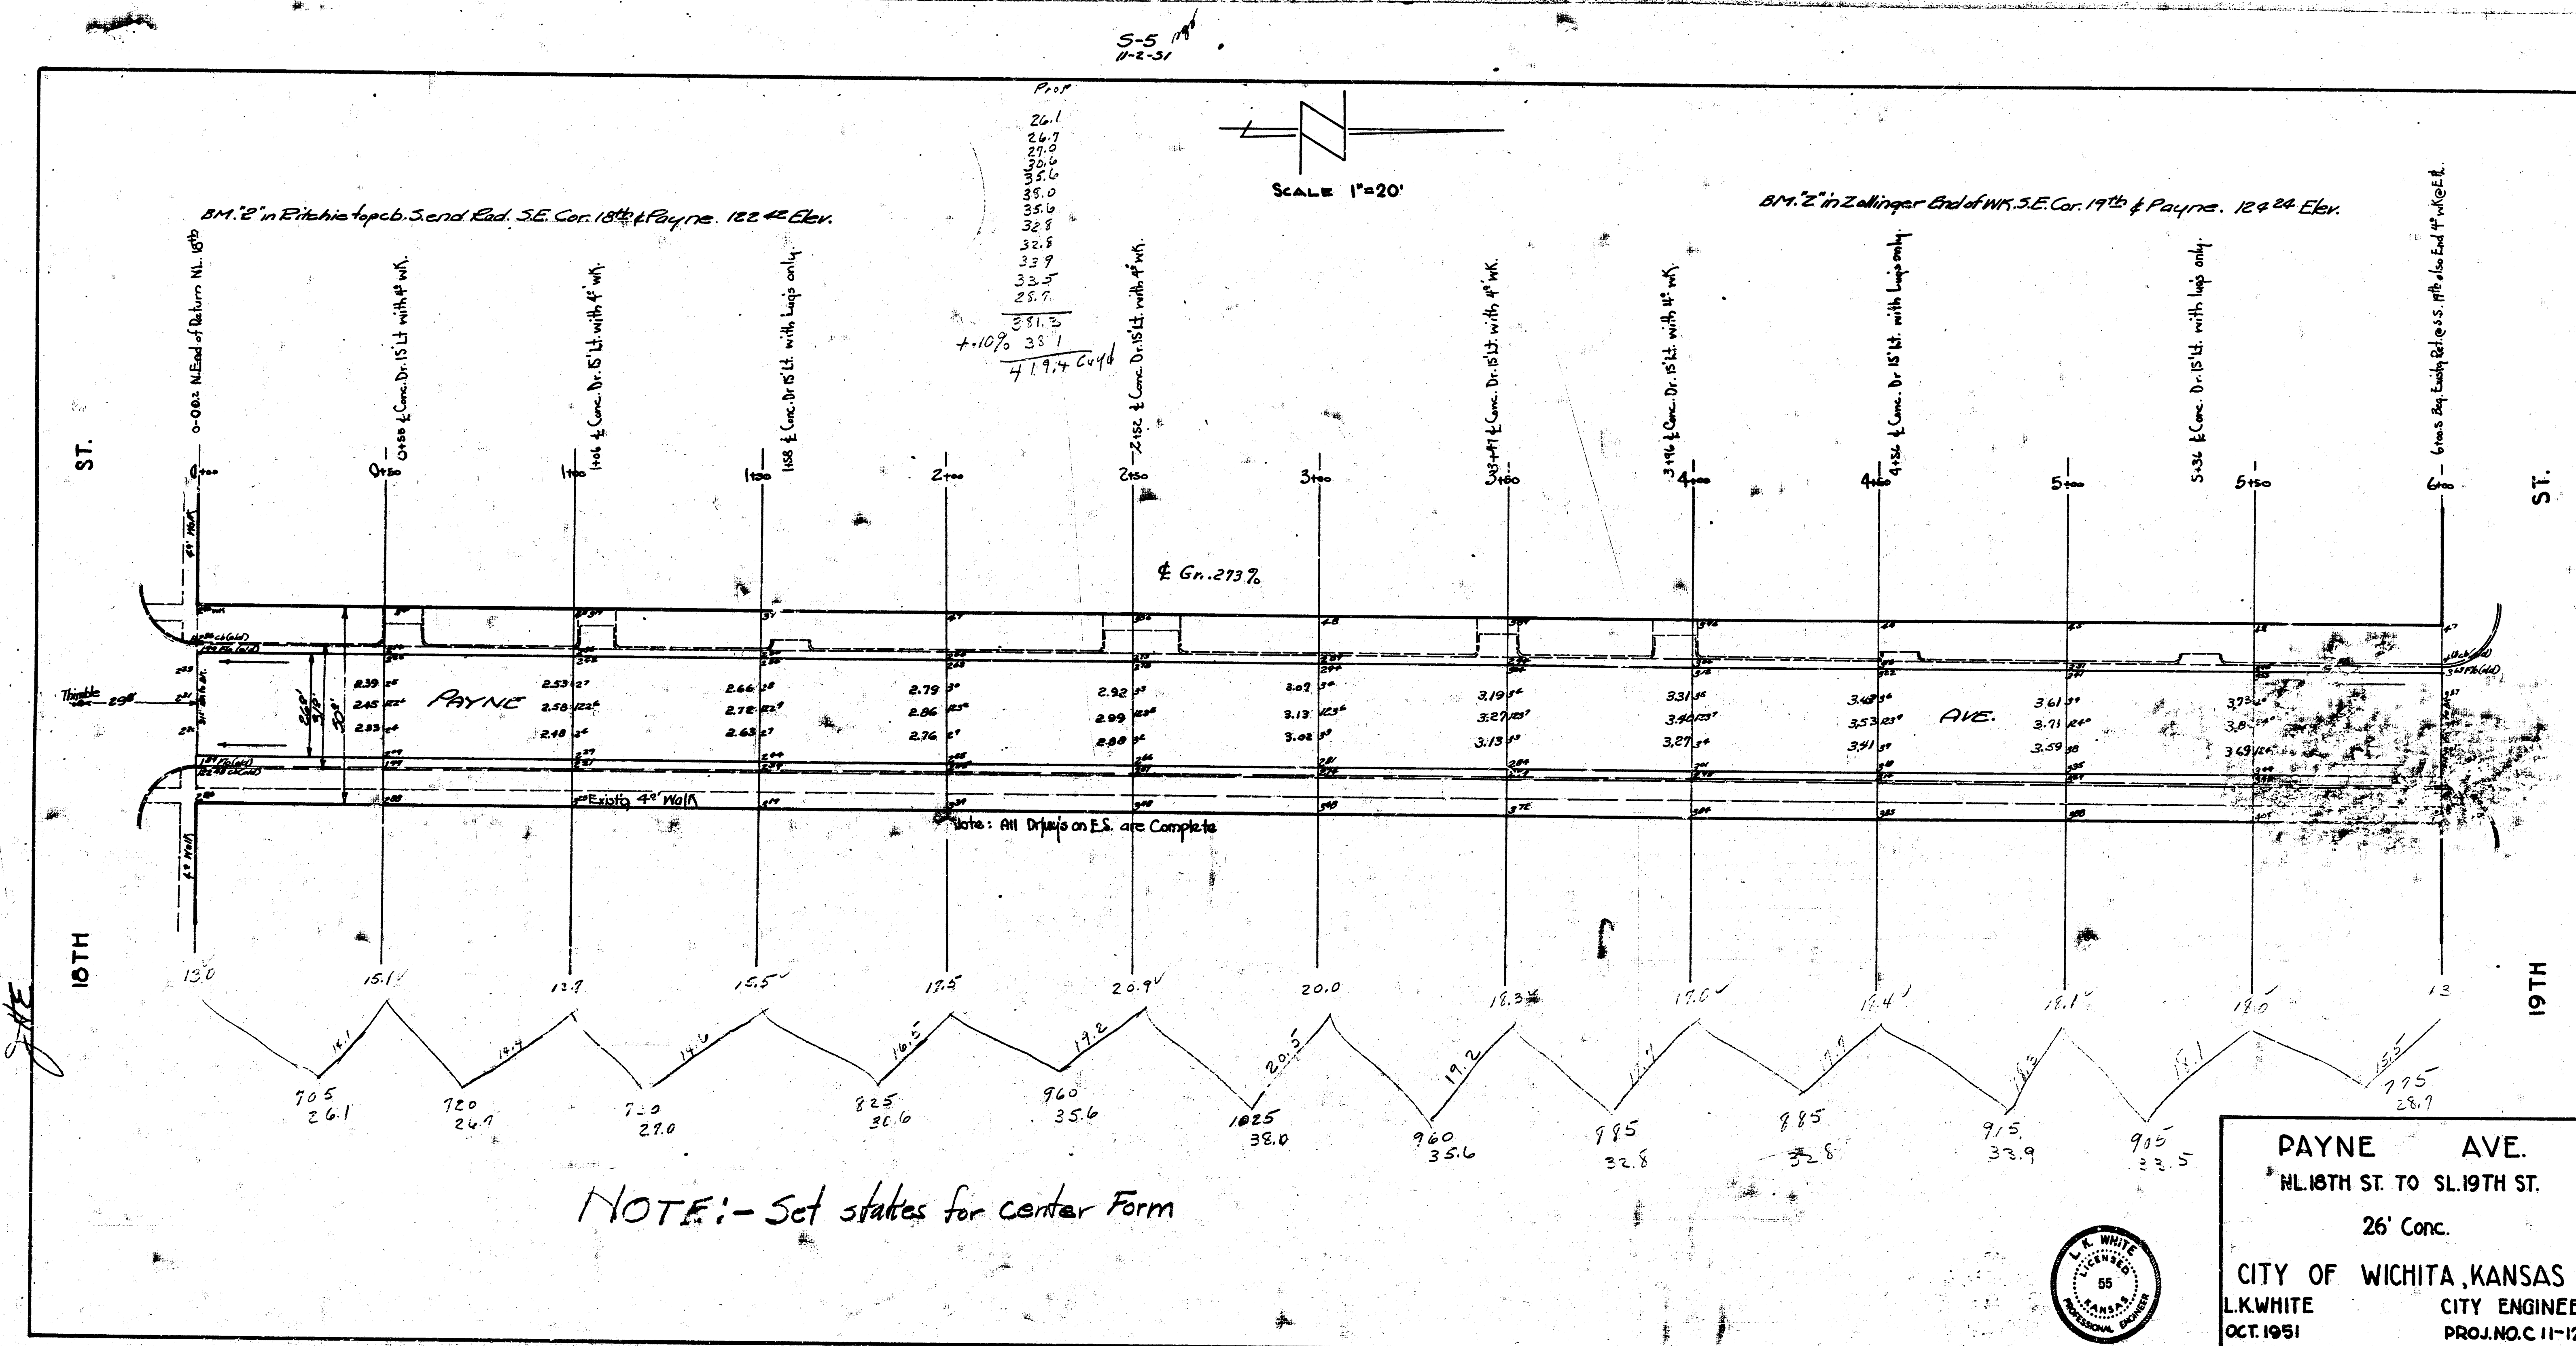

Book # 52
 37-38

