




146.25
 B.M. 127.34 SE. cor. sec. 25th & Grove - This BM reset
 B.M. 127.34 SE. cor. sec. 25th & N. Platt
 (B.M. 127.34 is 0.15 higher than old C. Grove 127.19)
 Put grades reset from new cb. elevations taken in
 the field after put was constructed

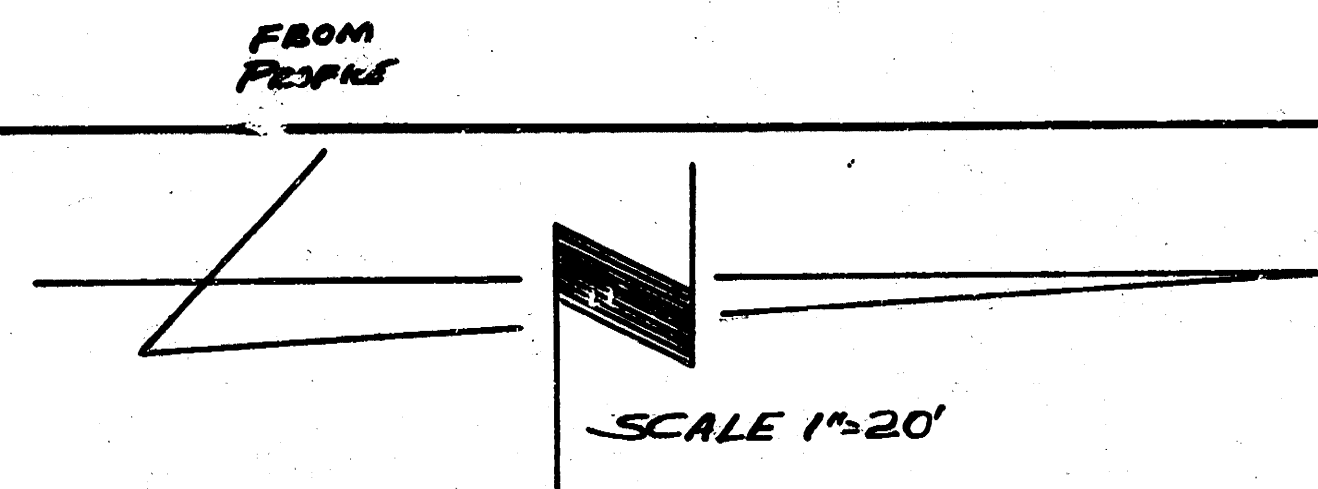



PROPERTY
 113.0
 118.7
 106.5
 100.6
 106.5
 132.0
 159.0
 158.3
 133.0
 141.1
 146.1
 121.0
 1598.6
 159.8
 +10.90
 1758.5 CUYDAS EXC

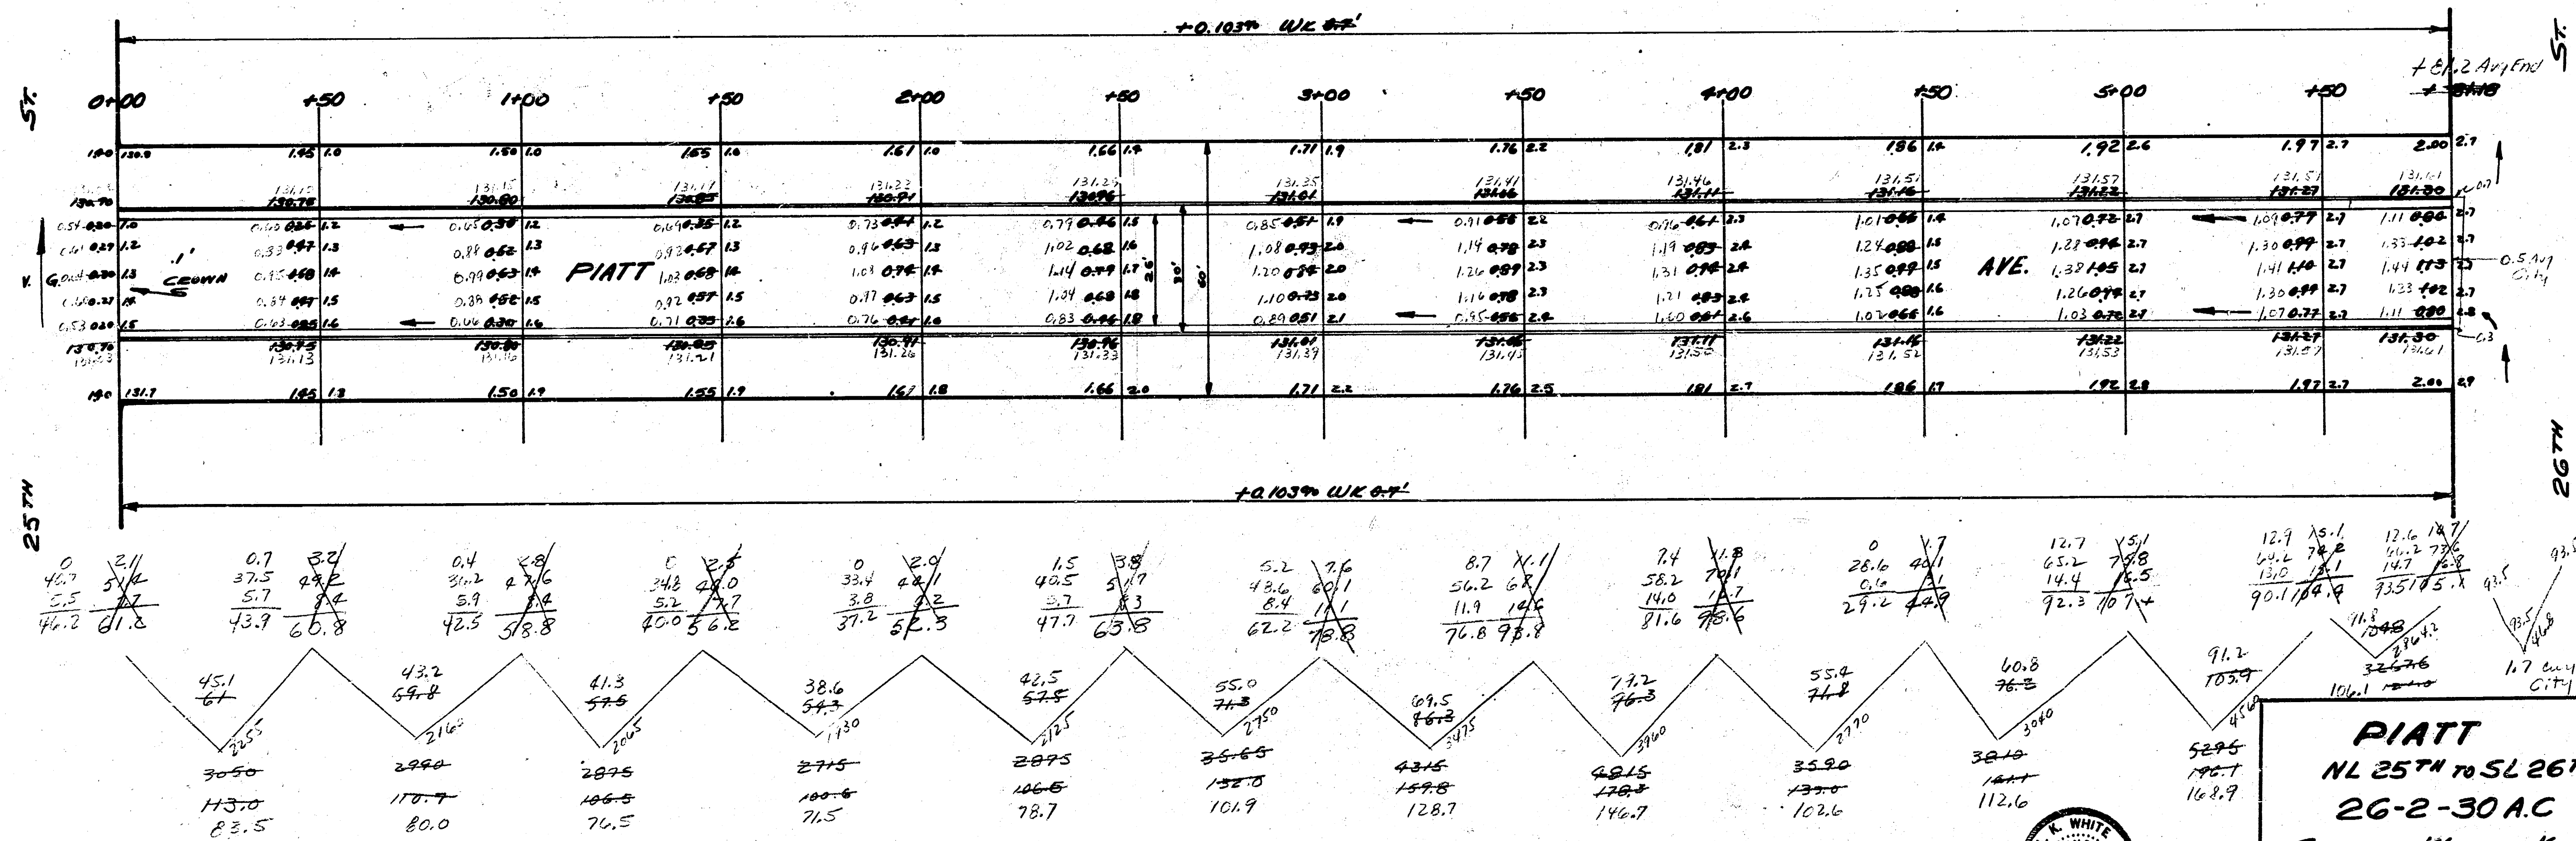

PIATT
 NL 25TH TO SL 26TH
 26-2-30 A.C.
 CITY OF WICHITA KANSAS
 LK WHITE CITY ENGINEER
 JUNE 12 1952 Prev. No. CH-345

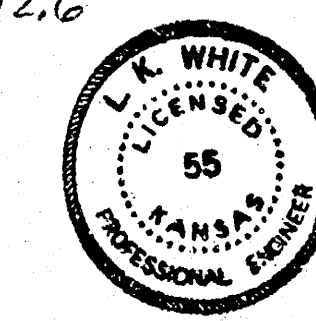

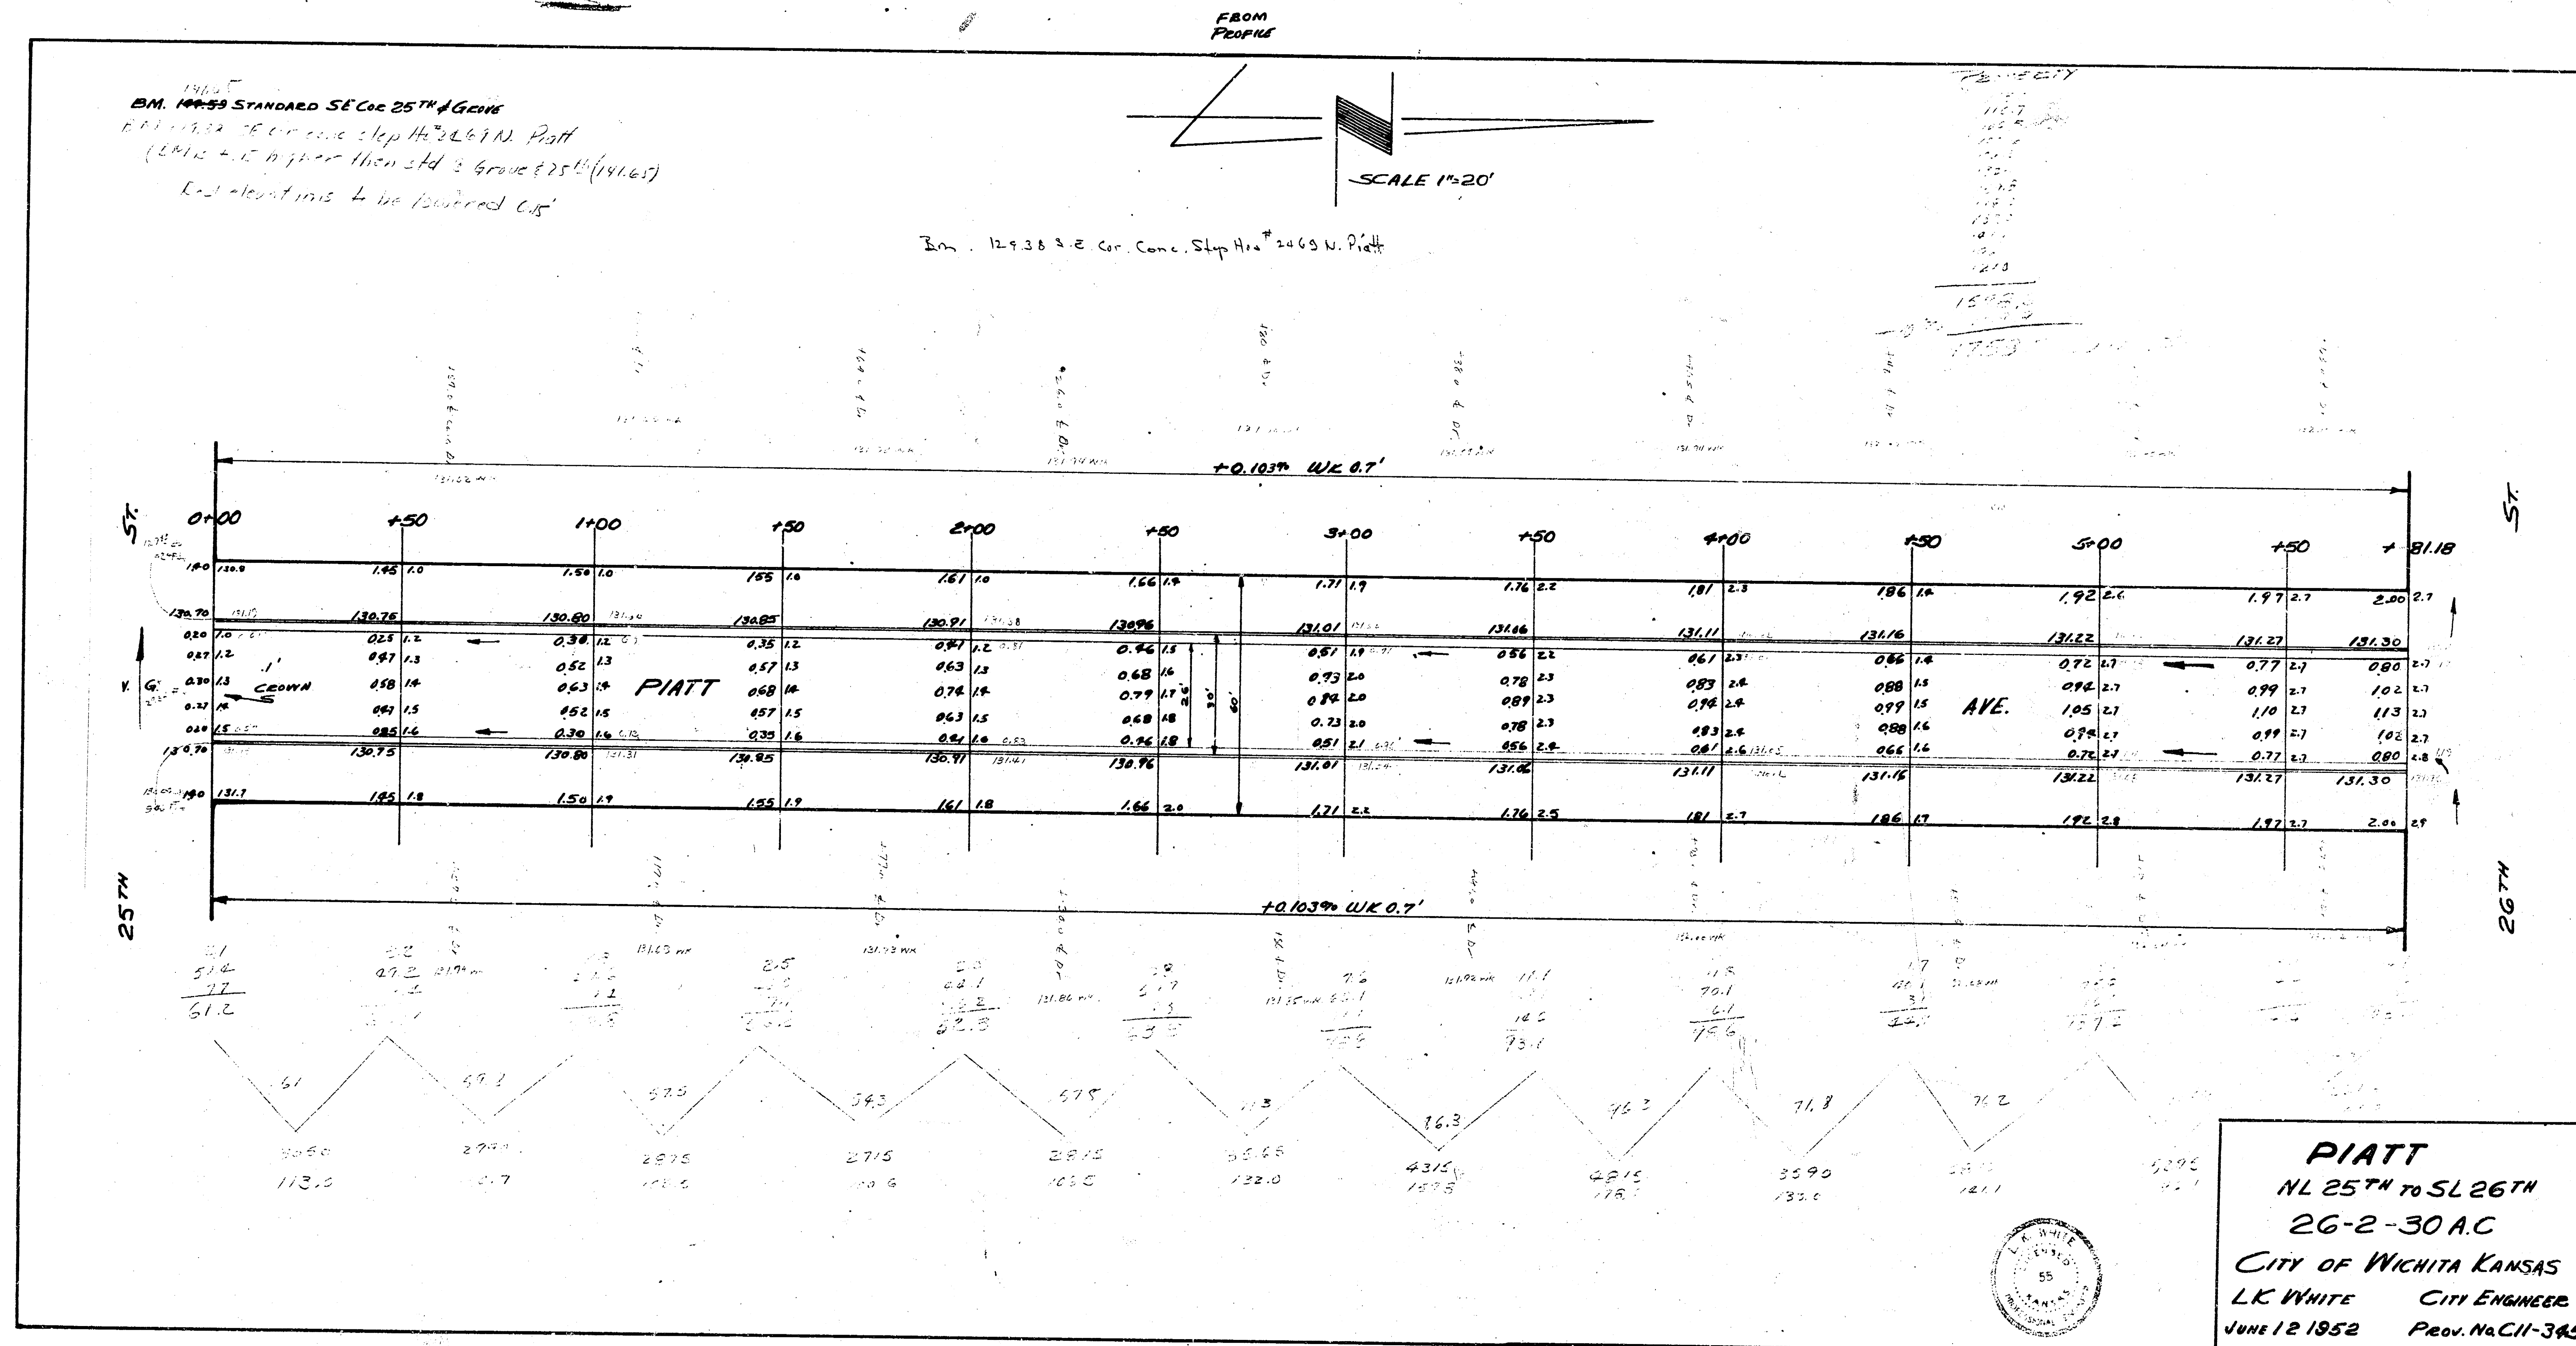

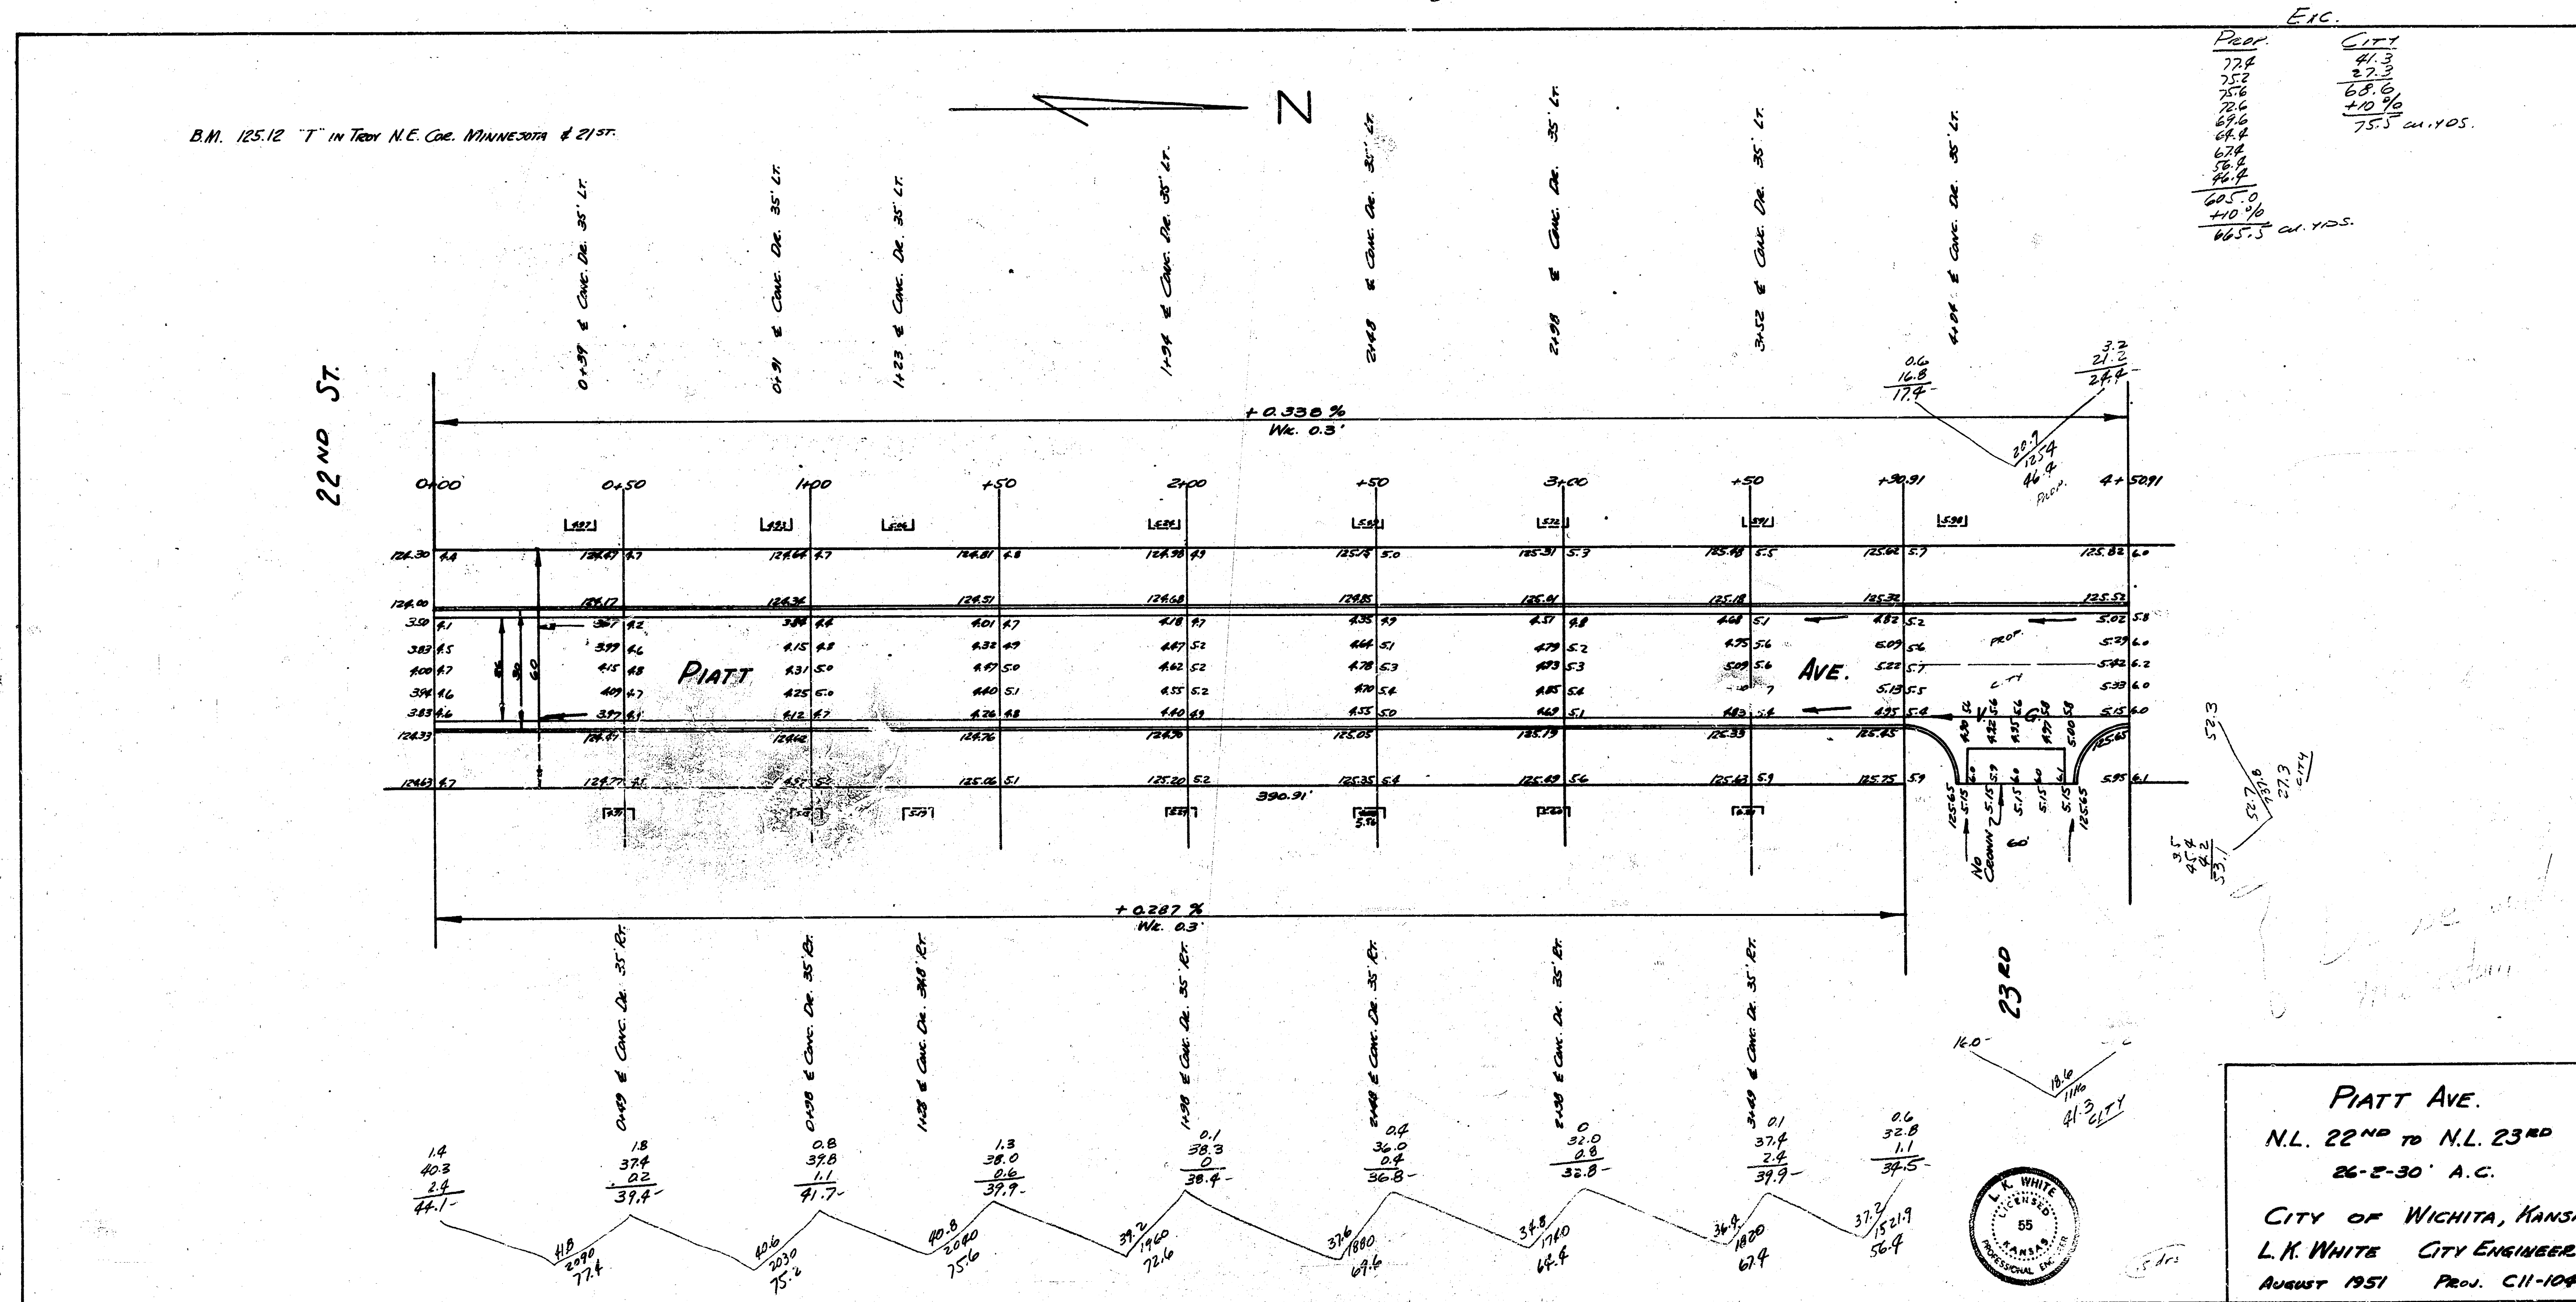

E-3

