


SILVER SPRINGS

LOT 2, BLOCK 1, SILVER SPRINGS
AN ADDITION TO THE CITY OF WICHITA, KANSAS
INTERIM DECELERATION LANE & MAJOR ENTRANCE ON RIDGE ROAD

PROJECT # 472-76-245-80000-000-000-008

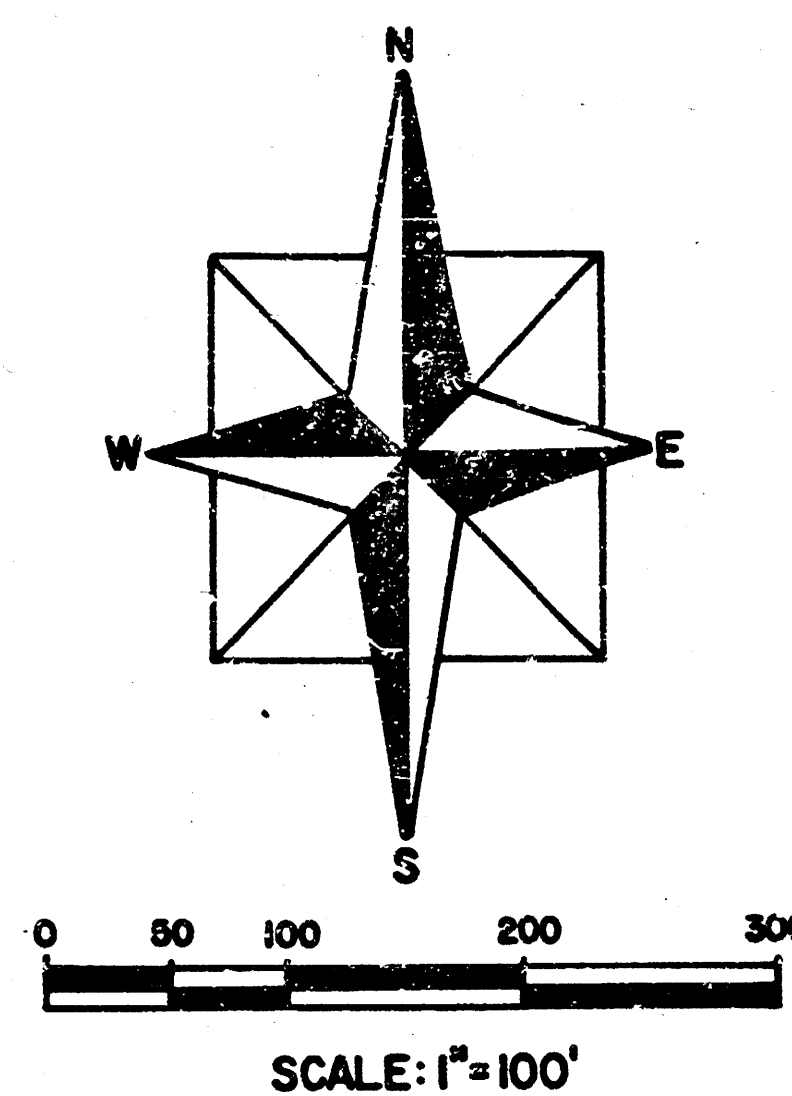

OWNER :
FLOYD R. HARDESTY
4606 SOUTH GARNETT
TULSA, OKLAHOMA
74145
PHONE: 622-3600


GENERAL NOTES

ALL CONSTRUCTION TO BE IN STRICT ACCORDANCE
WITH CITY OF WICHITA SPECIFICATION
EXISTING UNDERGROUND LINES HAVE BEEN SHOWN TO THE EXTENT
KNOWN AND LOCATIONS ARE APPROXIMATE. THE EXACT LOCATIONS
AND NOTIFICATION OF THE PROPER AGENCY IS THE RESPONSIBILITY
OF THE CONTRACTOR PRIOR TO ANY EXCAVATION.

LEGEND

- PROPOSED STORM SEWER
- PROPOSED MANHOLE
- PROPOSED INLET
- DRAINAGE AREA LIMITS
- SANITARY SEWER EASEMENT
- STORM SEWER EASEMENT
- UTILITY EASEMENT
- DRAINAGE EASEMENT
- EXISTING GROUND CONTOUR
- PROPOSED FINISHED CONTOUR


SOUTHWEST CORNER
OF SW/4 OF SECTION
15, T-27-S, R-1-W

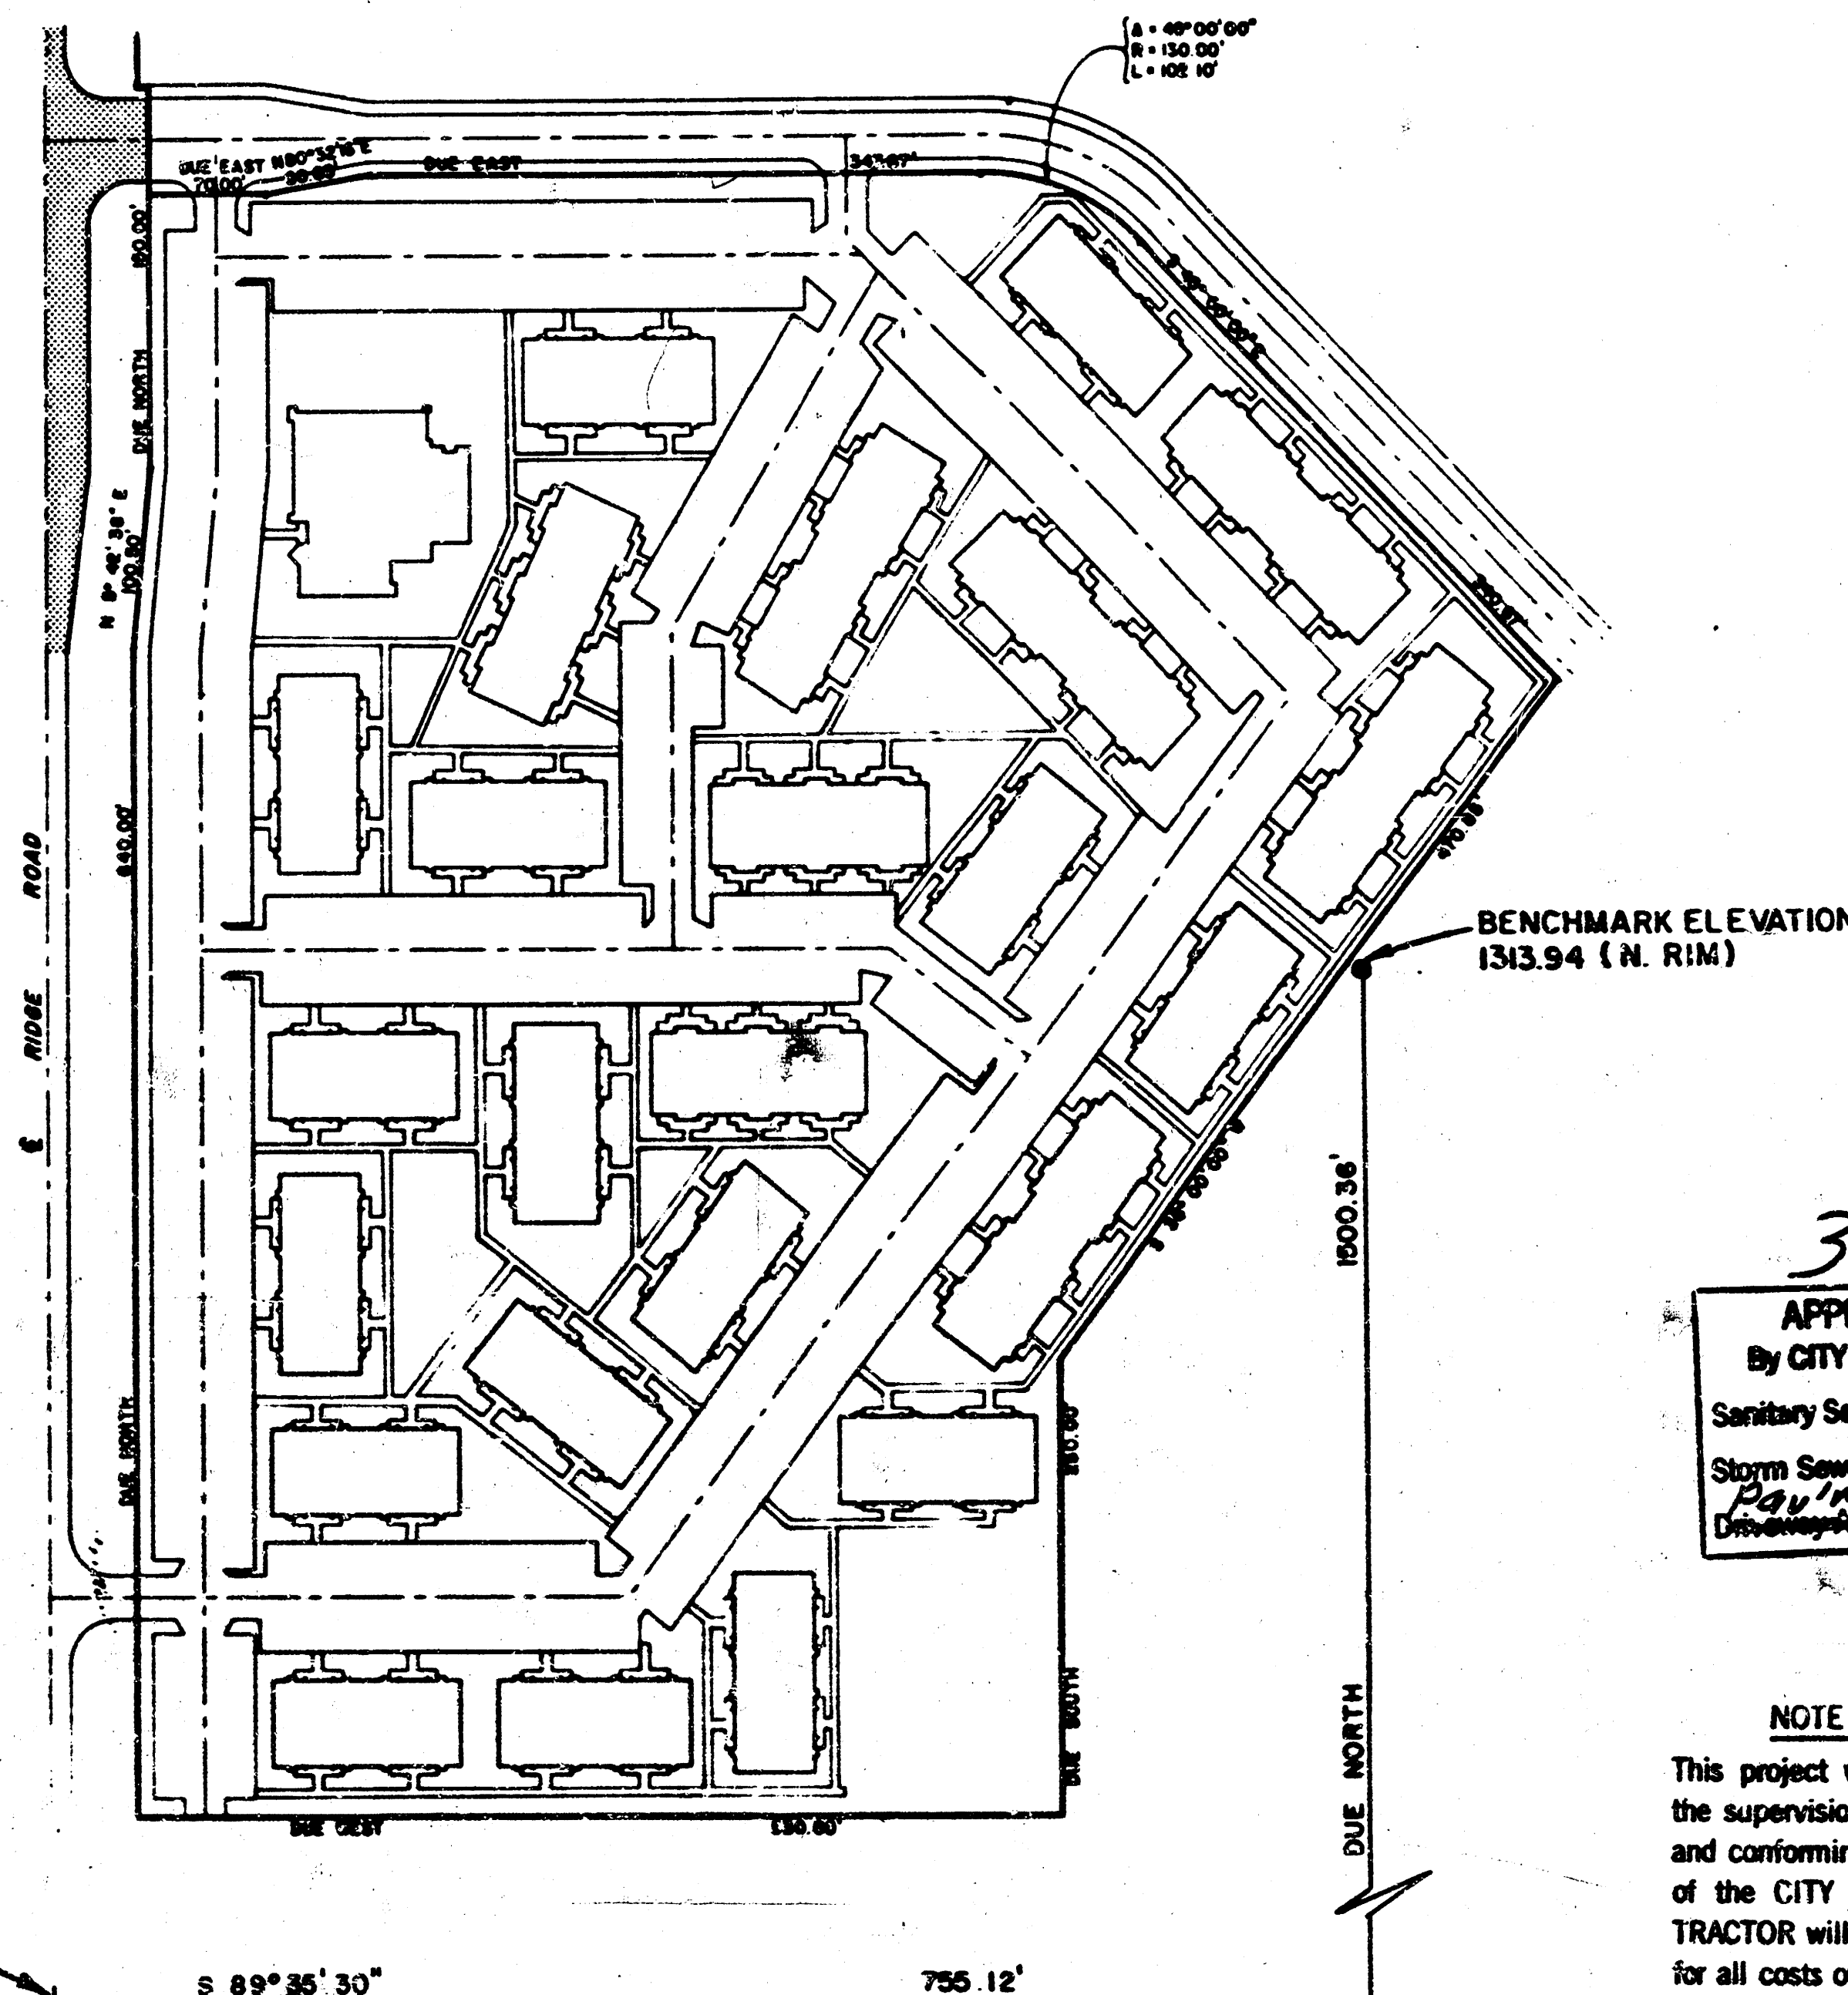

BENCHMARK: APPROXIMATELY 755.12 FEET EAST
AND 1500.36 FEET NORTH OF THE SOUTHWEST
CORNER OF THE SW/4 OF SECTION 15, T-27-S
R-1-W.

AL C. YOUNG & ASSOCIATES
OF TULSA, INC.

CONSULTING ENGINEERING • PLANNING • ENVIRONMENTAL ANALYSIS

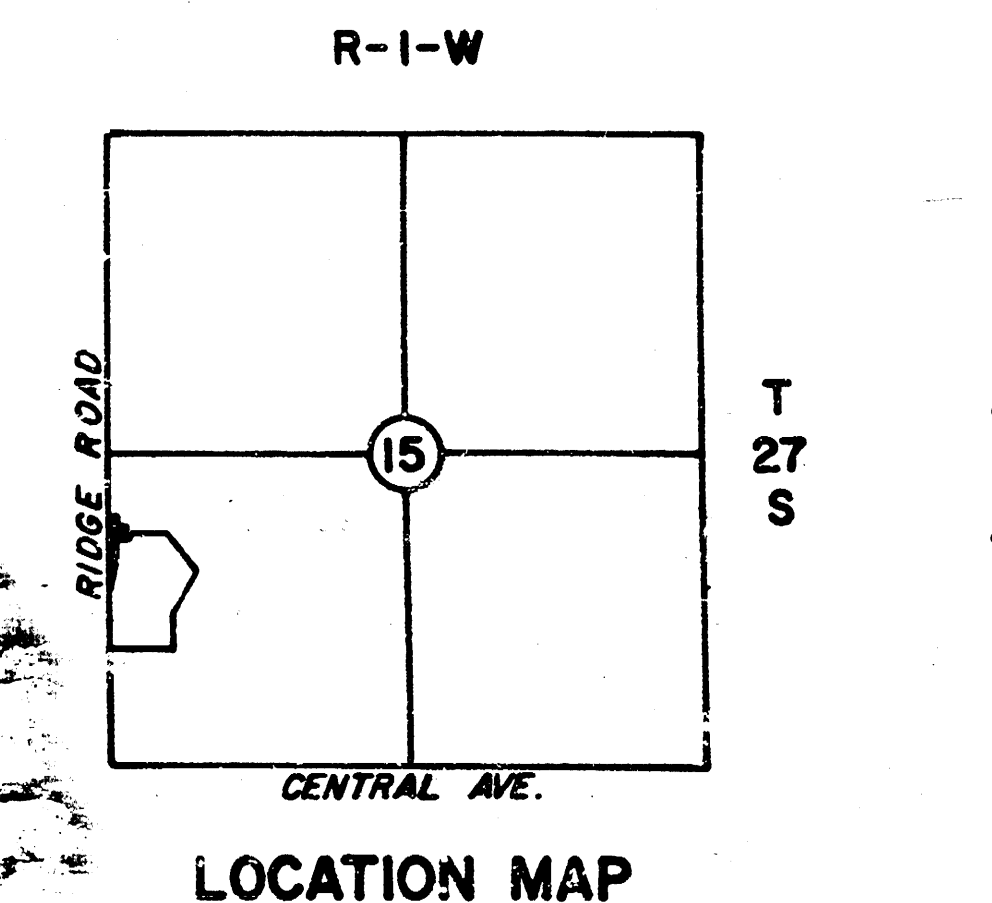

INDEX


SHEET NO.	DESCRIPTION
1	TITLE SHEET
2	DECEL LANE PLAN
3	ENTRY & DECEL LANE PLAN

3-23-84
APPROVED AS NOTED
By CITY ENGINEER OF WICHITA
Sanitary Sewers
Storm Sewers
Drainage/Easements

NOTE TO CONTRACTOR

This project will be constructed under
the supervision of the CITY ENGINEER
and conforming to the SPECIFICATIONS
of the CITY OF WICHITA. The CON-
TRACTOR will prepay the City of Wichita
for all costs of inspection.


CITY OF WICHITA, KANSAS	
AL C. YOUNG & ASSOCIATES	
DOUGLAS, PEORIA • TULSA, OKLA. 74120 • 913/383-4181	
PLAN SCALE 1"=100'	DRAWN DESIGNED SILVER SPRINGS TITLE SHEET
PROFILE SCALE 1"=10'	RECOMMENDED ENGINEERING DIRECTOR
FILE: 4337	DATE: 3
ATLAS PAGE NO:	SHEET 1 OF 3 SHEETS

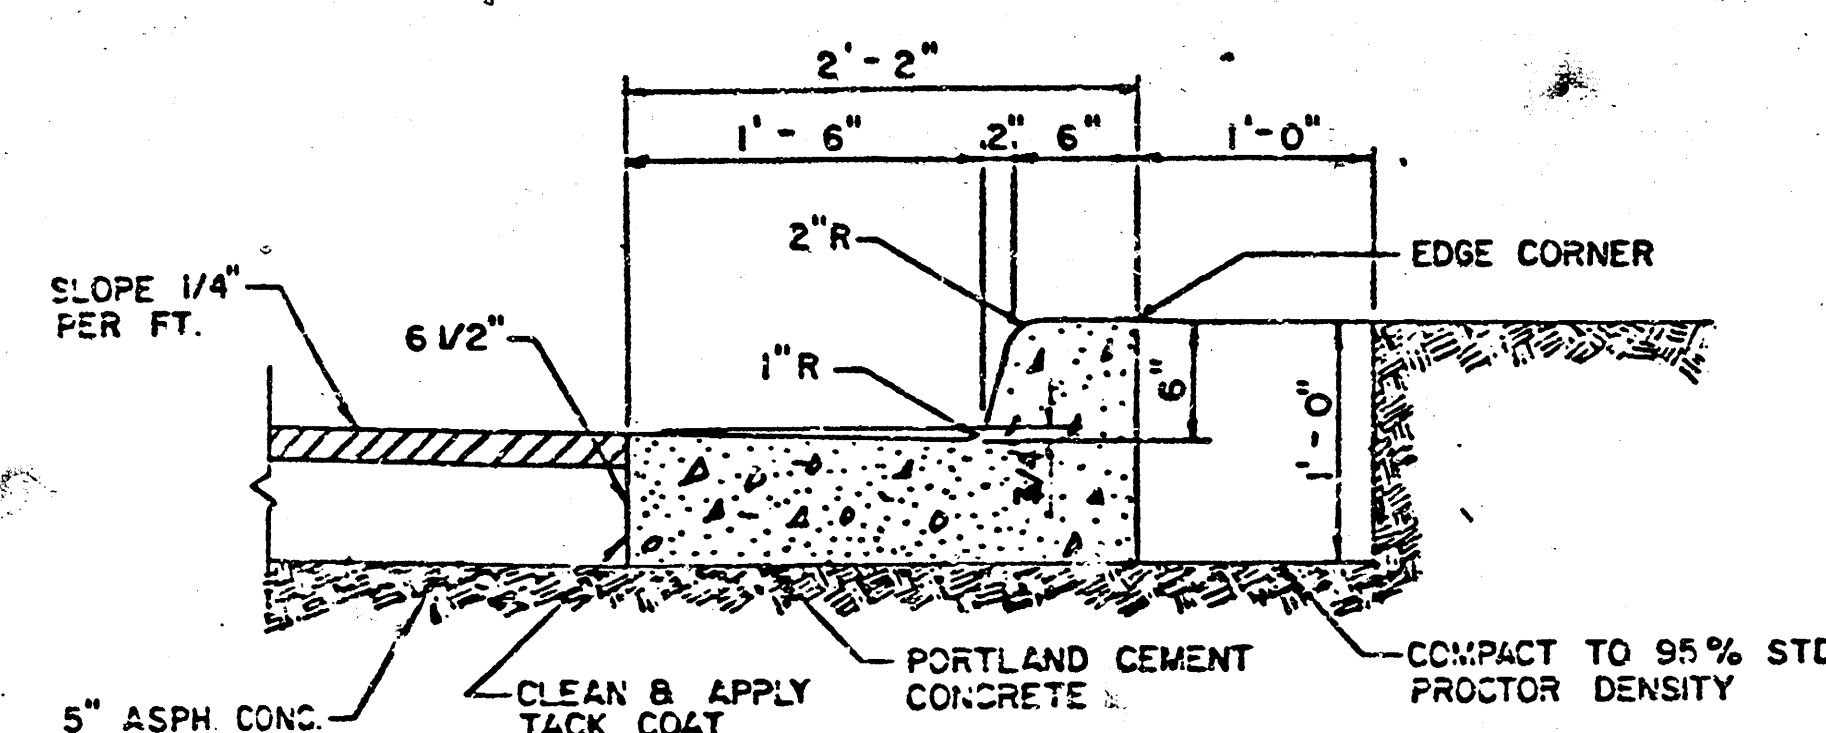

COMBINED CURB AND GUTTER



SCALE: 1"=1'

NOTE: REVERSE GUTTER SLOPE FOR MEDIAN SECTION.

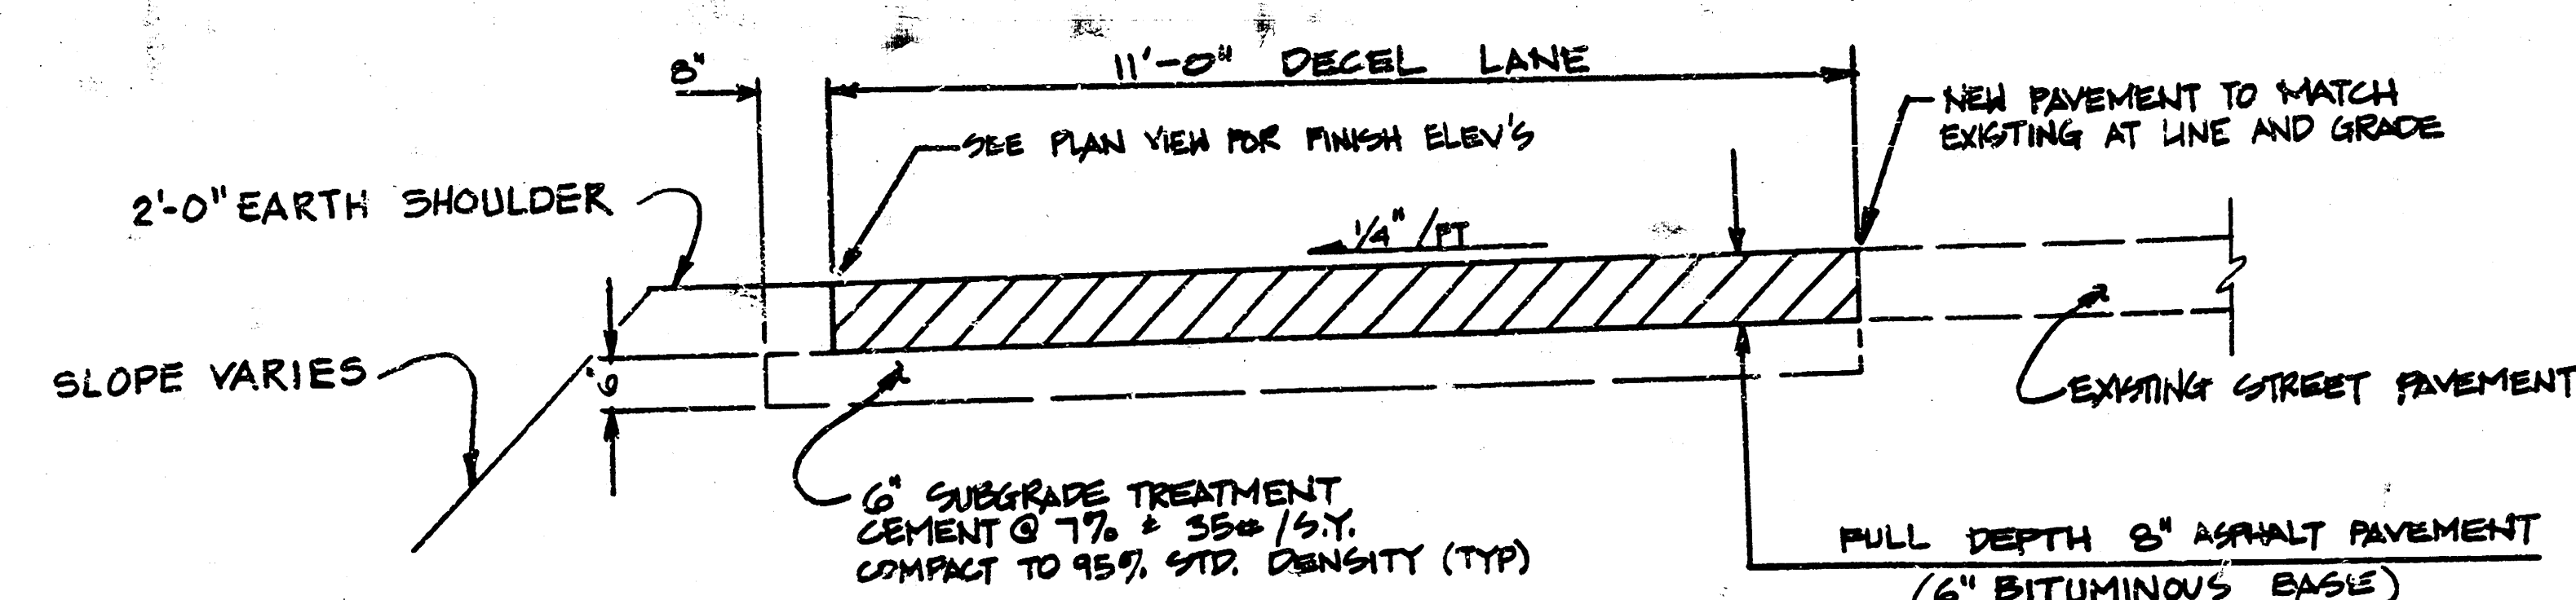

TYPICAL SECTION-DECEL LANE

1/2"=1'-0"

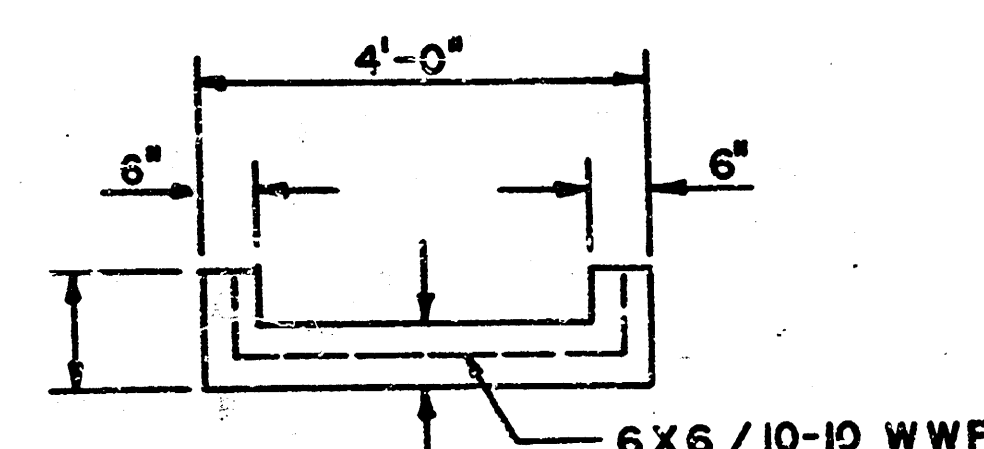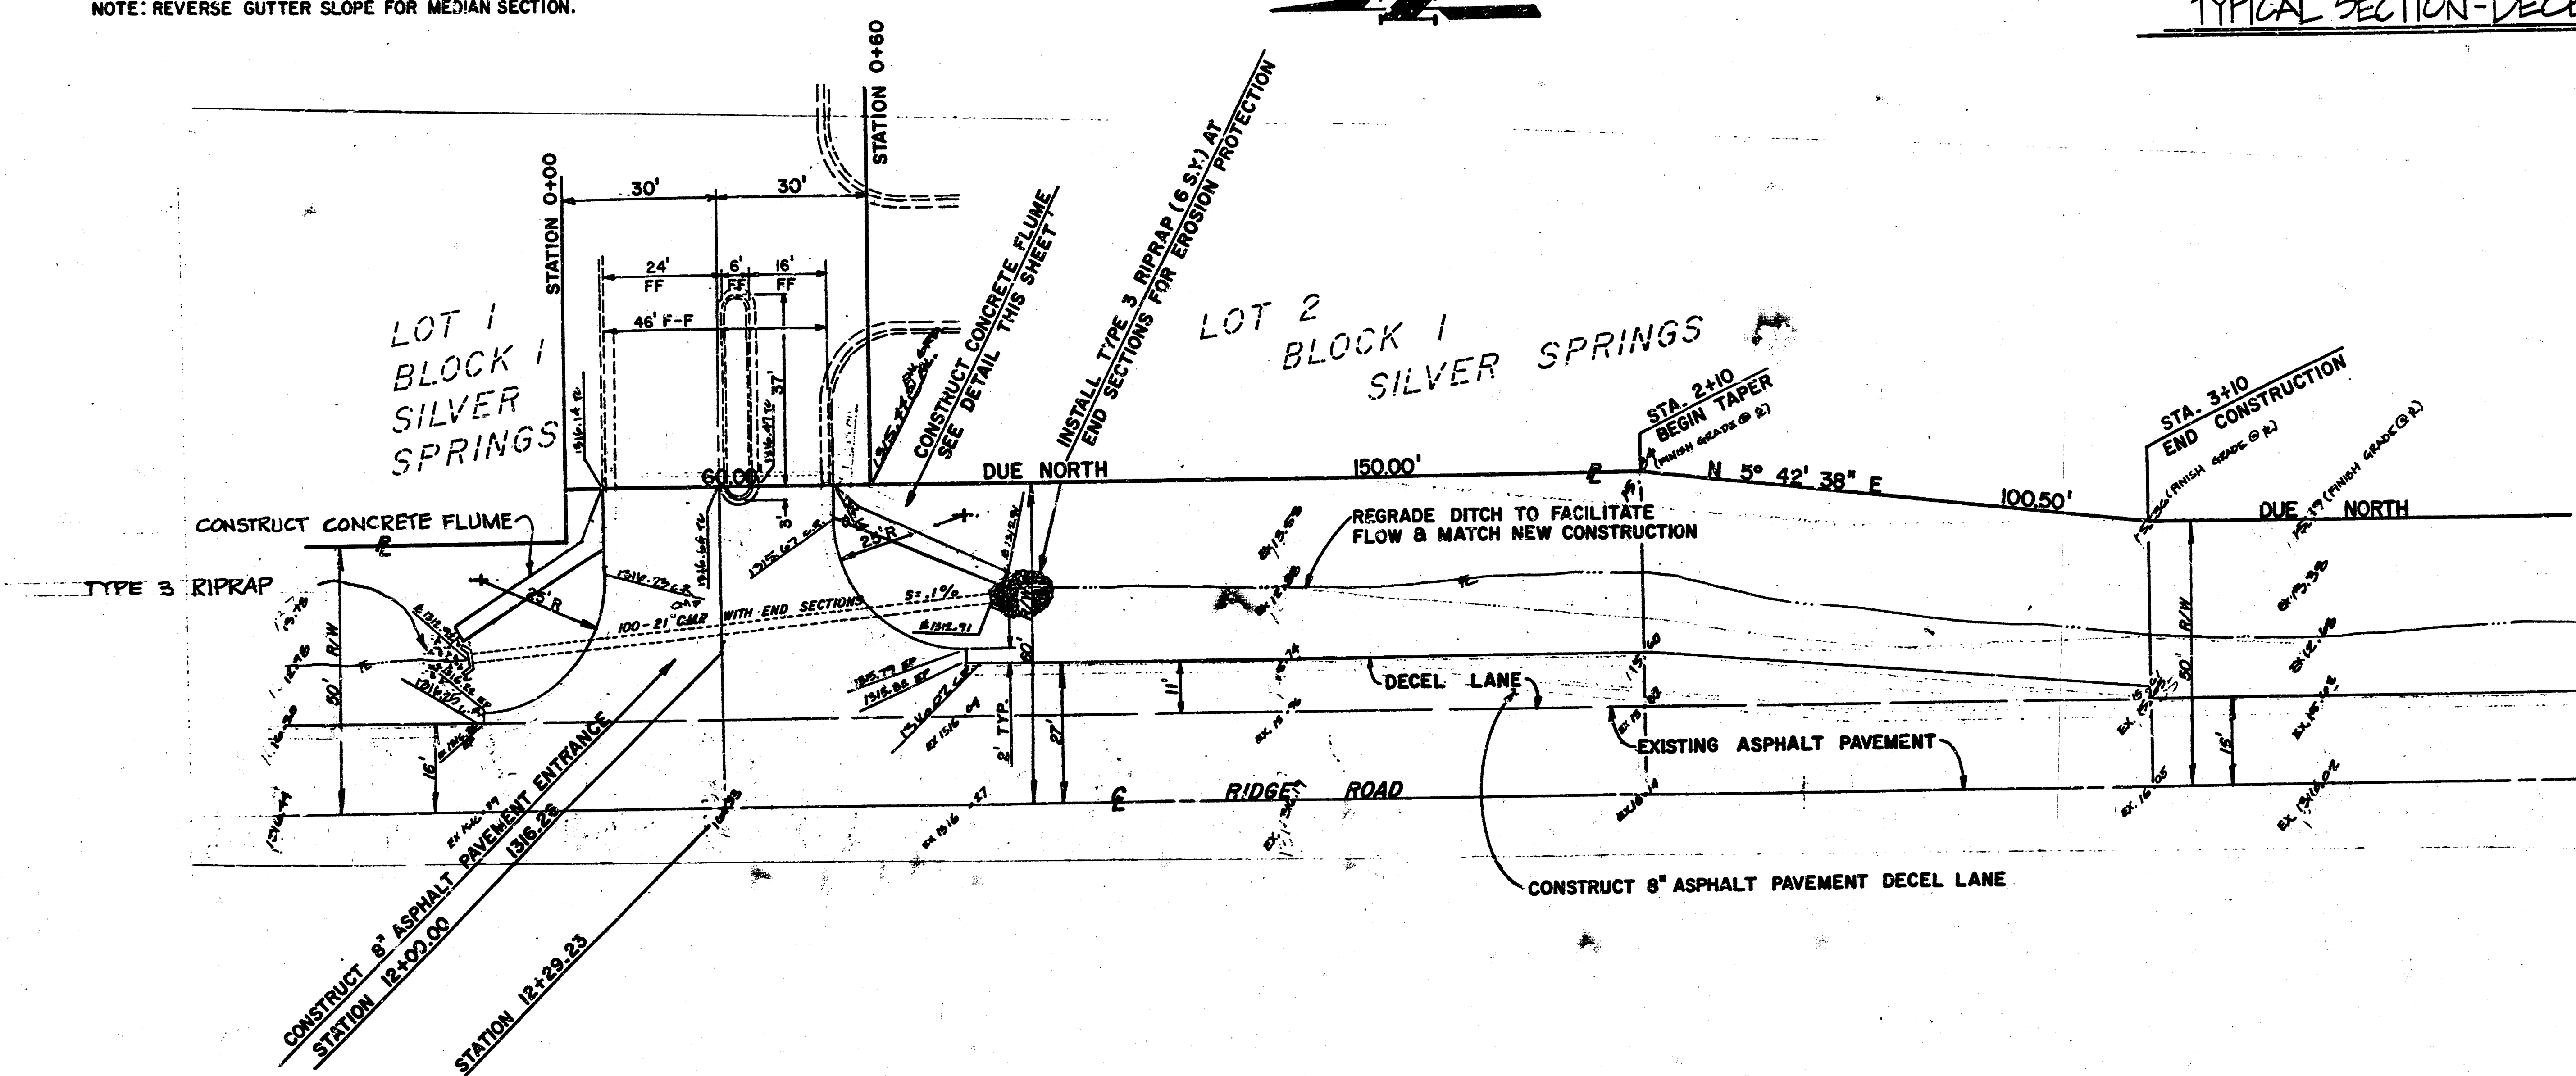

CONCRETE FLUME DETAIL

SCALE: 1"=2'-0"

CITY OF WICHITA, KANSAS
H.C. YOUNG & ASSOCIATES

REVISION	BY	DATE	PLAN SCALE	DESIGNED	APPROVED
			20'	S. DAVIS	
			PROFILE SCALE	DECEL LANE	
			HORIZONTAL	SILVER SPRINGS	
			VERTICAL	RECOMMENDED	
			FILE: 4337	DRAWING	
			ATLAS RATED	2	3

