


B.M. 102.03 "P" in P.K. 15, east end s.e. cor. Skinner & Greenway Blvd.  
 B.M. 103.89 "T" in Troy top fire hyd. n.w. cor. Skinner & Exchange.  
 B.M. 104.48 "T" in Troy top fire hyd. s.w. cor. Exchange & Funston.

TIES TO IRON & SILVER & SKINNER

37.62' N.E. to cutn' wall of three, west side 10' elm.  
 25.12' N.W. to cutn' wall of three N.E. face pole.  
 29.80' S.W. to cutn' wall of three S.E. face pole.

0+00: 100.00 ft. west of west line Silver on & extended.

Stations & chaining East on &

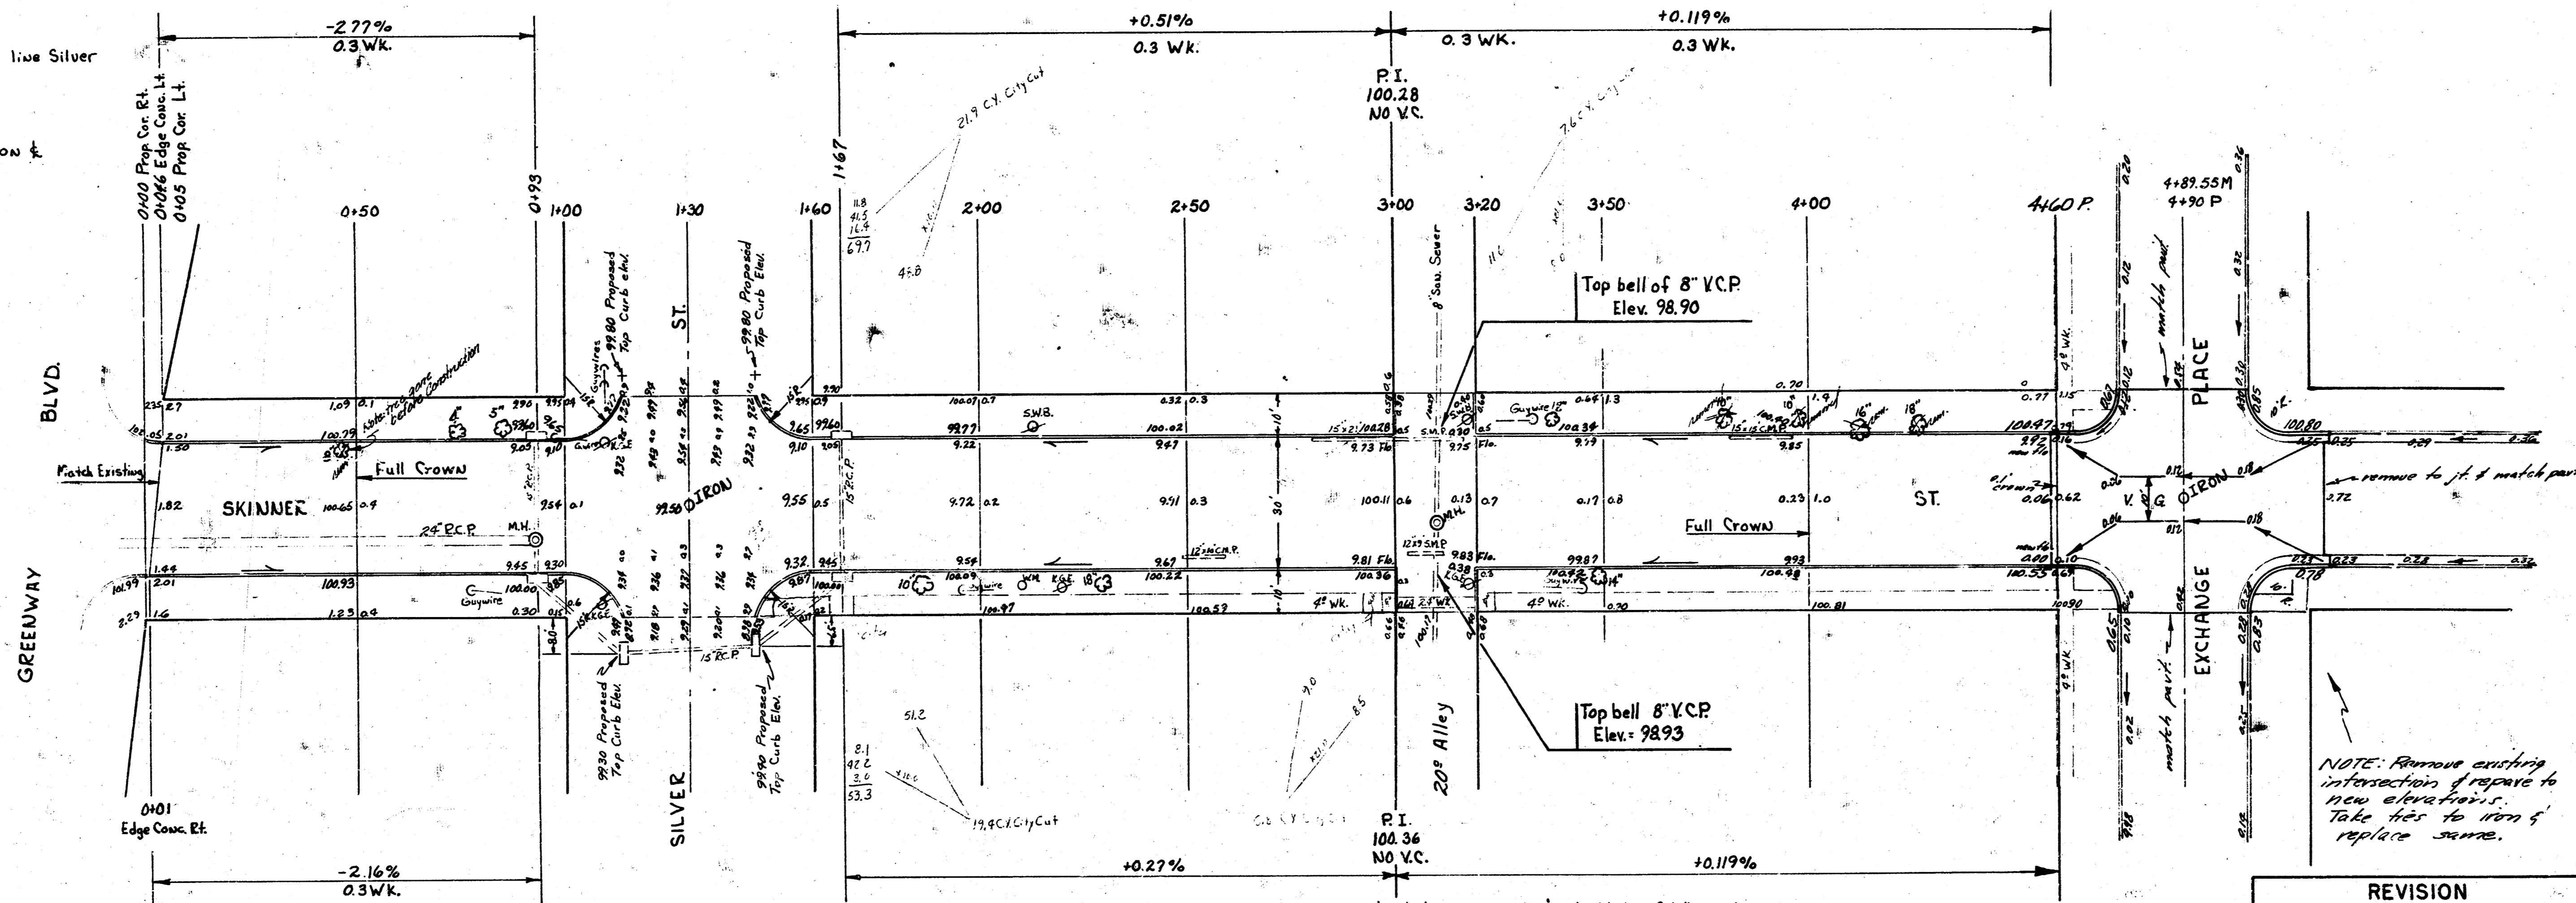


**NOTE:**  
 Sanitary sewer @ alley to be  
 excavated prior to paving.

REVISION		
DATE	CHANGED BY	CHECKED BY
4Feb. 59	Swickard	Zimm

**SKINNER ST.**  
 E.L. GREENWAY to W.L. EXCHANGE  
 30" CONC. & CB.  
 CITY OF WICHITA, KANSAS



B.E. SMITH  
 DATE: NOV, 1958  
 CITY ENGINEER  
 PROJ. NO. C18-142

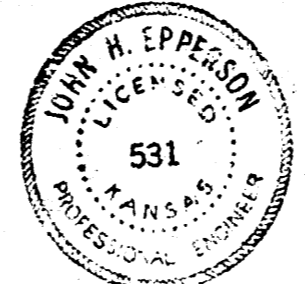

E.L.  
 120.5  
 410.5  
 132.7

1/2

5