





BENCHMARK:
BM #1: ARKANSAS AND 33RD ST. N.
C.O.W. BENCHMARK
32.00 FT SOUTH OF CENTERLINE OF
33RD ST. GOING EAST
22.00 FT EAST OF CENTERLINE OF
ARKANSAS
ELEV= 1317.21 (NGVD 29)
ELEV= 129.81 (CITY DATUM)

BM #2: C.O.W. DISK NE BRIDGE
HEADWALL 33RD AND DRAINAGE
CANAL
ELEV= 1320.98 (NGVD29)
ELEV= 133.58 (CITY DATUM)

All trench and manhole excavation areas from
Sta. 1+72.3 to Sta. 2+50.0 and Sta. 2+93.0 to
3+80.3, Line 1 and Sta. 0+00.0 to Sta. 0+49.1,
Line 1A shall be backfilled with sand. The sand
backfill shall be within two feet of existing
grade and shall be water-jetted and vibrated
during backfilling. All costs shall be paid for as
L.F. "Sand Backfill Jetted and Vibrated".

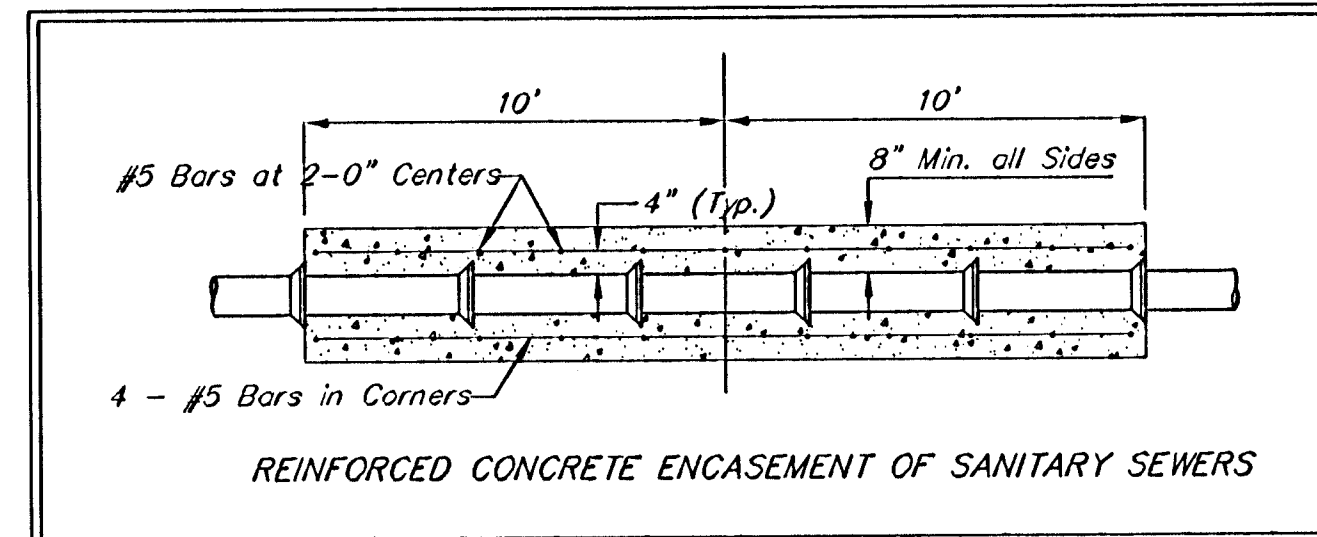

Scale: 1" = 40' Horizontal
1" = 5' Vertical
• = Iron

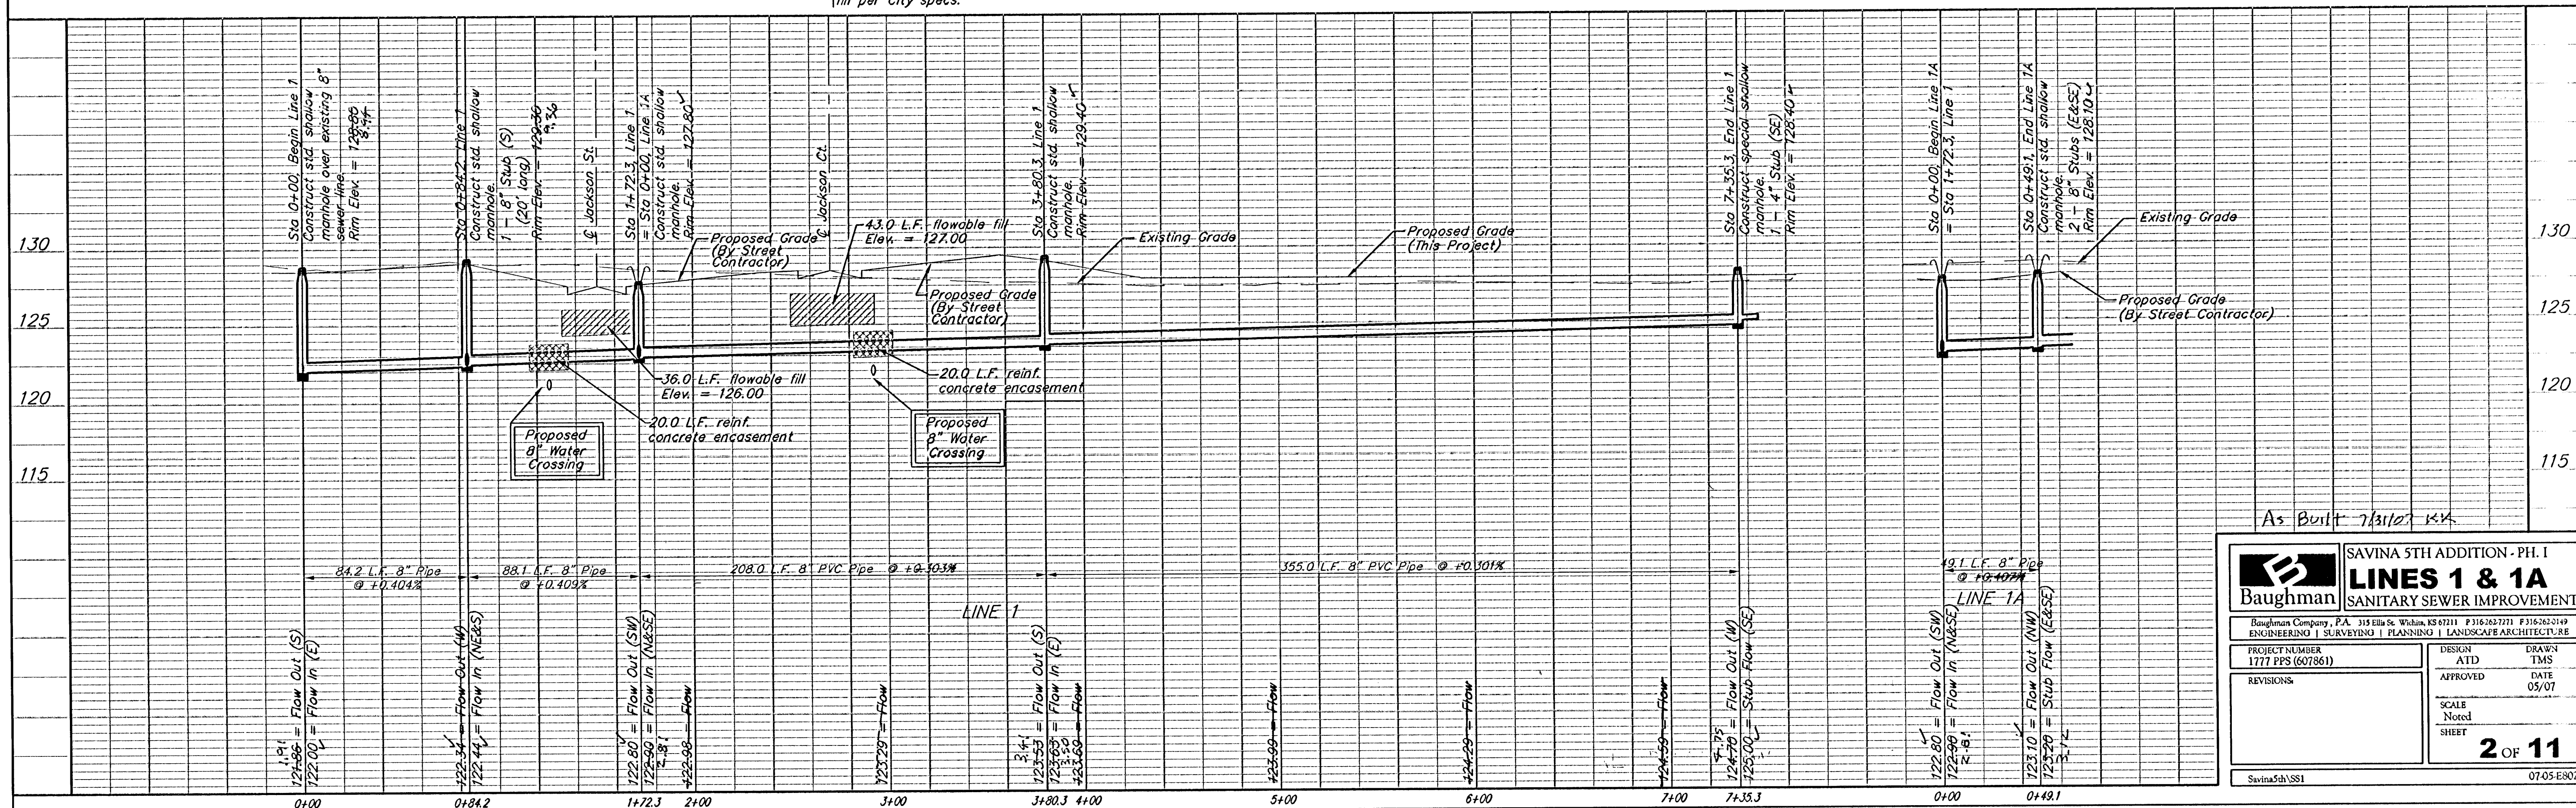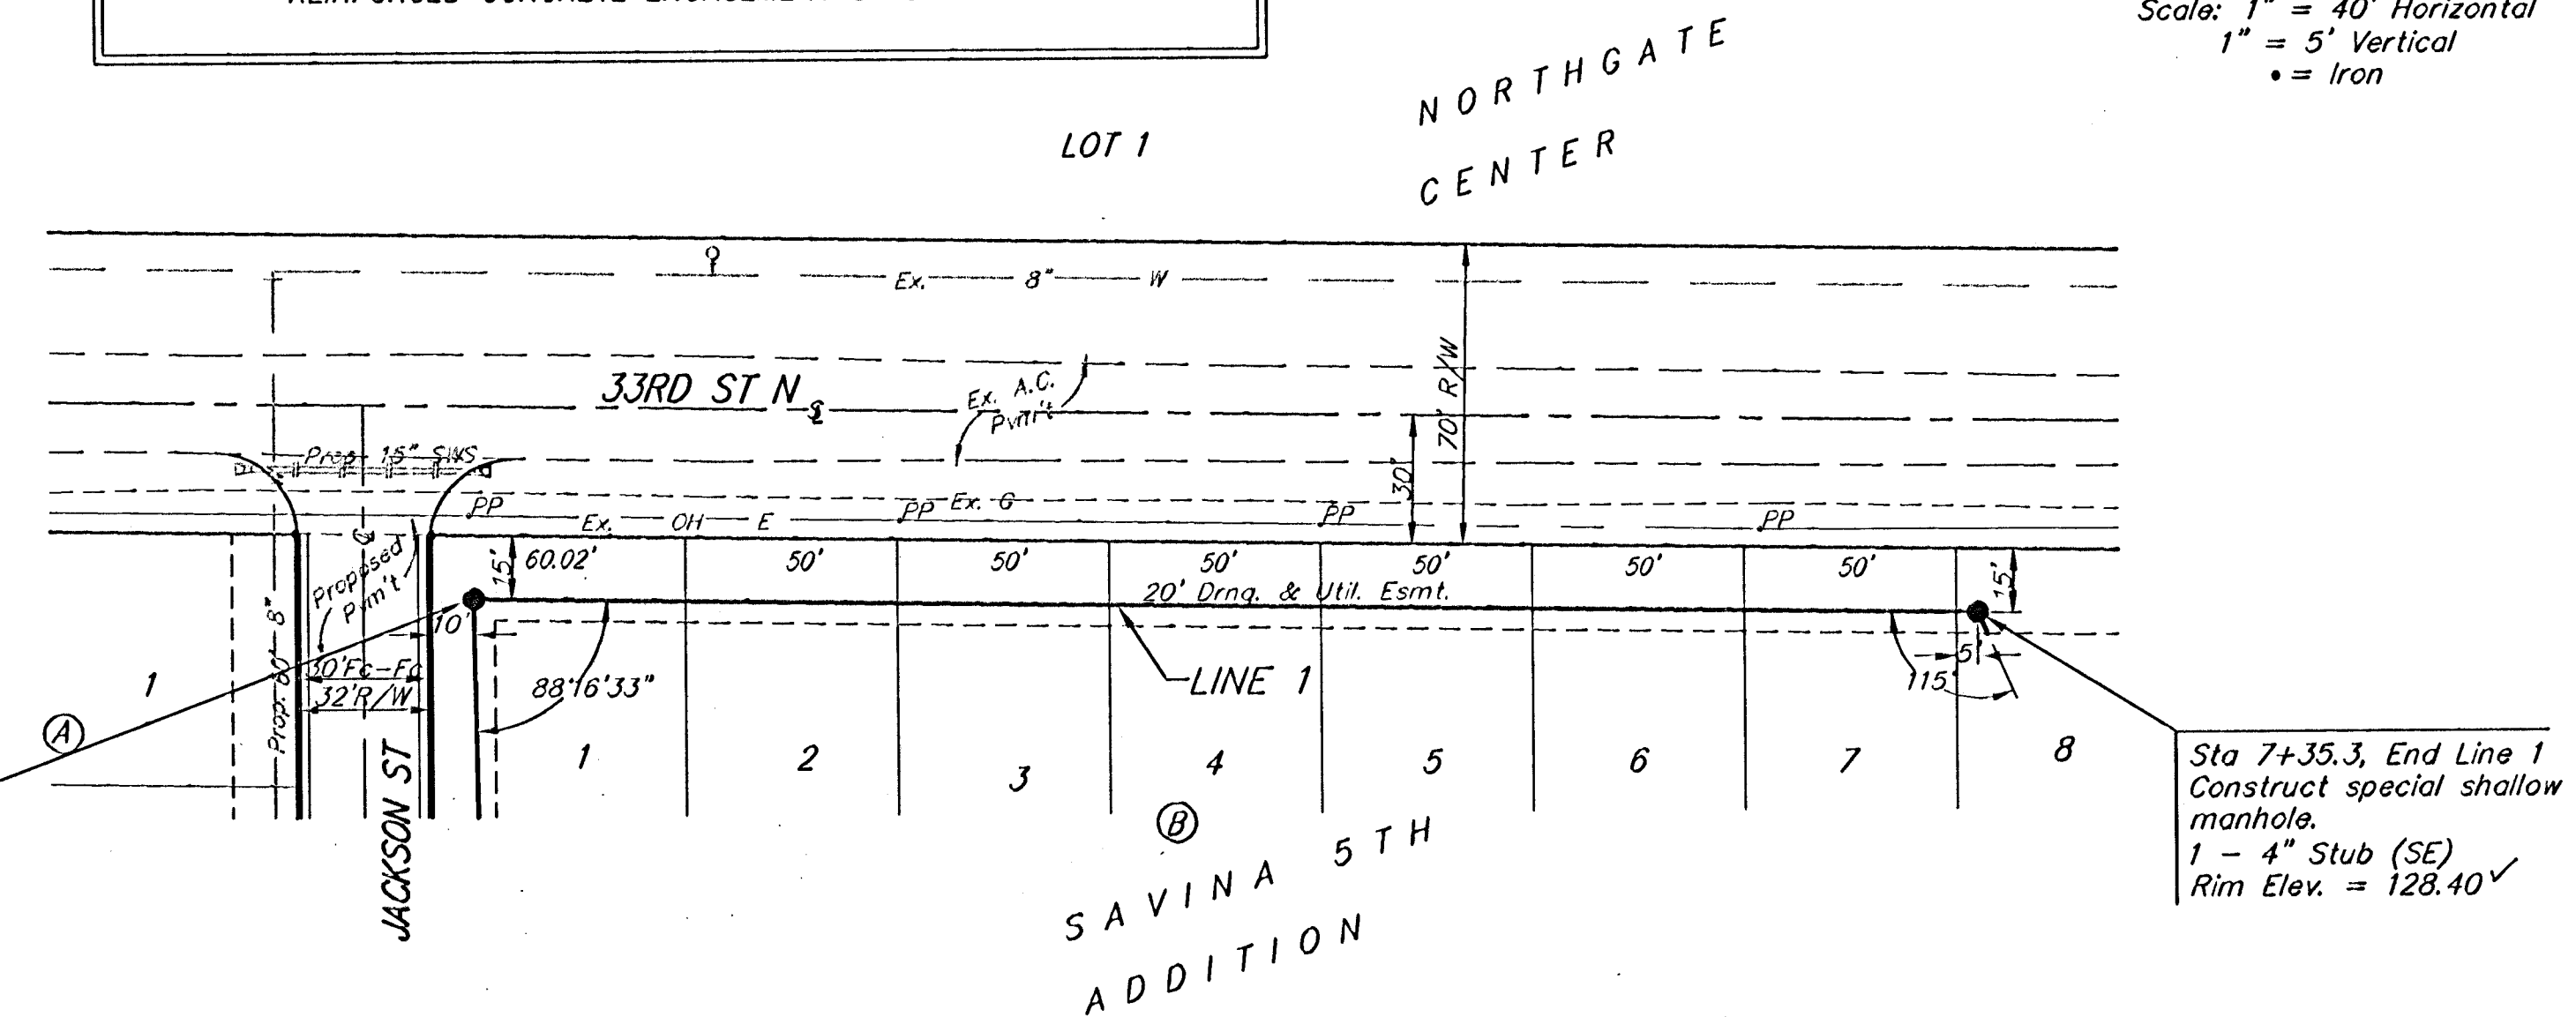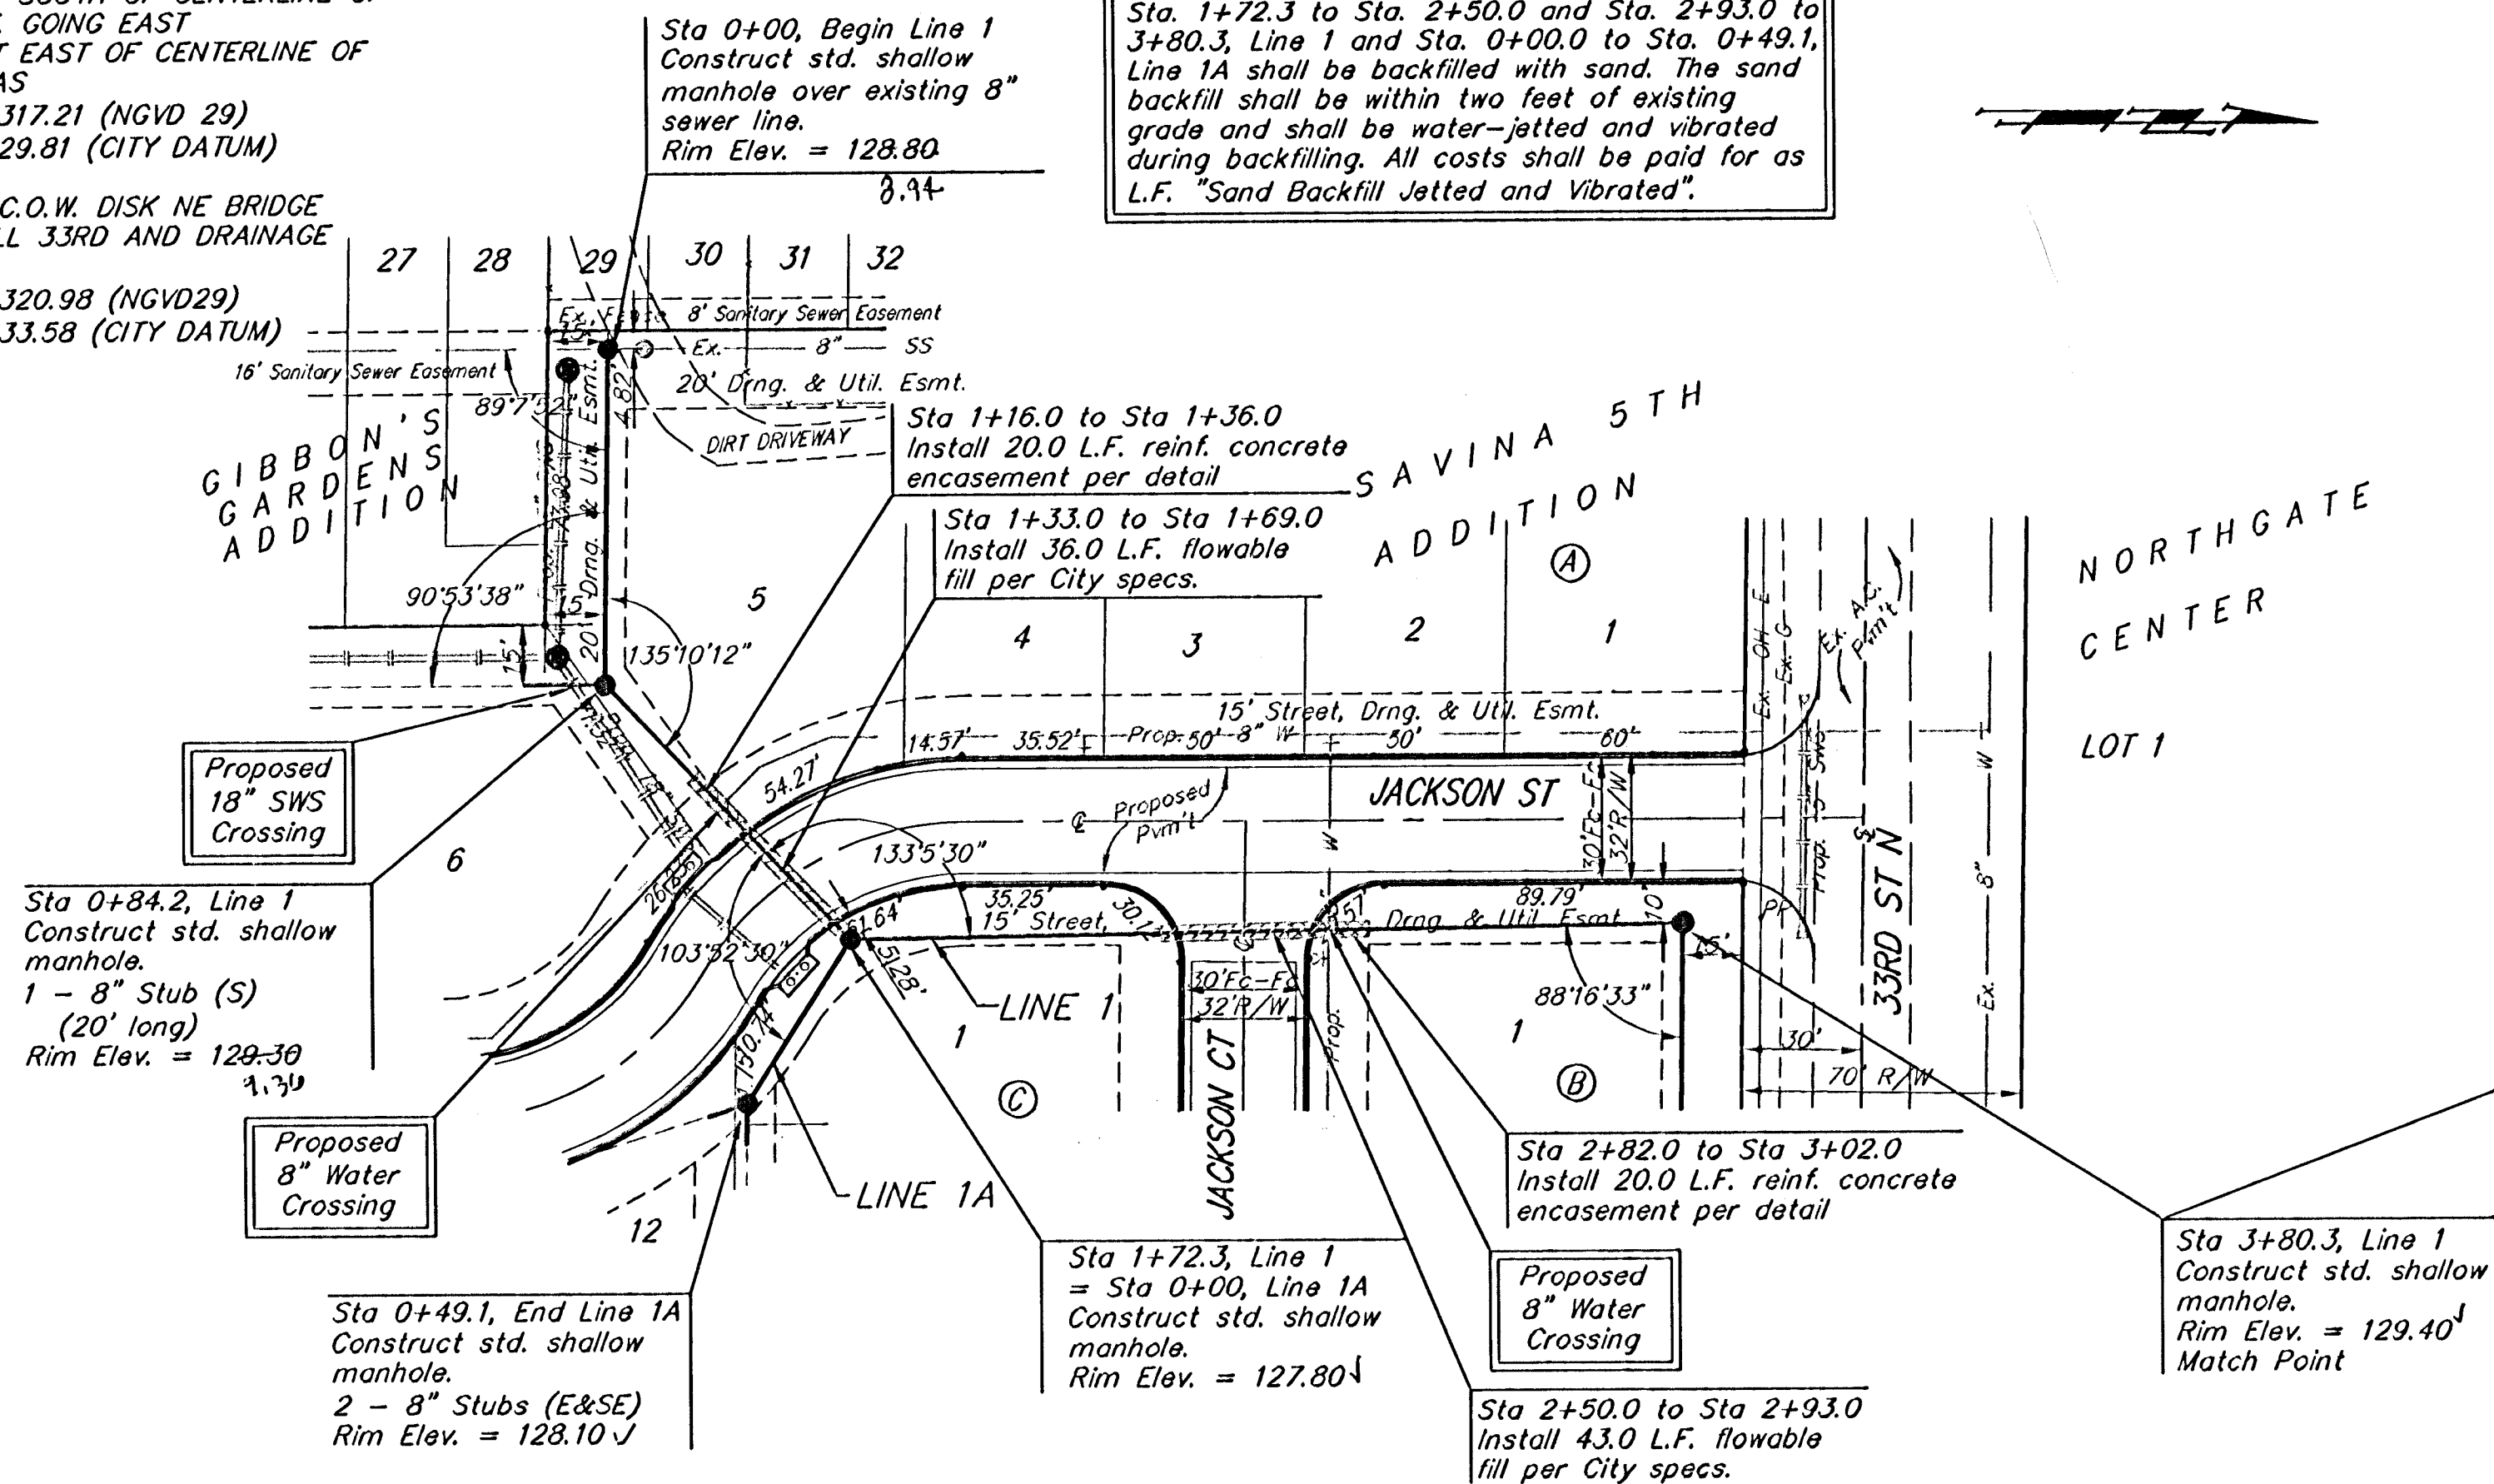

As Built 7/31/27 KSK

BAUGHMAN		SAVINA 5TH ADDITION - PH. I	
ENGINEERING SURVEYING PLANNING LANDSCAPE ARCHITECTURE		LINES 1 & 1A	
PROJECT NUMBER 1777 PPS (607361)		DESIGN ATD	
REVISIONS		DATE 05/07	
SCALE Noted		SHEET 2 OF 11	
Savina5th/SS1		07-05-E002	