

NOTE:  
CONTRACTOR SHALL PROTECT TREES ON LOTS 6, 7, 8 & 9, BLOCK 3  
AND FUTURE LOTS 33-36 FROM DAMAGE DURING CONSTRUCTION.  
TREES SHALL BE REMOVED ONLY WITH ENGINEER'S APPROVAL.  
TRIMMING OF TREES SHALL BE DONE ONLY WITH SAWS.


SEWER SERVICE TABLE

NUMBER	TYPE	LOCATION			FOR INFORMATION ONLY	
		LOT NO.	BLOCK NO.	LINE NO. STATION \ DIRECTION	APPROXIMATE LENGTH 4" PIPE	
					VERTICAL	HORIZONTAL
1	8" X 4" Tee Saddle	50	-	1 11+41/R	8'	10'
2	8" X 4" Tee Saddle	51	-	1 12+28/R	9'	10'
3	8" X 4" Tee Saddle	52	-	1 13+03/R	10'	10'
4	4" MH Riser	53	-	1 13+66/R	64.74 11'	6' N, 8' E
5	8" X 4" Tee Saddle	54	-	1 13+85/R	10'	10'
6	8" X 4" Tee Saddle	55	-	1 14+62/R	8'	10'
7	8" X 4" Tee Saddle	9	3	1 18+86/L	8'	10'



SCALE 1" = 40' HORIZ.  
1" = 5' VERT.  
IRON = ●

NOTE: Vertical Riser Pipe shall be extended to 2' minimum above ground water elevation and 4' maximum below proposed ground elevation.

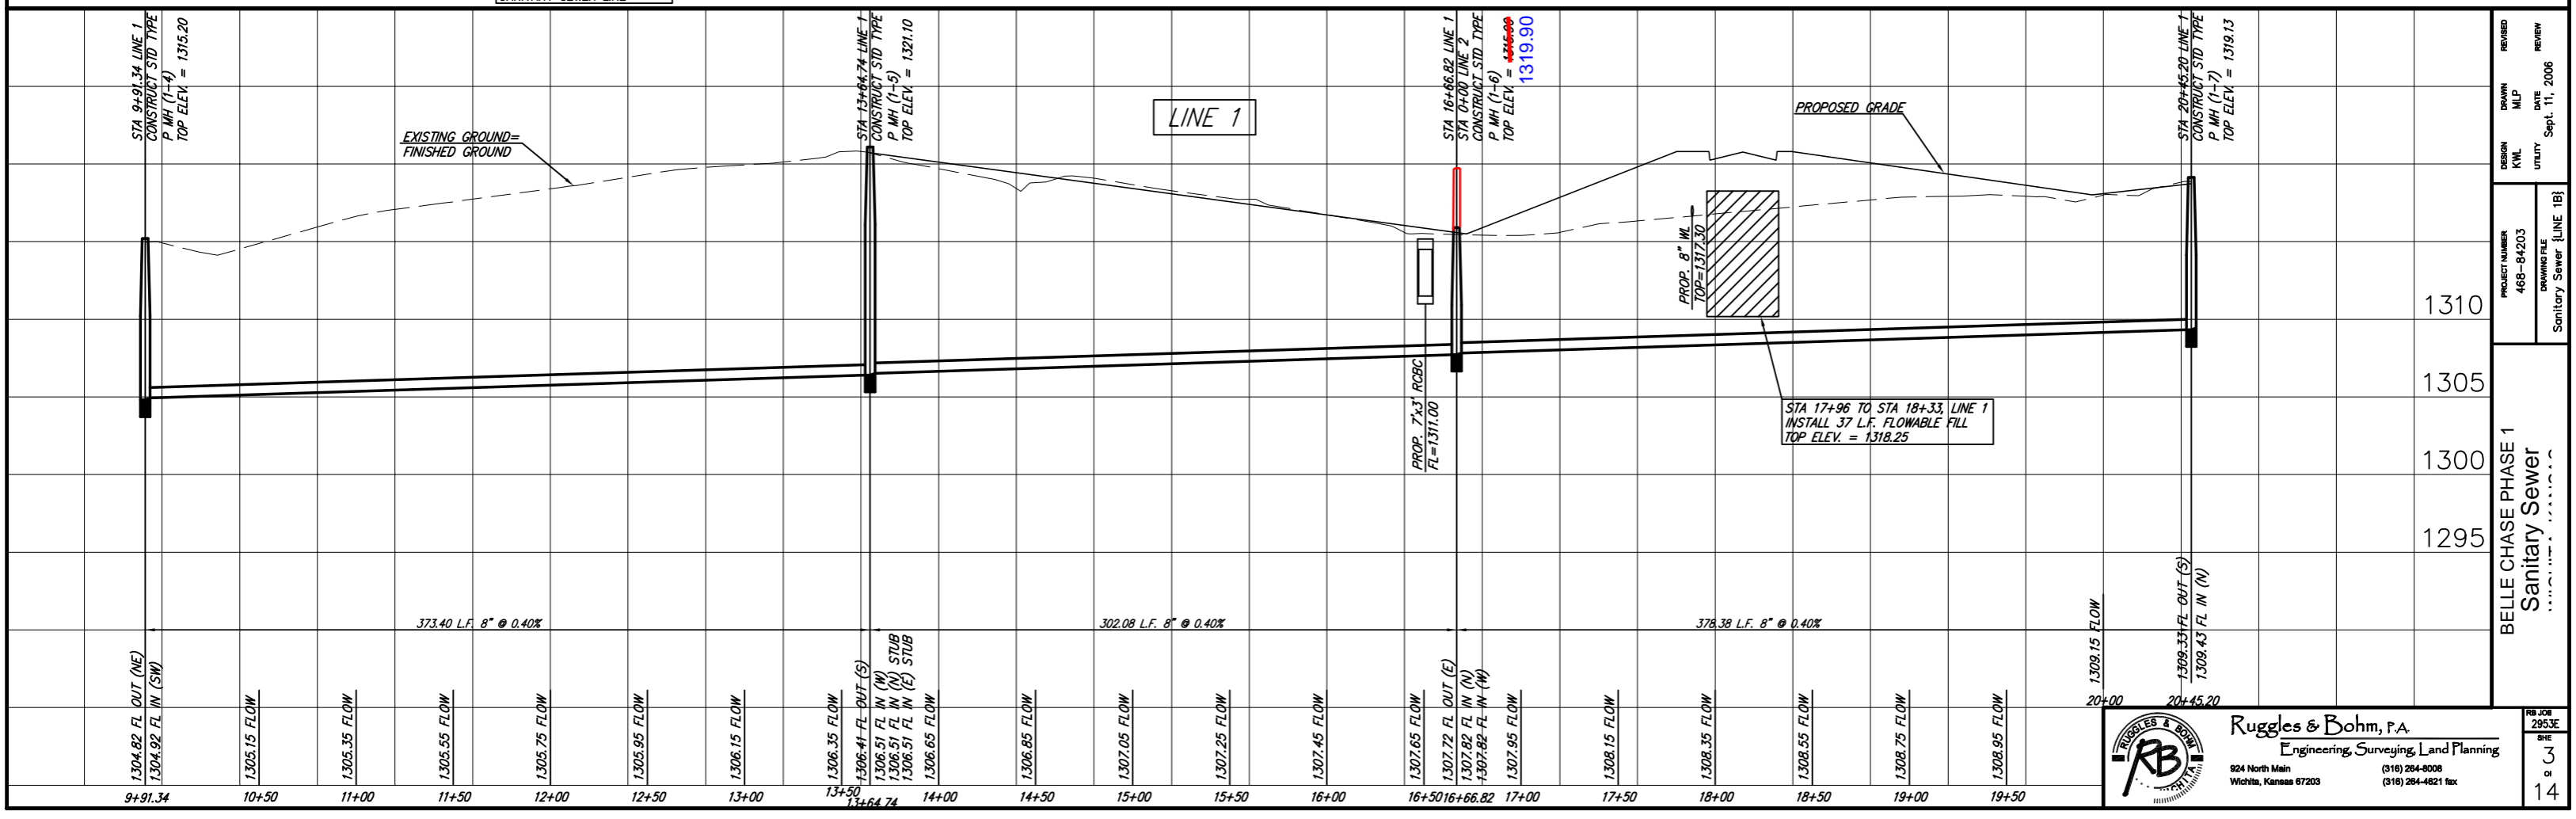

REVISIONS

NO.	DATE	BY	REVISION
1	Sept. 11, 2006	MLP	REVIEW

DESIGN: KWL  
DRAWN: MLP  
DATE: Sept. 11, 2006

PROJECT NUMBER: 468-84203  
DRAWING FILE: [LINE 1B]

BELLECHASE PHASE 1  
Sanitary Sewer

RUGGLES & BOHM, P.A.  
Engineering, Surveying, Land Planning  
924 North Main  
Wichita, Kansas 67203  
(316) 264-8008  
(316) 264-4821 fax

SCALE: 1" = 40' HORIZ.  
1" = 5' VERT.

14