


BENCHMARK:
 "X" at Back of Walk 50'± West
 & 50'± South of C. of Tyler &
 Central Intersection
 Elev. = 145.03 City Datum


APPROVED AS NOTED
 BY CITY ENGINEER OF WICHITA

Sanitary Sewer _____
 Storm Sewer VRH 8/24/95
 Driveway Approaches _____
 Driveway _____
 Paving _____


NOTE TO CONTRACTORS
 Inspection and testing for this project is to be provided by a
 Licensed Consulting Engineering Firm under contract with the
 Owner/Developer. Soil inspection is to be in accordance with the
 City of Wichita standard construction engineering practices and
 certified by a Licensed Professional Engineer. No work shall be
 performed in dedicated easements or public right-of-way by the
 Contractor without such inspection nor shall any work be commenced
 without written authorization by the City Engineer. All Construction
 and materials shall comply with the City of Wichita Specifications
 and Standards (on file and available in the City Engineer's Office).

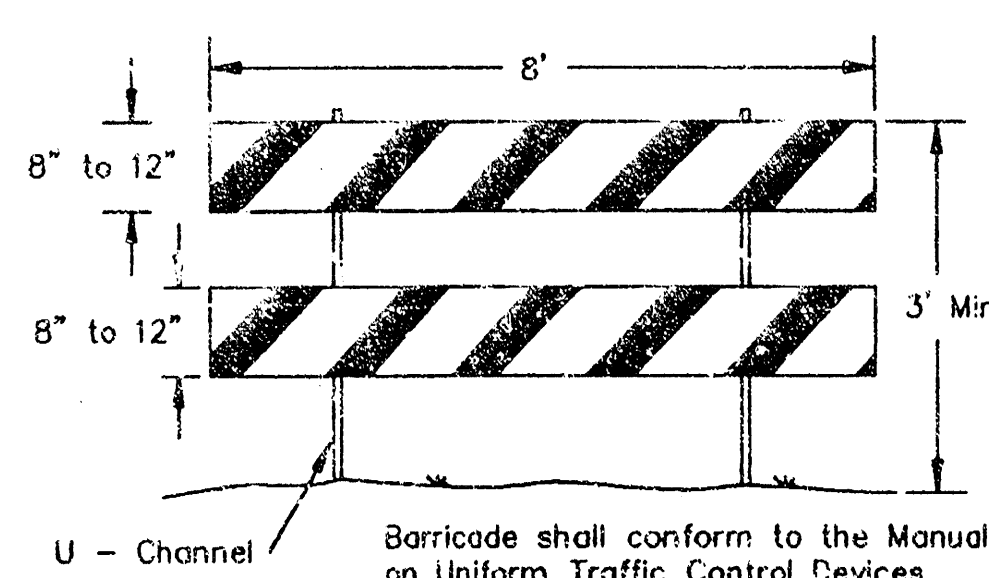



TYPE II BARRICADE
 DETAIL
 NOT TO SCALE

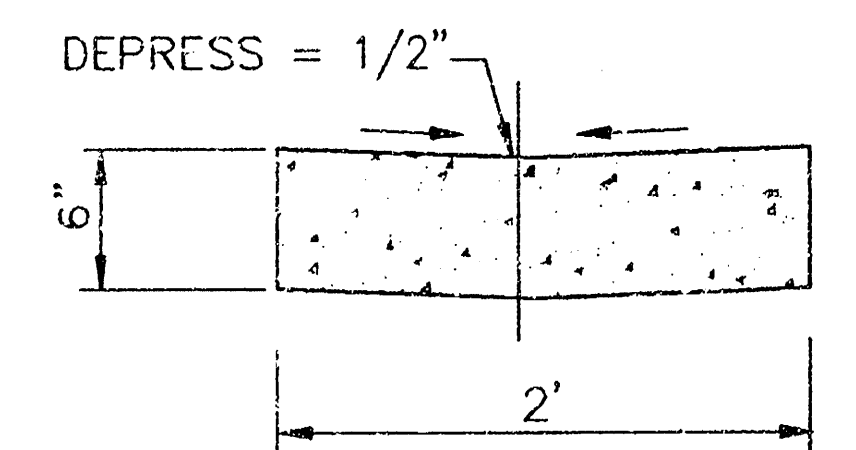


CONCRETE VALLEY
 GUTTER DETAIL
 NOT TO SCALE

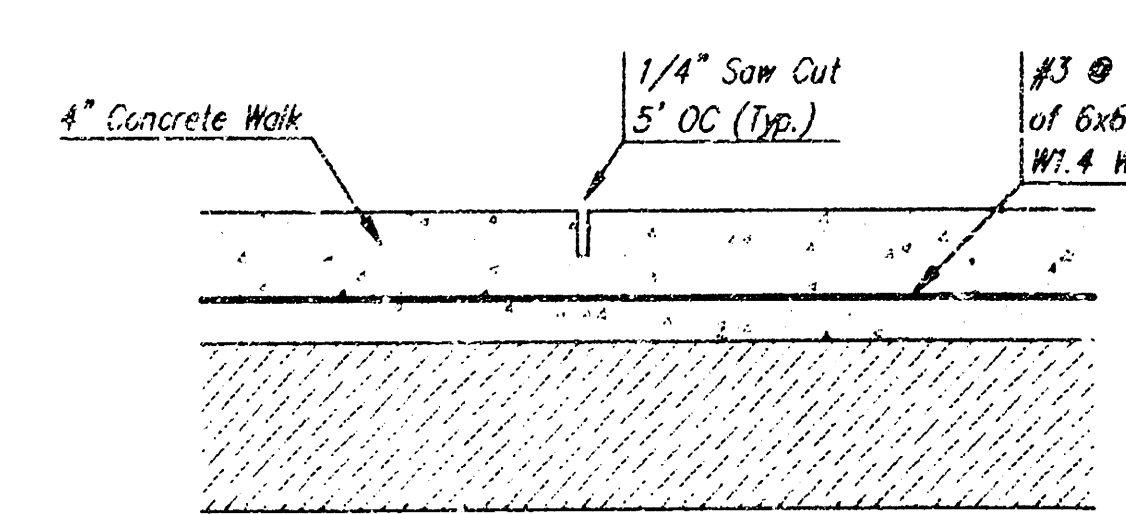


SIDEWALK DETAIL
 NOT TO SCALE

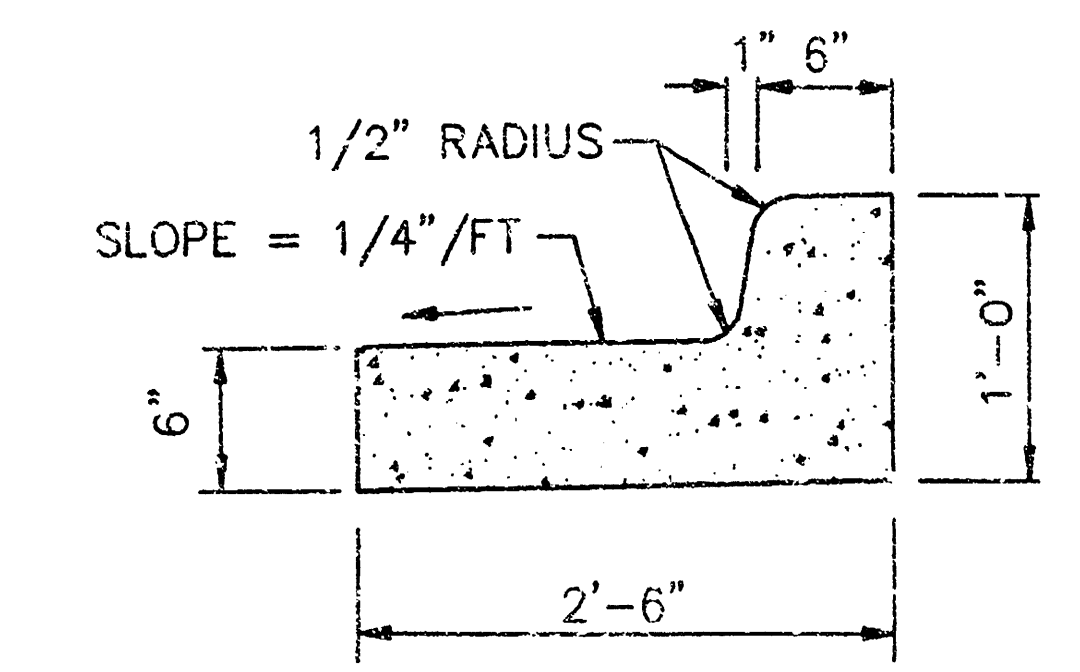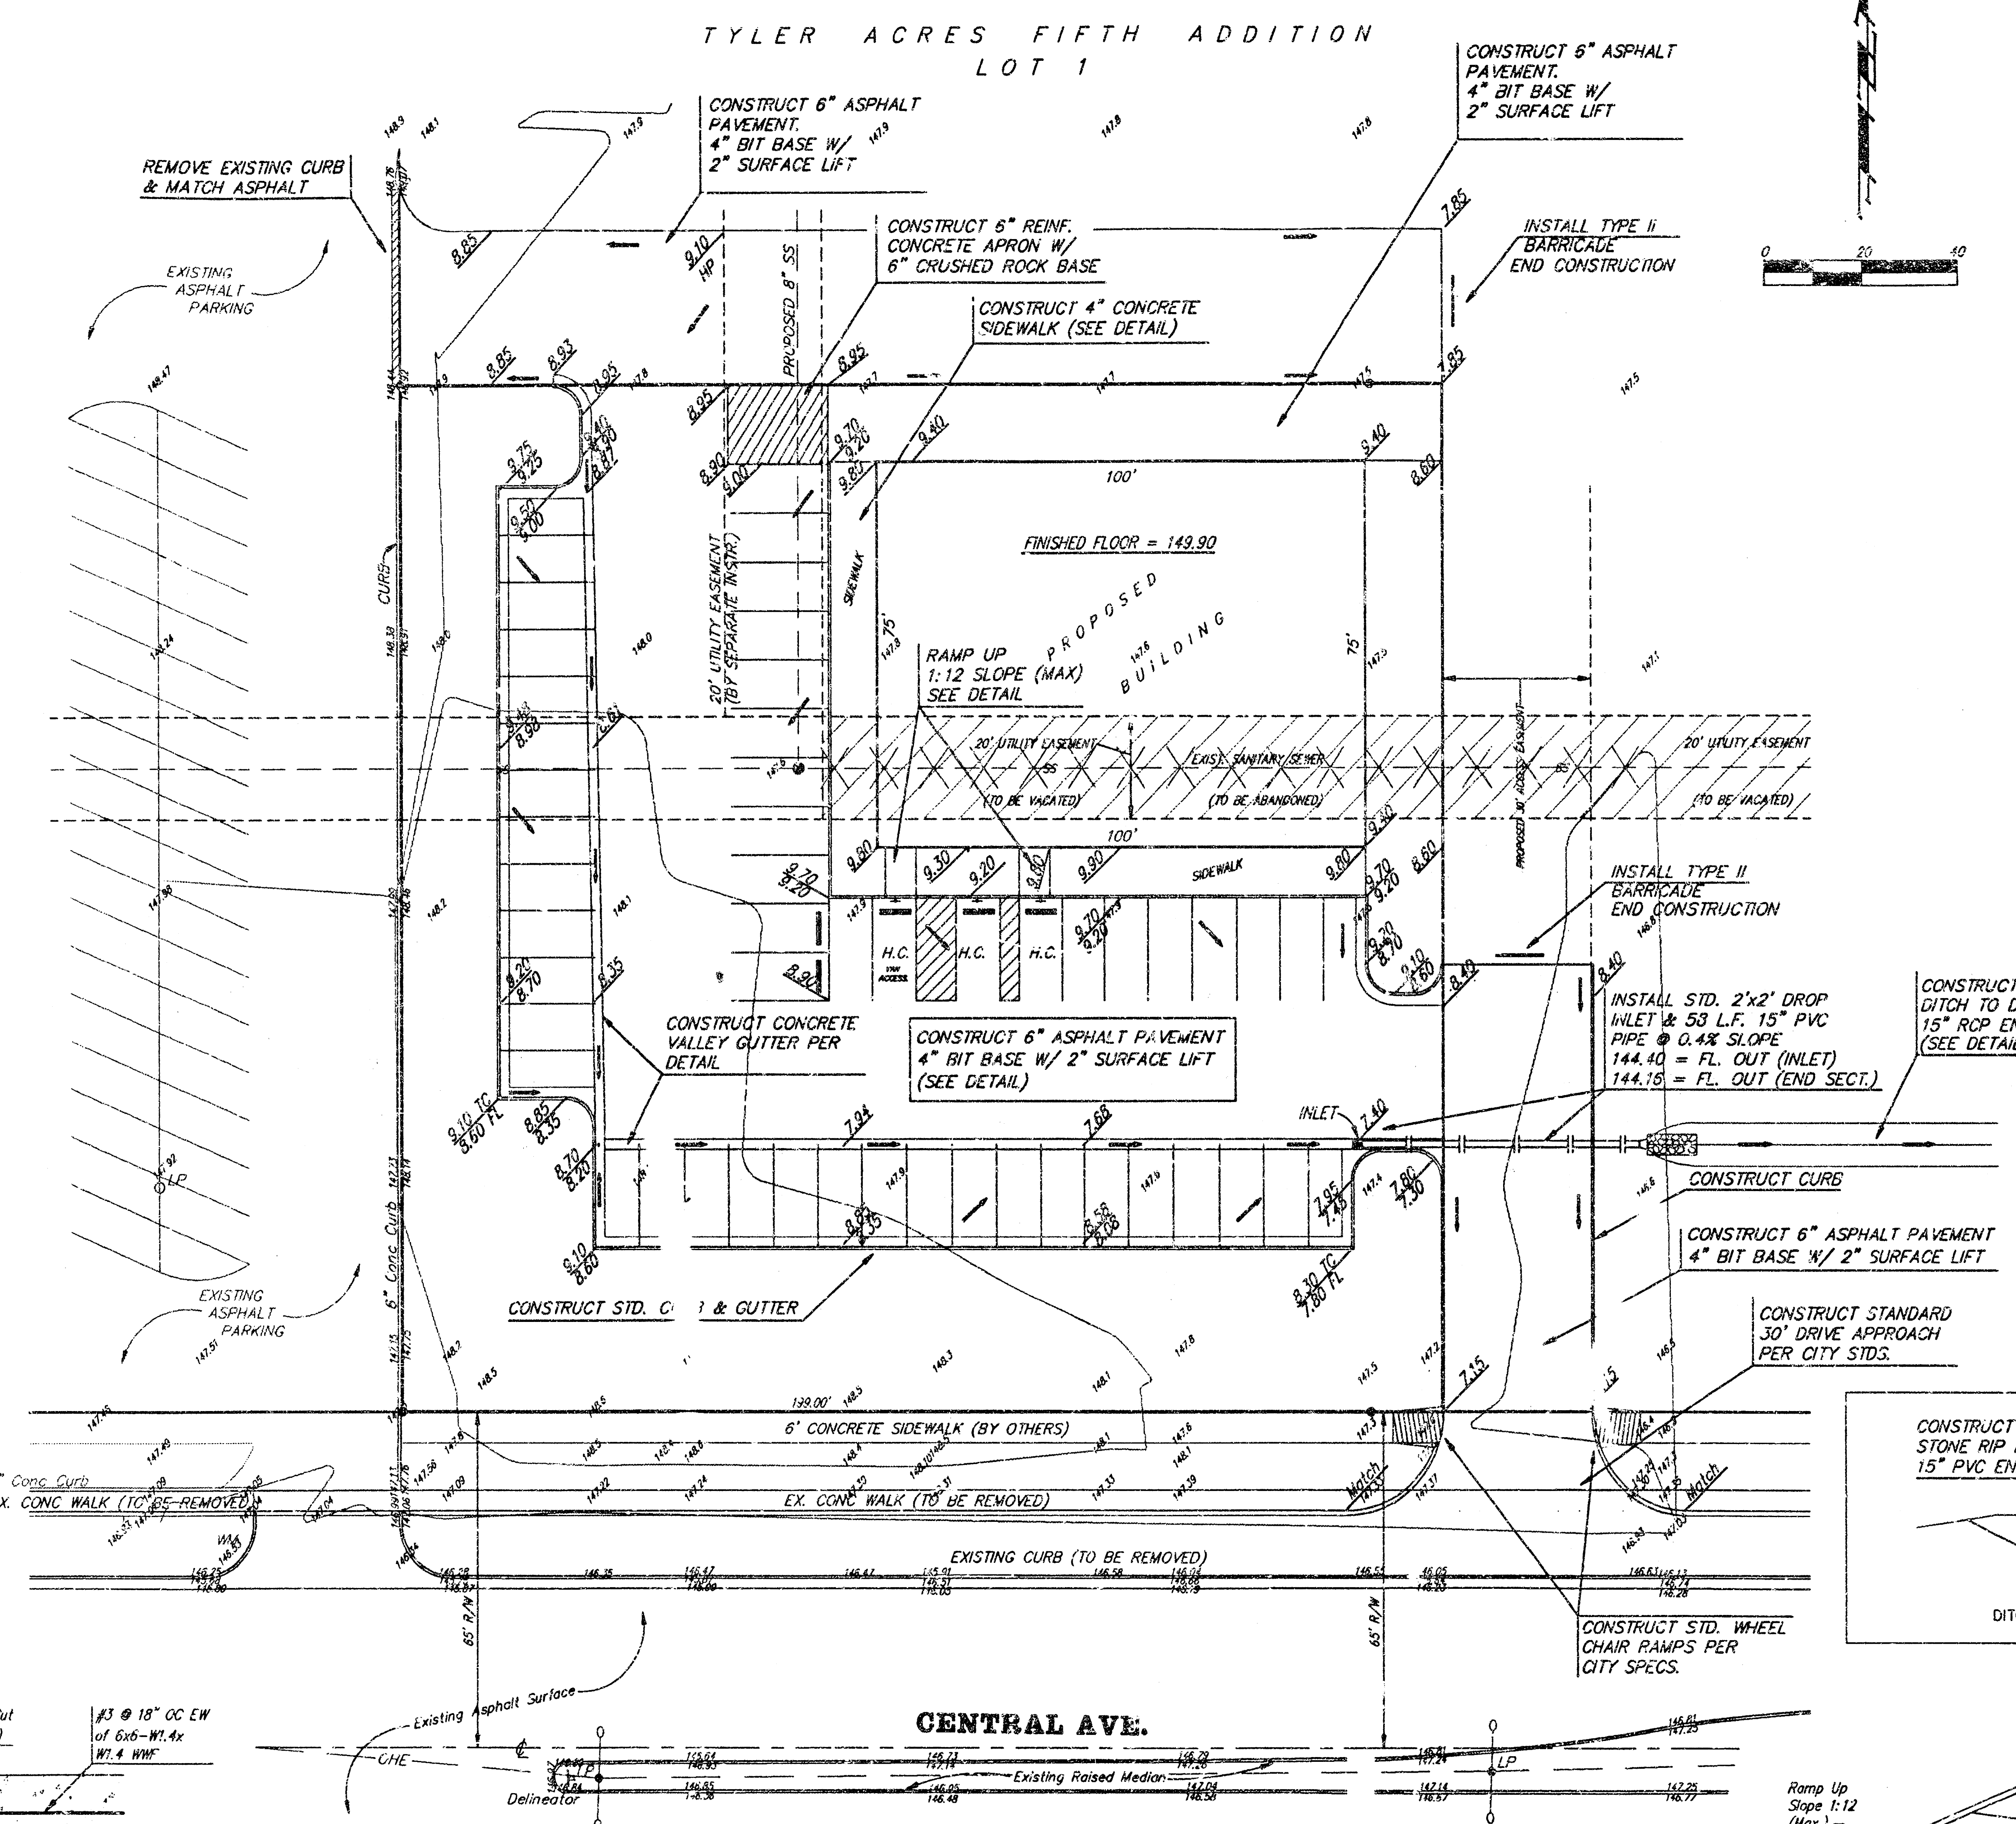

STD. CURB & GUTTER
 DETAILS
 NOT TO SCALE



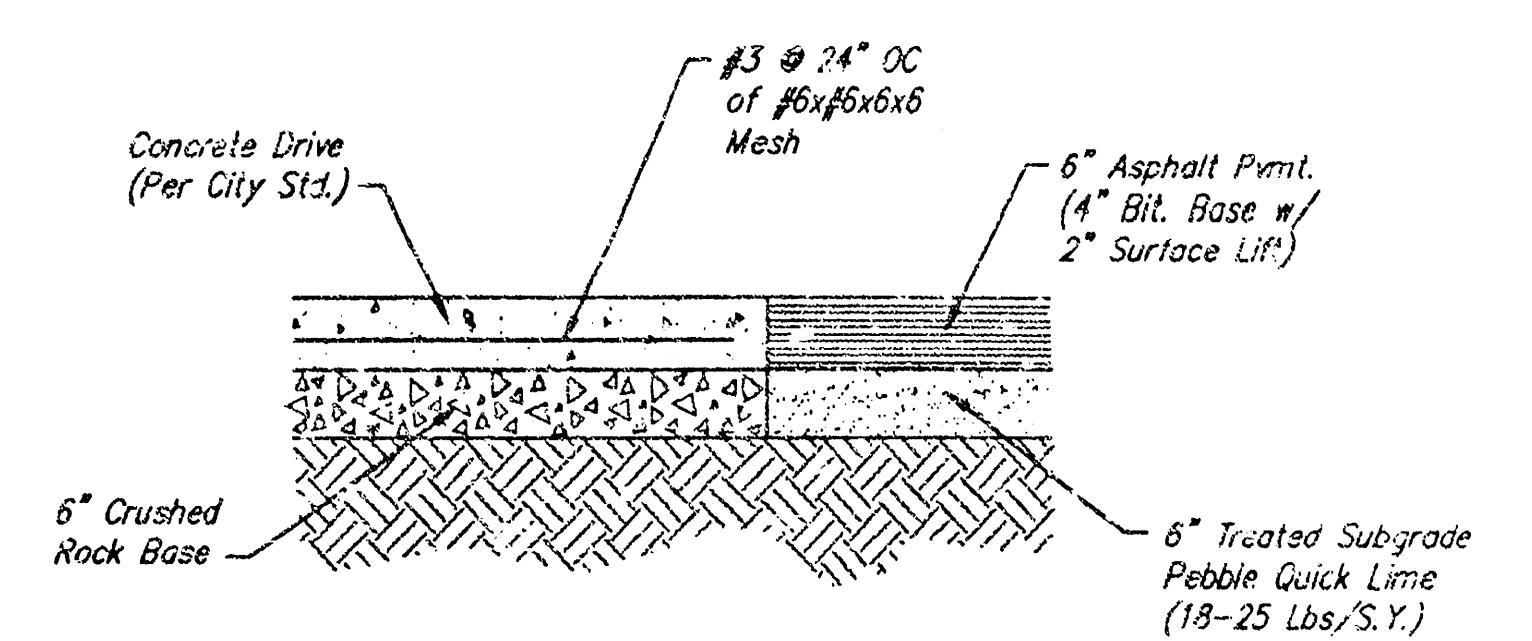


PAVEMENT DETAILS
 NOT TO SCALE

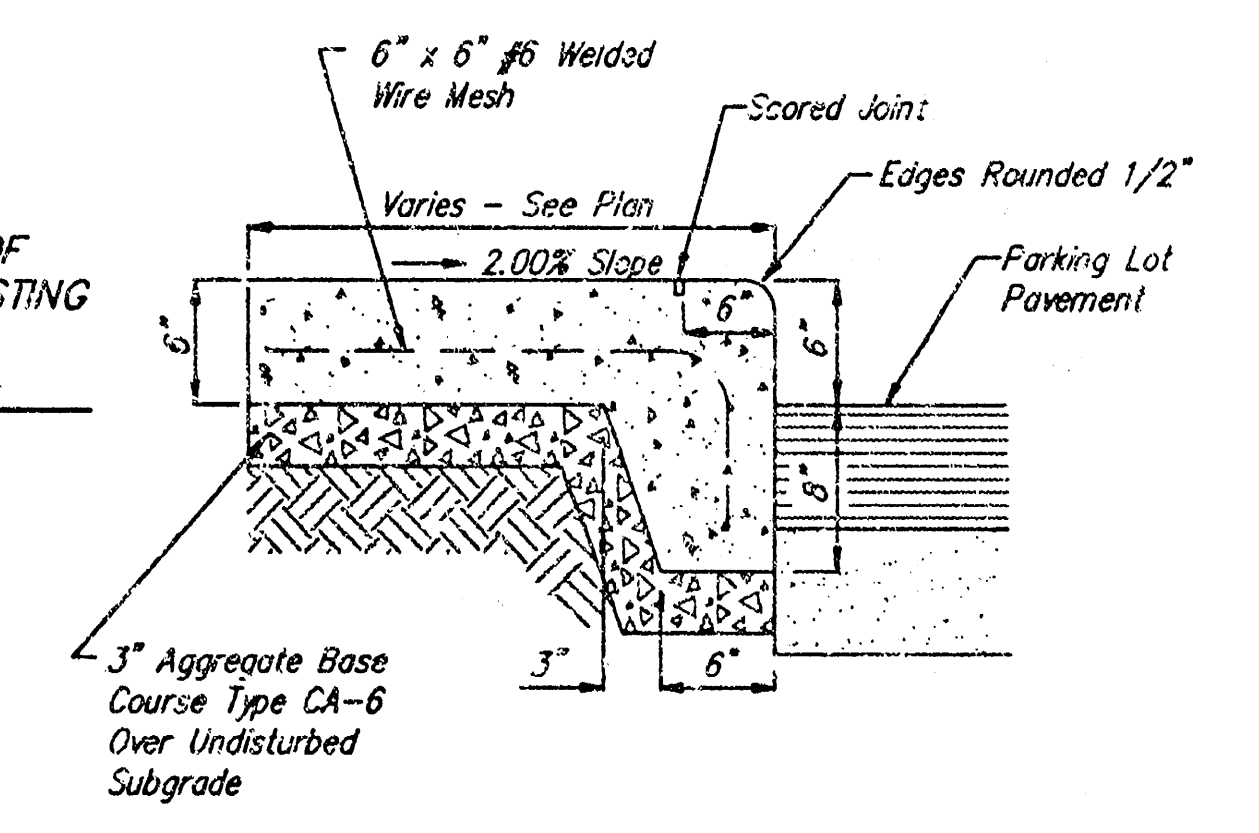

SIDEWALK CURB DETAILS
 NOT TO SCALE

CONSTRUCT 240± L.F. OF
 DITCH TO DRAIN TO EXISTING
 15" RCP END SECTION
 (SEE DETAILS BELOW)

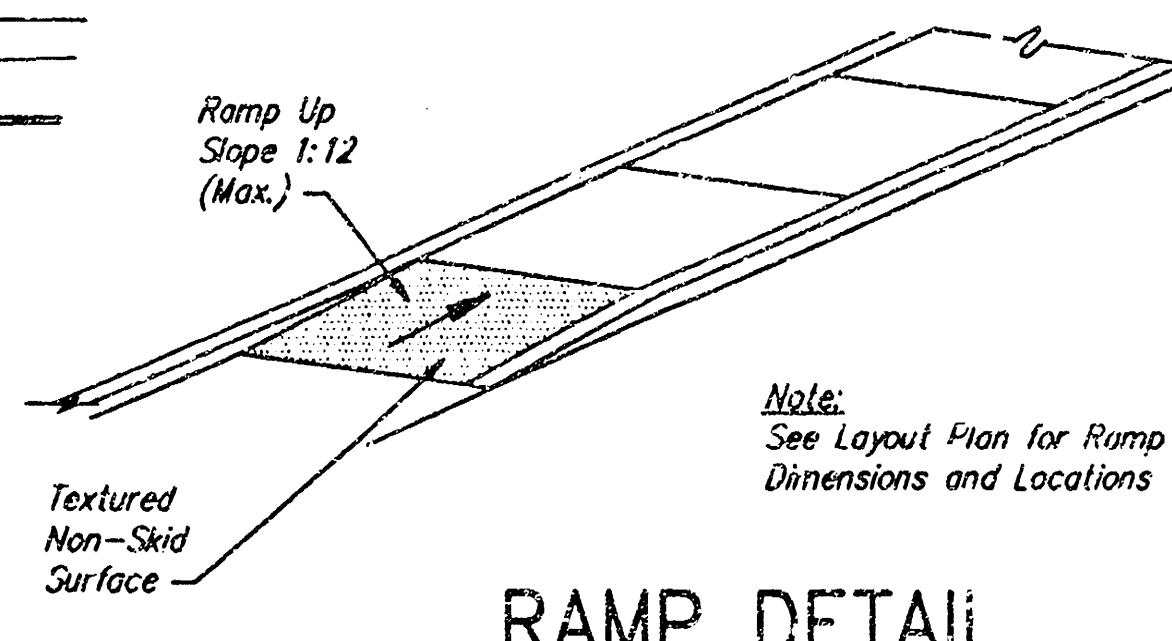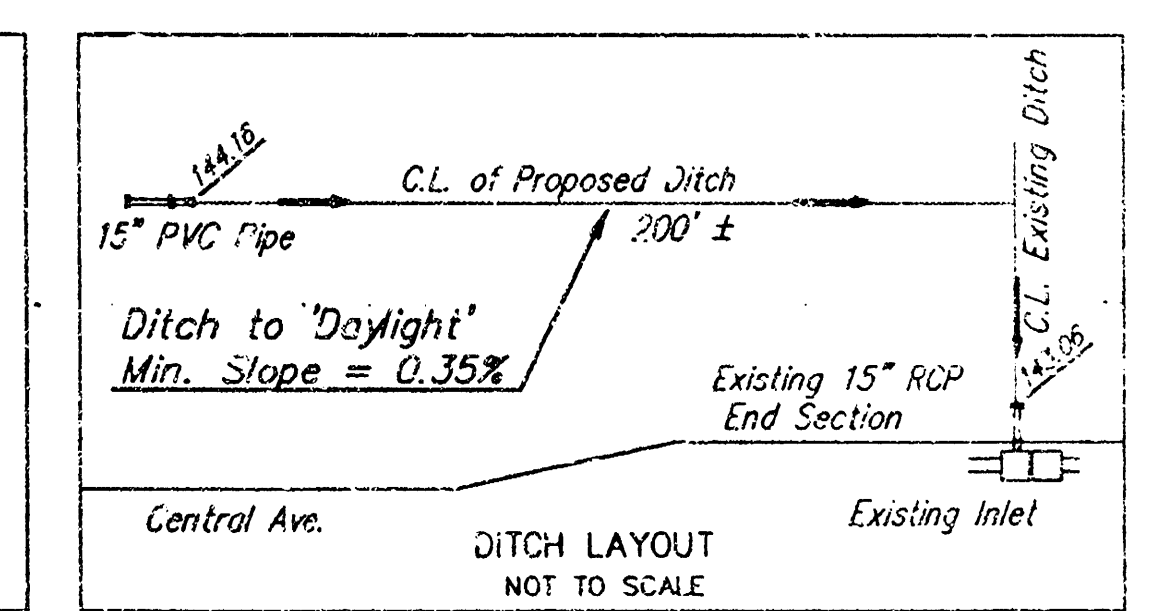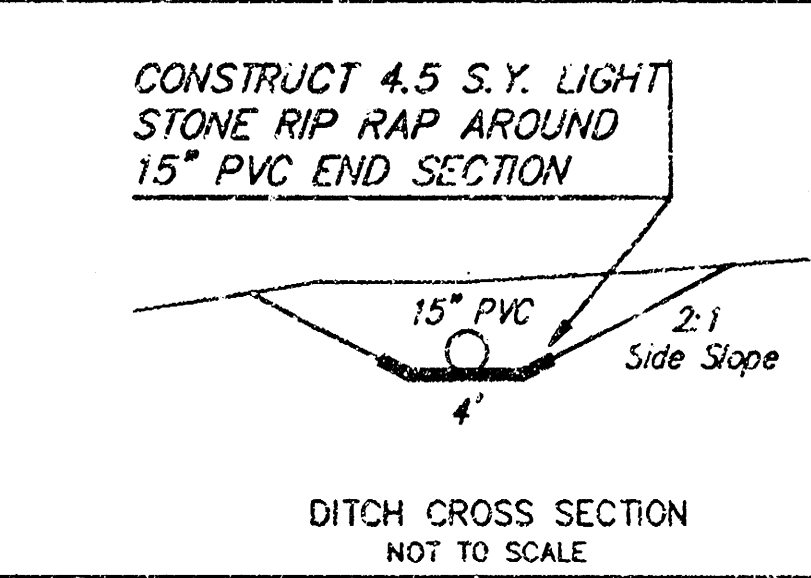

RAMP DETAIL
 NOT TO SCALE

At time the end section was
 install. But this project has been
 added on going to east now, it
 is a parking area for a business.



REVISED 8-14-95 PER CITY COMMENTS
 REVISED 8-23-95 FOR DRAINAGE

**HOLLYWOOD ENTERTAINMENT
 SITE GRADING
 PLAN**

BAUGHMAN COMPANY P.A.
 ENGINEERING, SURVEYING, & PLANNING
 318-292-7271 • 315 ELLIS • WICHITA, KANSAS 67211

PROJECT NUMBER
580 PPS (807881)

DESIGN NEW DRAWN MGC/HSP APPROVED DATE 7/19/95 SCALE 1"=20'