

DATE DRAWN

REVISIONS

10-17-95
Rev. Curb Entry Elevations
Rev. Curb & Storm Sewer Info

PRINTS ISSUED

JEFFREHBIEL
ASSOCIATES
ARCHITECTURE

100 E. LEWIS AVENUE, SUITE 200
WICHITA, KANSAS 67202
TEL: 264-4821 FAX: 264-4821

DATE

The Homestead
Assisted Living Residence
WICHITA, KANSAS

PROJECT NUMBER

9-49


SHEET TITLE

SITE GRADING PLAN


SHEET NUMBER

SG1.1

OF SHEETS

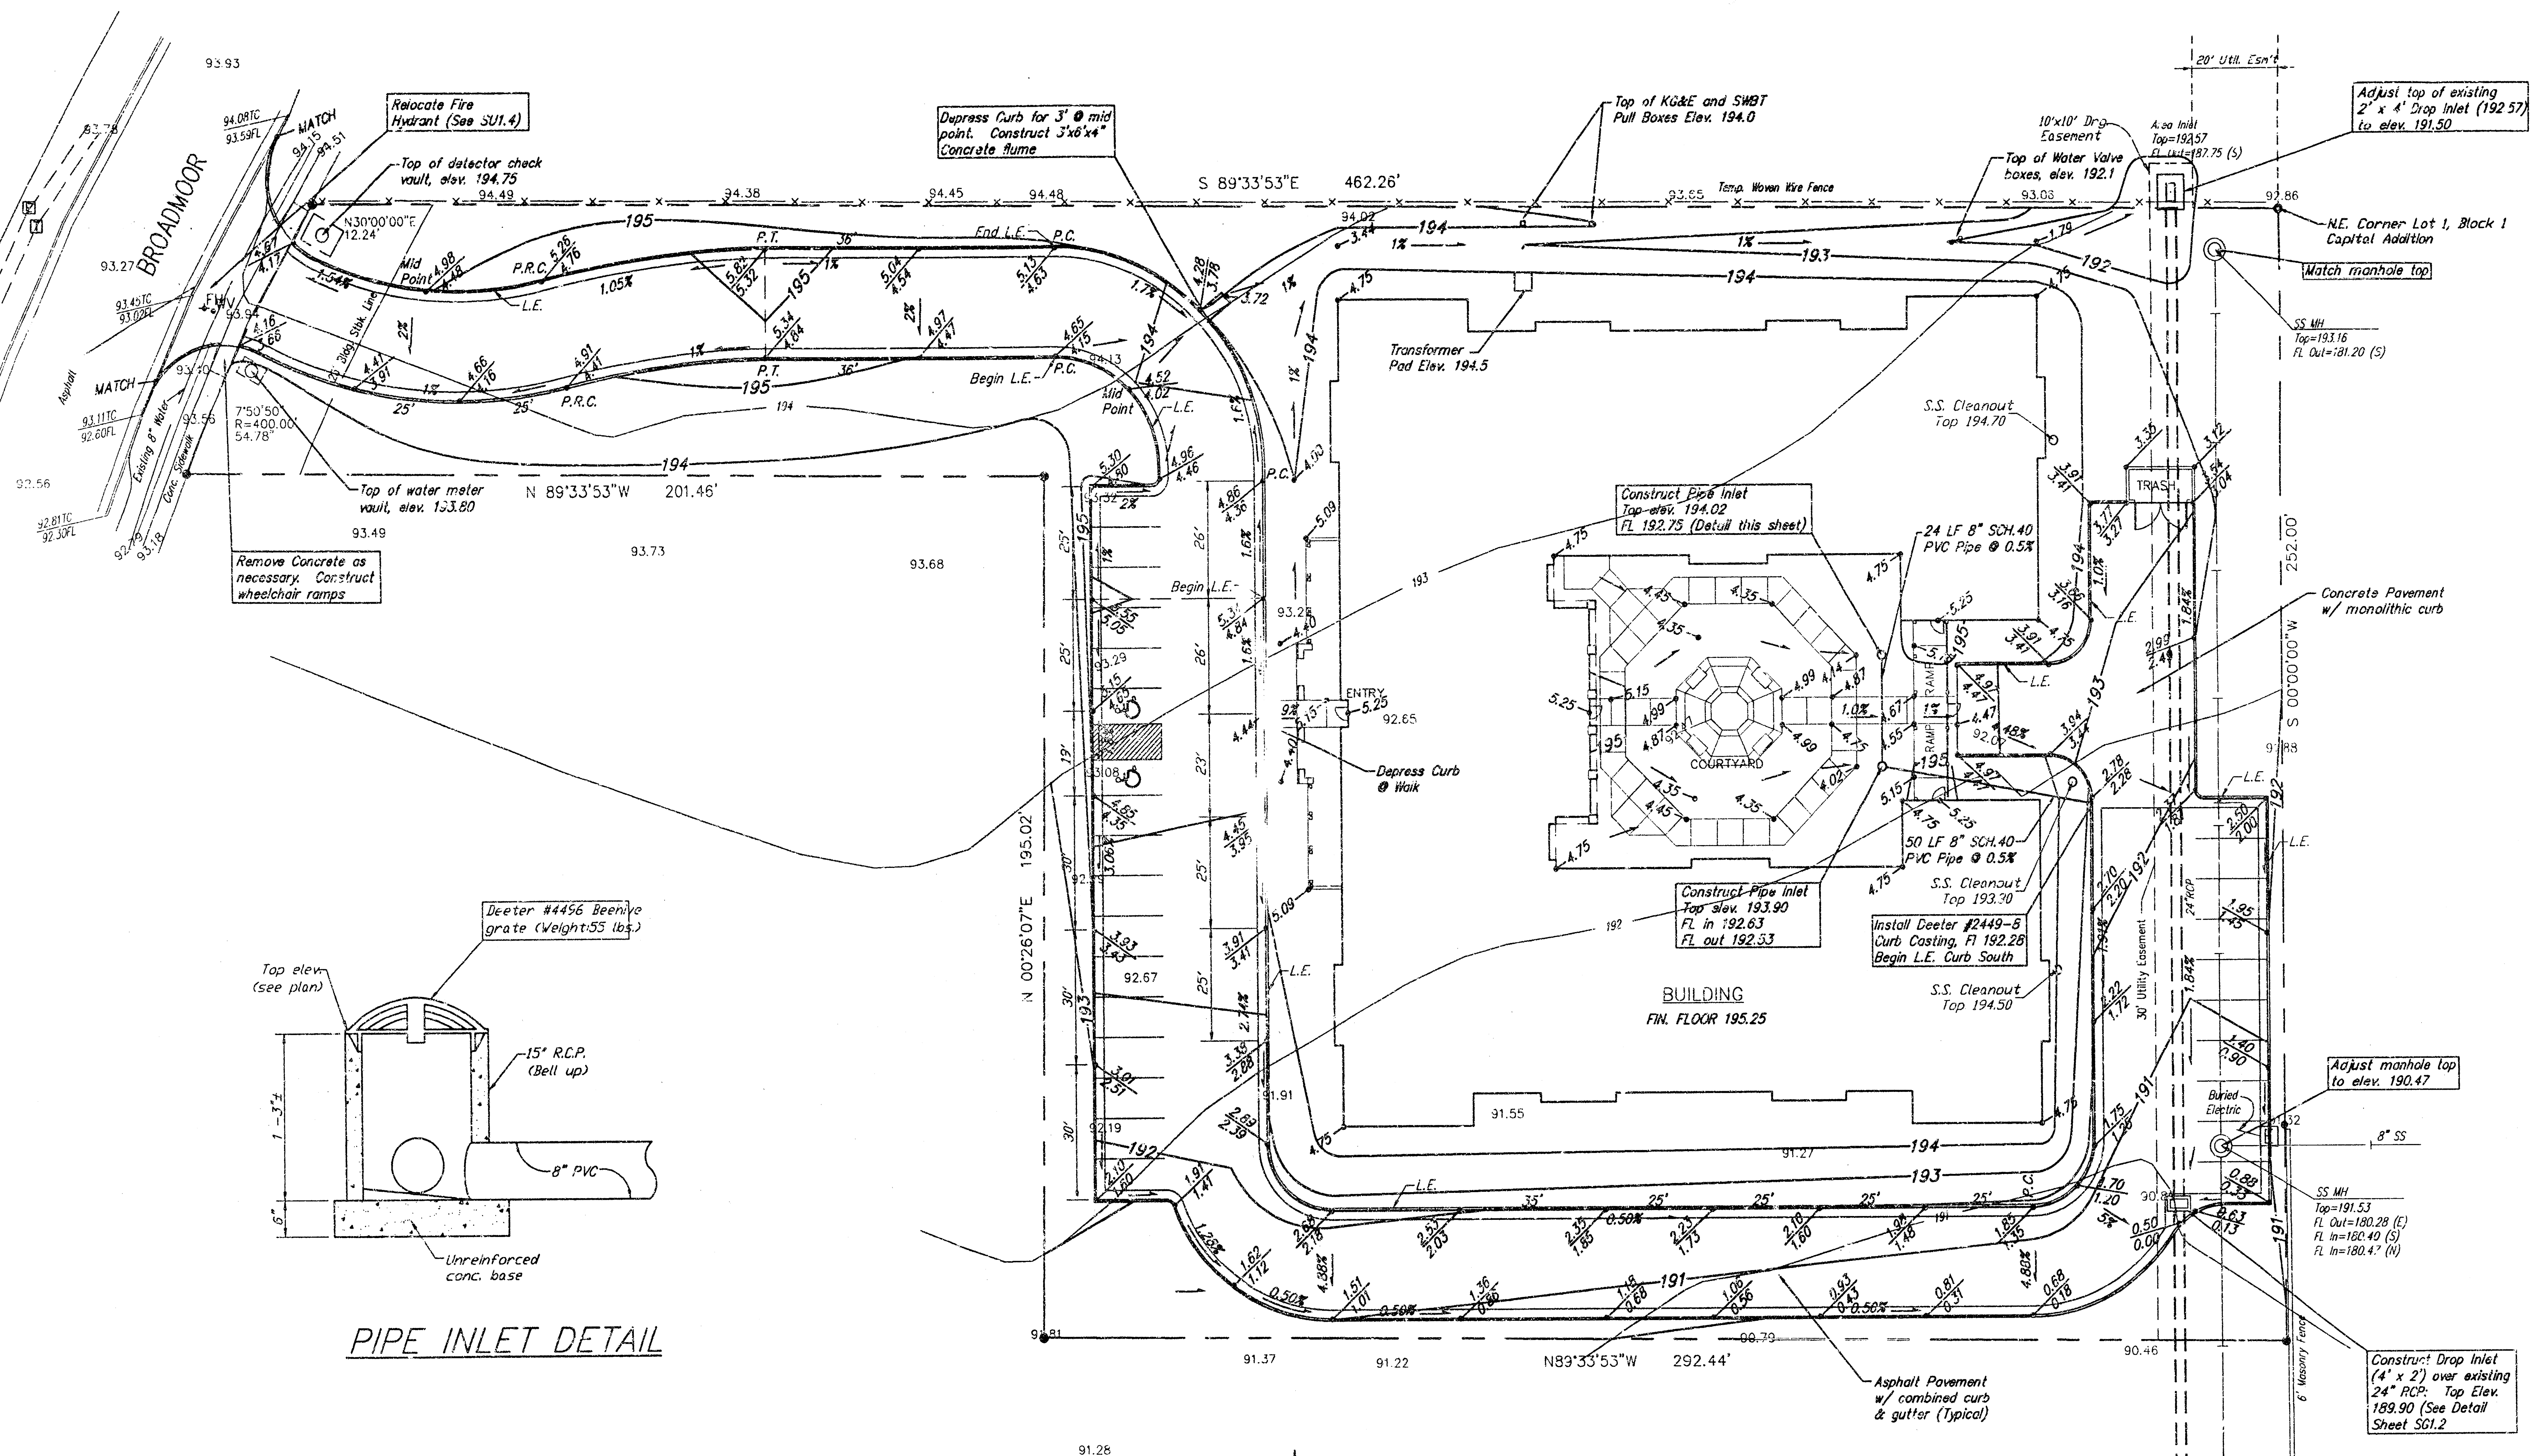

PIPE INLET DETAIL

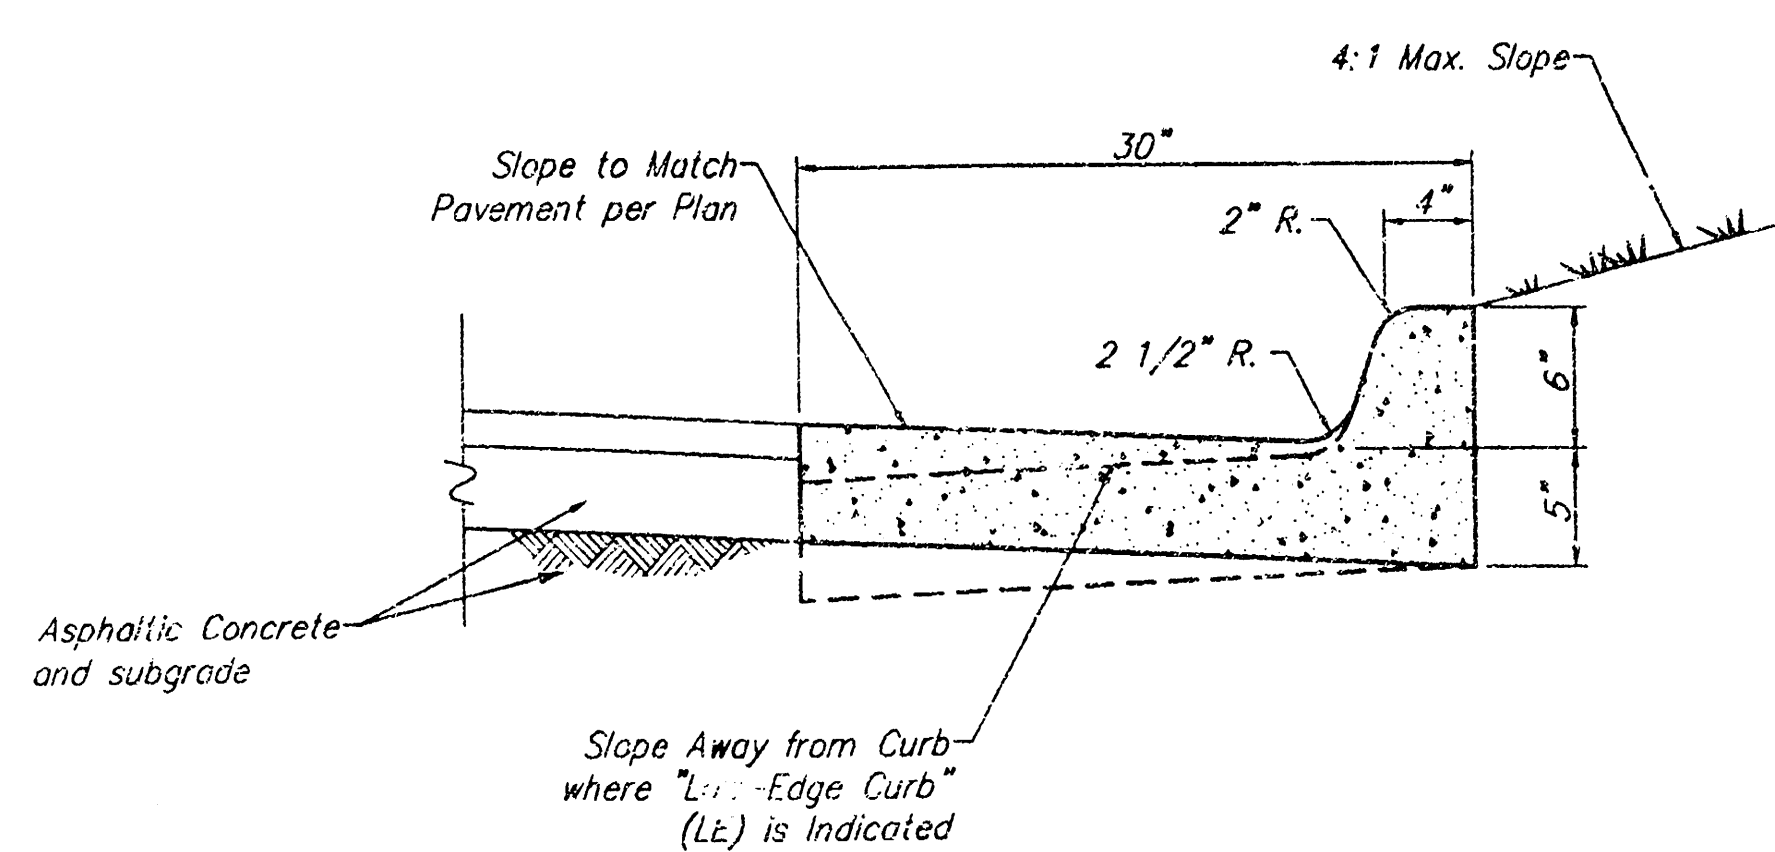

CURB & GUTTER DETAIL

Existing Contours

Finished Contours

Existing Elevations

Finished Grade Elev.

SCALE 1"=20'
Elev. = City Datum

SITE GRADING PLAN


BENCH MARK:

Chiseled "C" South end curb return West side of Rock Road at
East 1/4 Corner Sec. 19, T2S, R2E Elev. 179.18 City Datum

LEGAL DESCRIPTION:

Part of Lots 1 and 2, Block 1, Capital Addition to Wichita, Sedgwick County, Kansas.

NOTE: All storm sewer construction on this project within public easement shall be constructed and inspected in conformance with "City of Wichita Procedure for Construction of Public Works Improvements by Private Contract."

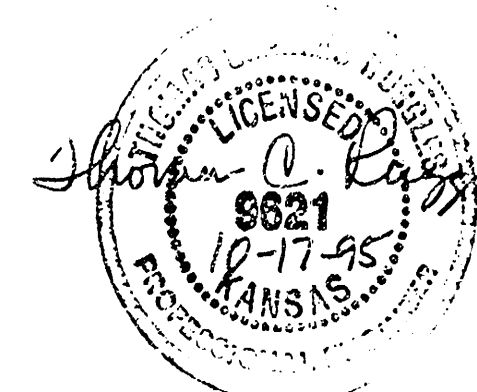

SRB 924 NORTH MAIN 316-264-8008
WICHITA, KANSAS 67203 FAX 264-4821
SAVOY, RUGGLES & BOHM, P.A.
ENGINEERING & SURVEYING

Project #593 PPS (607861)



APPROVED AS NOTED
BY CITY ENGINEER OF WICHITA

Sanitary Sewers
Storm Sewers VRH 10/18/95
Driveway Approaches
Water Mains
Parking

NOTE TO CONTRACTORS


Inspection and testing for this project are to be provided by a Licensed Consulting Engineering Firm under contract with the Owner/Developer. Said inspection to be in accordance with the City of Wichita standard construction engineering practices and certified by a Licensed Professional Engineer. No work shall be performed in dedicated easements or public right-of-way by the Contractor without such inspection, nor shall any work be commenced without written authorization by the City Engineer.

C:\PROJECTS\ACTIVE\151\DWG\151-1.dwg 10/27/2005 10:05:10


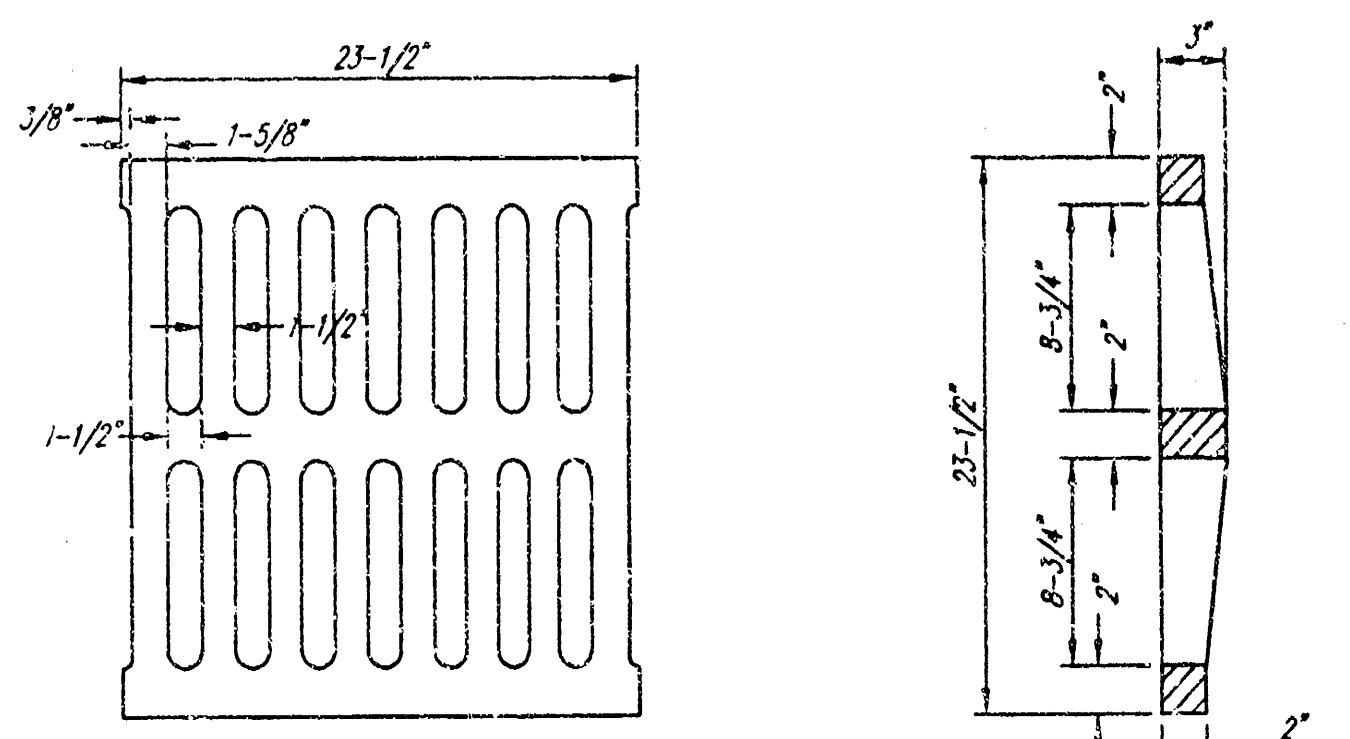
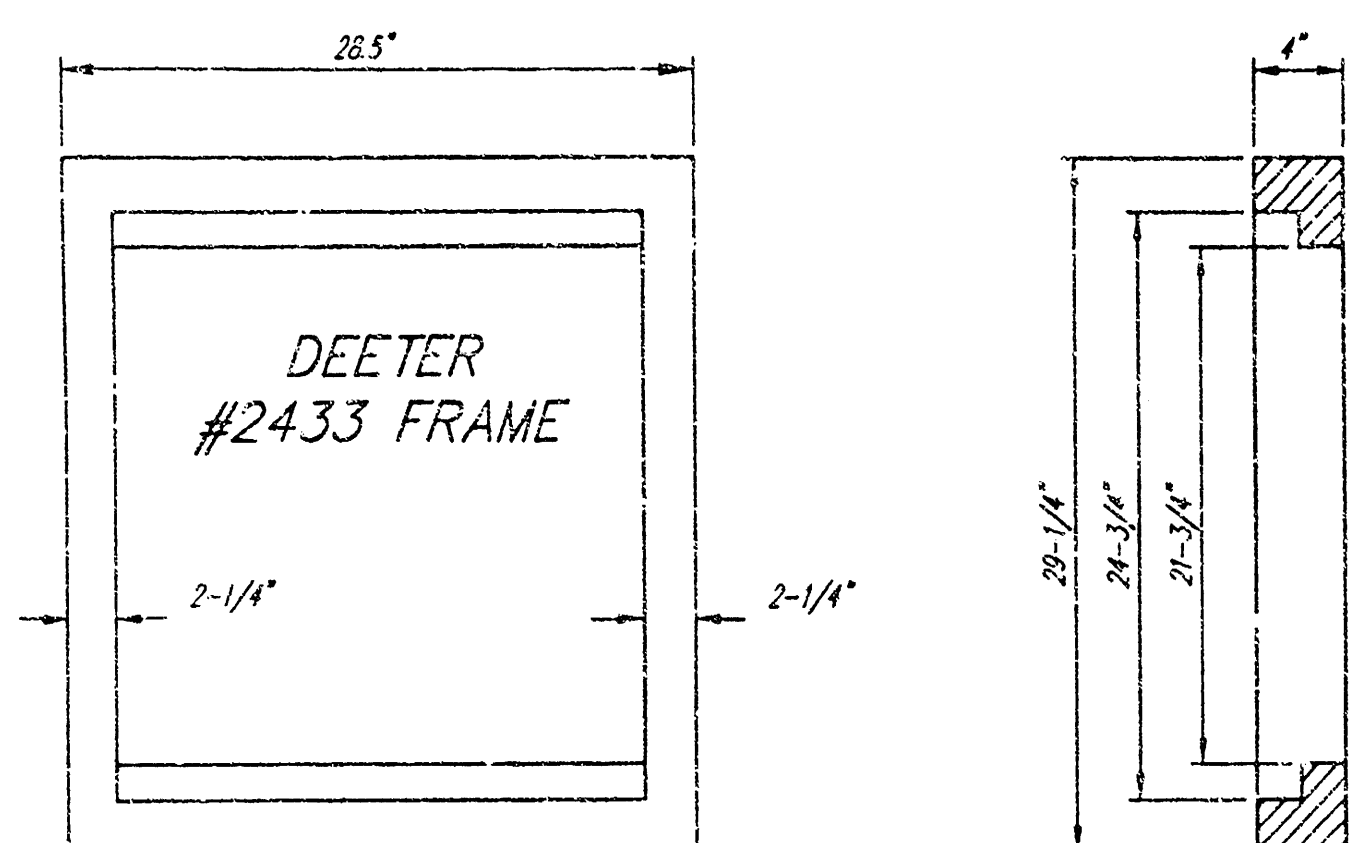


DEETER #2433 GRATE

24" x 24" Frame and Grate Detail

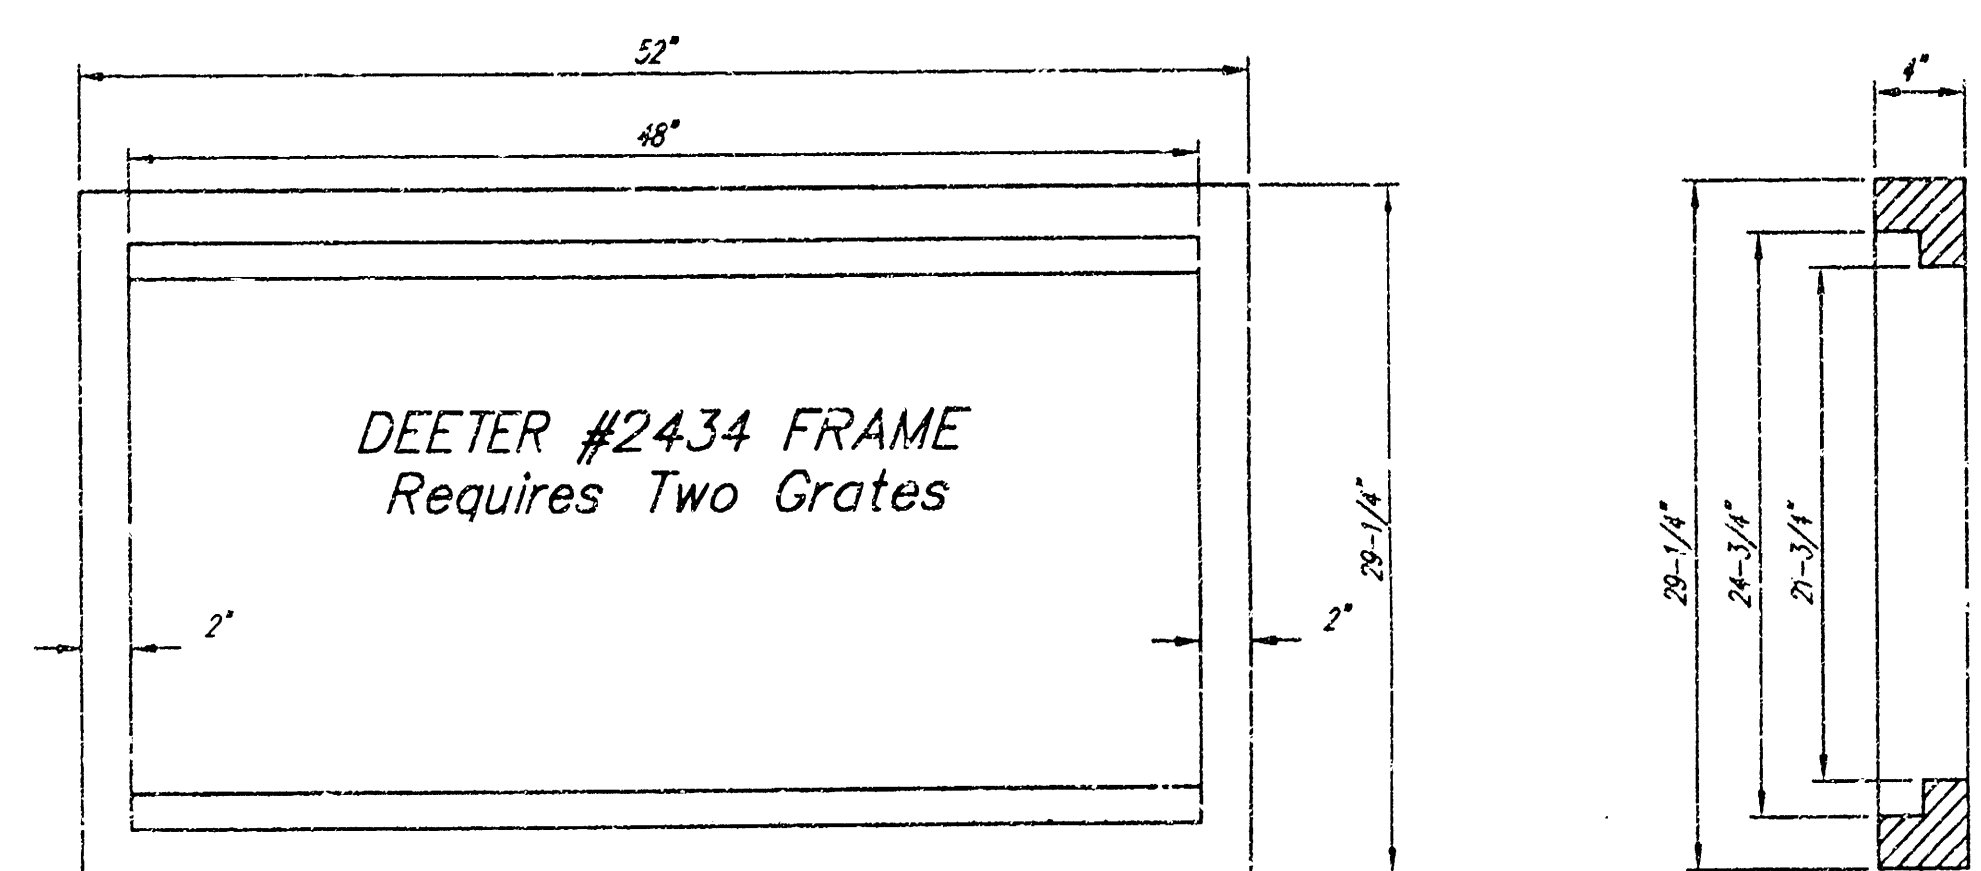

Double 24" x 24" Frame Detail

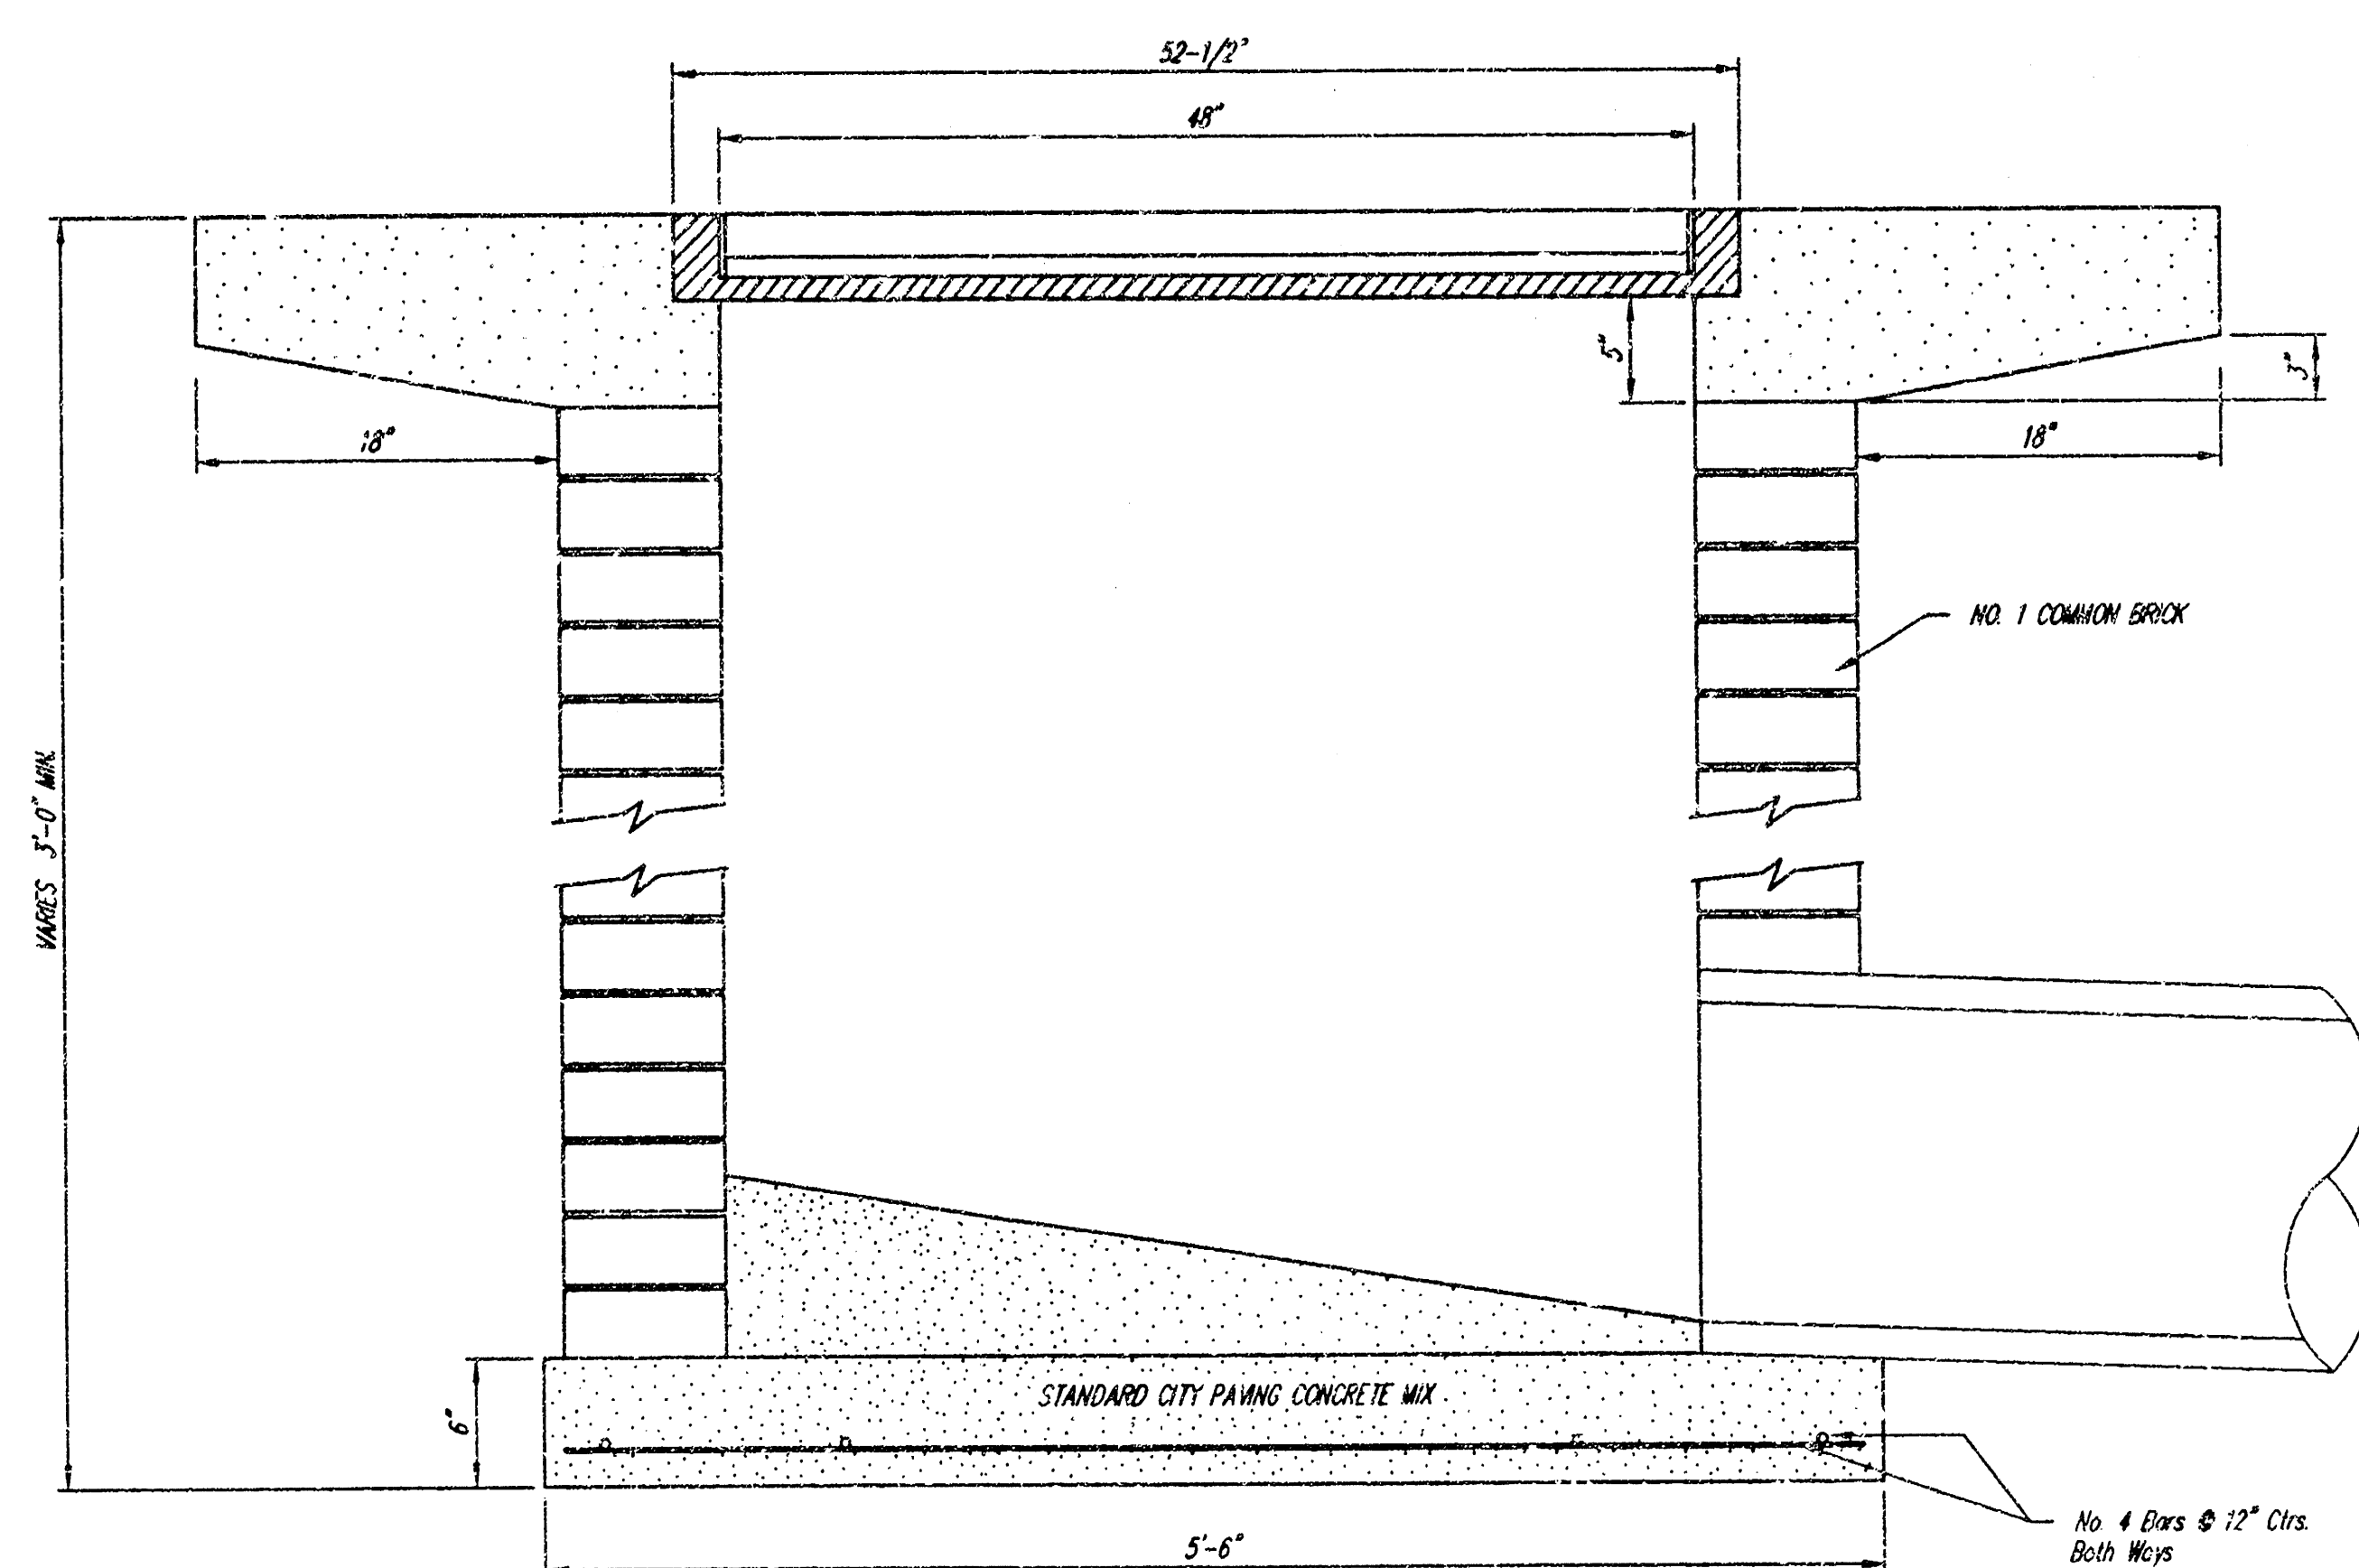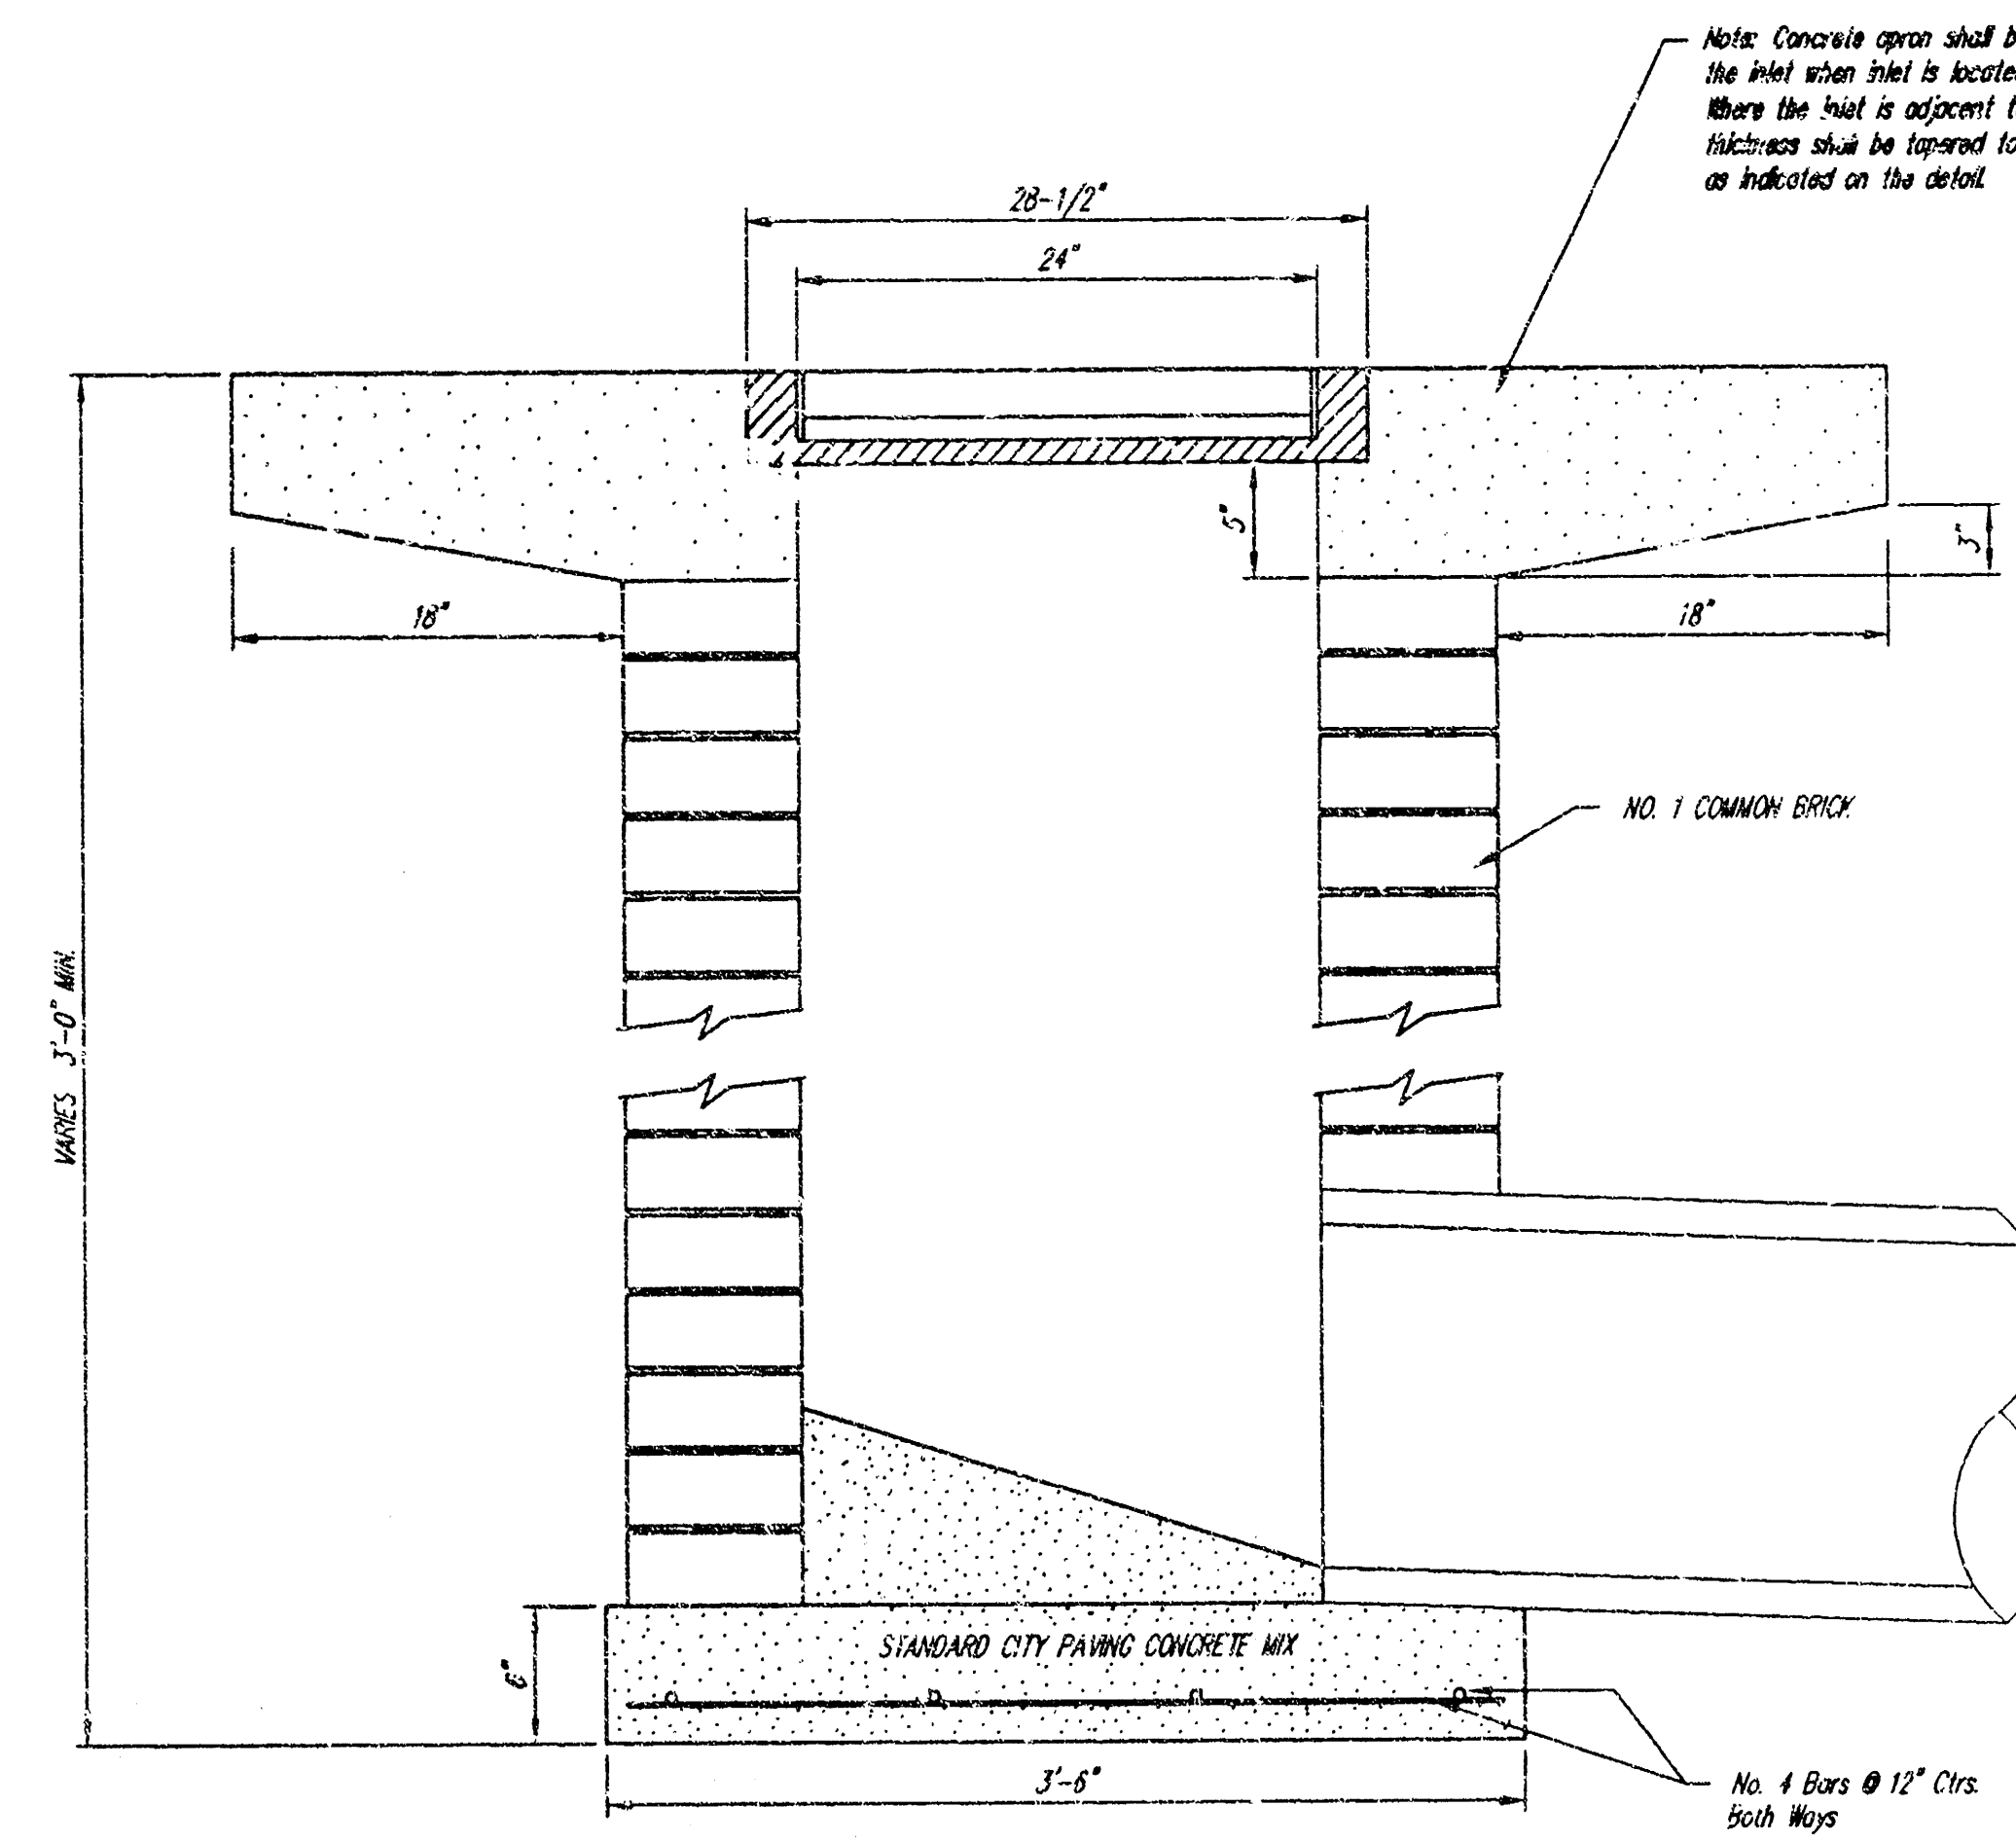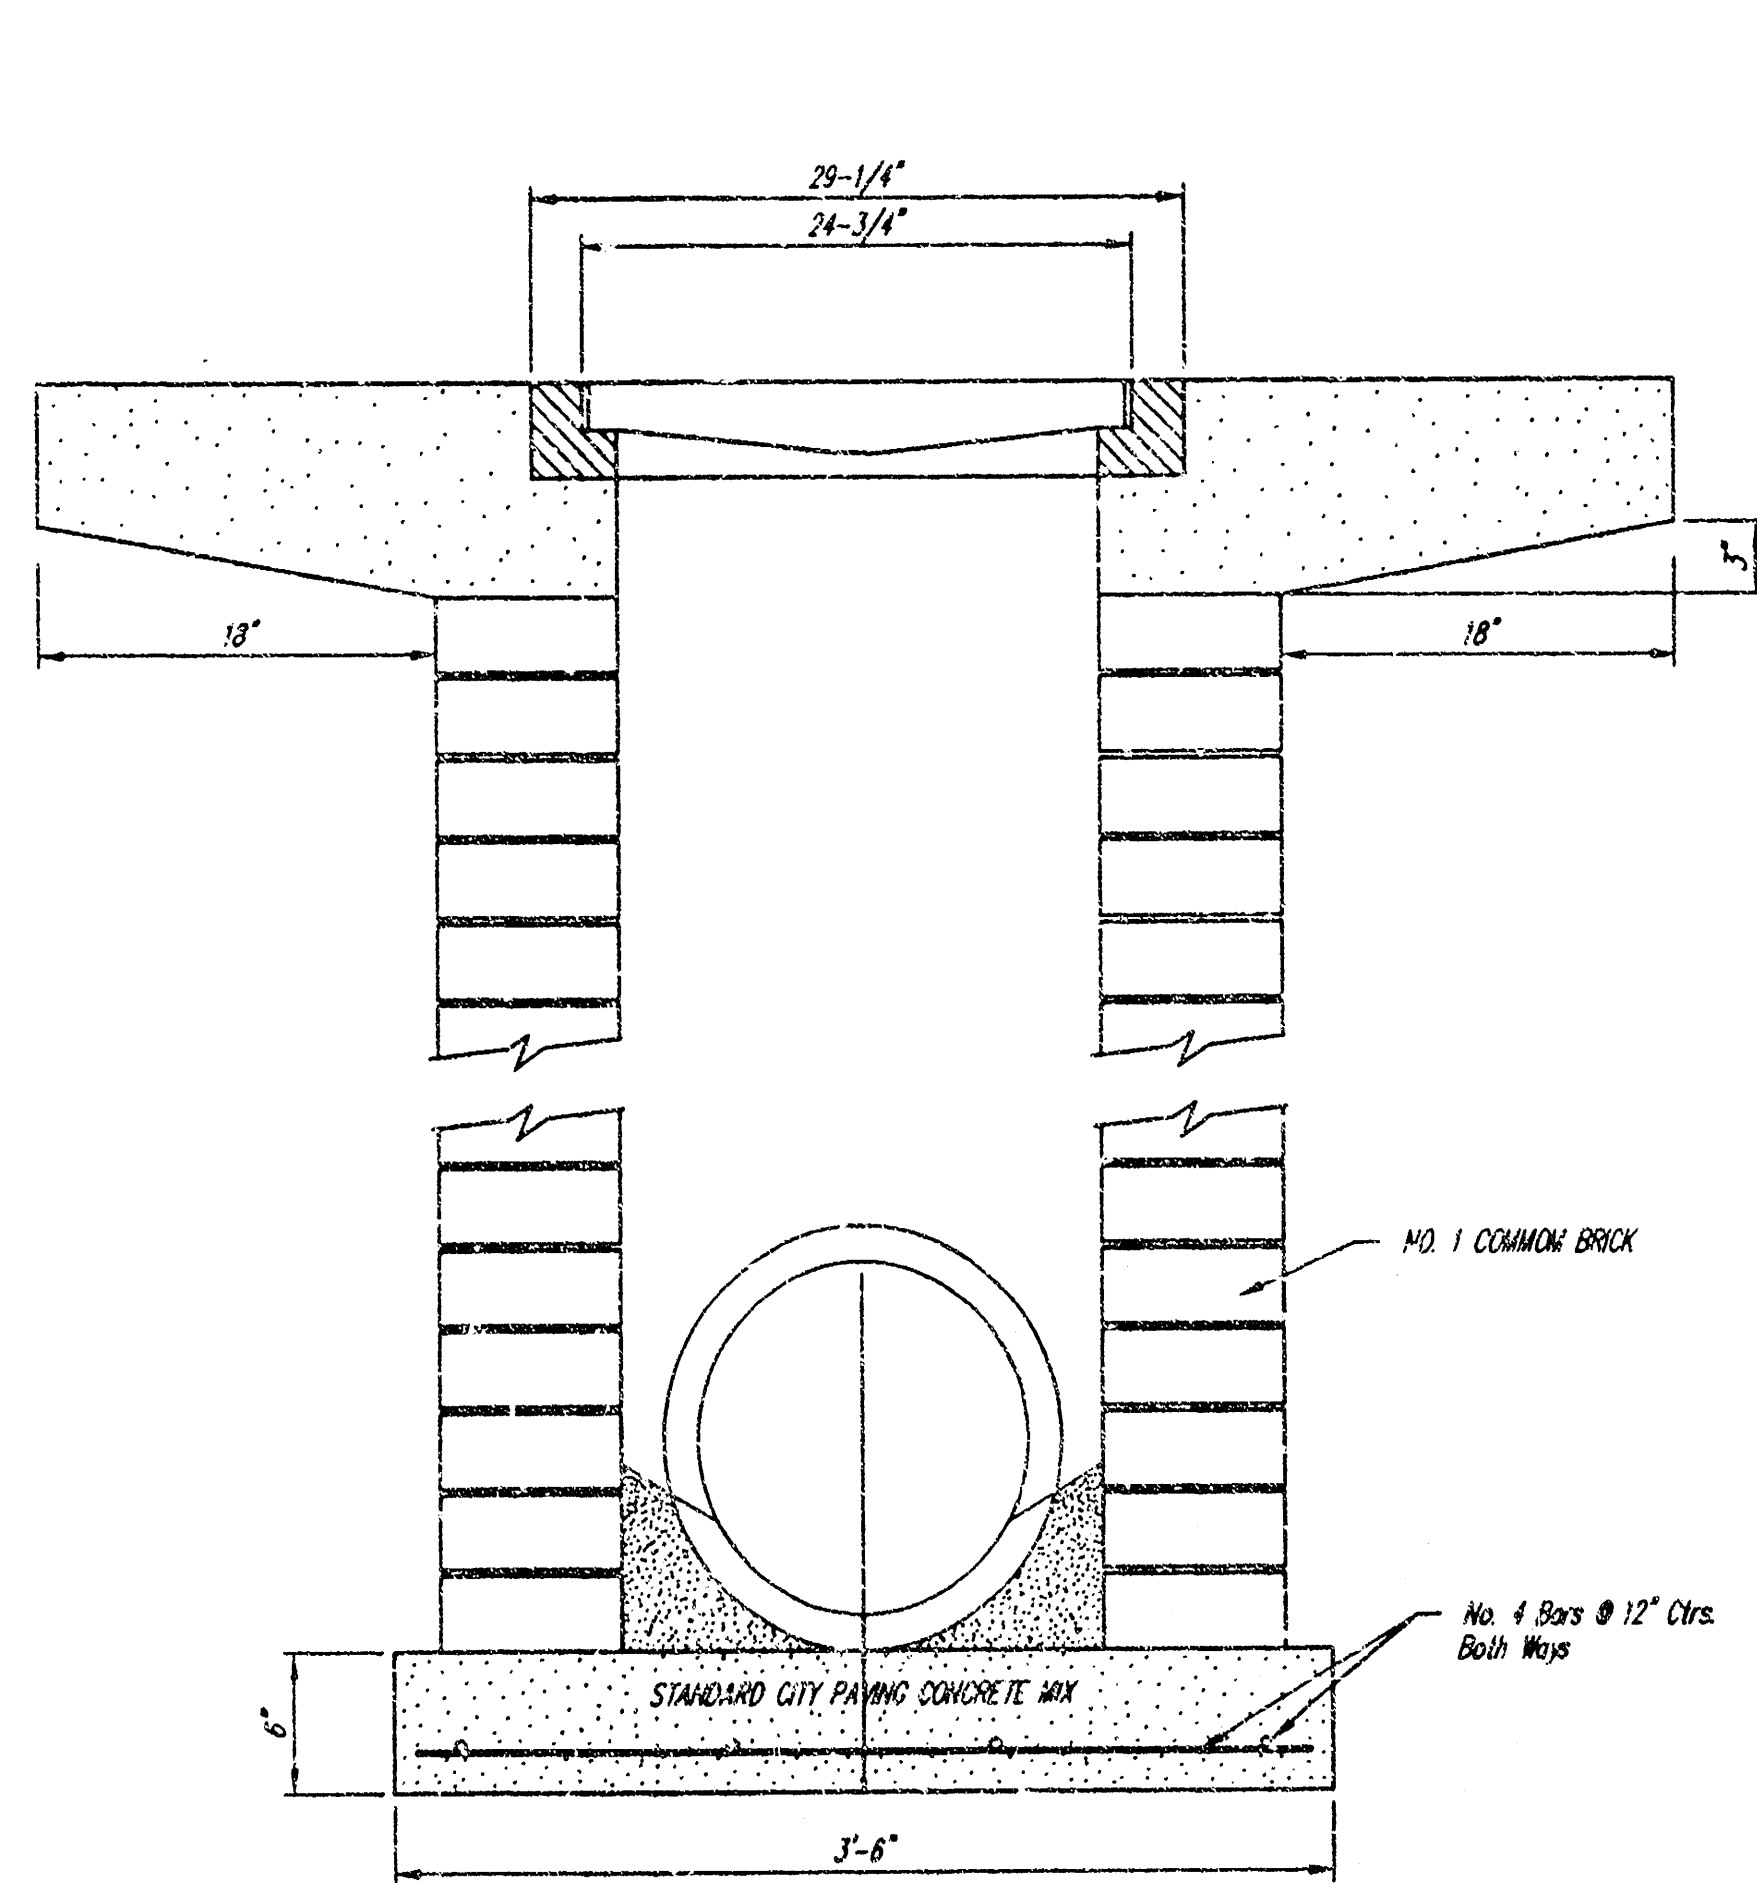

Project #593 PPS (607861)

SRB 924 NORTH MAIN 316-264-8005
WICHITA, KANSAS 67203 FAX 264-4821

SAVOY, RUGGLES & BOHM, P.A.
ENGINEERING & SURVEYING

DATE DRAWN
REVISIONS

PRINTS ISSUED

DATE

PROJECT NUMBER
94149

SHEET TITLE
DROP INLET DETAILS

SHEET NUMBER

SG1.2

OF SHEETS

JEFF KREHBIEL
ARCHITECTURE
100 E. USHWAY AVENUE, SUITE 100
WICHITA, KANSAS 67203
316-264-8005 FAX 316-264-8006

The Homestead
Assisted Living Residence
WICHITA, KANSAS

3-4-1-41