



299 484

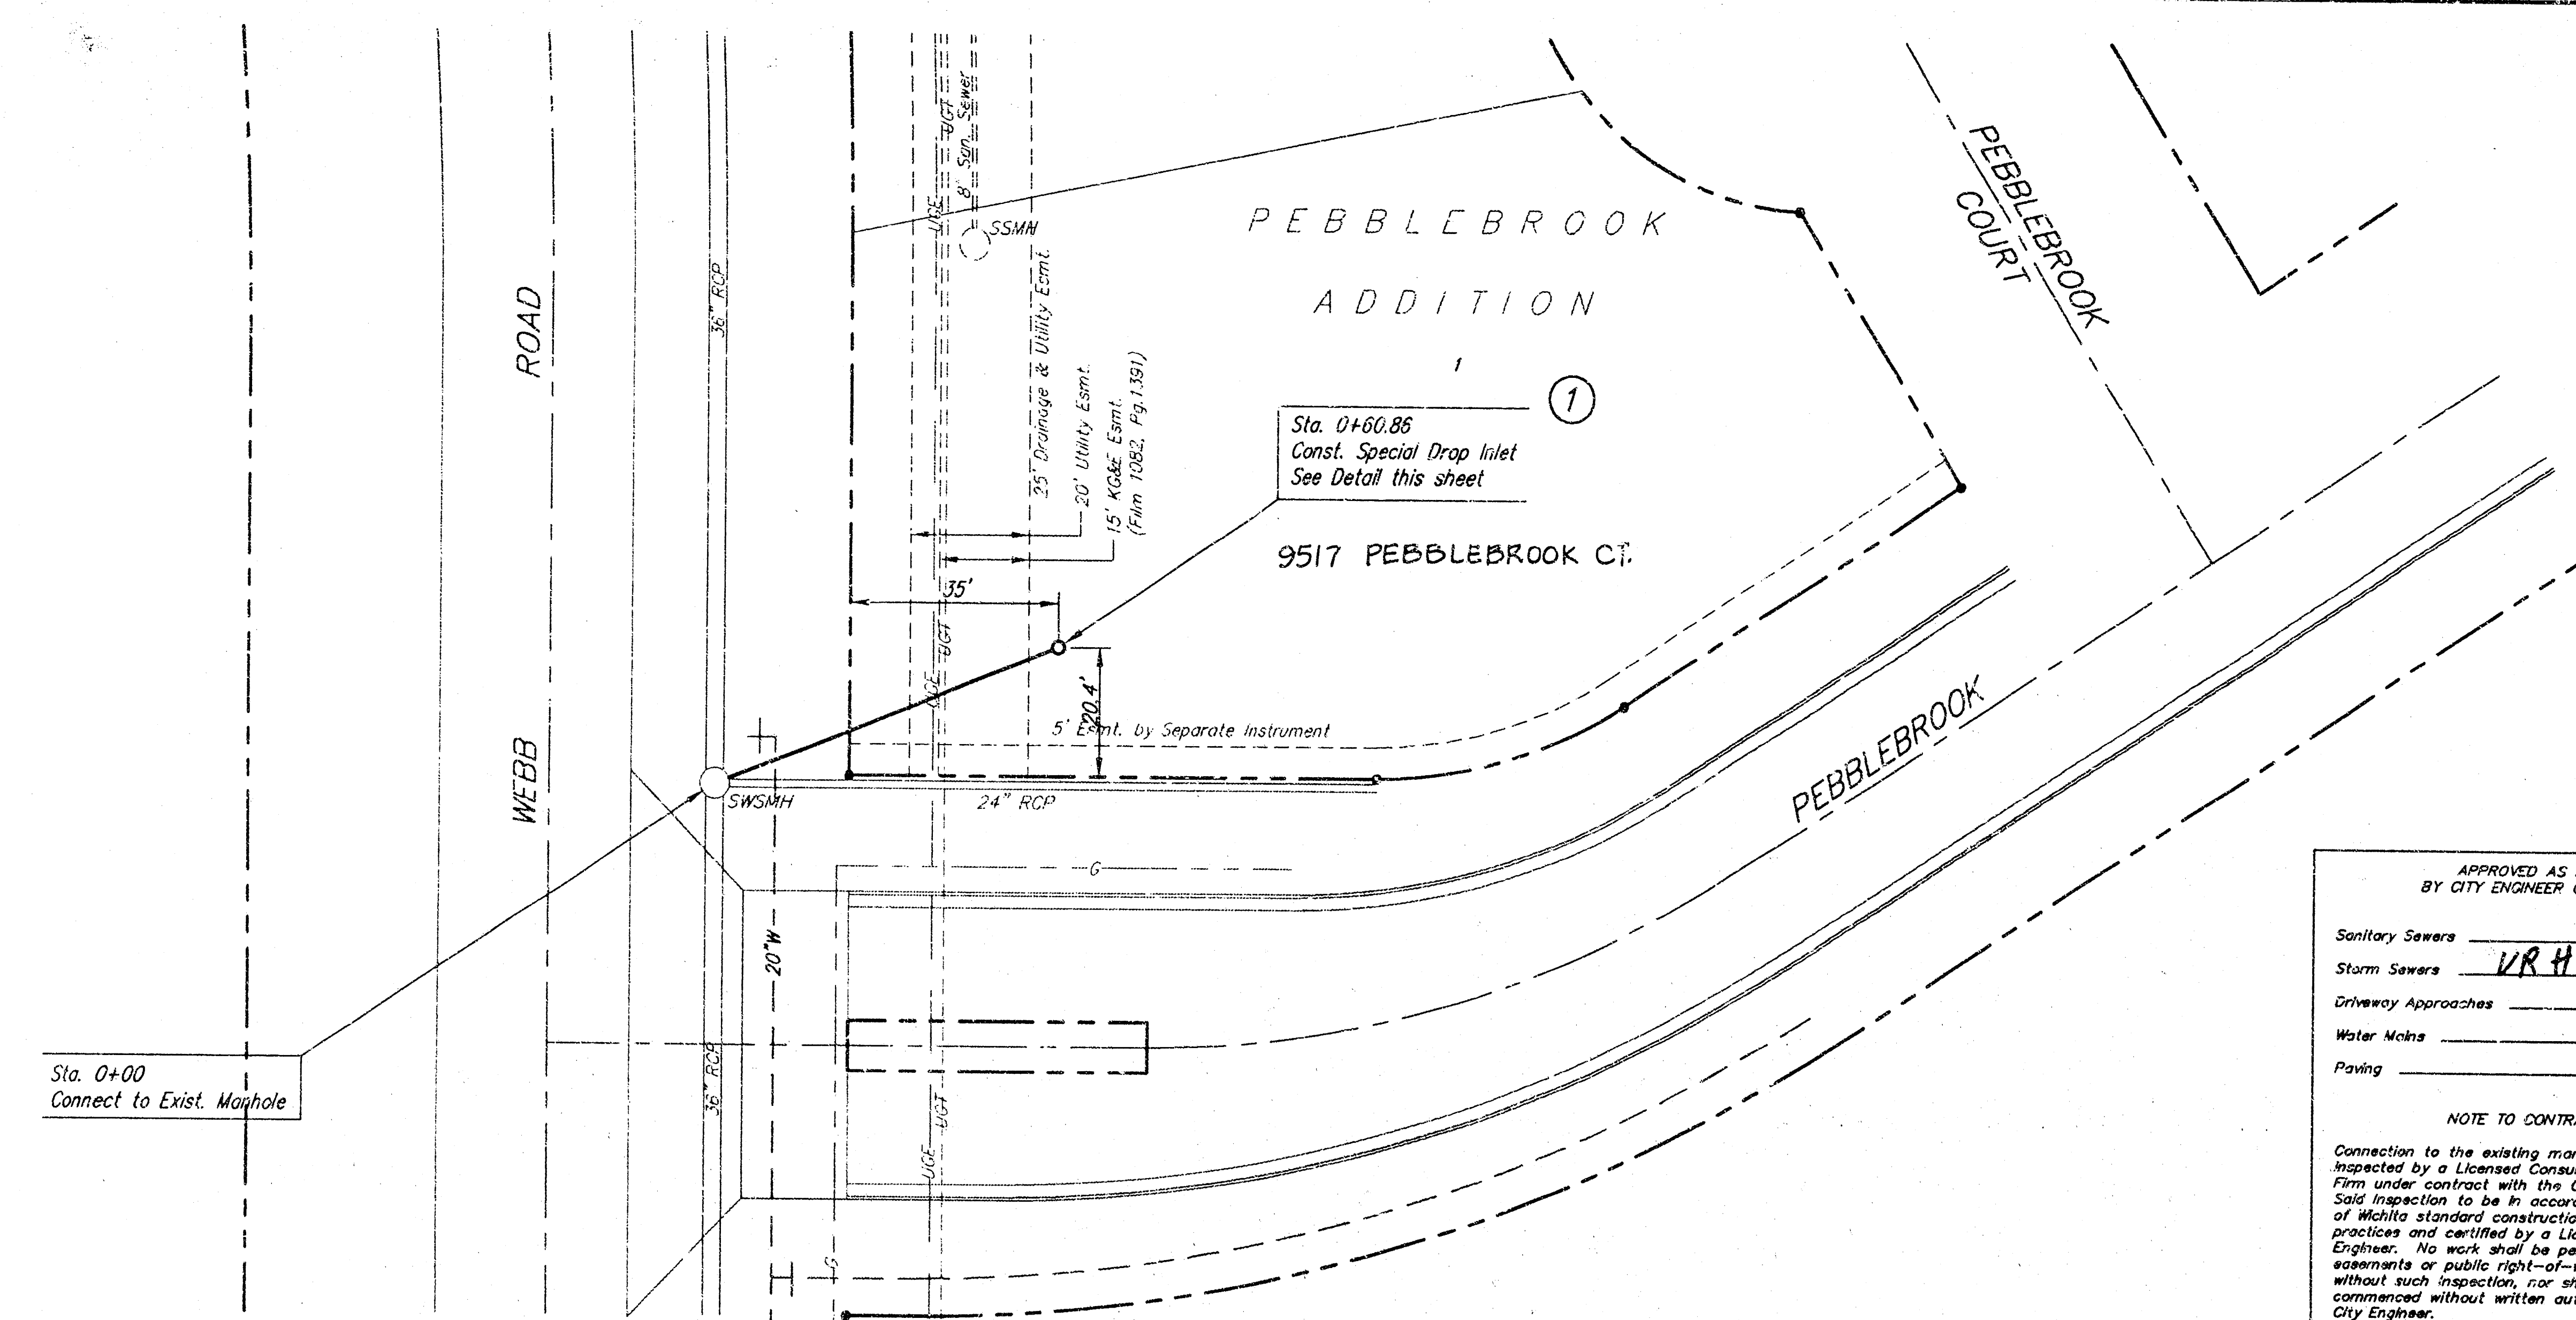

SRB


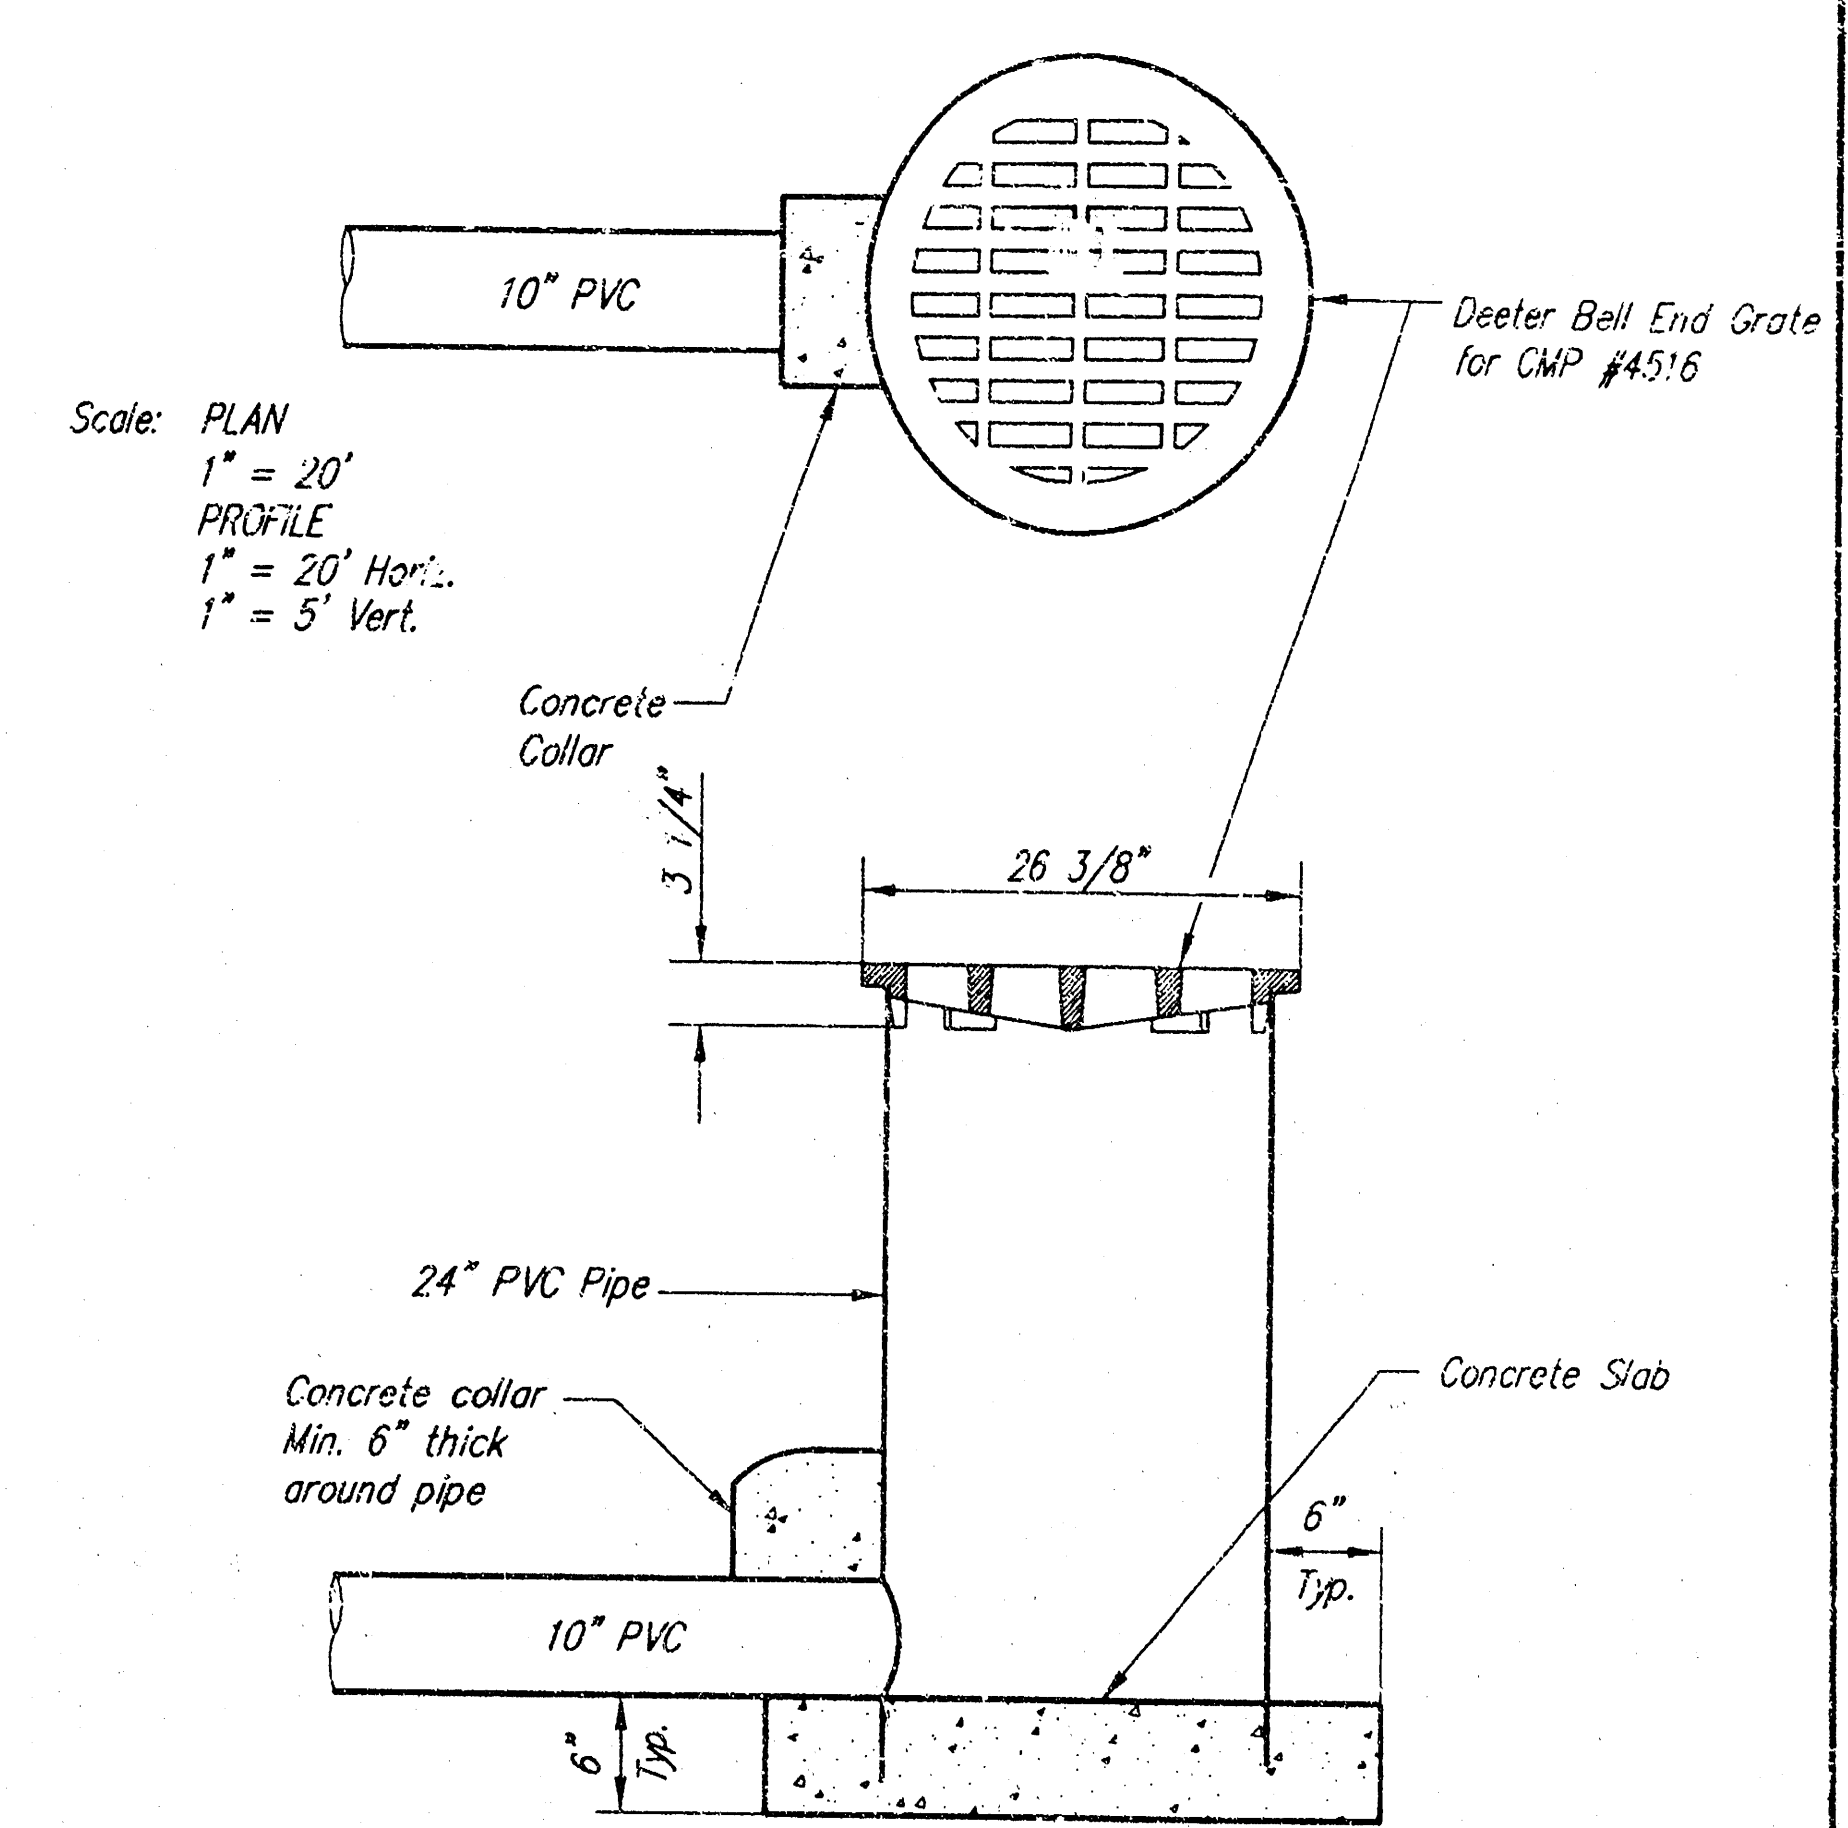


SPECIAL DROP INLET DETAIL


APPROVED AS NOTED
BY CITY ENGINEER OF WICHITA

Sanitary Sewers _____
Storm Sewers VRH 1/12/94
Driveway Approaches _____
Water Mains _____
Paving _____

NOTE TO CONTRACTORS
Connection to the existing manhole is to be inspected by a Licensed Consulting Engineering Firm under contract with the Owner/Developer. Said inspection to be in accordance with the City of Wichita standard construction engineering practices and certified by a Licensed Professional Engineer. No work shall be performed in dedicated easements or public right-of-way by the Contractor without such inspection, nor shall any work be commenced without written authorization by the City Engineer.

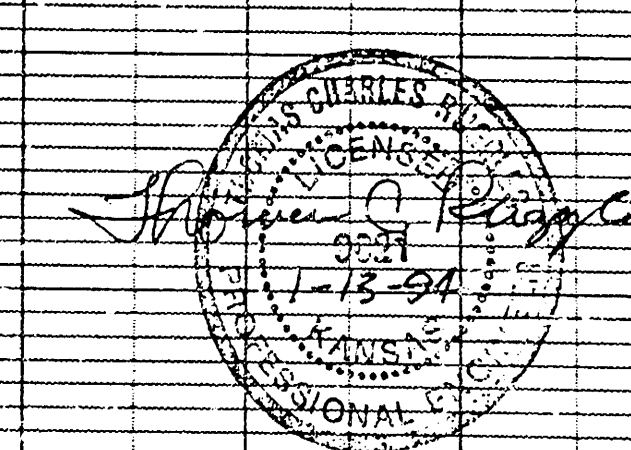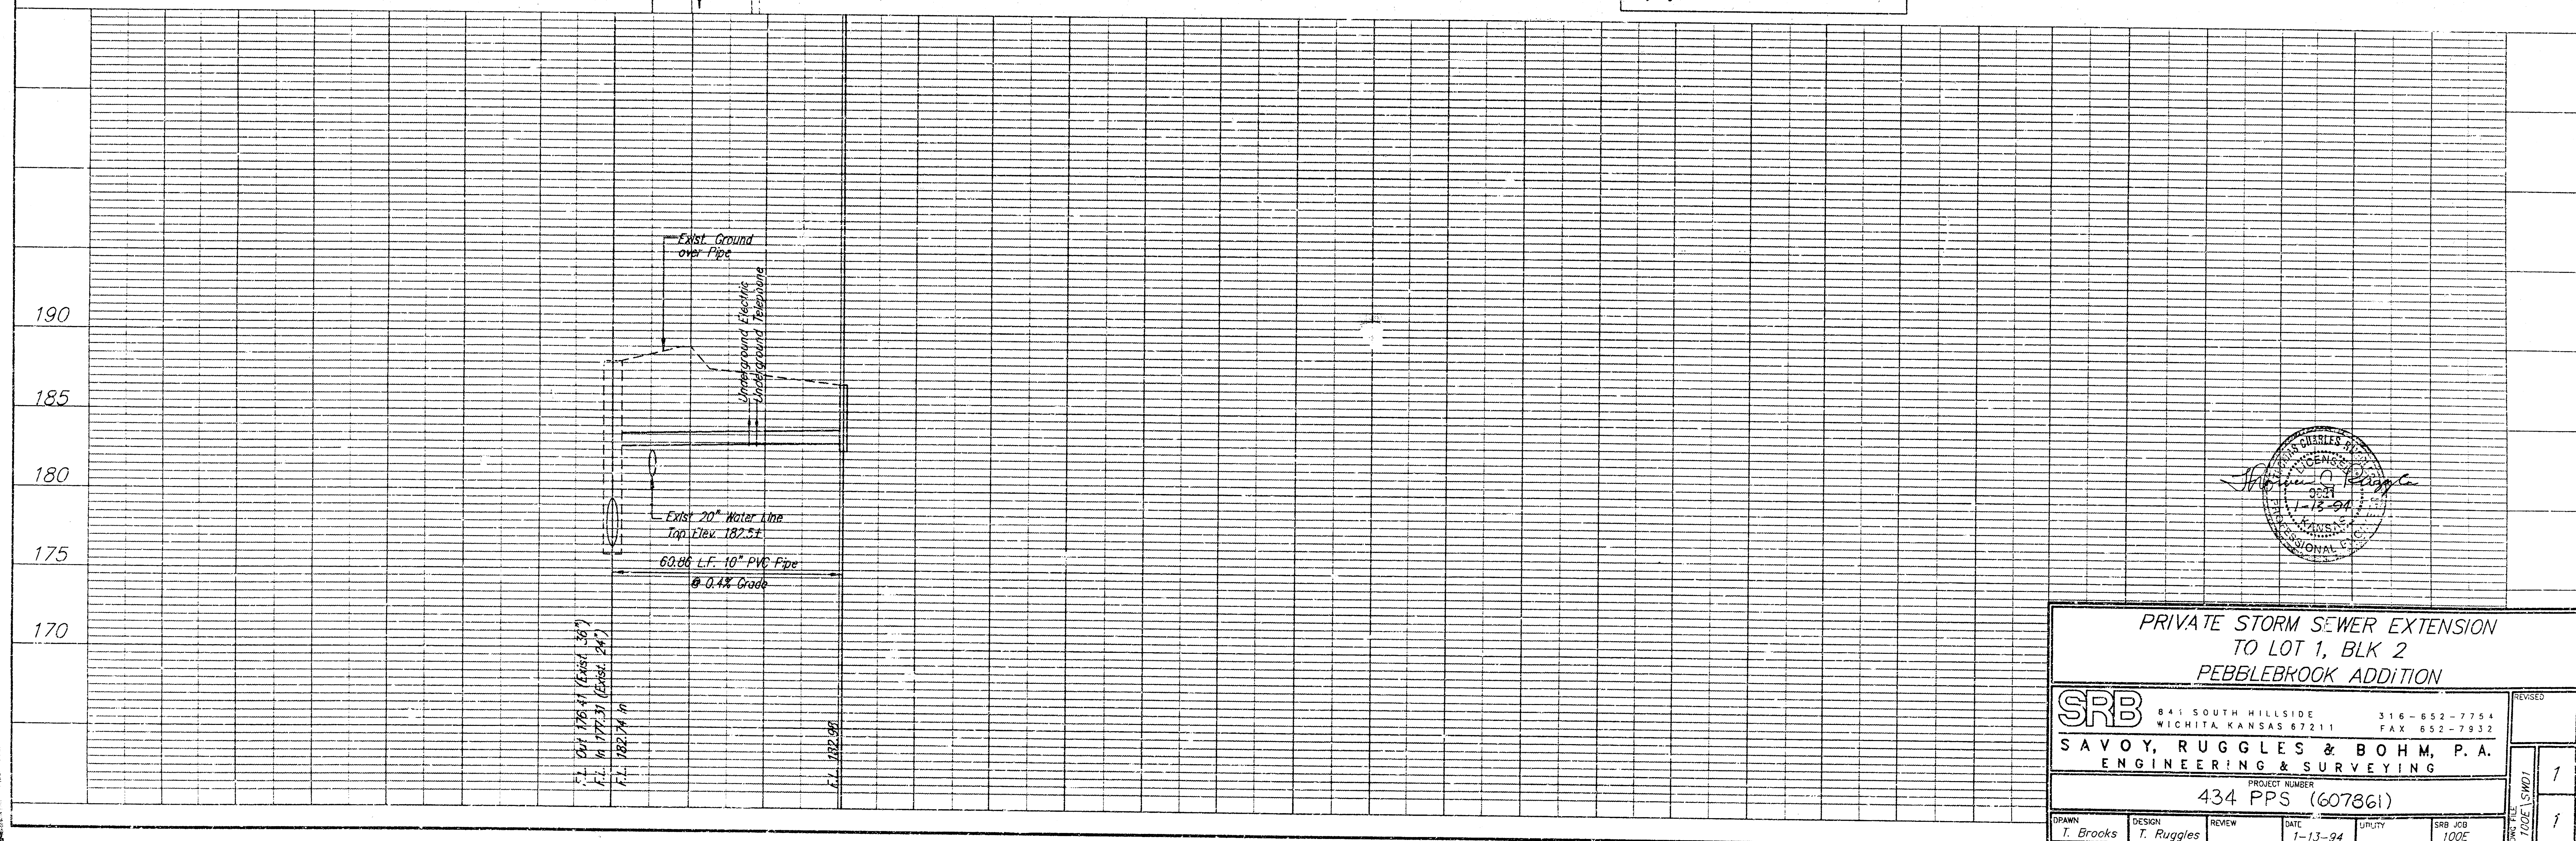

PRIVATE STORM SEWER EXTENSION TO LOT 1, BLK 2 PEBBLEBROOK ADDITION			
SRB 841 SOUTH HILLSIDE WICHITA, KANSAS 67211 318-632-7754 FAX 632-7932			
SAVOY, RUGGLES & BOHM, P.A. ENGINEERING & SURVEYING			
PROJECT NUMBER 434 PPS (607861)			
DRAWN T. Brooks	DESIGN T. Ruggles	REVIEW T. Ruggles	DATE 1-13-94
SRB JOB 100E		REVISIONS 1 1	


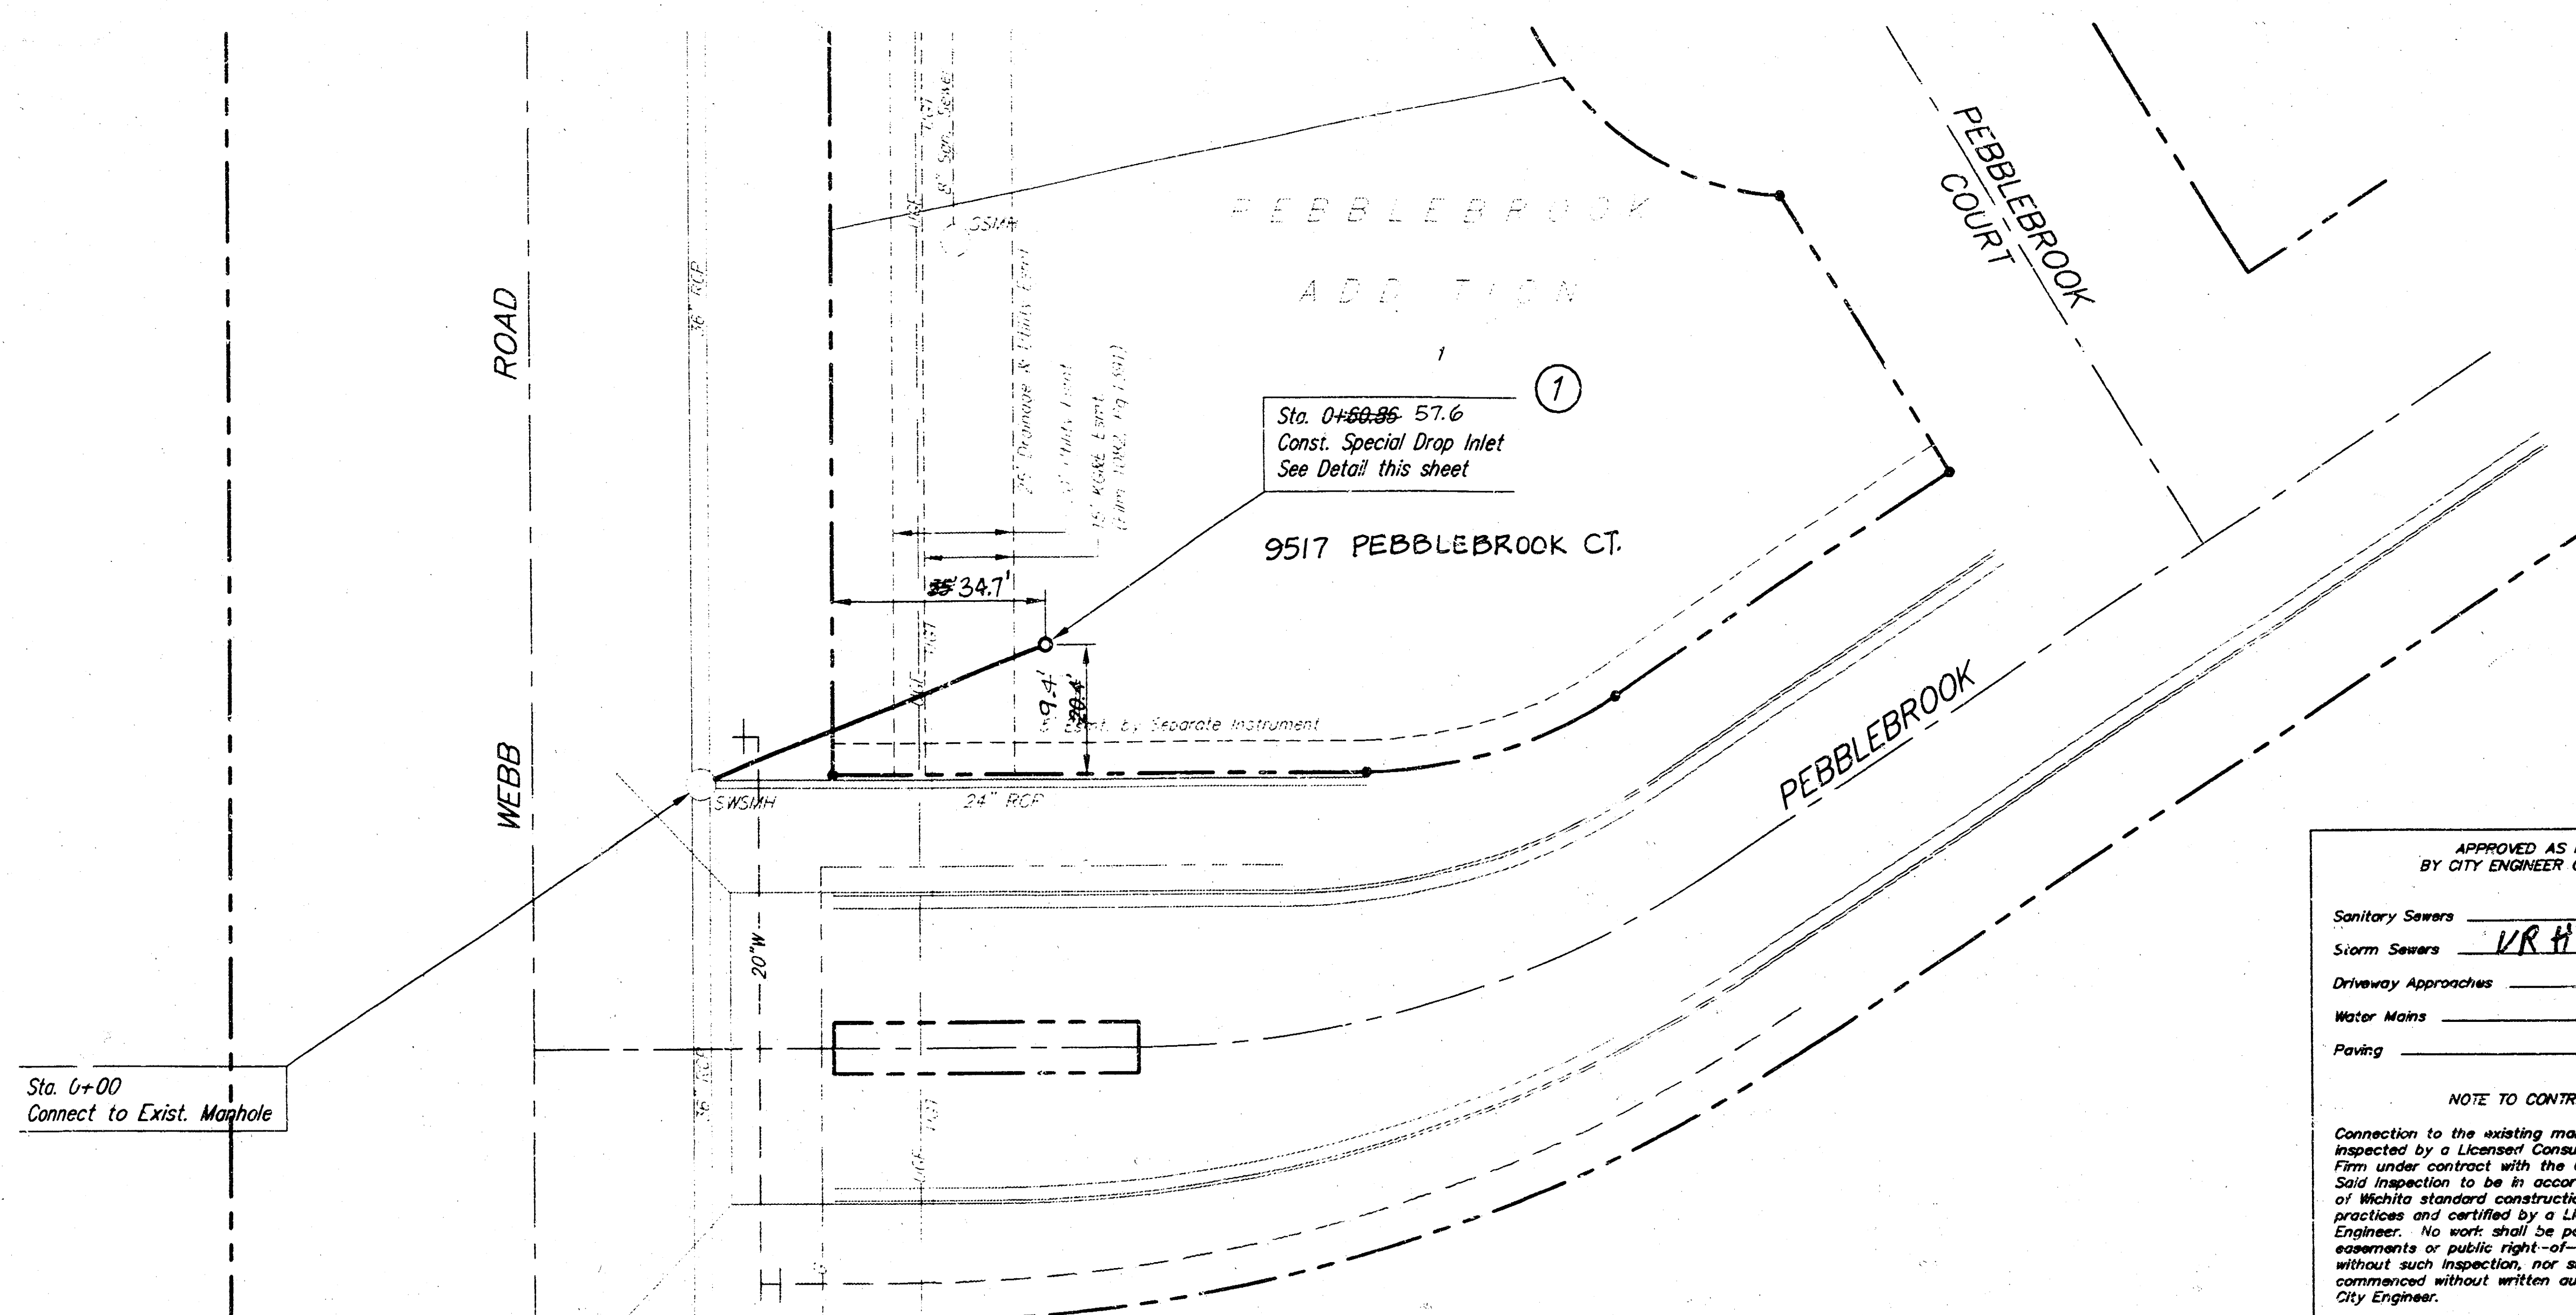


APPROVED AS NOTED
BY CITY ENGINEER OF WICHITA

Sanitary Sewers _____
Storm Sewers VRH 1/13/94
Driveway Approaches _____
Water Mains _____
Paving _____

NOTE TO CONTRACTORS

Connection to the existing manhole is to be inspected by a Licensed Consulting Engineering Firm under contract with the Owner/Developer. Said inspection to be in accordance with the City of Wichita standard construction engineering practices and certified by a Licensed Professional Engineer. No work shall be performed in dedicated easements or public right-of-way by the Contractor without such inspection, nor shall any work be commenced without written authorization by the City Engineer.

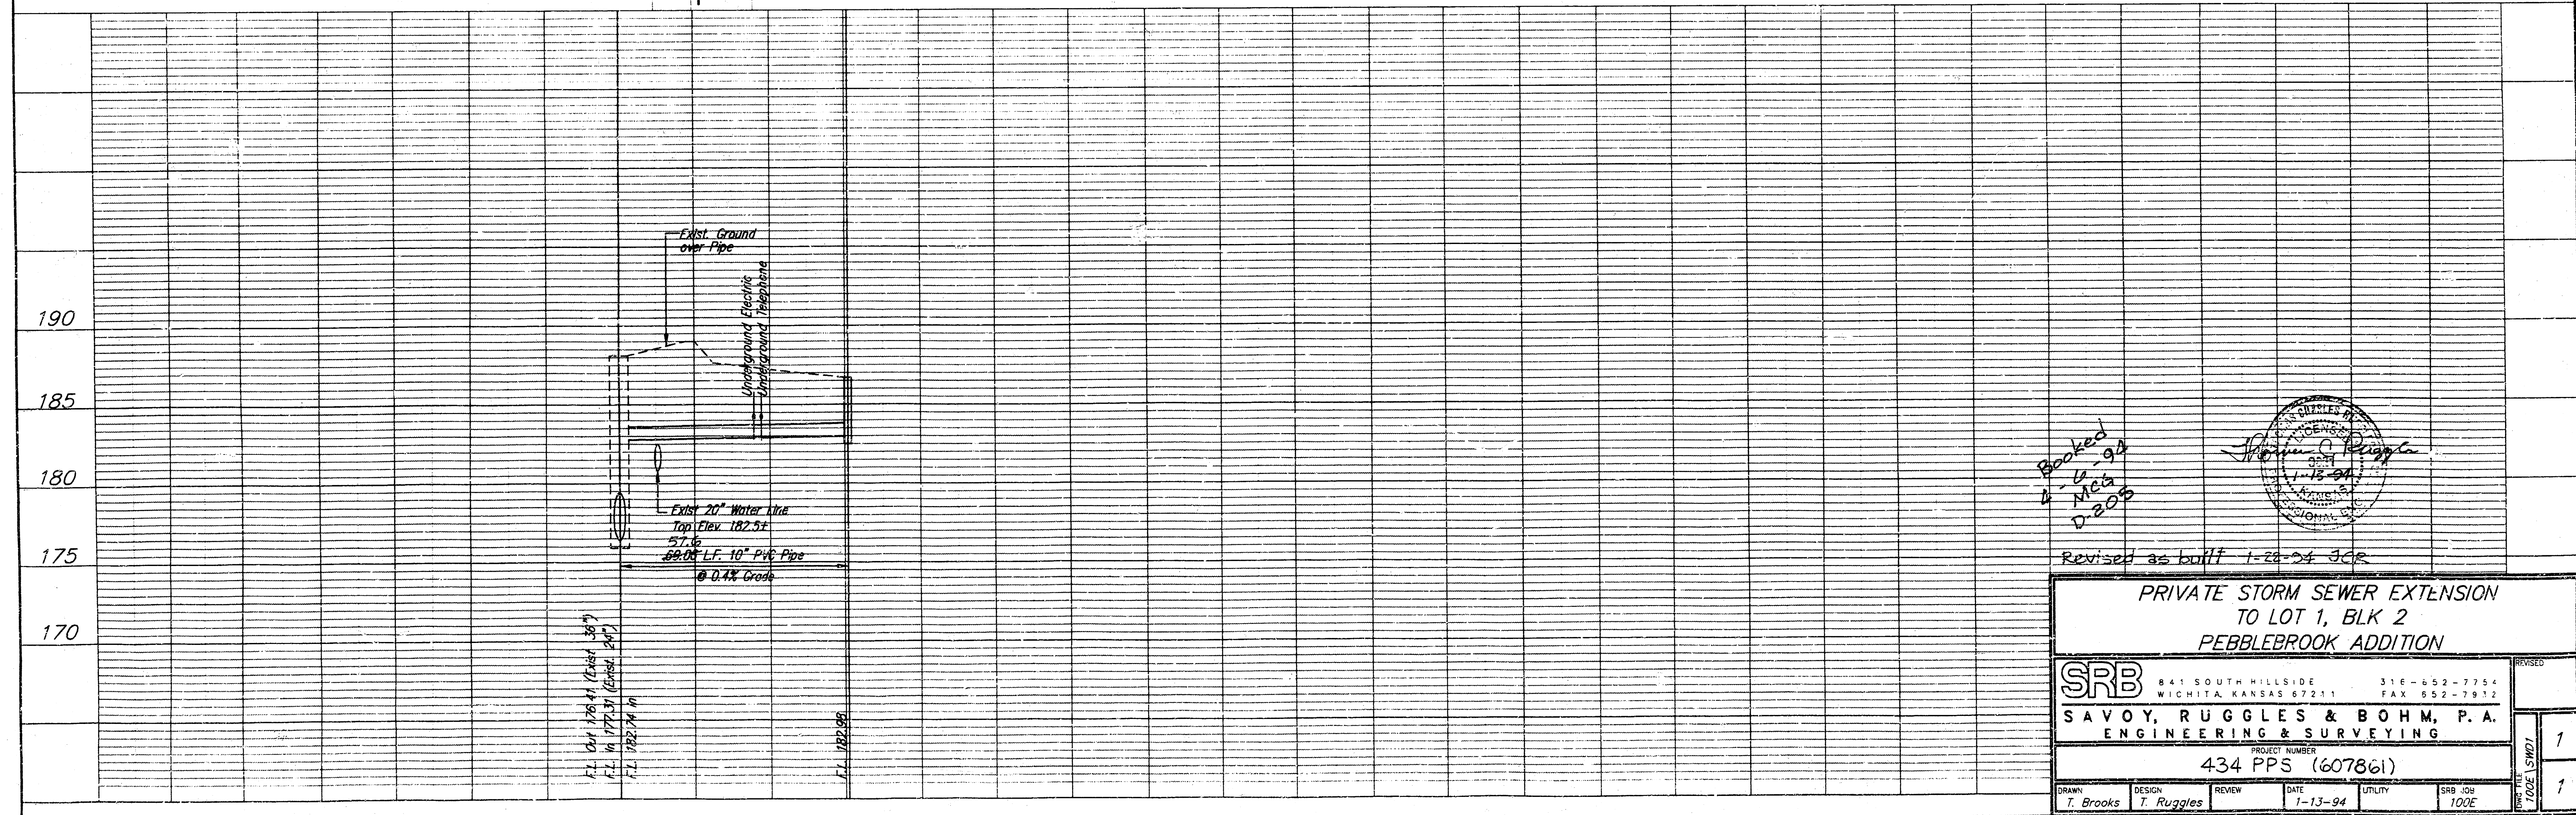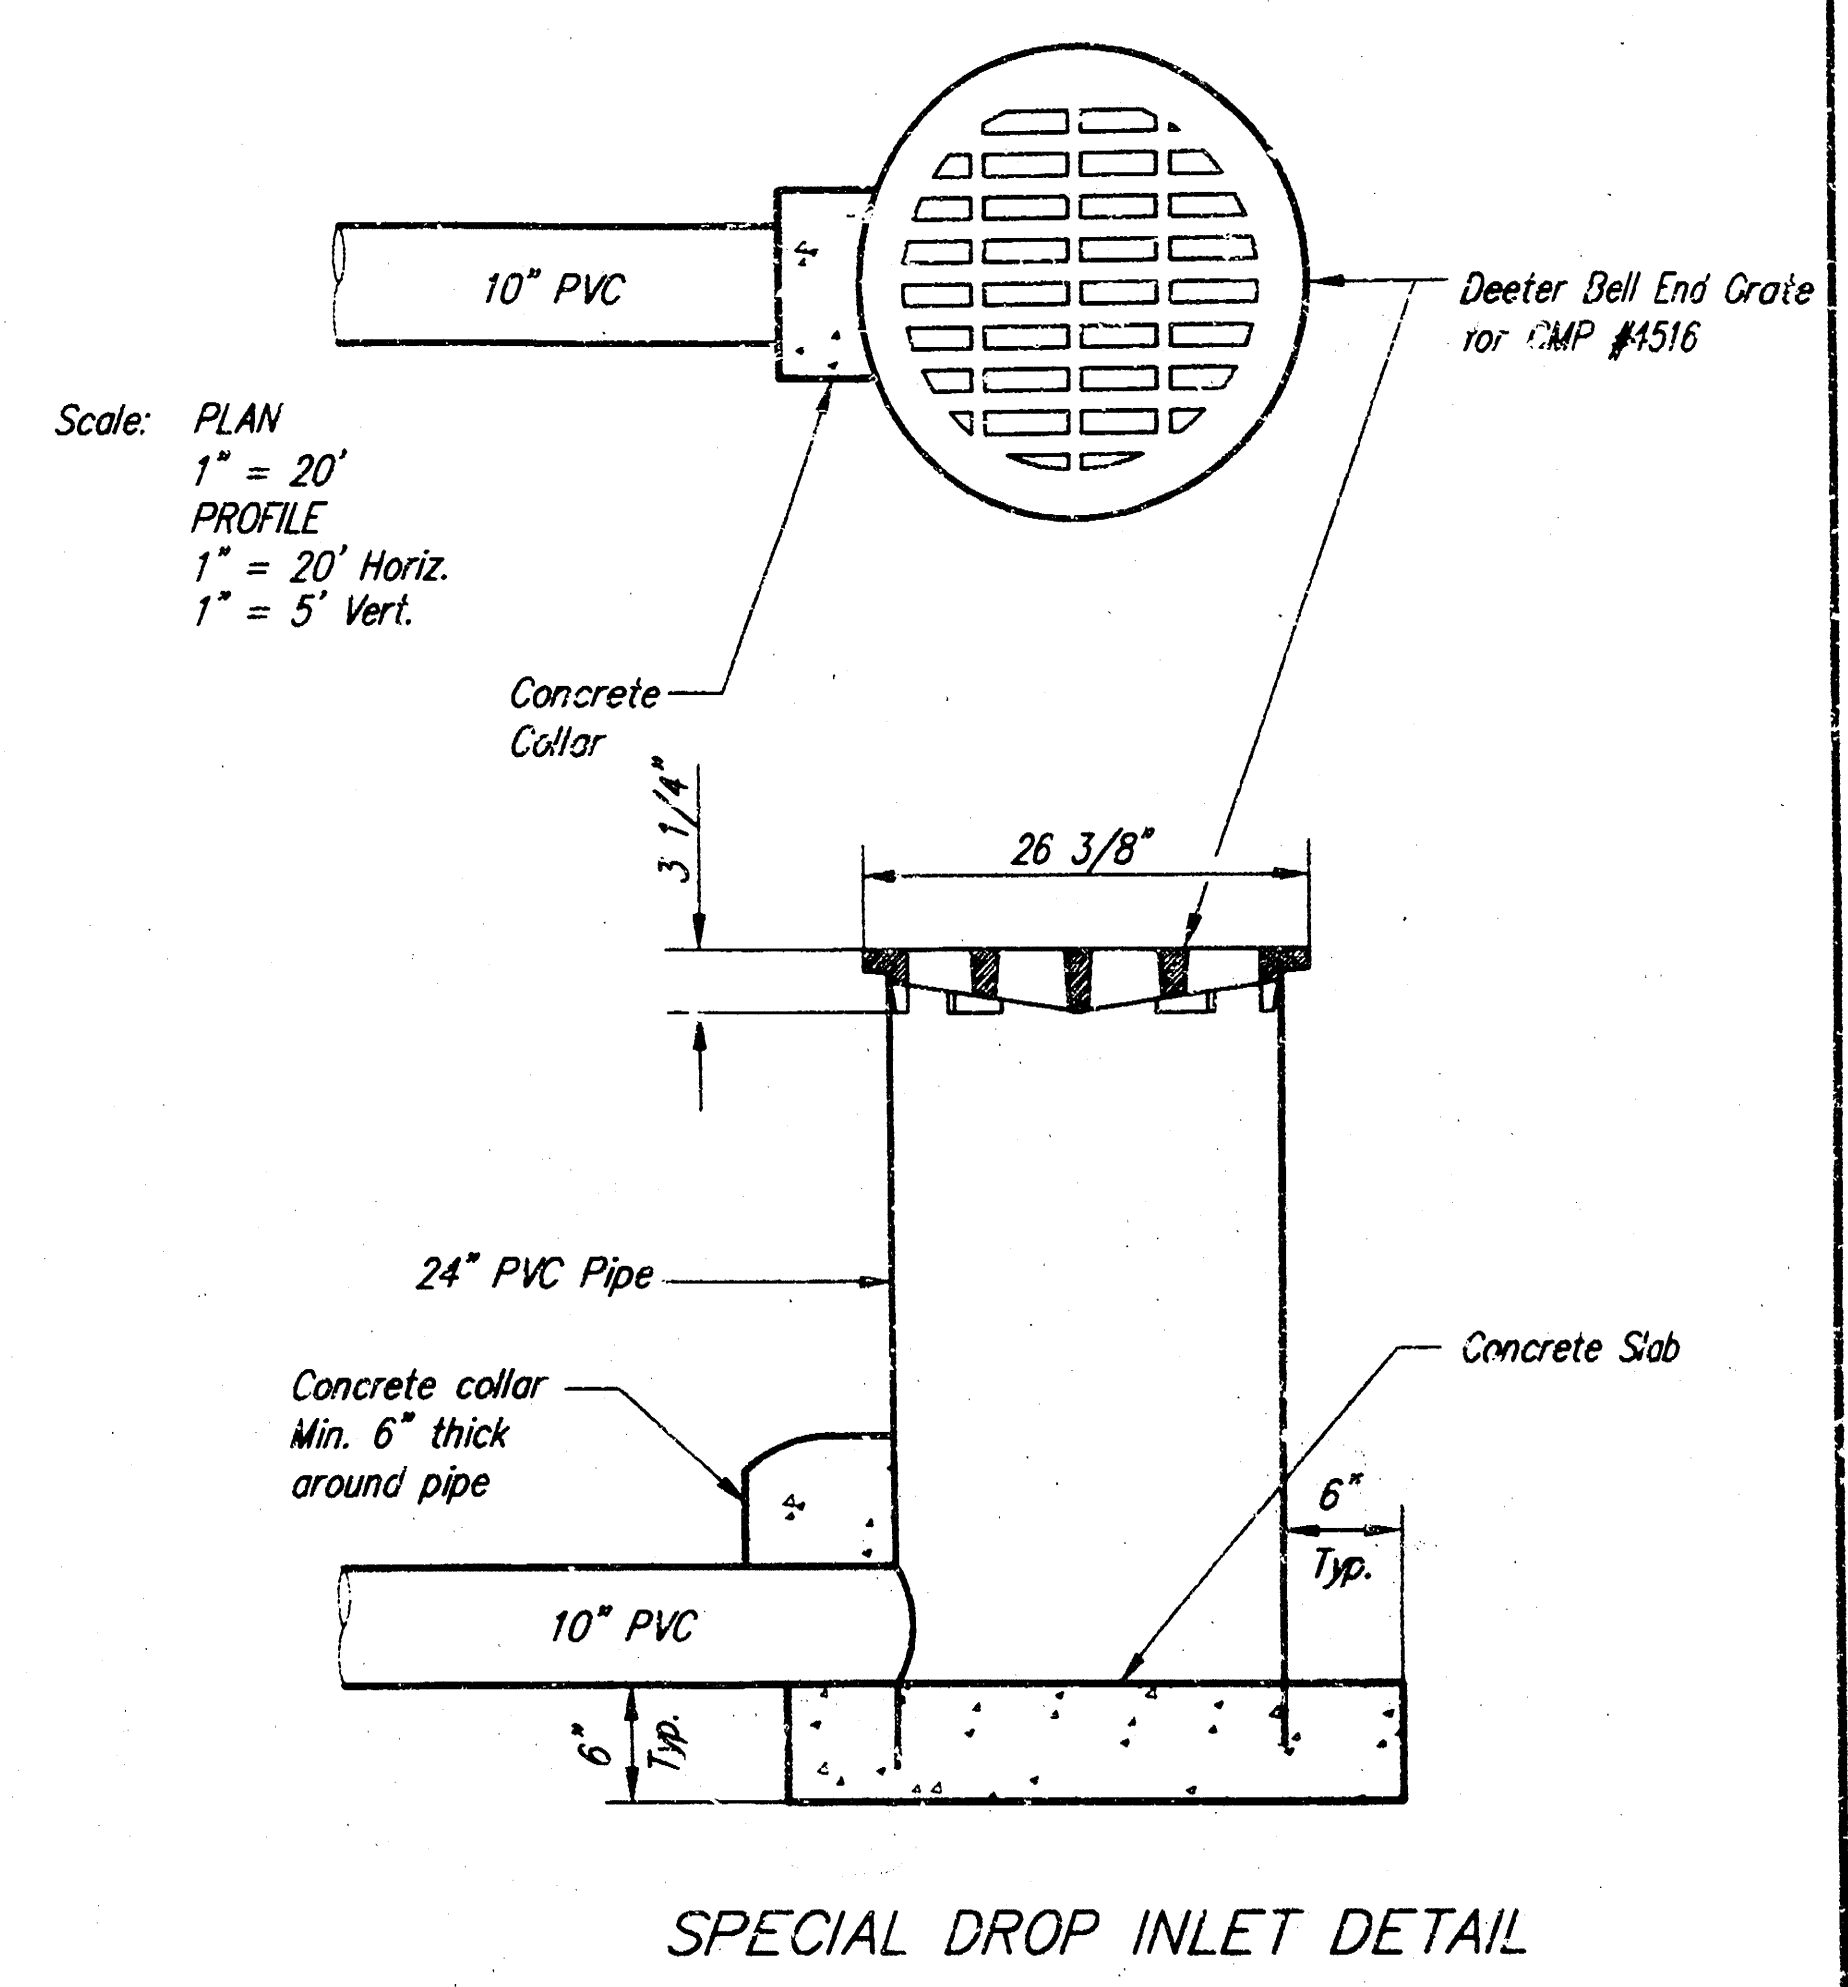

Booked
4-8-94
MCA
D-205

Revised as built 1-29-94 JCR

PRIVATE STORM SEWER EXTENSION
TO LOT 1, BLK 2
PEBBLEBROOK ADDITION

SRB 841 SOUTH HILLSIDE 316-652-7754
WICHITA, KANSAS 67211 FAX 652-7912

SAVOY, RUGGLES & BOHM, P.A.
ENGINEERING & SURVEYING

PROJECT NUMBER
434 PPS (607861)

DRAWN: T. Brooks DESIGN: T. Ruggles REVIEW: DATE: 1-13-94 UTILITY: SRB JOB: 100E

1
1