
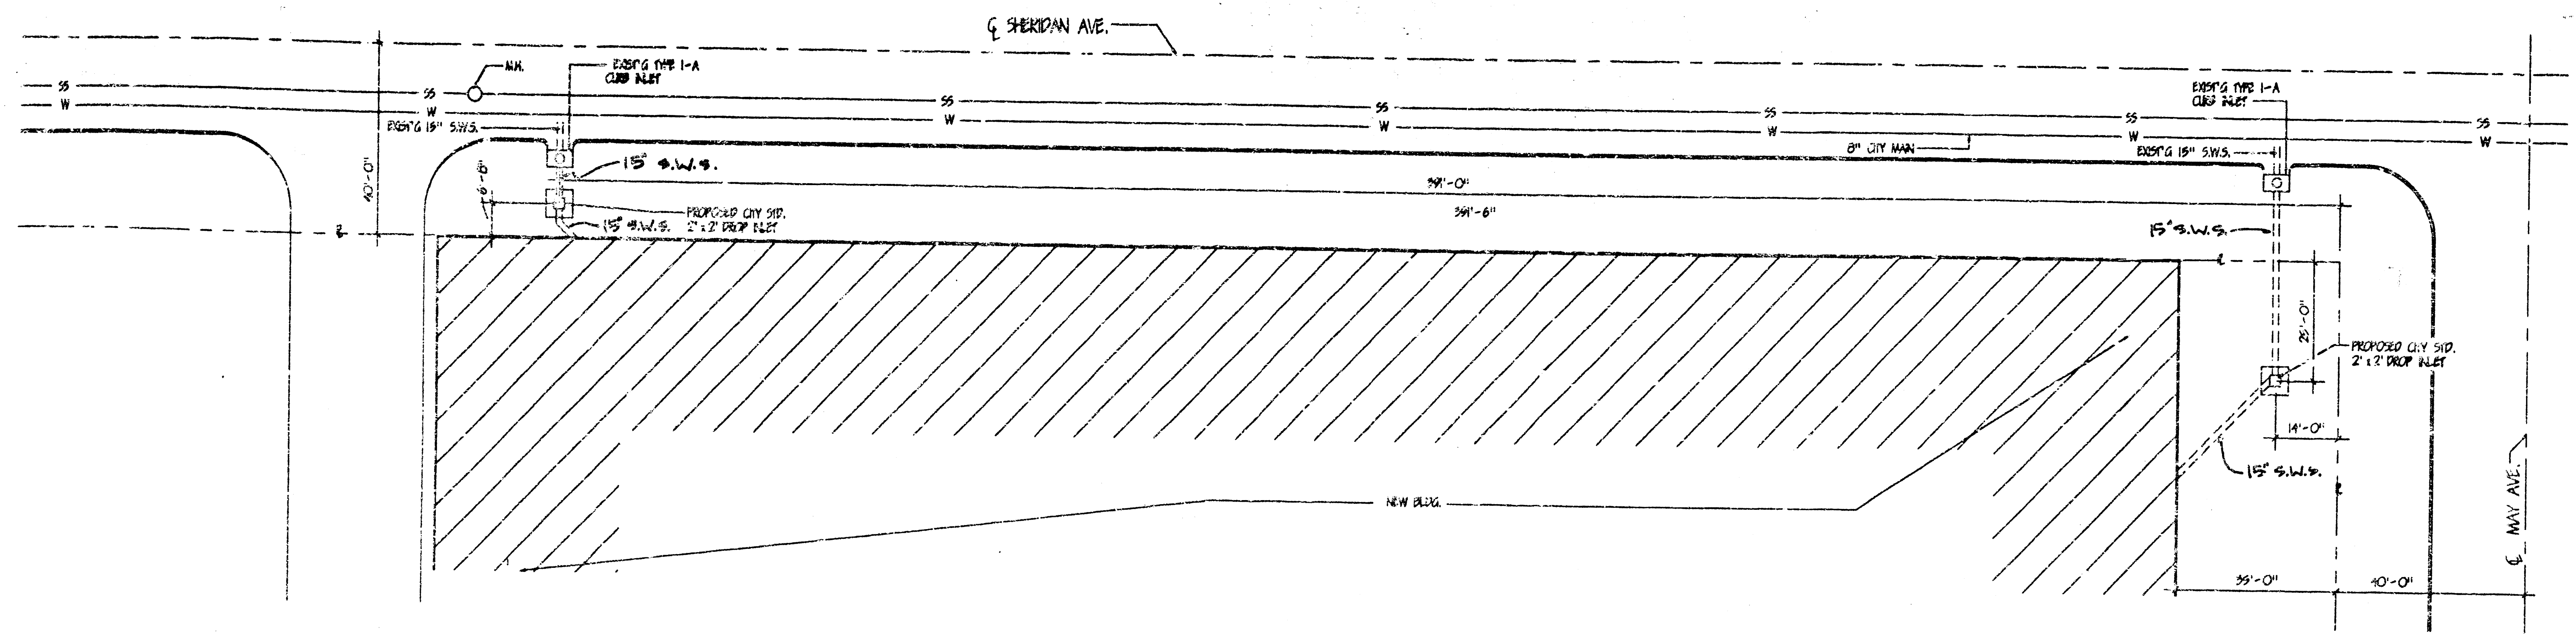



**PRIVATE STORM WATER SEWER
SERVING LOT 1, BLOCK "A", METAL-FAB ADDITION**
1" = 20'-0"

S.M. #33 60' SPIKE SET IN
S.E. CORNER OF P. 3 S.W. CORNER
SHERIDAN & MAY BL. 107.64
FOR CITY DATUM


NOTE: GRADE SHALL BE DETERMINED ON THE TOP
SURFACE WITH CITY & NEIGHBORING LOTS
AT LEAST 1" IN HEIGHT. OTHER ELEVATION MEASUREMENTS
MAY BE USED ONLY IF APPROVED BY THE ENGINEER.

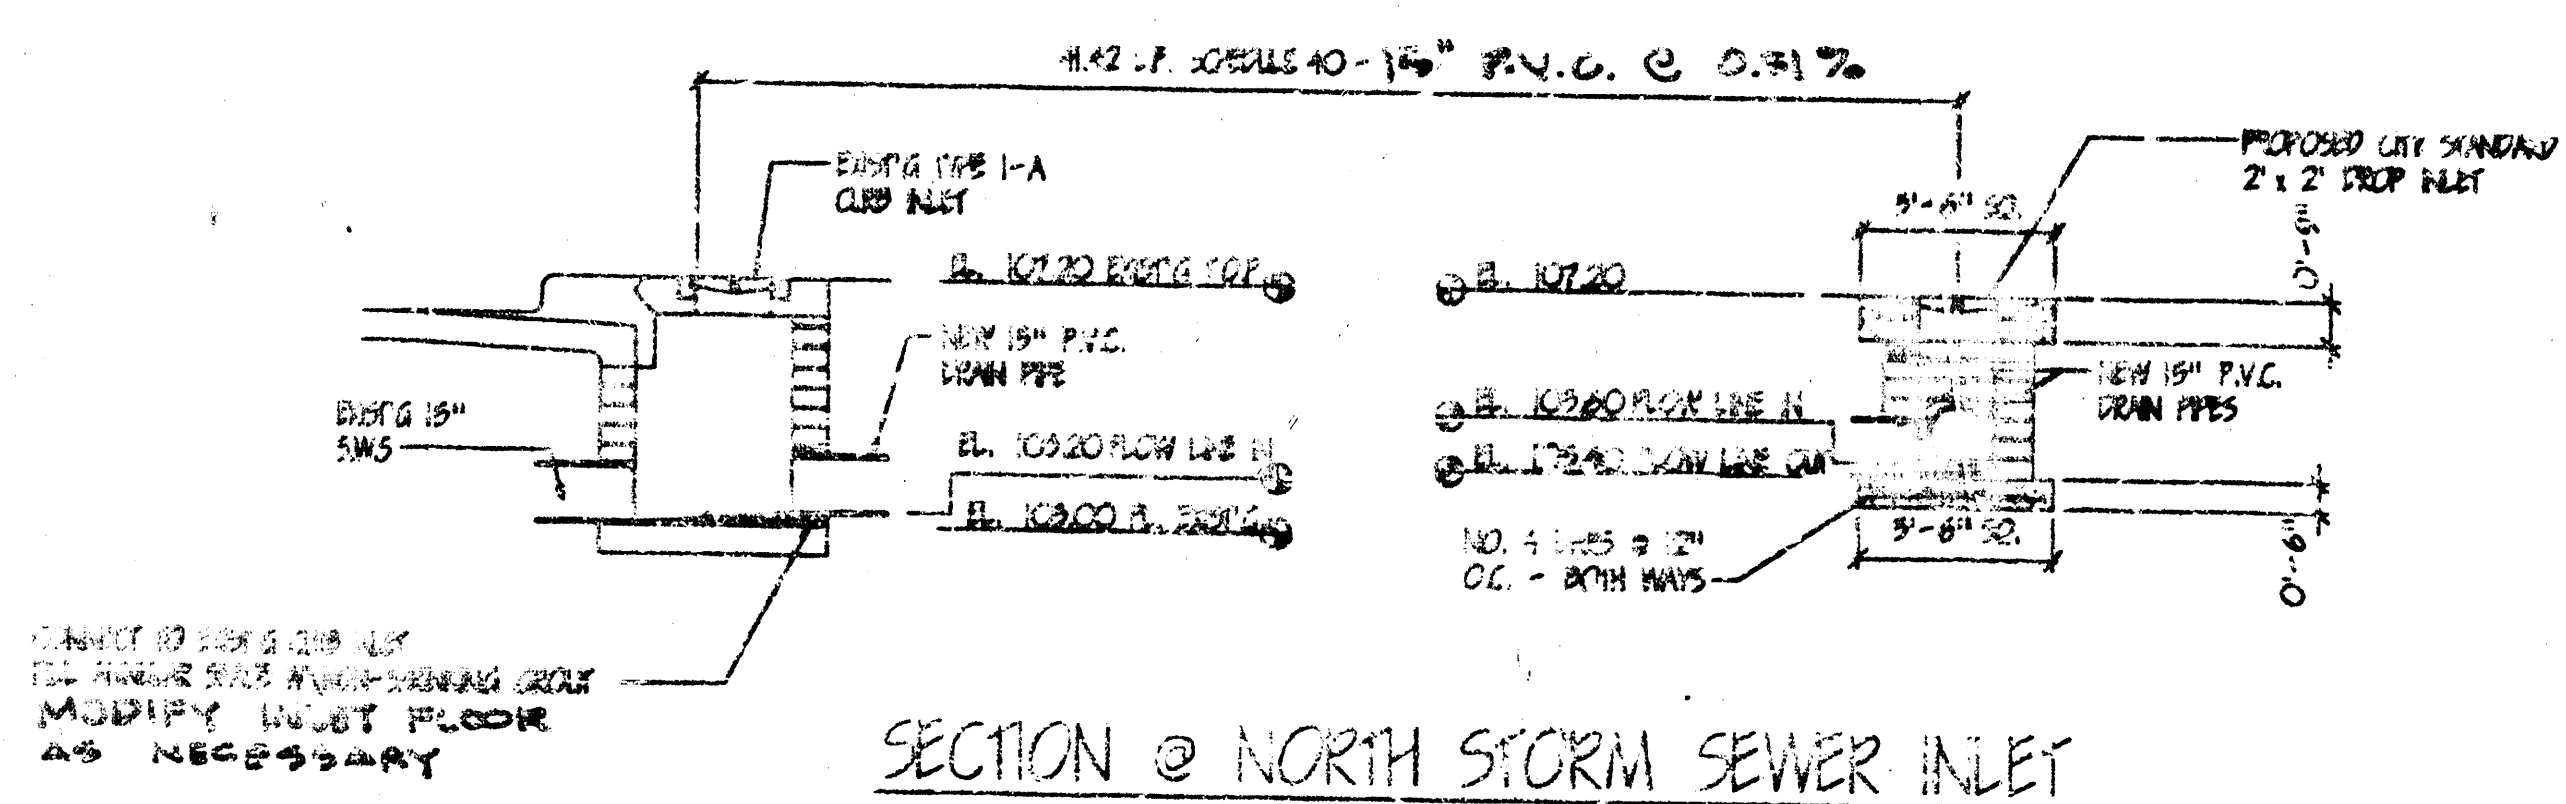

SECTION @ NORTH STORM SEWER INLET

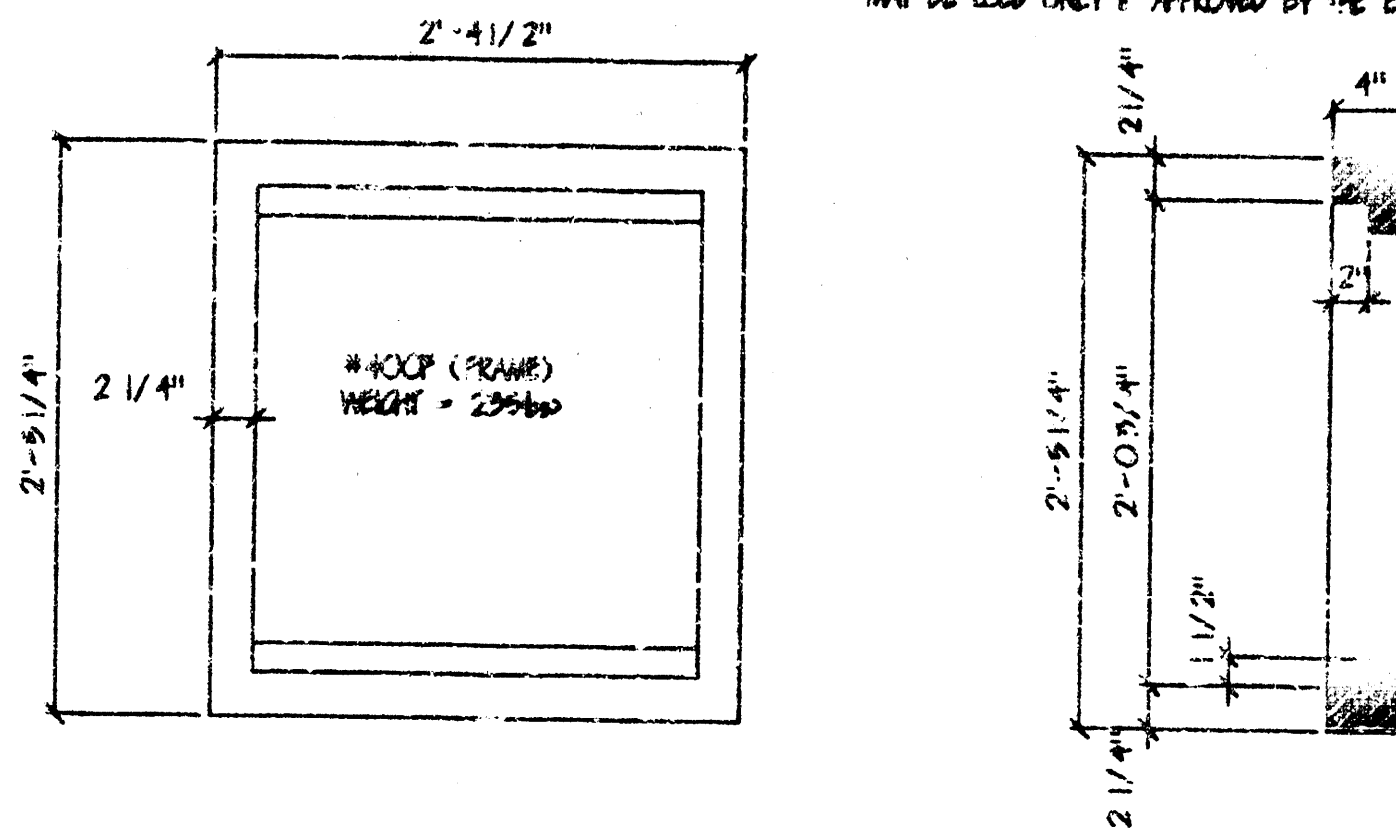

FRAME & GRATE DETAIL

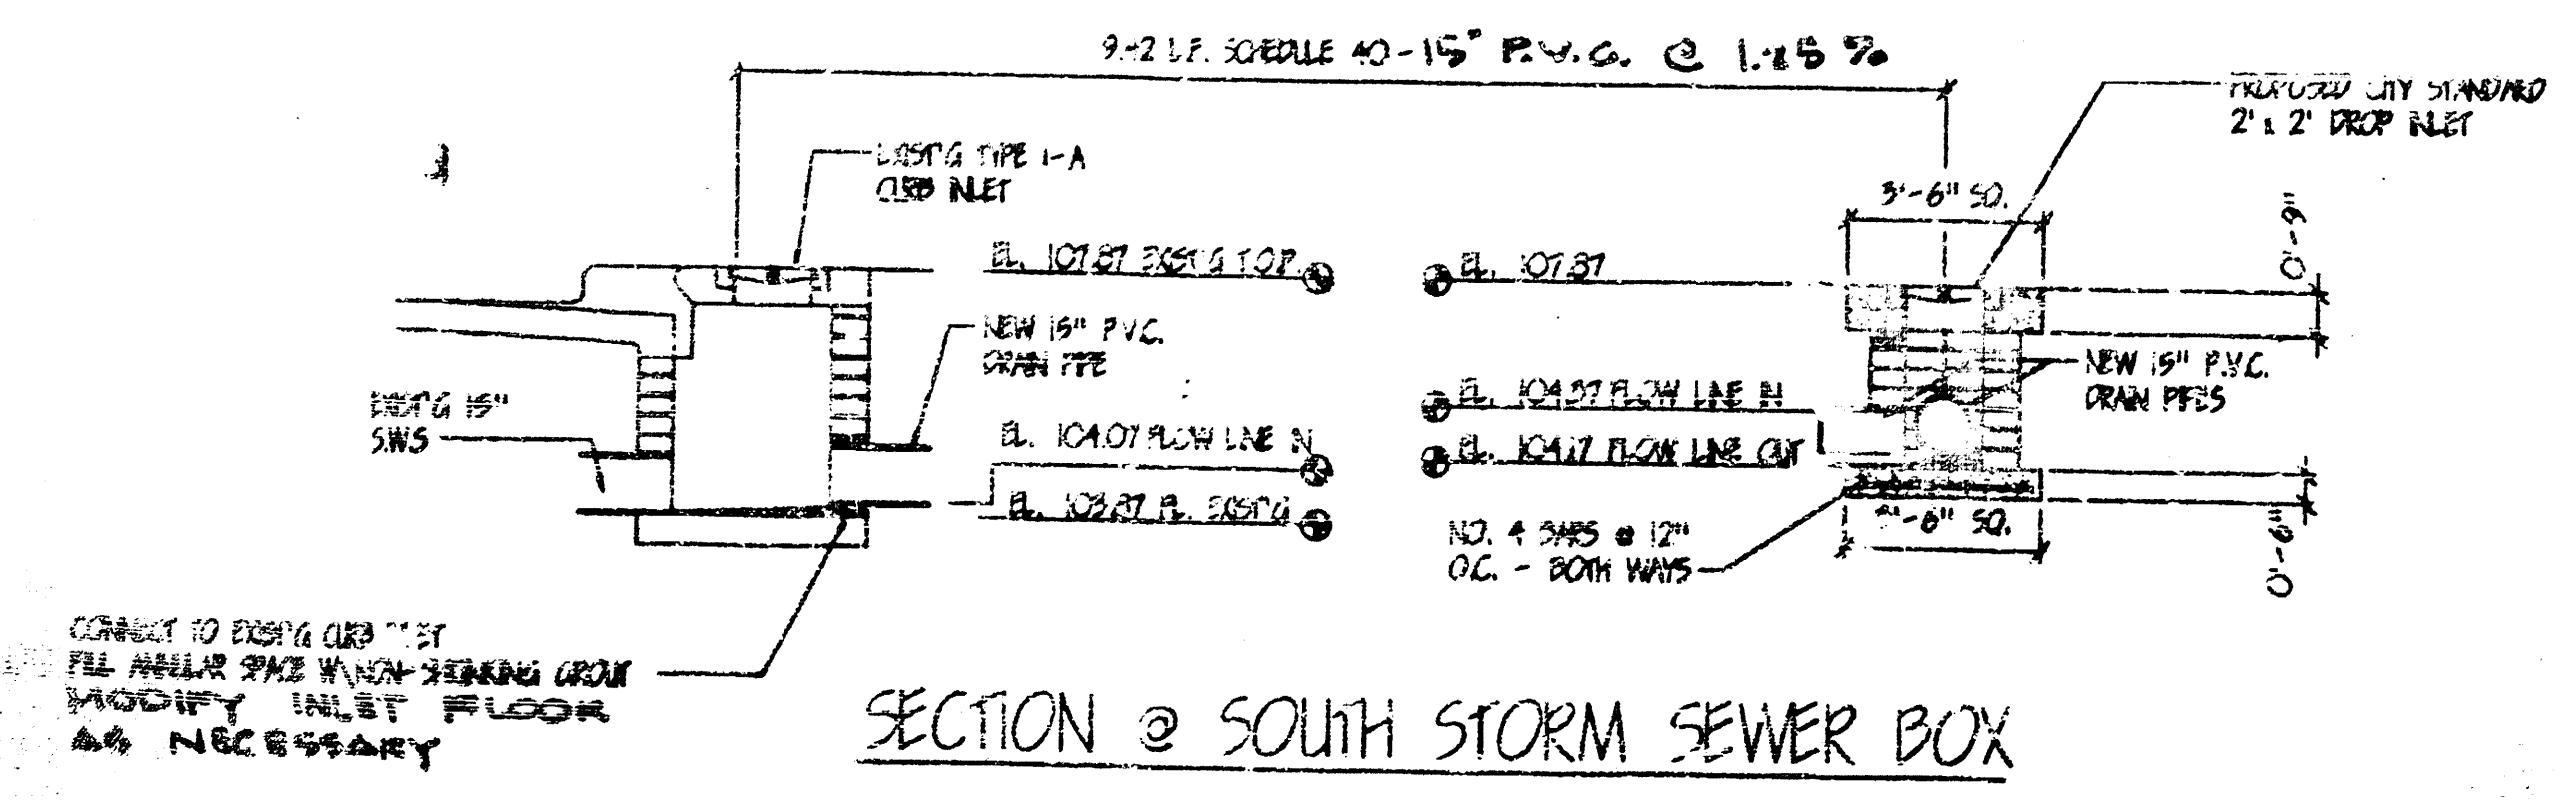

SECTION @ SOUTH STORM SEWER BOX

INSPECTION AND TESTING FOR THIS PROJECT TO BE PROVIDED BY A LICENSED CONSULTING ENGINEERING FIRM UNDER CONTRACT WITH THE OWNER/DEVELOPER. SAID INSPECTION TO BE IN ACCORDANCE WITH THE CITY OF WICHITA STANDARD CONSTRUCTION ENGINEERING PRACTICES AND CERTIFIED BY A LICENSED PROFESSIONAL ENGINEER. NO WORK SHALL BE PERFORMED IN DEDICATED EASEMENTS OR PUBLIC RIGHT-OF-WAY BY THE CONTRACTOR WITHOUT SUCH INSPECTIONS, NOR SHALL ANY WORK BE COMMENCED IN DEDICATED EASEMENTS OR PUBLIC RIGHT-OF-WAY WITHOUT WRITTEN AUTHORIZATION BY THE CITY ENGINEER.

APPROVED AS NOTED
BY CITY ENGINEER OF WICHITA


SANITARY SEWERS _____
STORM SEWERS VRH 7/29/94
DRIVEWAY APPROACHES _____
WATER MAINS _____
PAVING _____

PRIVATE PROJECT NO. 484PFS (60786)



Drawings prepared under the direction of,
Don C. Moehring II - Consulting Engineer

By Don C. Moehring II

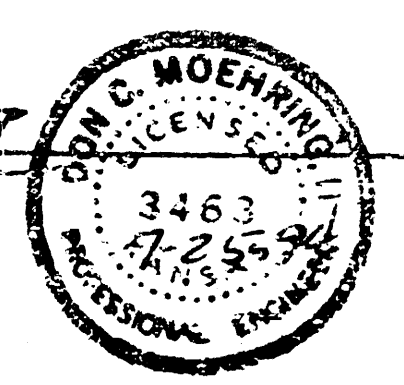

AS BUILT PLANS
S.E. ANDERSON, P.E.
DECEMBER, 1995

EVANS BUILDING CO., INC.
9801 WEST YORK
WICHITA, KANSAS 67277

METAL - FAB INC.
5000 W. 11th

PROPERTY
STATE OF KANSAS
COMMISSIONER OF REVENUE

E
B
C

REVISIONS
NO. DATE BY

DATE: 7/29/94

DR. BY: N.M.

CK. BY:

SCALE:

PROJECT

94-122

SHEET

SP-1a

OF