




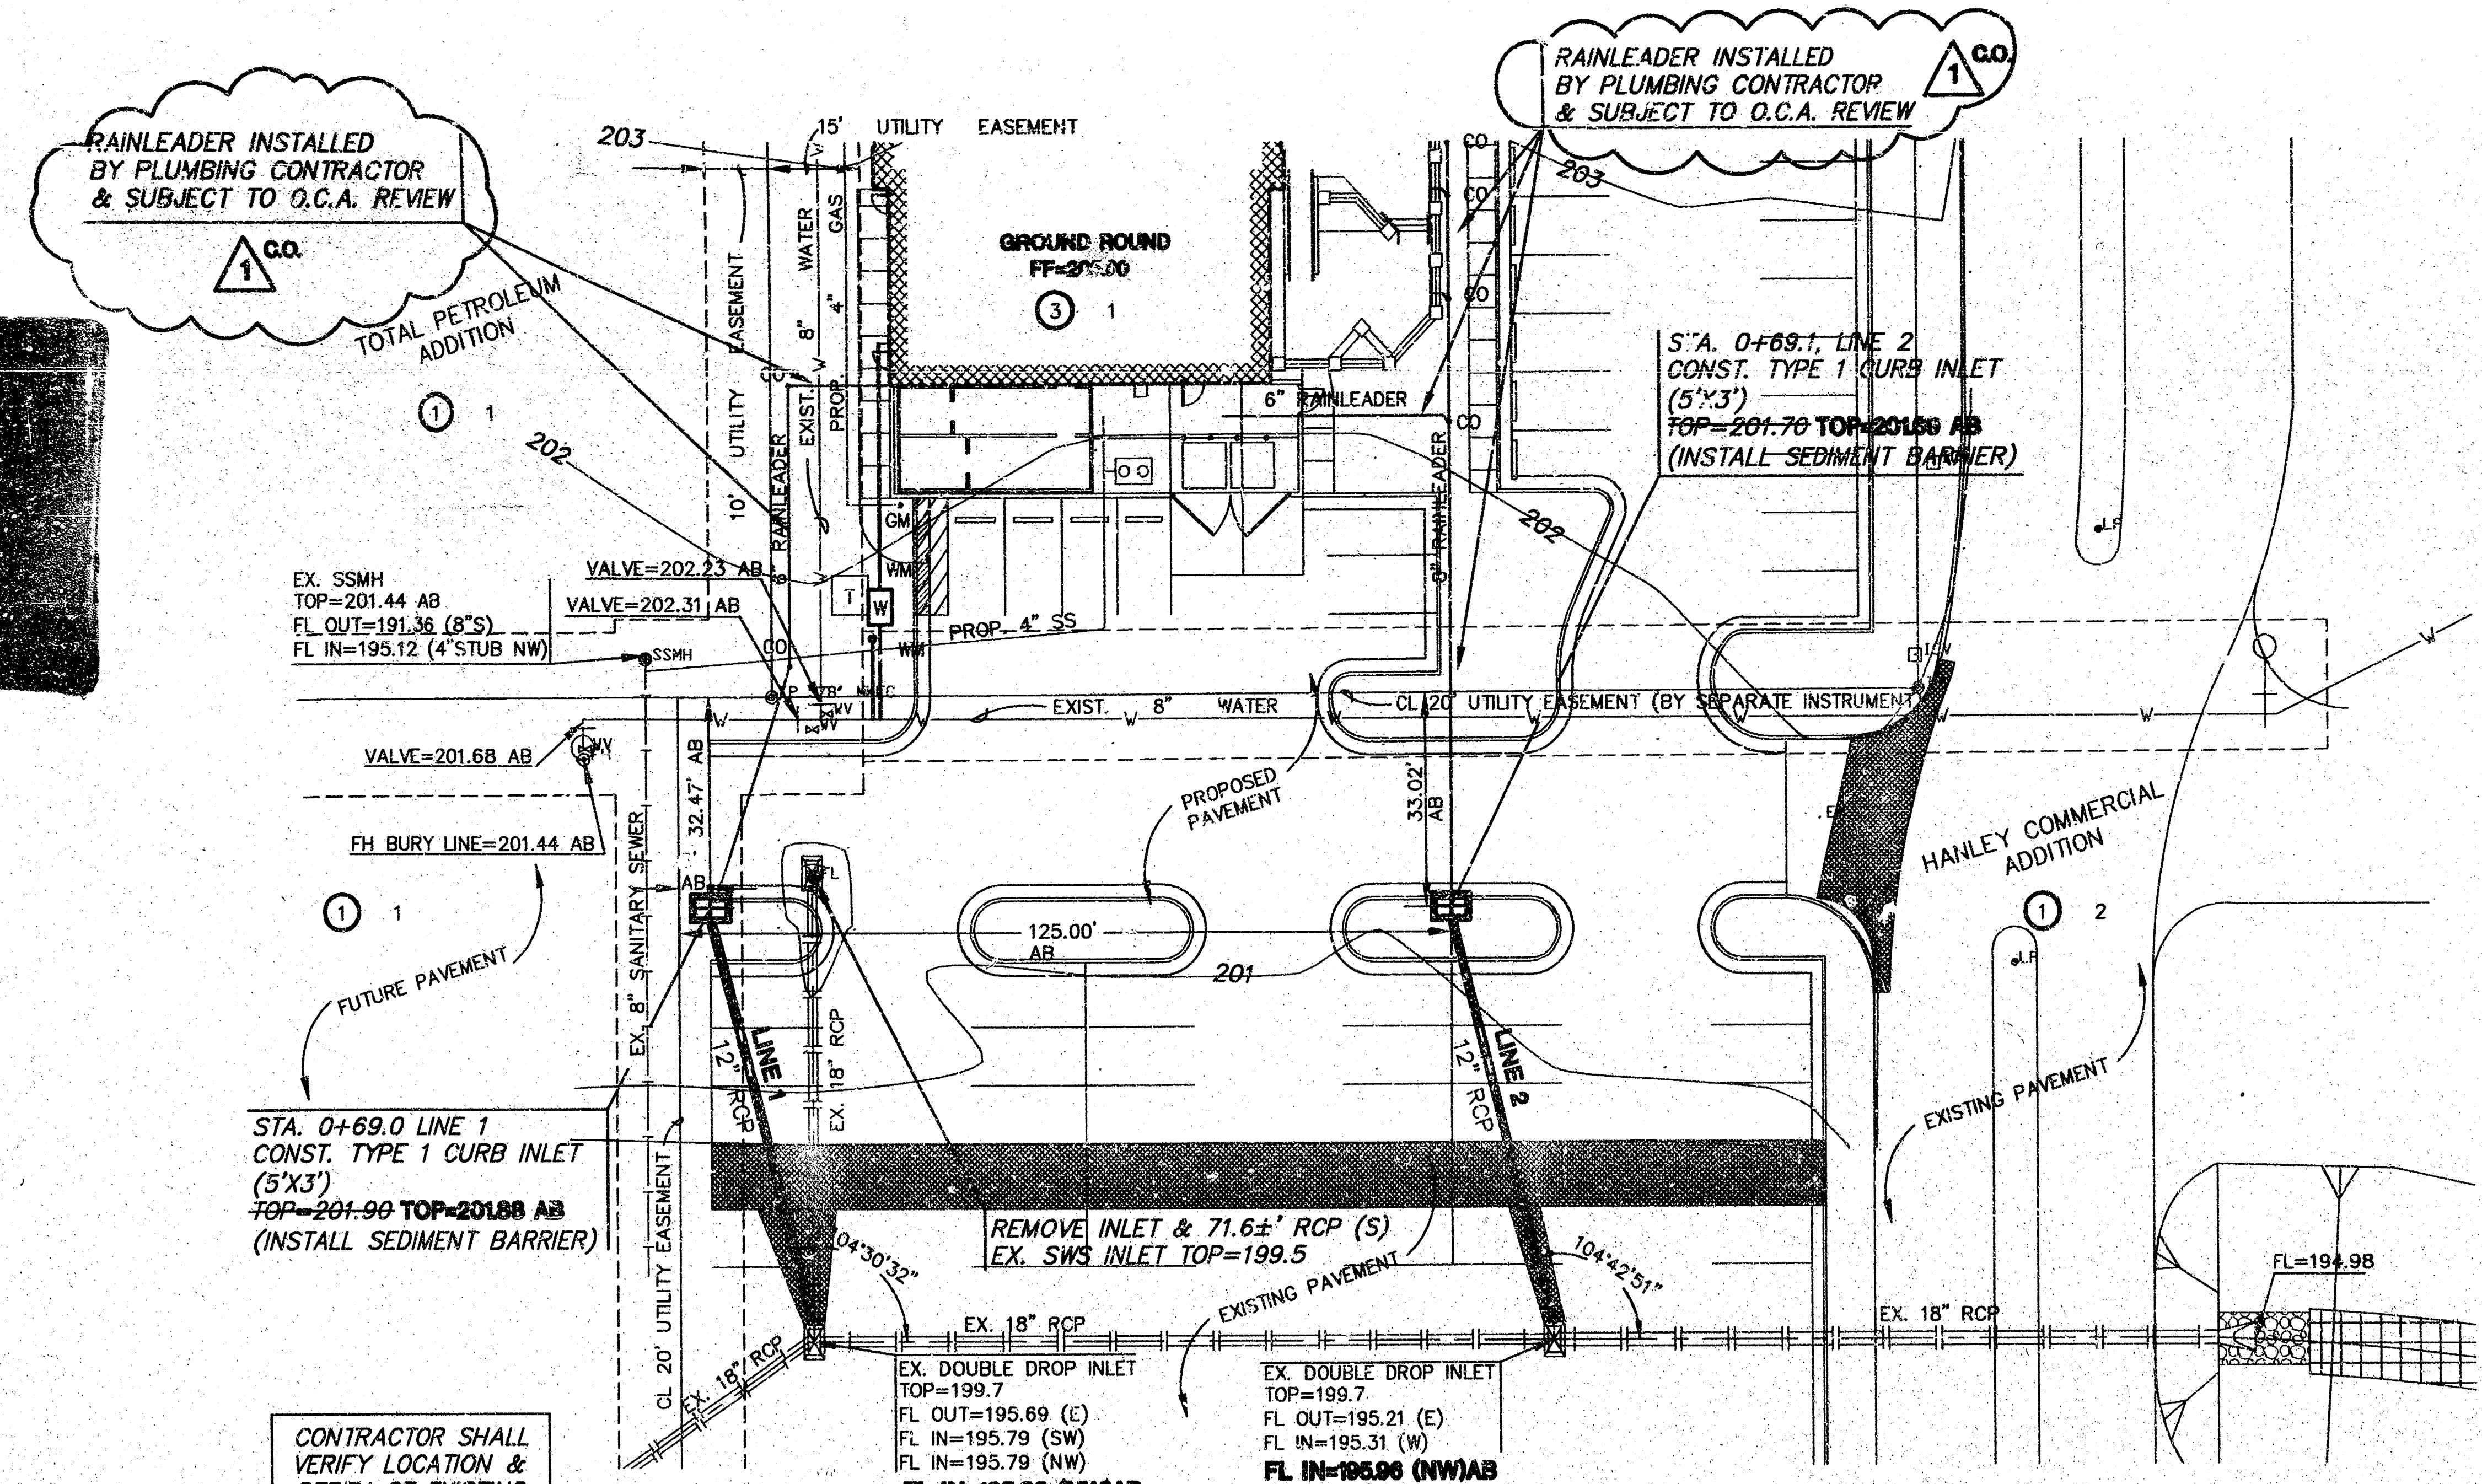


PLAN LINE 1
SCALE: 1"=20'

PLAN LINE 2
SCALE: 1"=20'

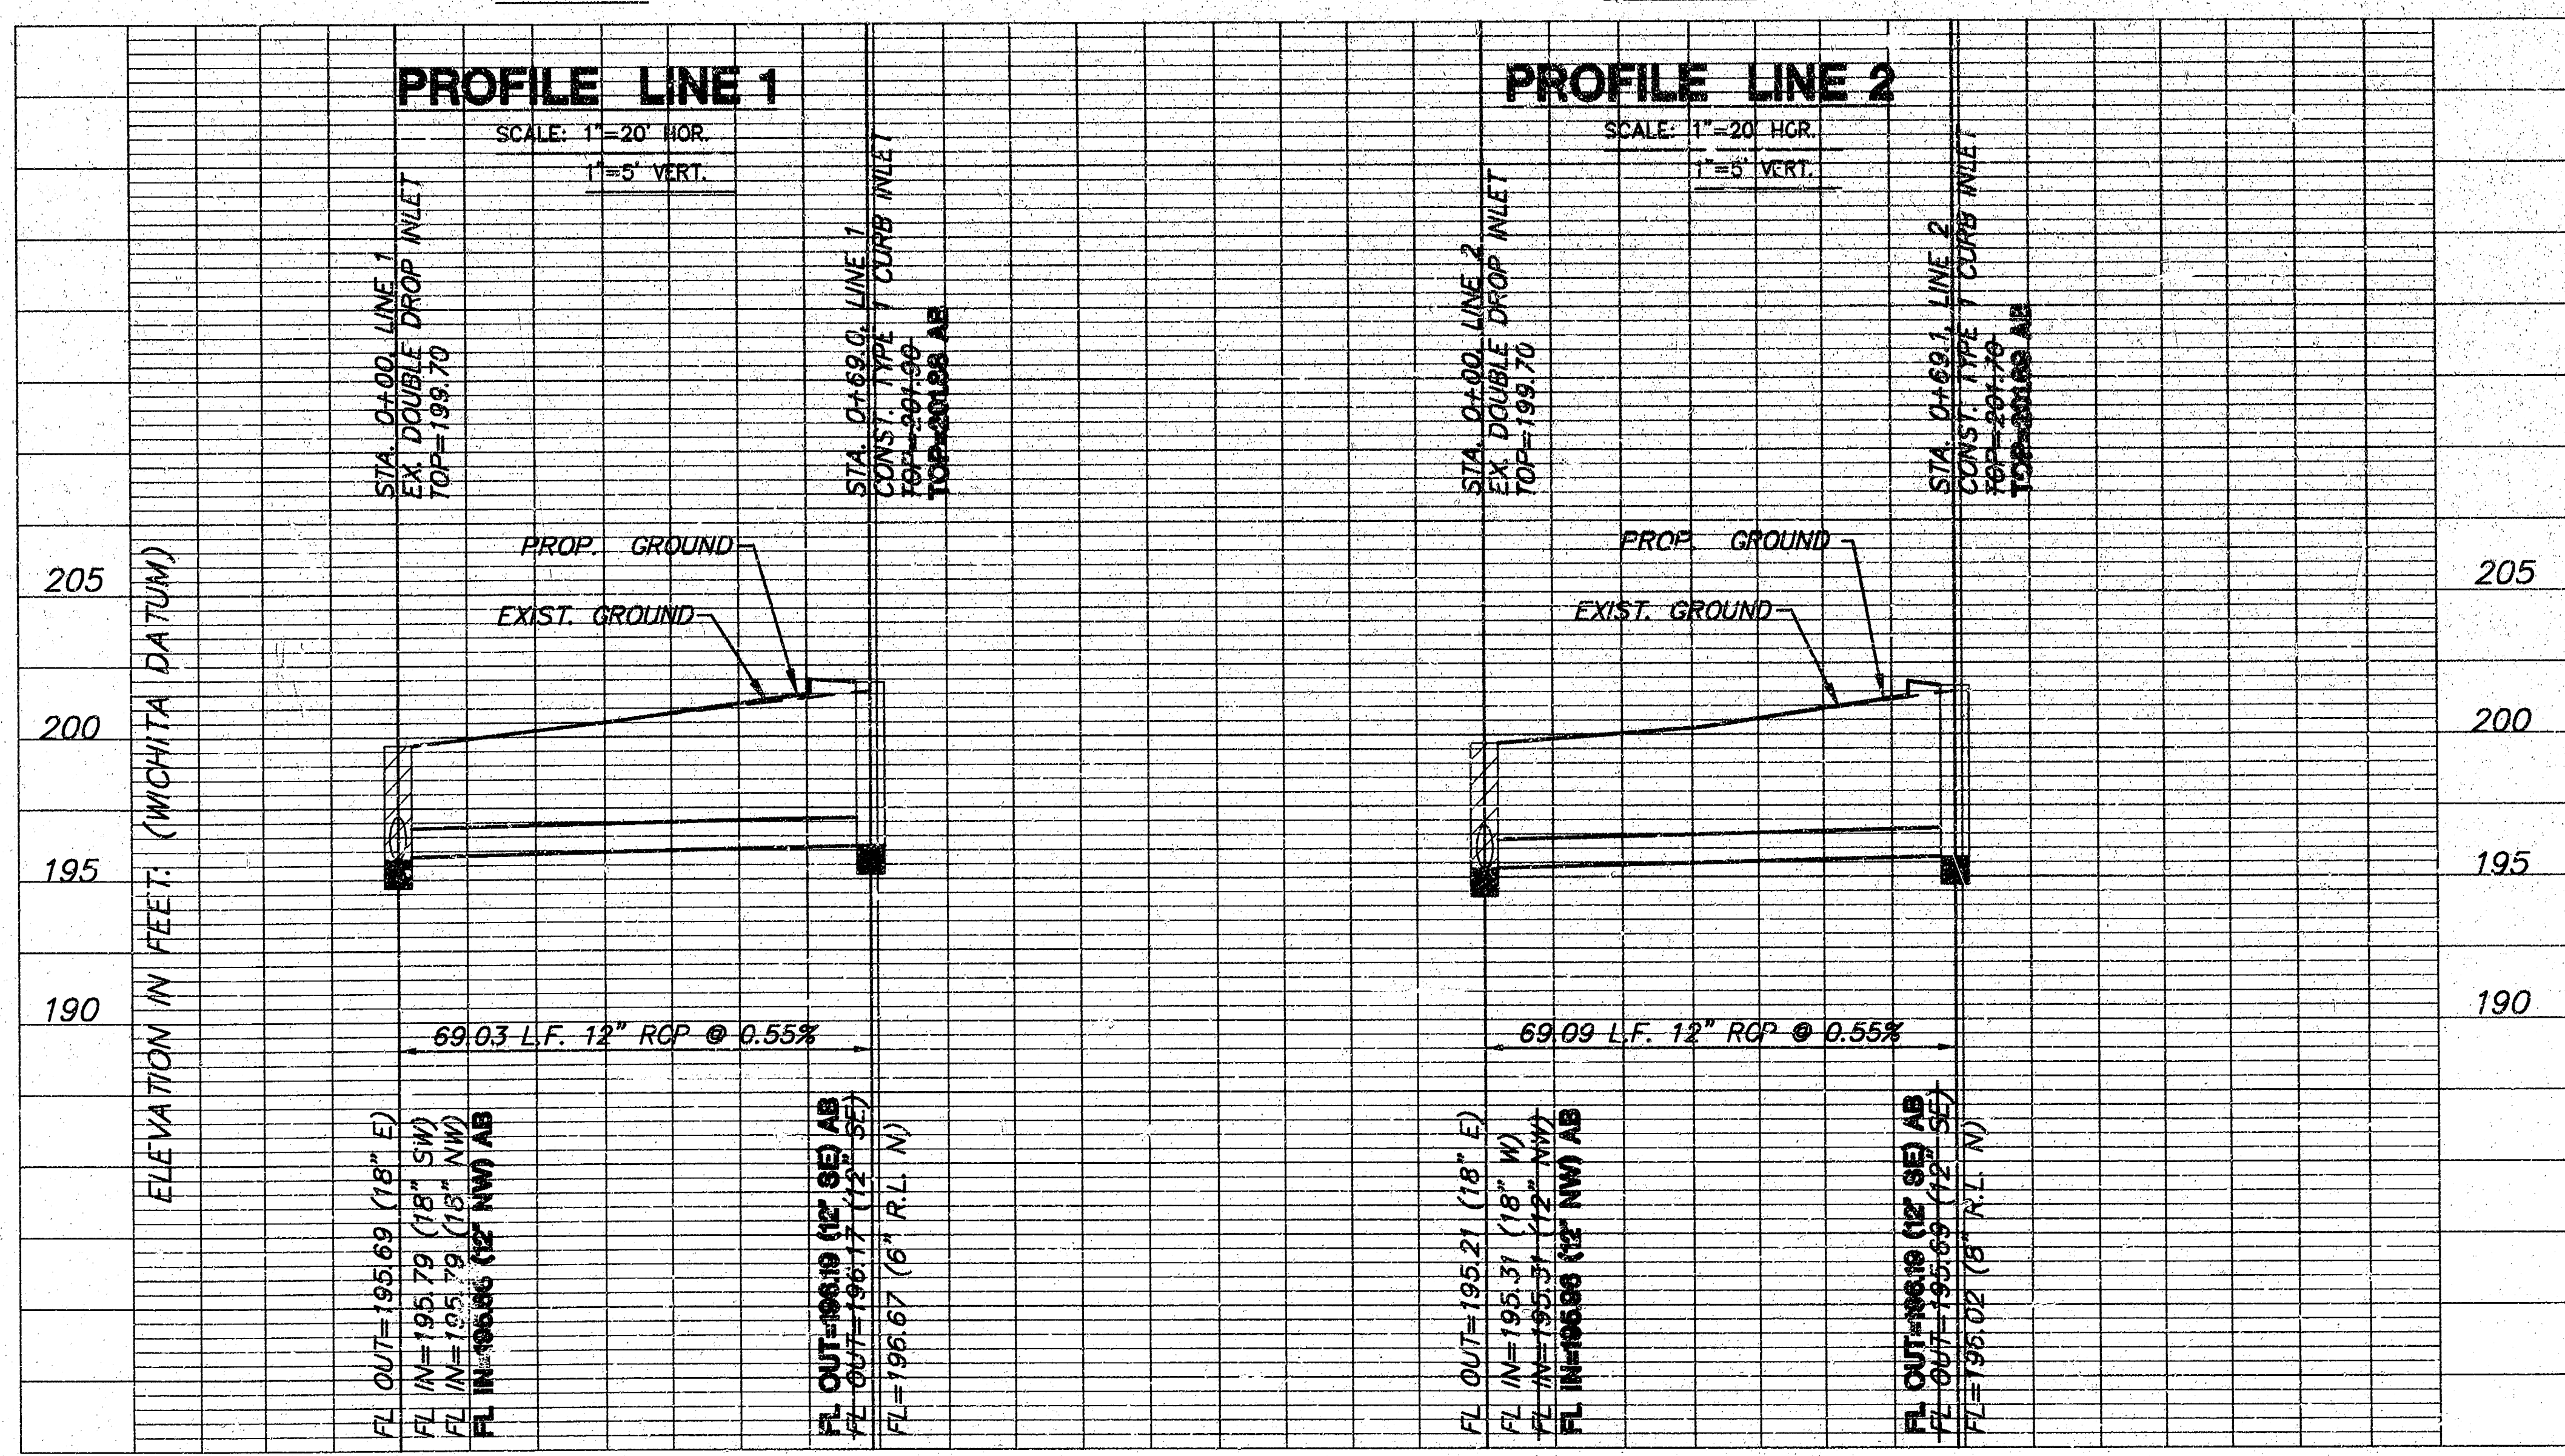

AS-BUILT 20 MAY 2003

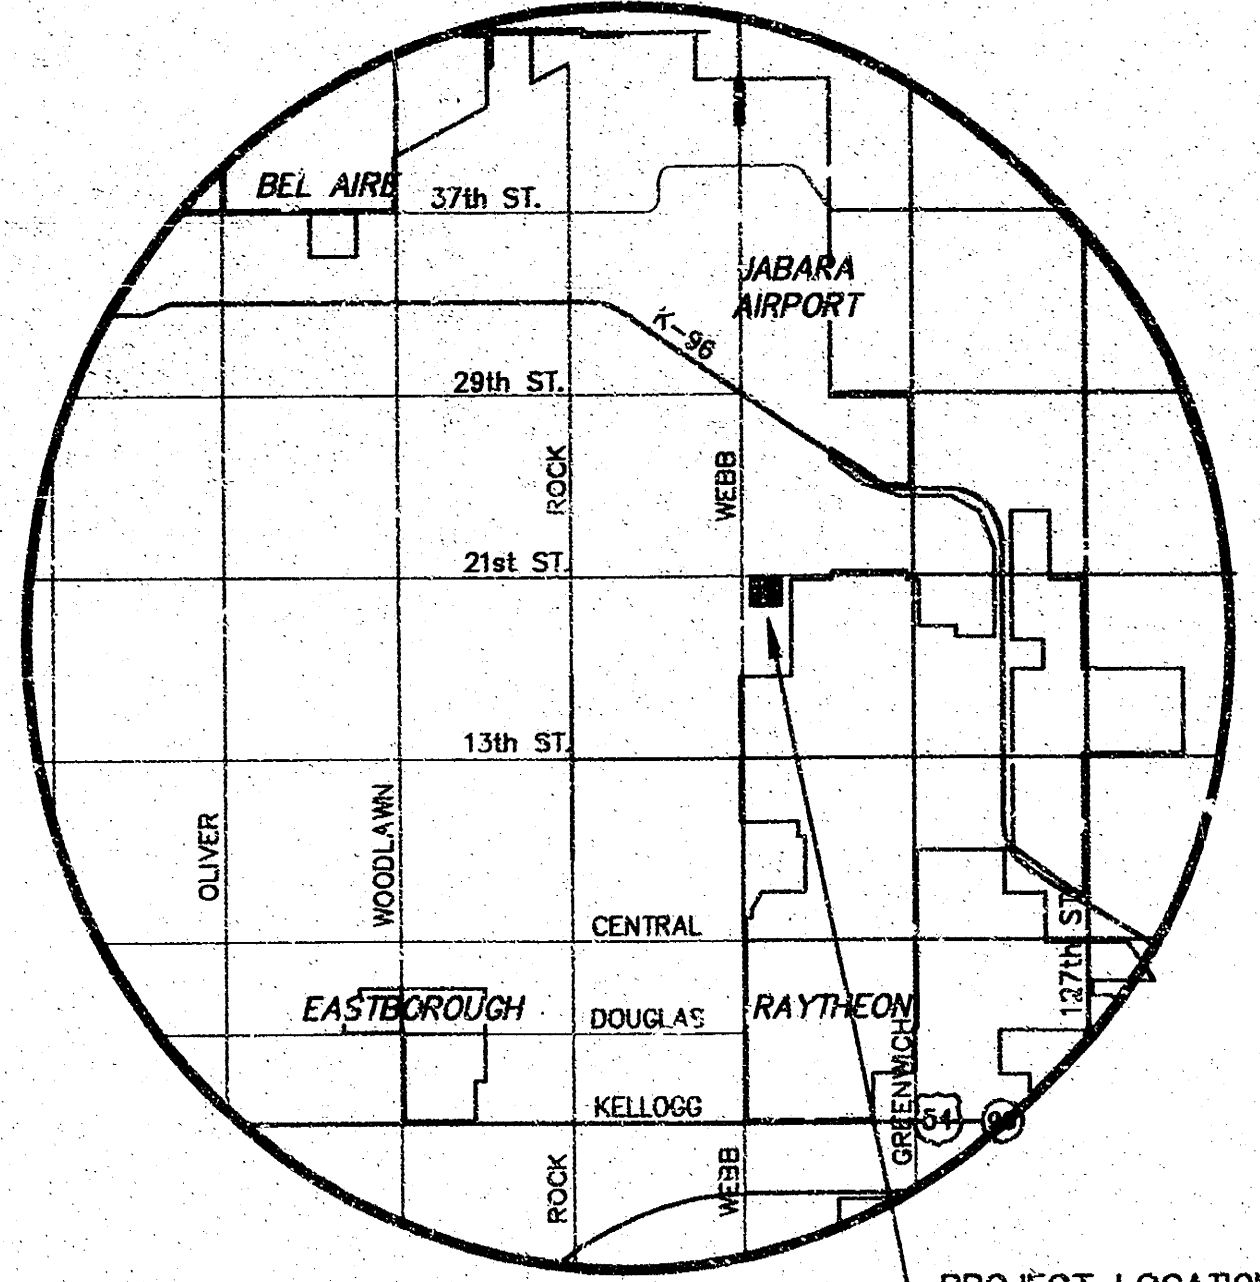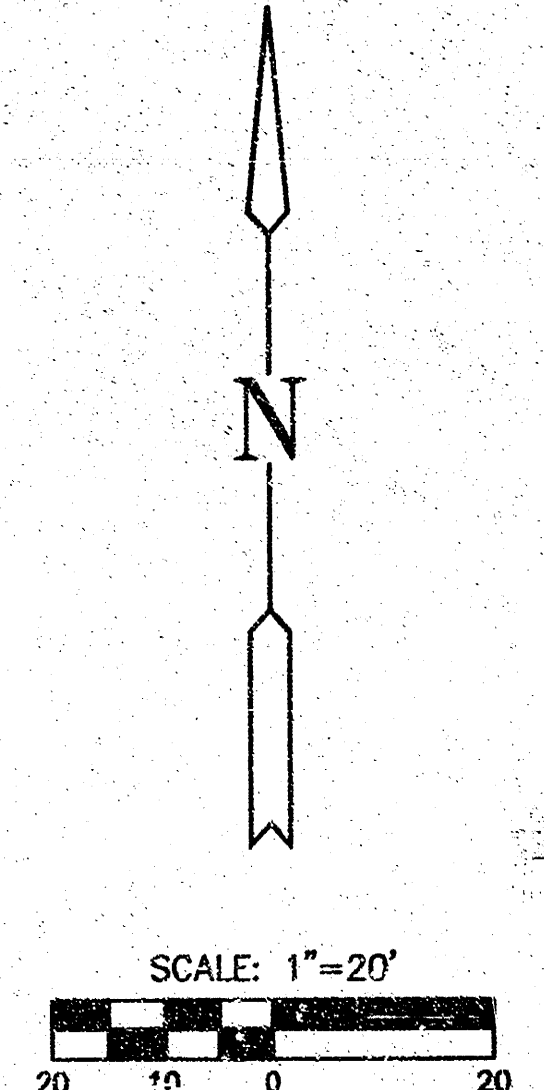

- BENCHMARKS**
- BM #1 CITY OF WICHITA BENCH MARK DISC IN N.E. COR. CONCRETE VAULT, 400'± WEST OF WEBB RD. ON N. SIDE OF 21ST STREET NORTH. ELEV.=205.70 CITY DATUM
 - BM #2 "0" CUT ON TOP OF E. CURB ON WEBB RD. 115' S. OF C/L 21ST STREET NORTH. ELEV.=202.85 CITY DATUM
 - BM #3 "0" CUT ON N.E. COR. HEADWALL OF RCB 85' S. & 50' E. OF SECTION COR. ELEV.=198.03 CITY DATUM


- LEGEND:**
- CO CLEANOUT
 - IRR IRRIGATION
 - W WATER
 - RL RAINLEADER
 - PAVEMENT REMOVAL

REVIS: 12/11/02

APPROVED AS NOTED
BY CITY ENGINEER OF WICHITA
STORM SEWERS UAH 12/18/02

NOTE TO CONTRACTOR

INSPECTION AND TESTING FOR THIS PROJECT IS TO BE PROVIDED BY A LICENSED CONSULTING ENGINEERING FIRM UNDER CONTRACT WITH THE CONTRACTOR. SAID INSPECTION TO BE IN ACCORDANCE WITH THE CITY OF WICHITA STANDARD CONSTRUCTION ENGINEERING PRACTICES AND CERTIFIED BY A LICENSED PROFESSIONAL ENGINEER. NO WORK SHALL BE PERFORMED IN DEDICATED EASEMENTS OR THE PUBLIC RIGHT-OF-WAY BY THE CONTRACTOR WITHOUT SUCH INSPECTION NOR SHALL ANY WORK BE COMMENCED IN DEDICATED EASEMENTS OR PUBLIC RIGHT-OF-WAY WITHOUT WRITTEN AUTHORIZATION BY THE CITY ENGINEER.

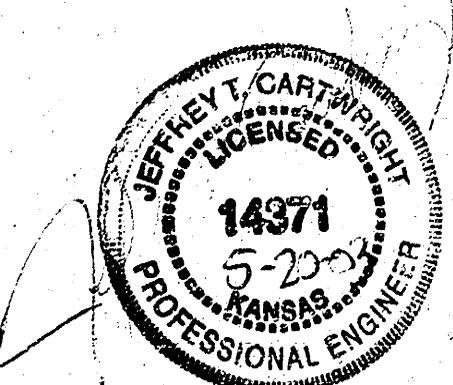

**PRIVATE STORM WATER SEWER TO
SERVE LOT 3, BLOCK 1, HANLEY COMMERCIAL ADD.
1299PPS (607861)**

MKEC
ENGINEERING
CONSULTANTS
4111 N. WEBB ROAD
WICHITA, KS 67202
316-262-4700

wcm
architects

Wilson Darnell Mann P.A.
105 N. Washington Wichita, Kansas 67202
ph 316.262.4700 fx 316.262.0002
www.wdndesign.com

Ground Round of Kansas
Prototype #4600

STORM WATER SEWER

PRINTS ISSUED
November 4, 2002
Dec. 13, 2002 - C.O. #1 - O/C/franchise

WON No. 02140
drawn: DAC
checked: JTC

CUI.I

© copyright 2002 Wilson Darnell Mann P.A.

