

General Notes

- Contractor will be required to provide notice to utility companies a minimum of twenty-four (24) hours prior to any excavation, as follows:

Kansas One-Call 687-2470

The Contractor must notify the following in case of an emergency:

Cablevision 262-4270
or
K & L Gas Service Company 263-2061
Kansas Gas & Electric Company 383-8650
Arkio Gas Company 383-8600
Southwestern Bell Telephone Company 942-8350
City of Wichita Water Department 1-571-2611
City of Wichita Sewer Maintenance 268-4908
263-4071


- Underground utility service lines and overhead utility pole lines are to be adjusted as necessary by others prior to construction unless the plans specifically call for their adjustment by the Contractor or unless the plans specifically identify a utility to be adjusted by its owner during construction. Existing utilities and their location, as shown on the plans, represent the best information obtainable for design. Location information has been obtained from the various utility companies and is either from company record drawings or company provided field locations. The Contractor will be required to work around existing utilities within the right-of-way which do not conflict with proposed construction.
- Rubble from the removal of miscellaneous structures and excess excavation which is to be wasted shall be disposed of on sites to be provided by the Contractor. These sites shall be approved by the Engineer as to suitability, appearance and site location. Locations that, in the opinion of the Engineer, will leave an unsightly appearance will not be approved.
- Trees and shrubs in public right-of-way which are in direct conflict with proposed new construction shall be removed by the Contractor with the Engineer's approval. Trees and shrubs which are not in direct conflict with proposed new construction shall be saved and protected from damage.
- The Contractor shall give all property owners and/or tenants of developed property directly abutting the construction of this project a minimum of ten (10) days advance notice prior to start of construction.
- The Contractor shall be responsible for preserving property lines. The Contractor will be required to re-establish any property lines which are damaged or destroyed by his construction operations. Such lines shall be re-established by a licensed land surveyor in accordance with state law.
- The Contractor shall seed all areas disturbed by construction operations as per City of Wichita AR-78 for site restoration.

BENCHMARK


RR Spike in Power Pole Located
1/2 Block North of Intersection
of Maple & Hiram.

Elevation = 113.50 (City Datum)

PART OF UNIVERSITY PLACE ADDITION

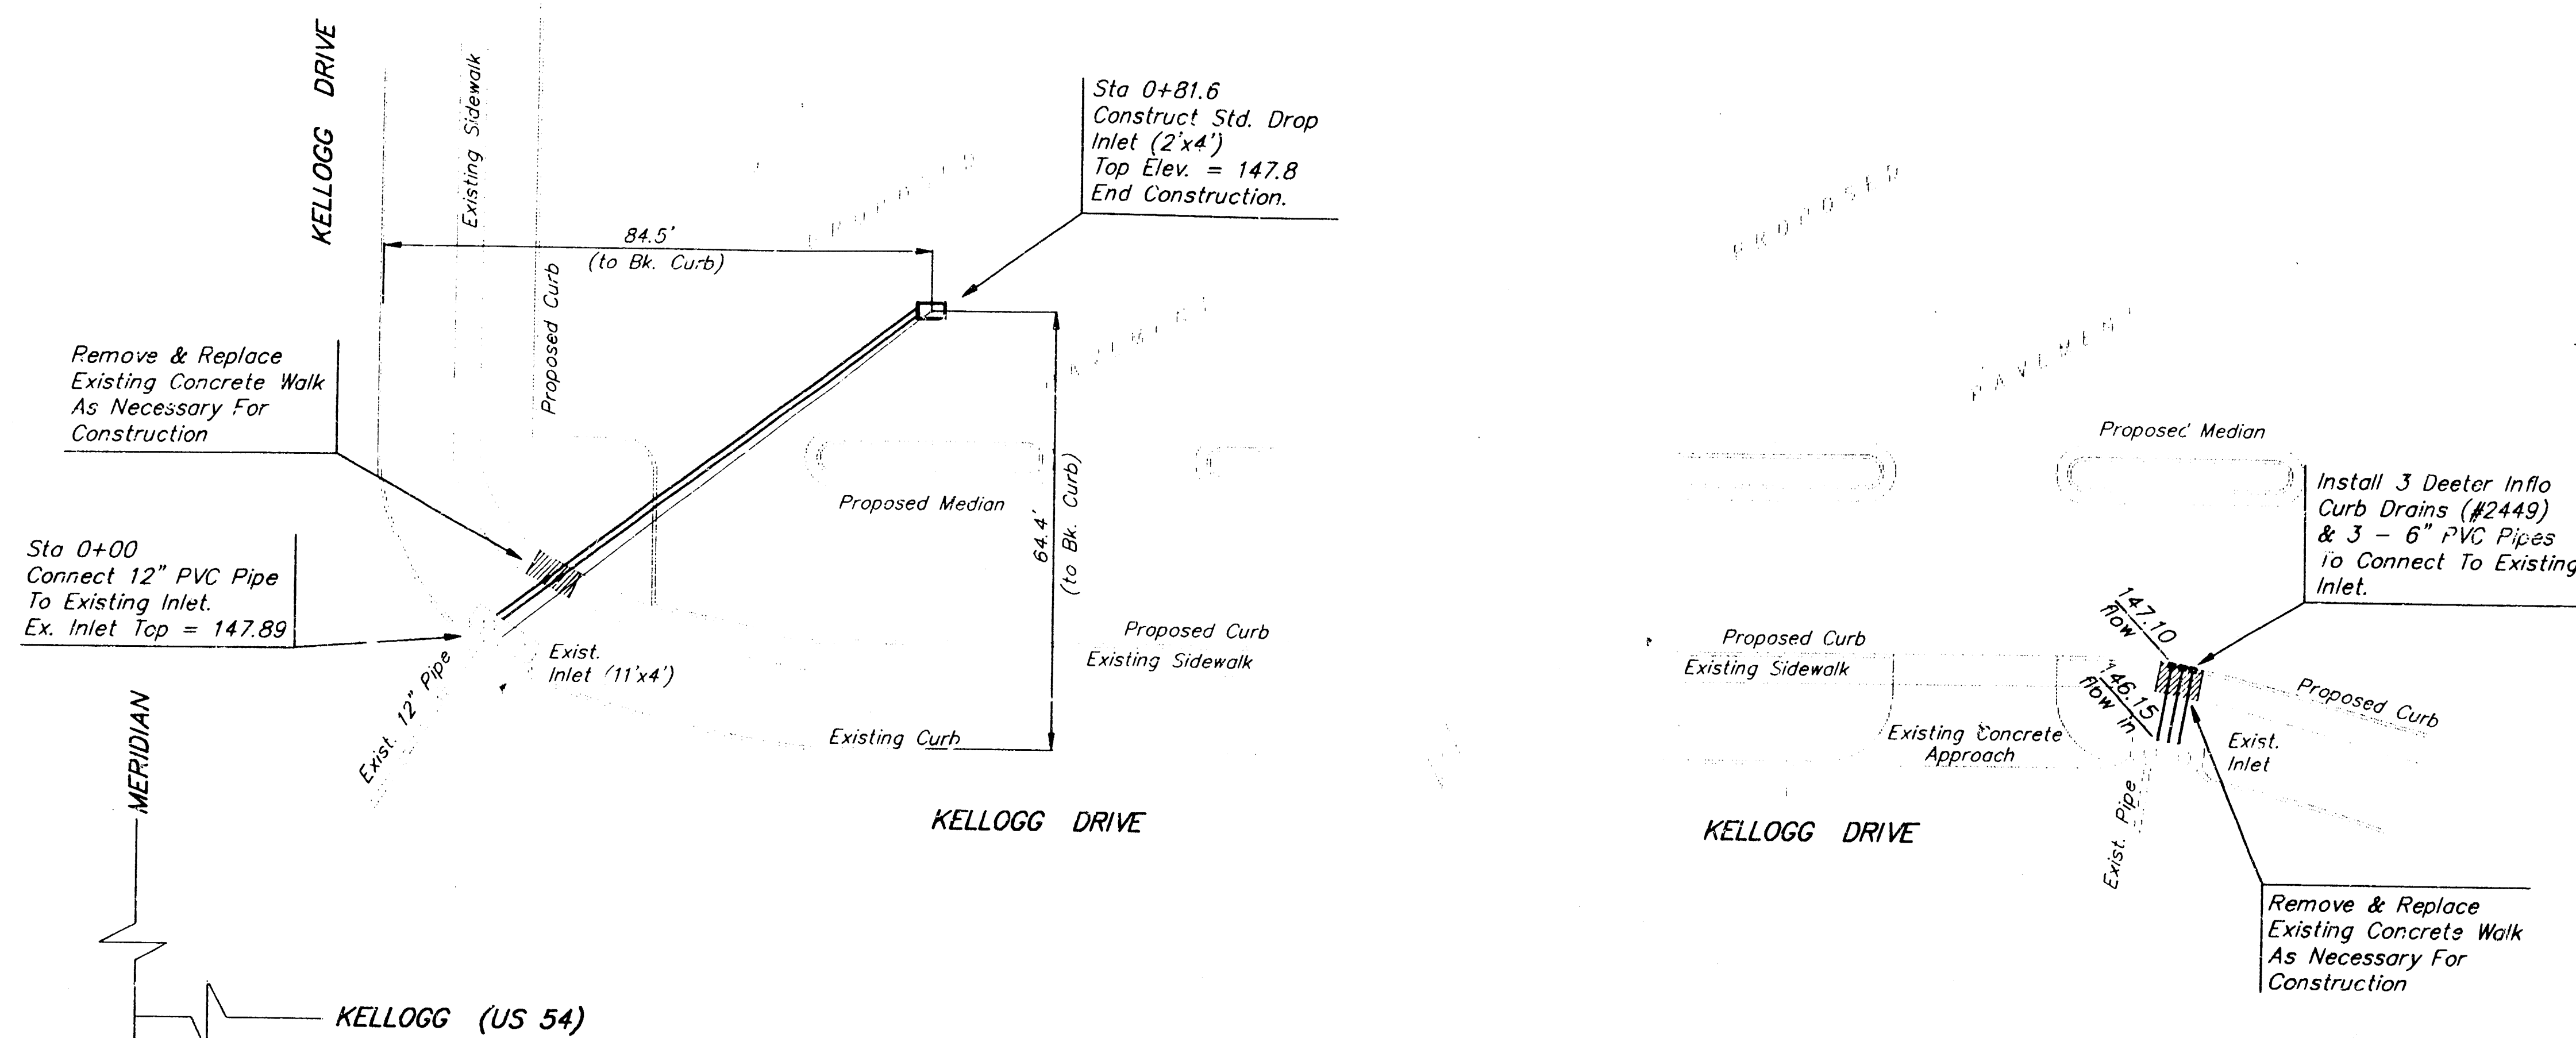

SCALE:
1"=20' Horizontal
1"=5' Vertical


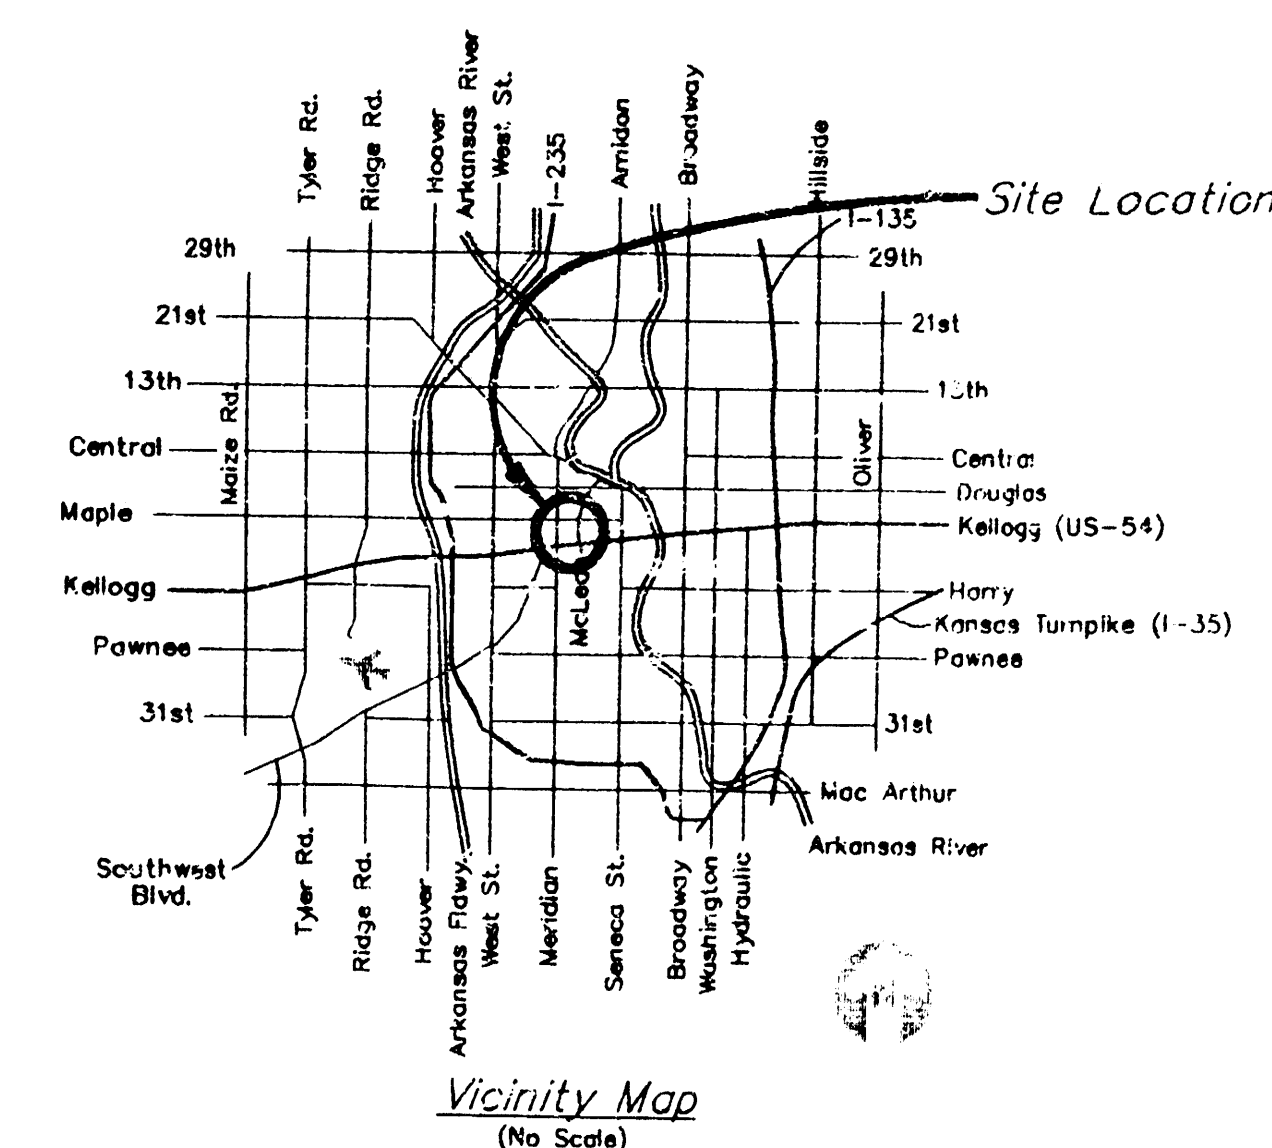


APPROVED AS NOTED
BY CITY ENGINEER OF WICHITA



Storm Sewers VRR 7/13/95

NOTE TO CONTRACTORS

Inspection and testing for this project is to be provided by a Licensed Consulting Engineering Firm under contract with the Owner/Developer. Said inspection is to be in accordance with the City of Wichita standard construction engineering practices and certified by a Licensed Professional Engineer. No work shall be performed in dedicated easements or public right-of-way by the Contractor without such inspection nor shall any work be commenced without written authorization by the City Engineer. All Construction and Materials shall comply with the City of Wichita Specifications and Standards (on file and available in the City Engineer's Office).

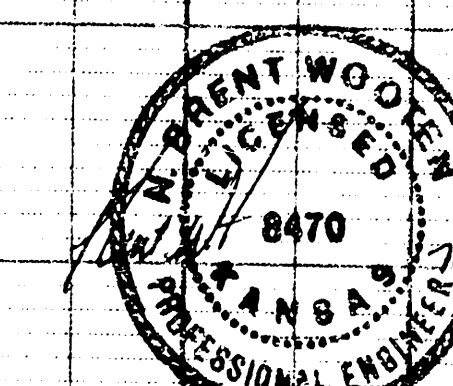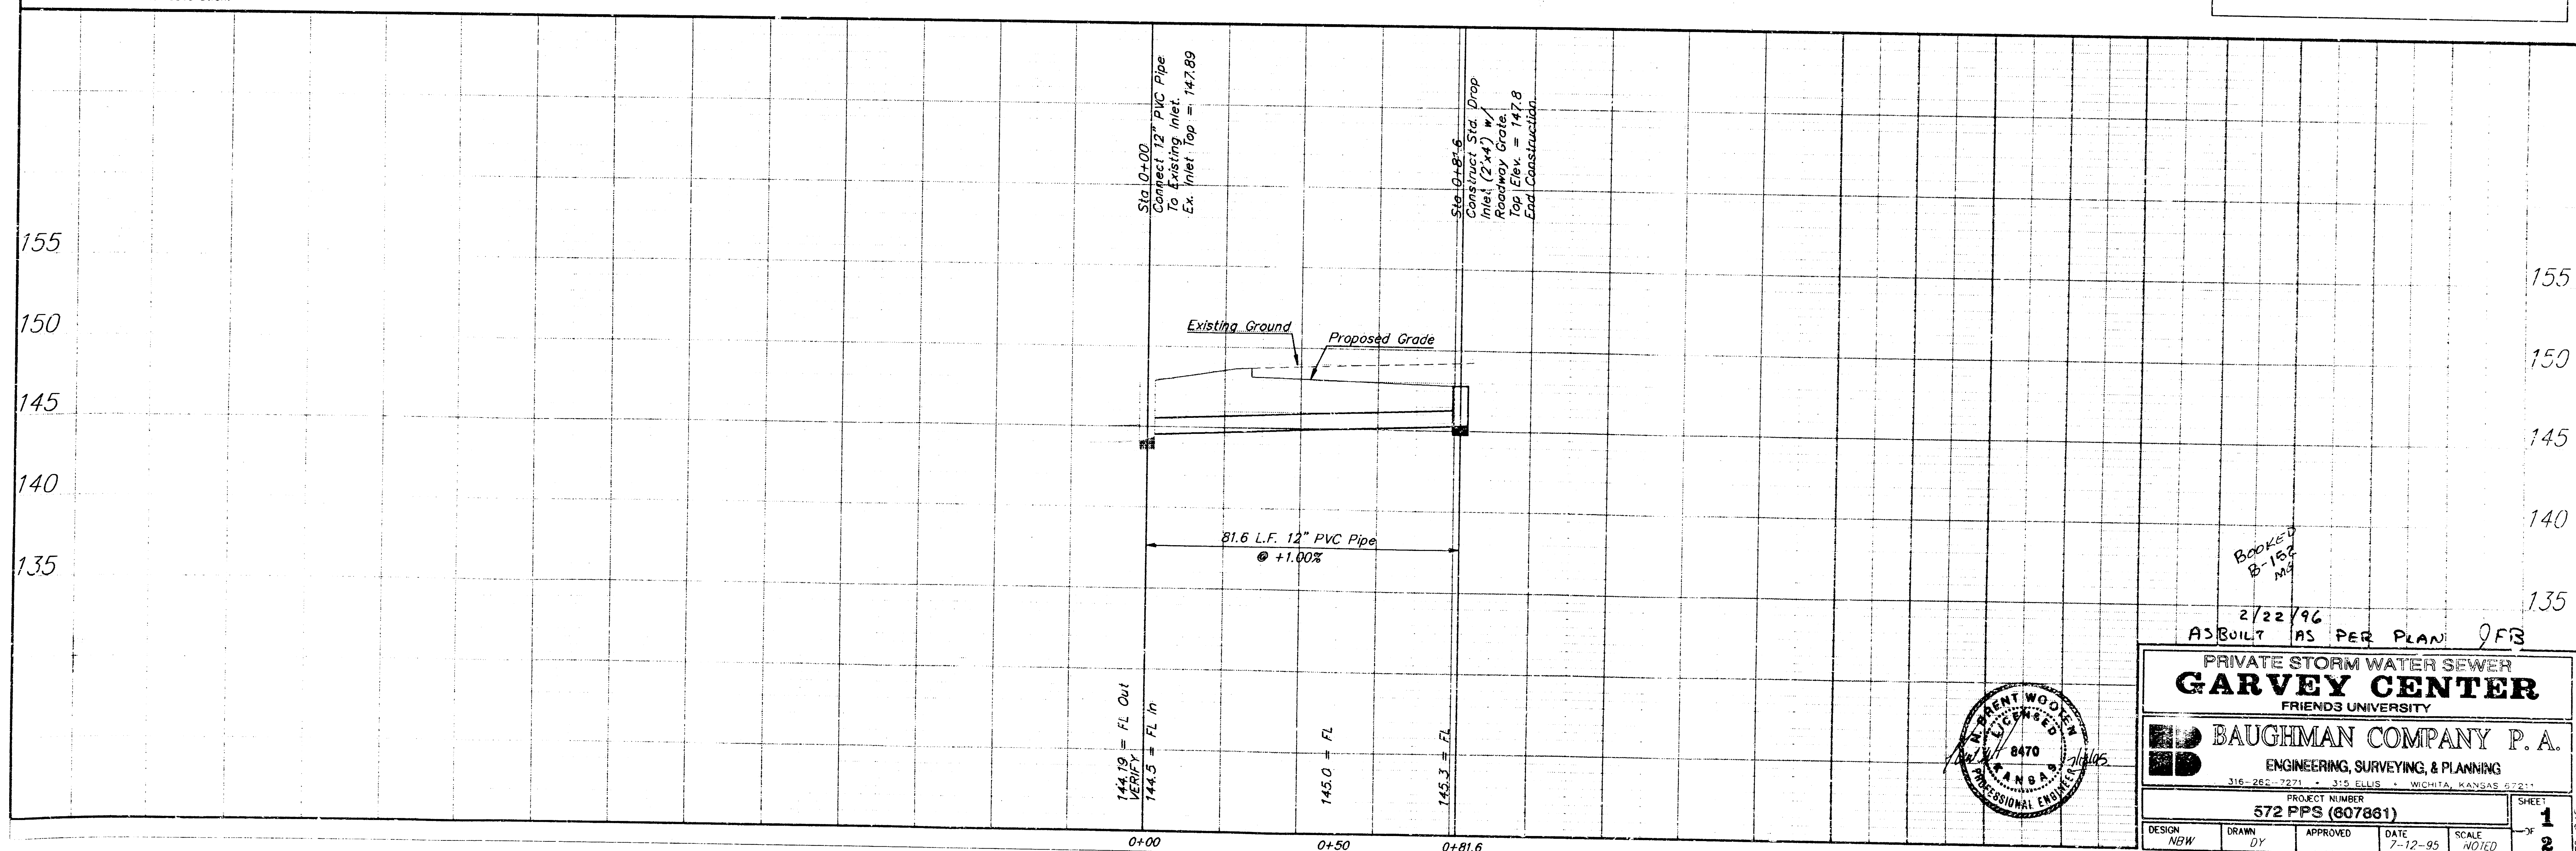


PRIVATE STORM WATER SEWER			
GARVEY CENTER			
FRIENDS UNIVERSITY			
BAUGHMAN COMPANY P. A.			
ENGINEERING, SURVEYING, & PLANNING			
316-262-7221 • 315-ELLS • WICHITA, KANSAS 67211			
PROJECT NUMBER		SHEET	
572 PPS (807881)		1	
DESIGN	DRAWN	APPROVED	DATE
NEW	BY	NOTED	7-12-95

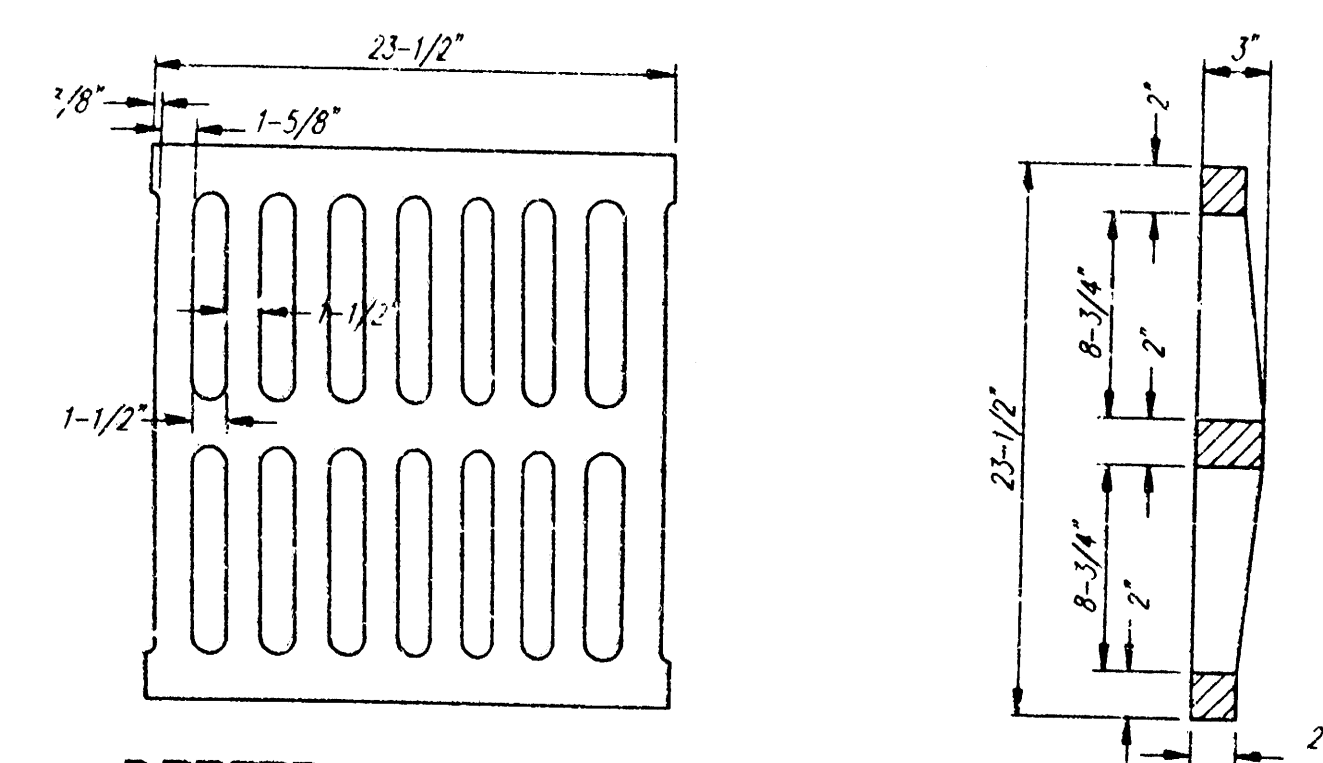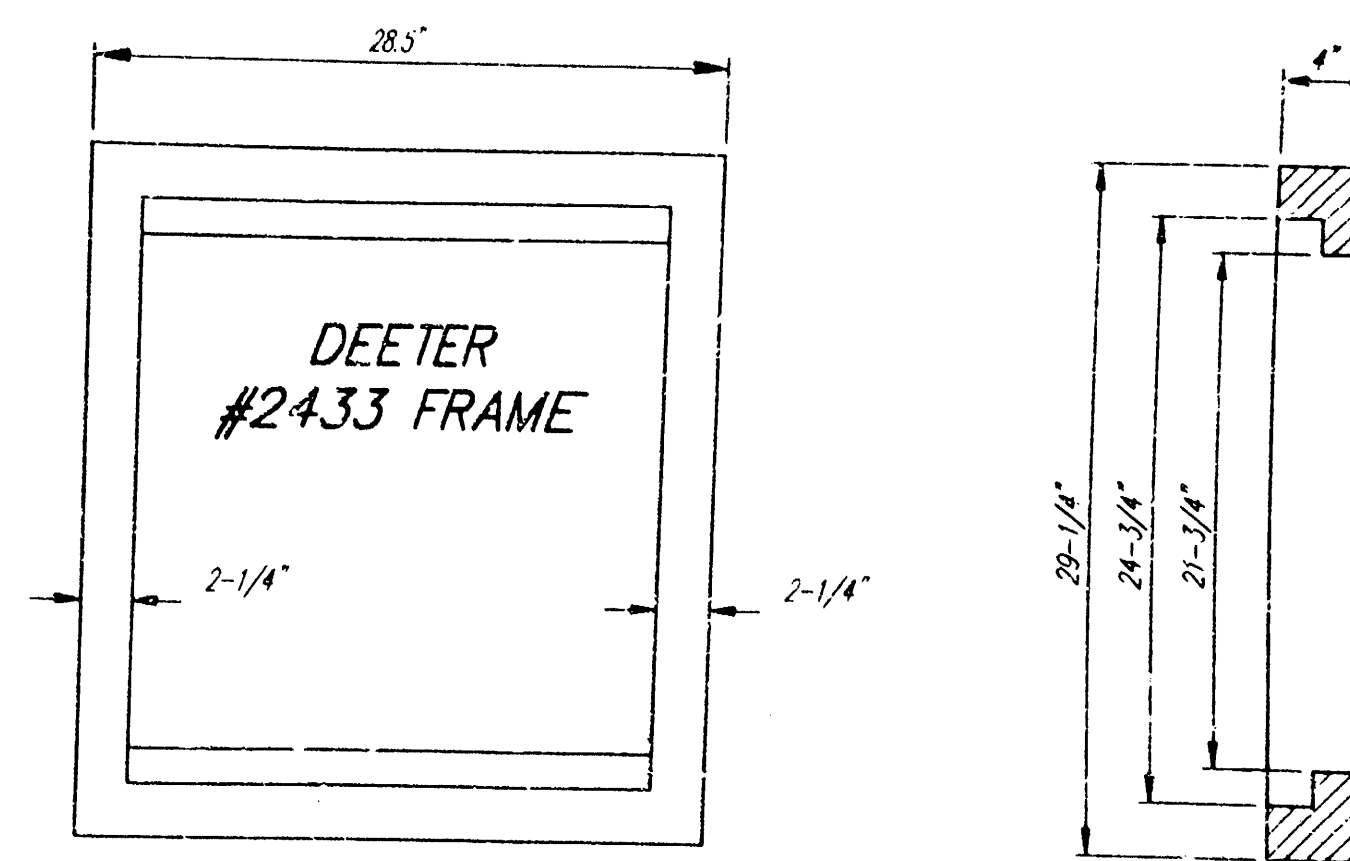



DEETER #2433 GRATE

24" x 24" Frame and Grate Detail




NOTE: Grates shall be imprinted on the top surface with "CITY OF WICHITA" using letters at least 1" in height. Other marking methods may be approved by the engineer.

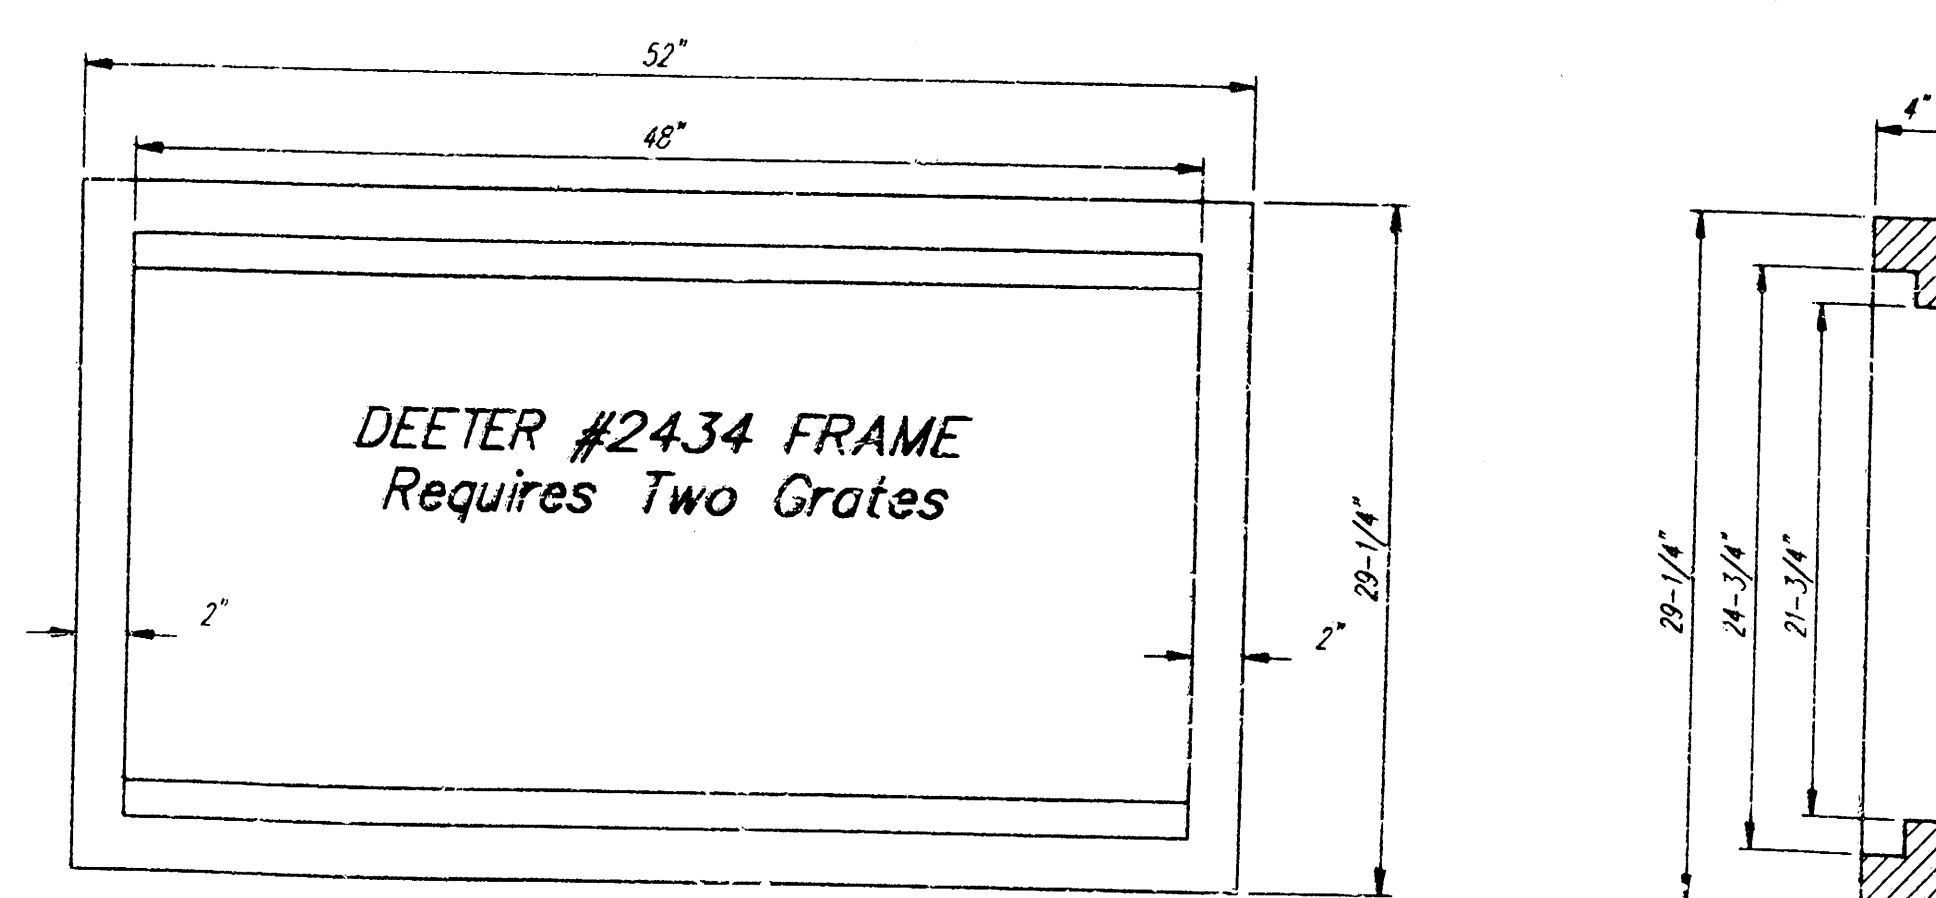

Double 24" x 24" Frame Detail

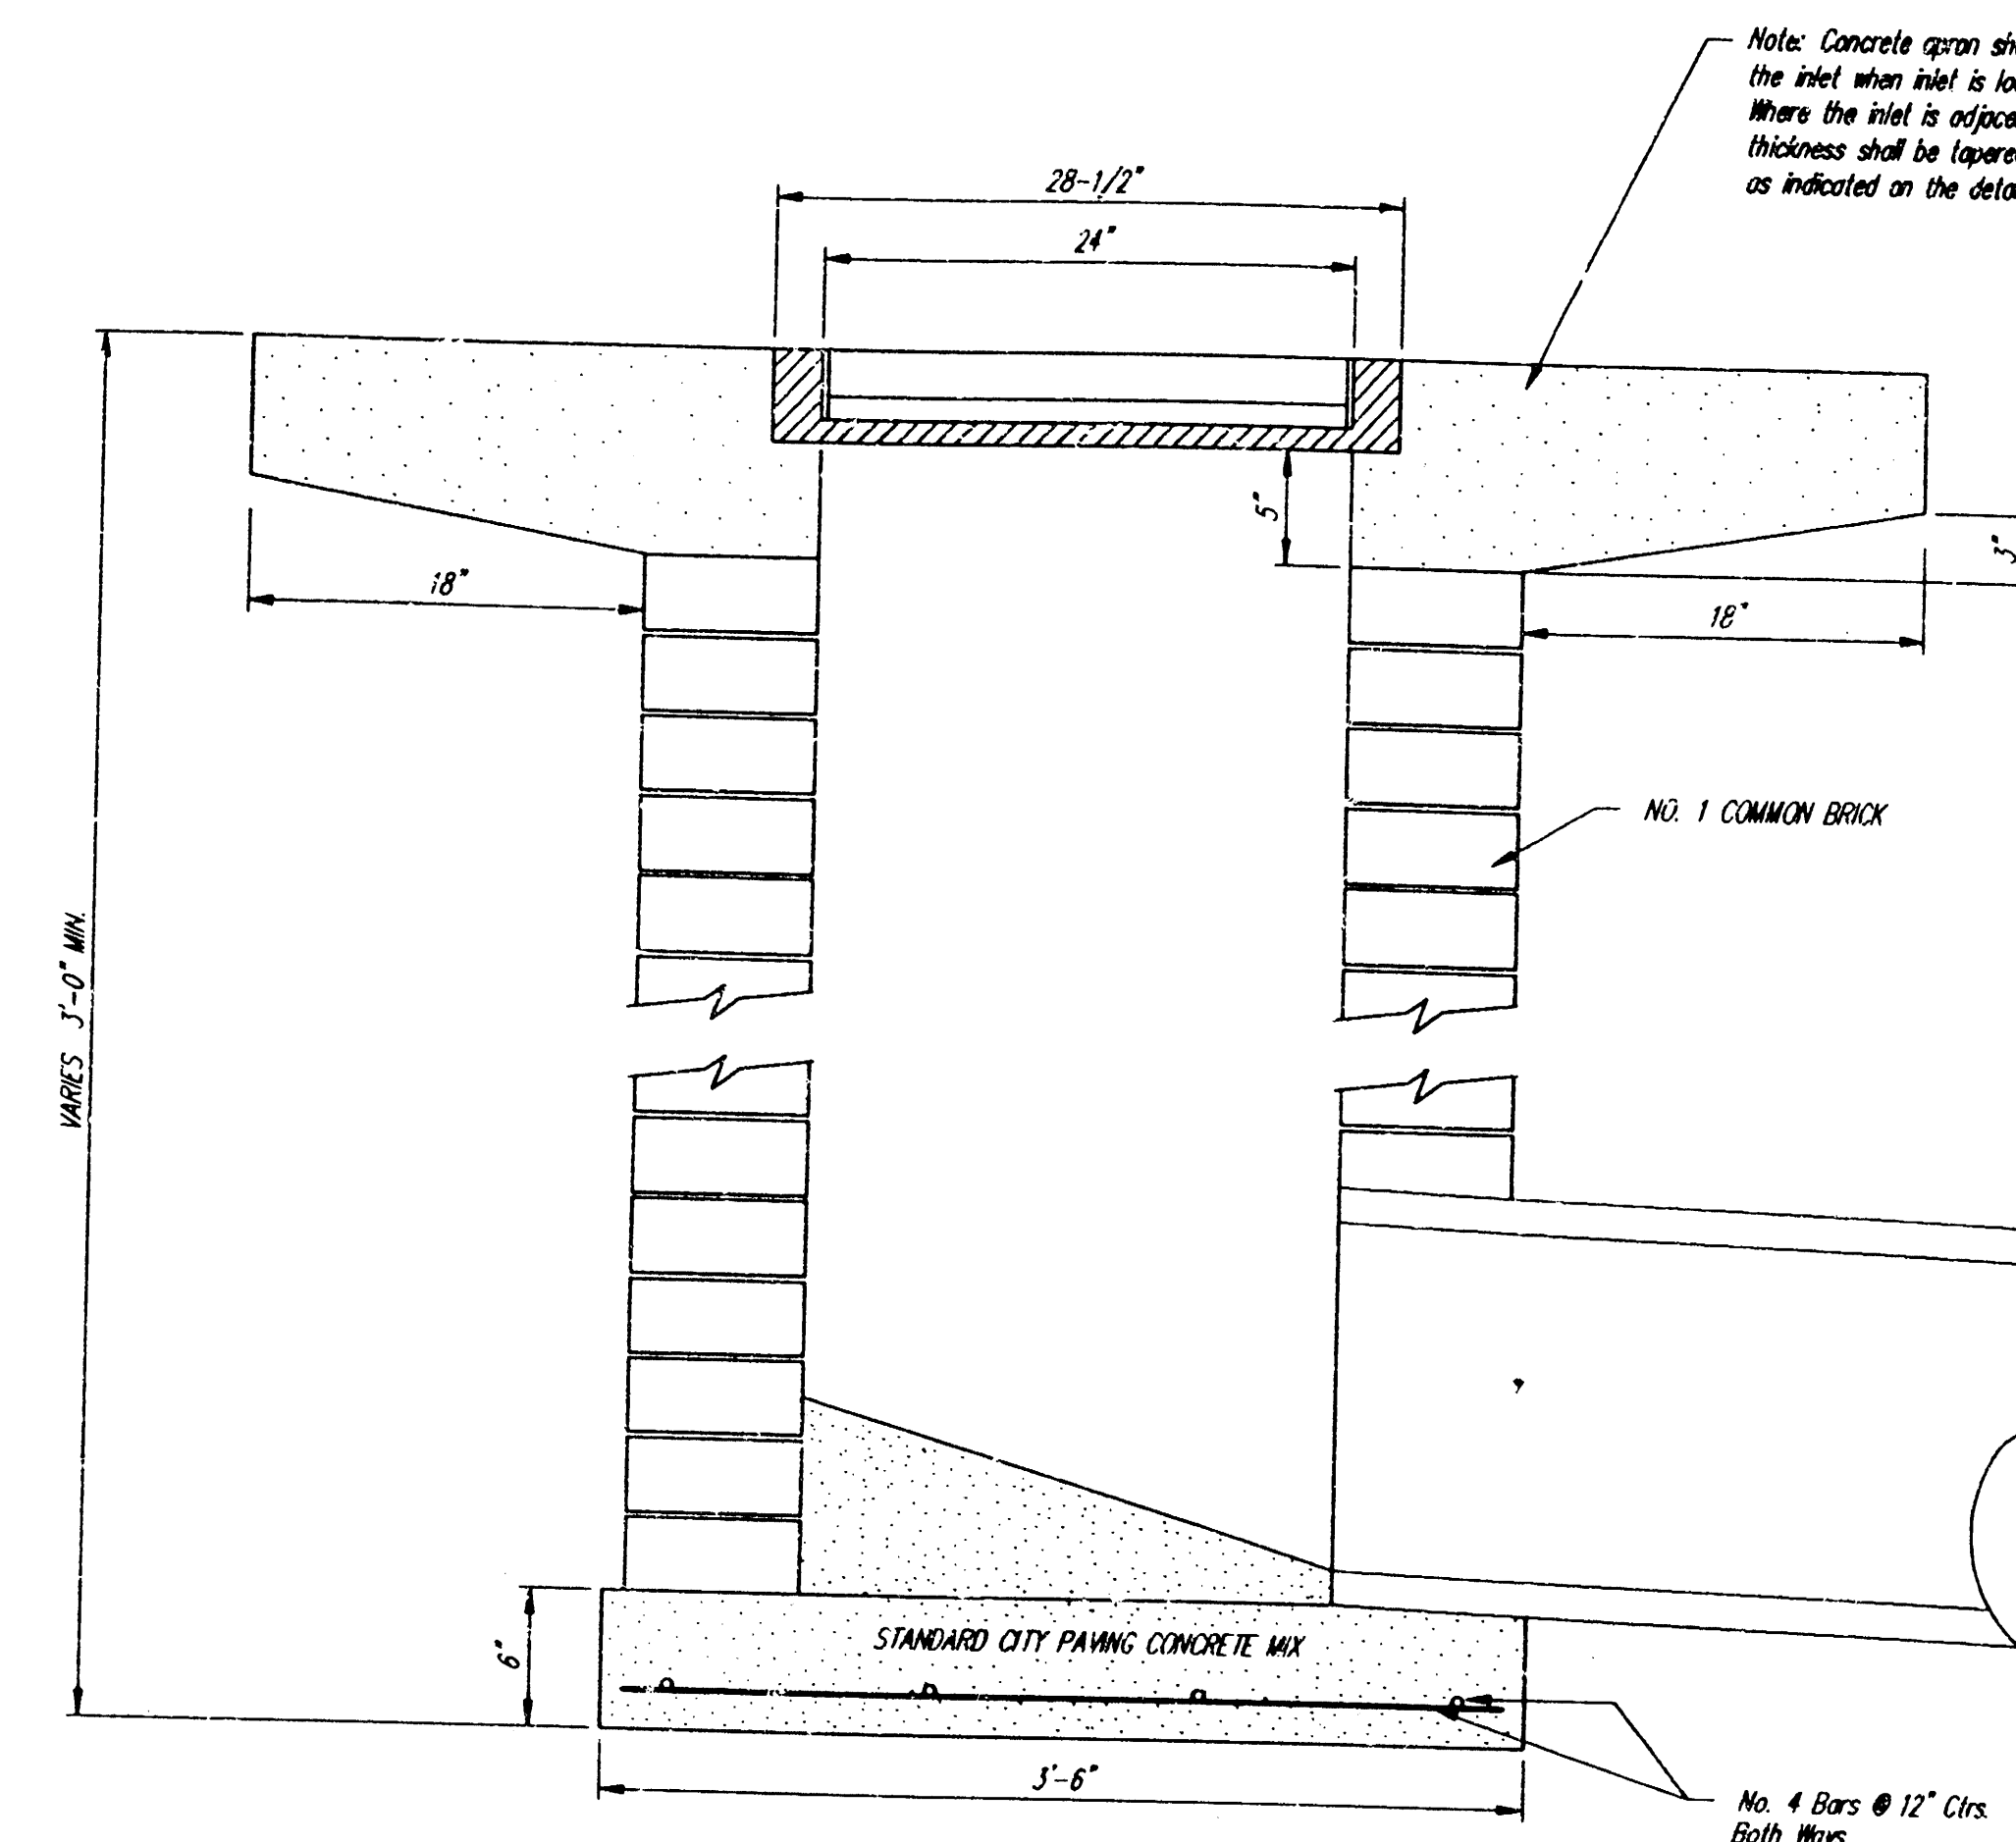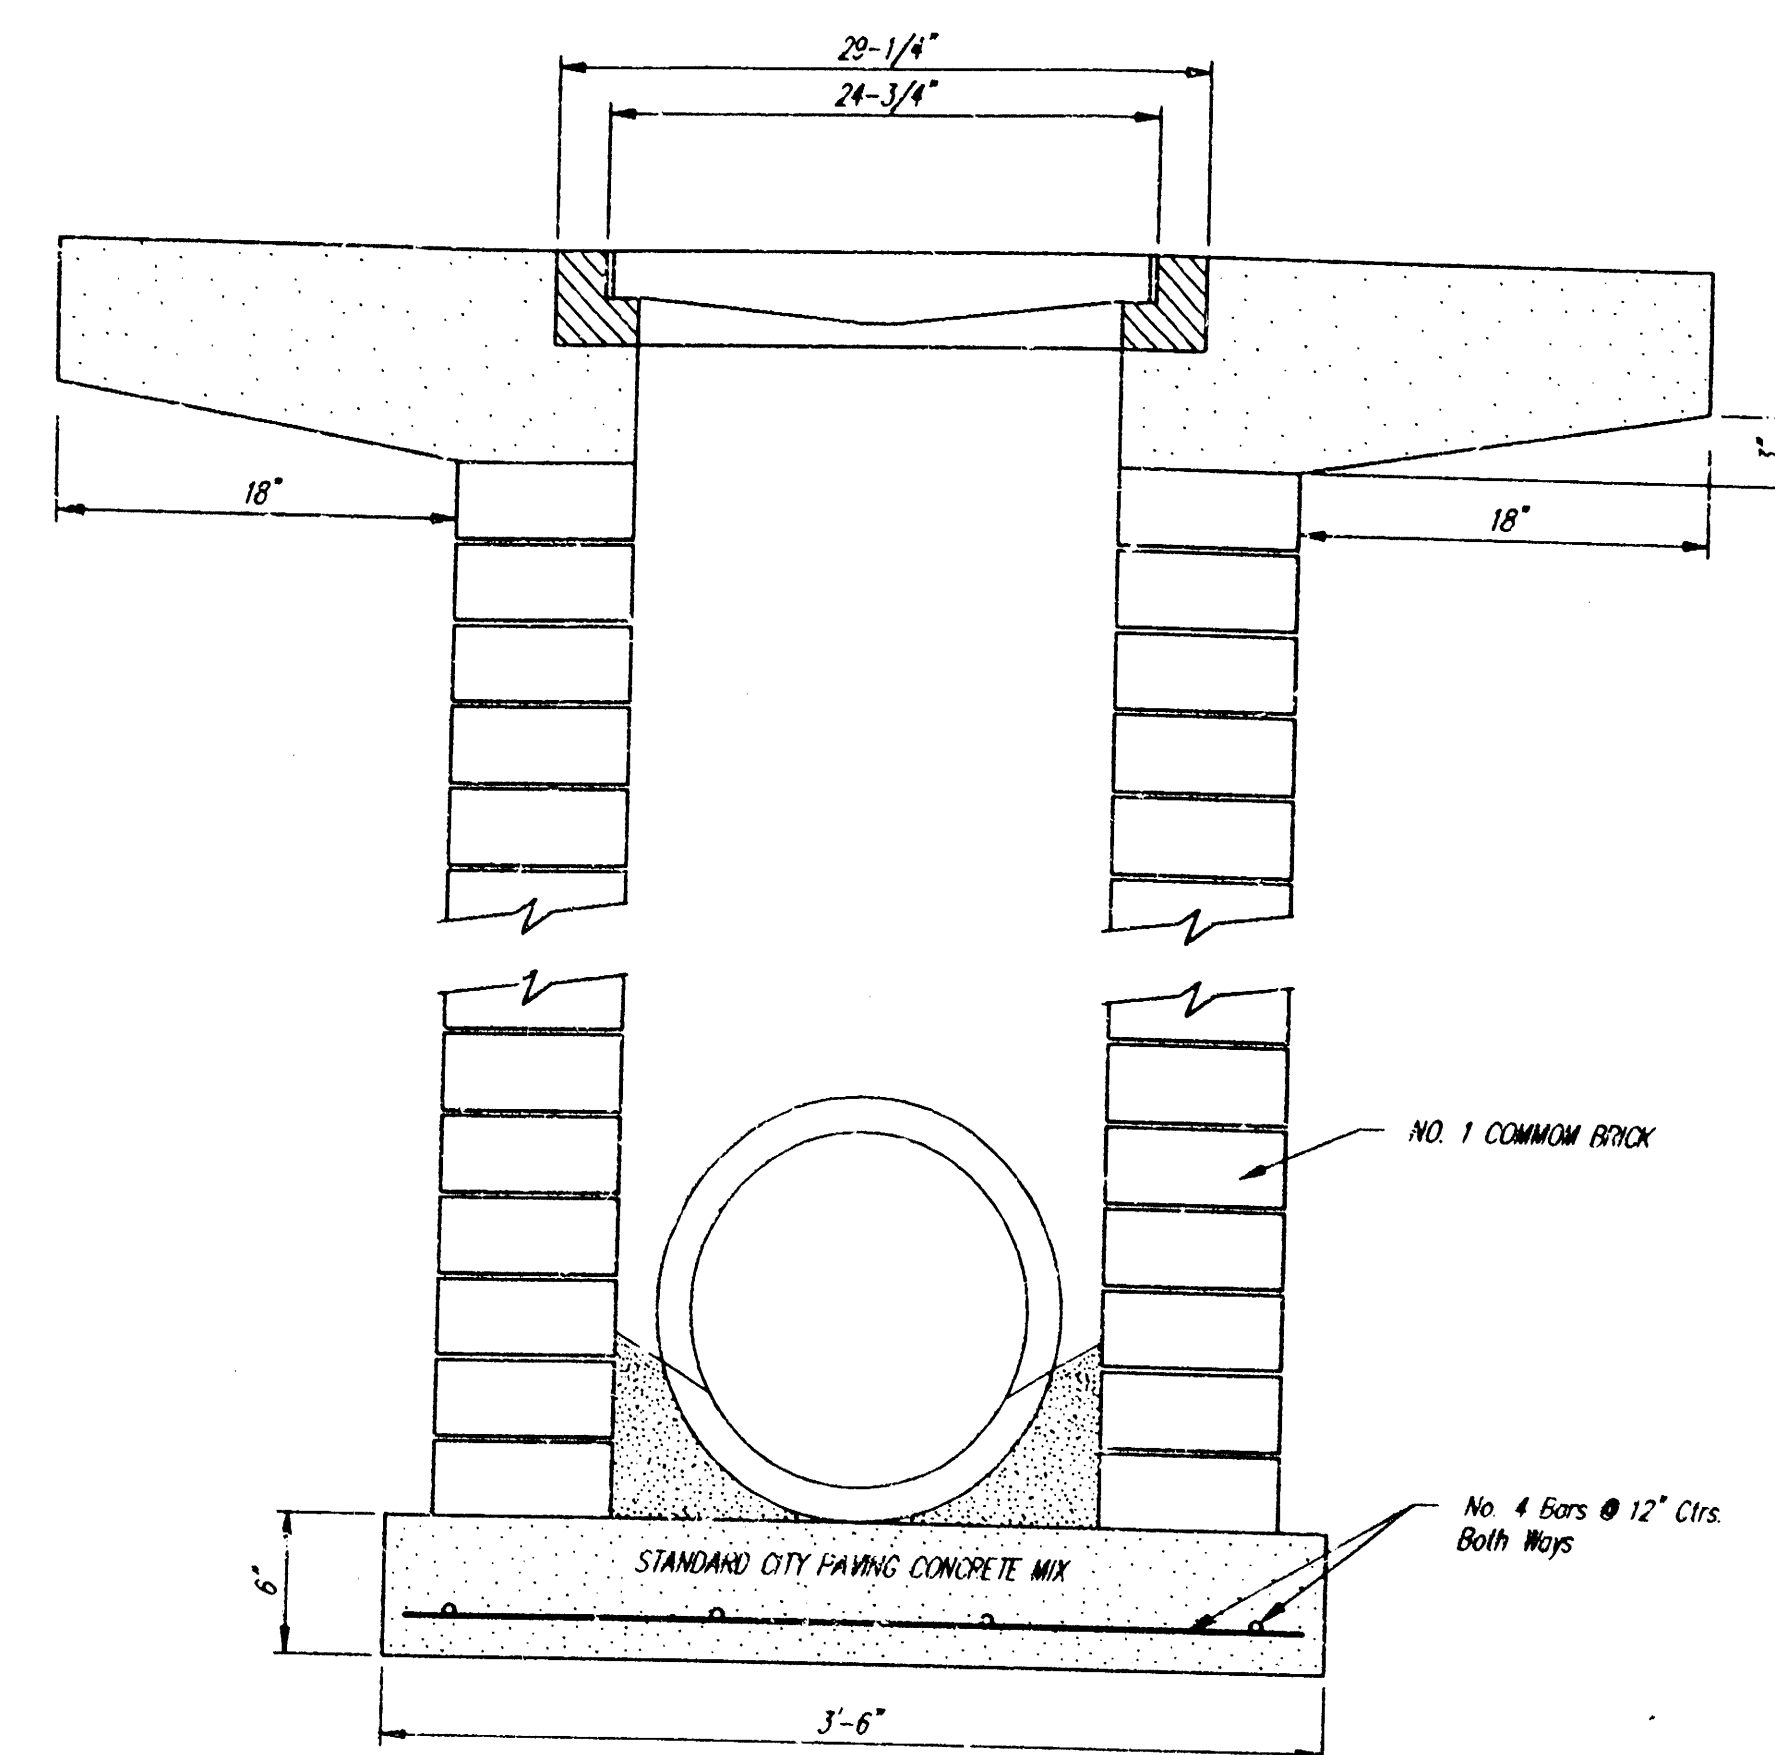

Note: Concrete apron shall be constructed around the inlet when inlet is located in an unimproved area. Where the inlet is adjacent to pavement, the pavement thickness shall be figured to the inlet in 18 inches as indicated on the detail.

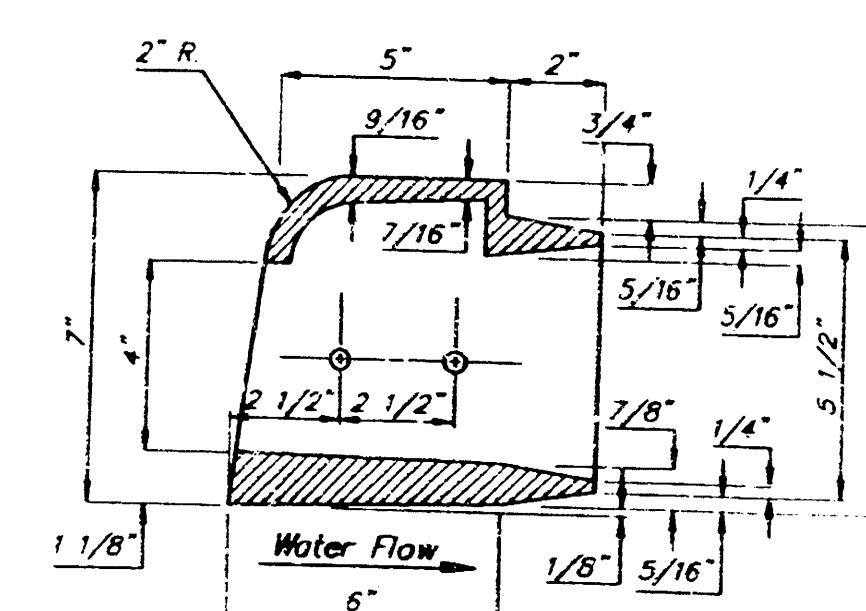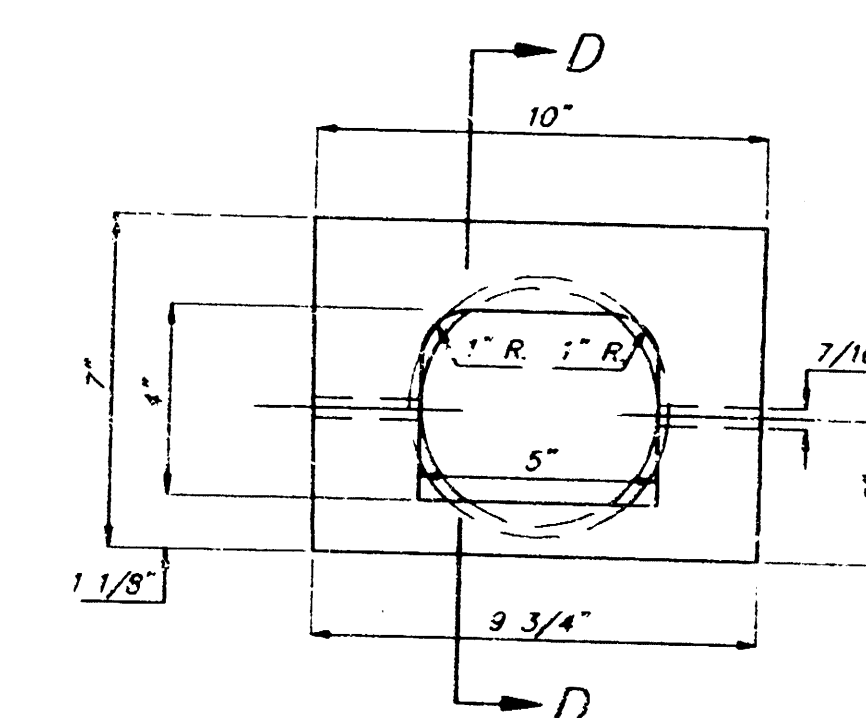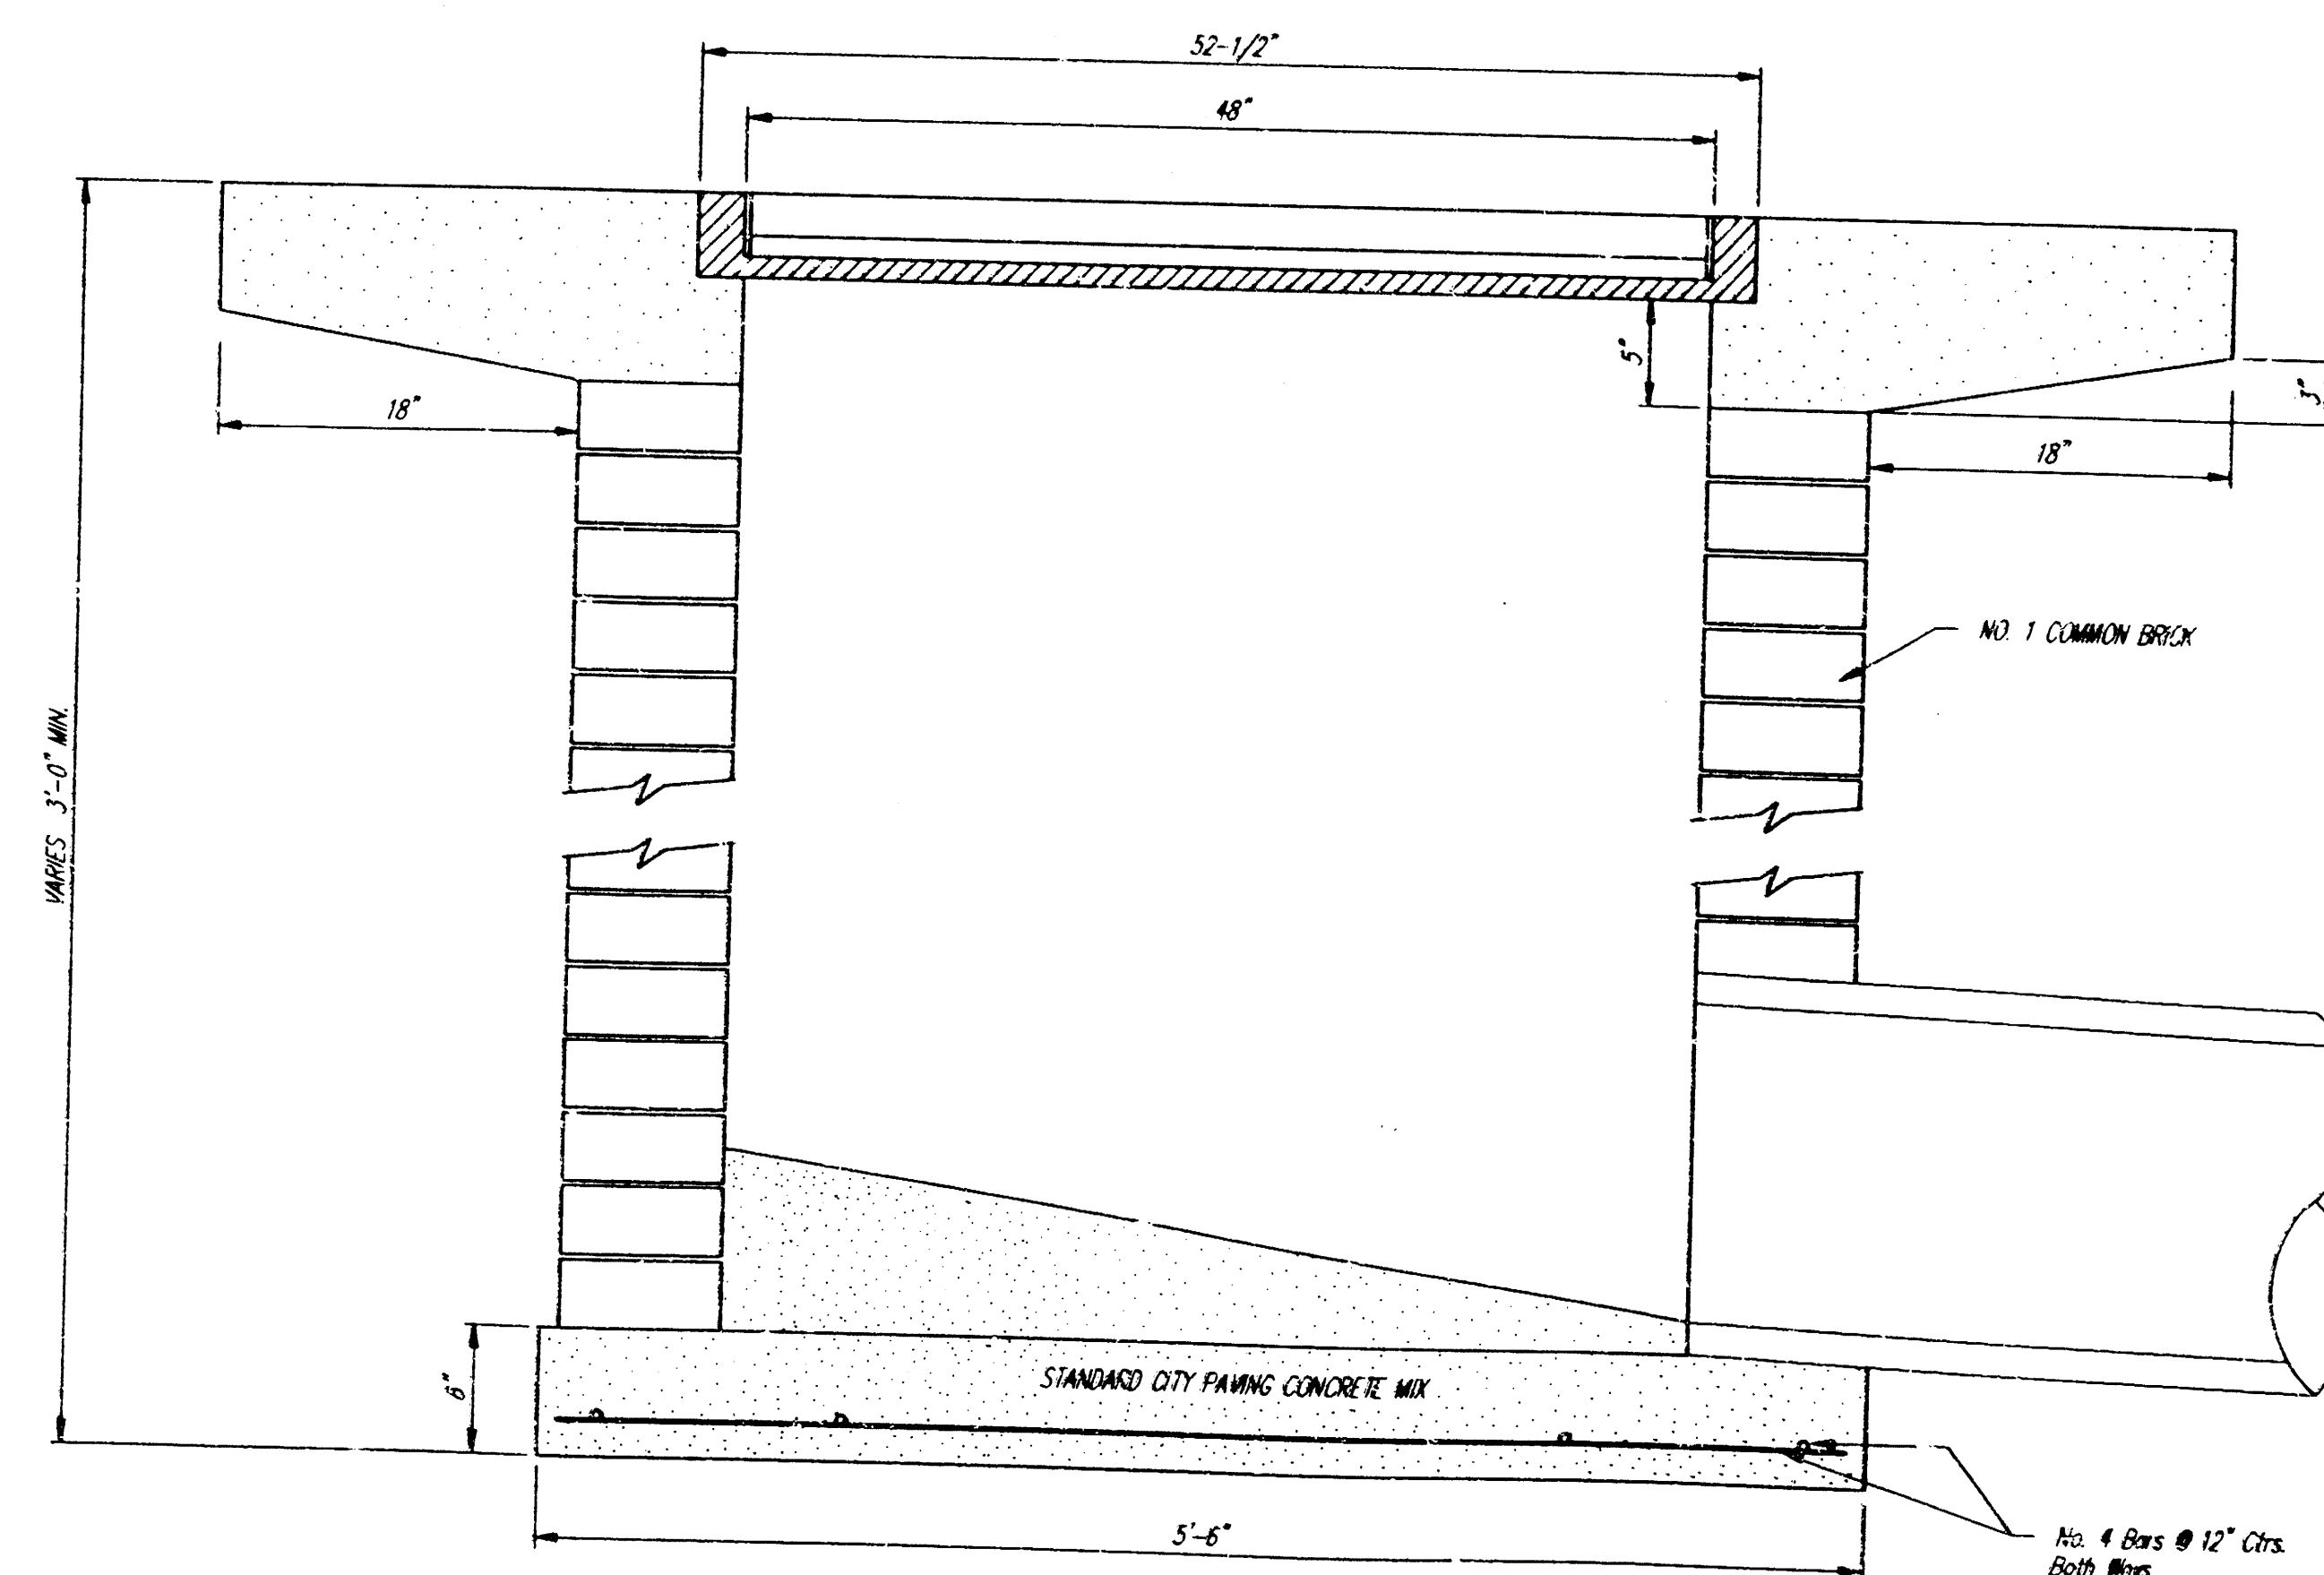

SECTION D-D

DEETER CURB DRAIN
#2449 - 6" CURB (IN-FLOW)
EST. WT. = 40 LBS.

City of Wichita Standard			
Drop Inlet Details			
With Deeter Curb Drain Detail			
BAUGHMAN COMPANY P. A.			
ENGINEERING, SURVEYING, & PLANNING			
318-262-7271 • 315 ELLIS • WICHITA, KANSAS 67201			
PROJECT NUMBER			
572 FPS (607861)			
DESIGN	DRAWN	APPROVED	DATE
			7-12-95
SCALE			None
SHEET			2
OF			2