


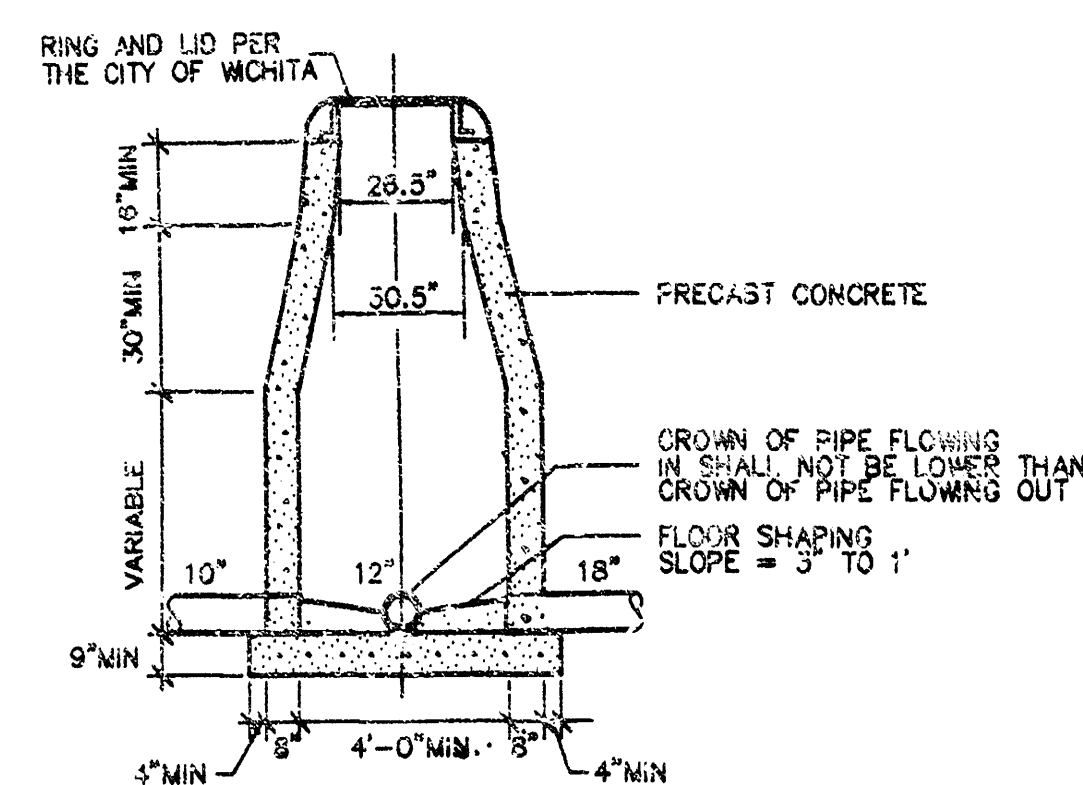

PRECAST MANHOLE DETAIL
NO SCALE

STORM WATER SEWER TO SERVE RESERVE IN FANTASEA LOT 1

CITY OF WICHITA, KANSAS

Michael E. Lindebak, P.E. City Engineer

Private Project Number

1107PPS (607851)

FEBRUARY 2002

APPROVED AS NOTED
BY CITY ENGINEER OF WICHITA

Storm Sewers VRH 2/15/02

NOTE TO CONTRACTORS


Installation, inspection and testing for this project is to be provided by a Licensed Consulting Engineering firm under contract with the Owner/Developer. Said inspection to be in accordance with the City of Wichita standard construction engineering practices and certified by a Licensed Professional Engineer. No work shall be performed in dedicated easements or public right-of-way by the Contractor without such inspection nor shall any work be commenced without written authorization by the City Engineer. All construction and materials shall comply with the City of Wichita Specifications and Standards (on file and available in the City Engineer's office).

BENCHMARK


Cut "□" on top of hubguard @ east side of 10'x3' RCD
Elev. = 109.05 (city datum)

- GENERAL NOTES -


1. REFER TO SITE SURVEY SHEET C12-1 FOR ALL UTILITY DESCRIPTIONS, NOTES, AND LEGAL DESCRIPTIONS PERTAINING TO THE EXISTING SITE.
2. THE INSTALLING CONTRACTOR IS RESPONSIBLE TO REVIEW ALL ARCHITECTURAL, MECHANICAL, STRUCTURAL, ELECTRICAL DRAWINGS FOR CONFLICTS AND/OR DISCREPANCIES.
3. COORDINATE CONNECTION OF MECHANICAL SYSTEMS WITH EXISTING UNDERGROUND AND OVERHEAD UTILITIES AND SERVICES. COMPLY WITH REQUIREMENTS OF GOVERNING REGULATIONS, FRANCHISED SERVICE COMPANIES, AND CONTROLLING AGENCIES. PROVIDE REQUIRED CONNECTION FOR EACH SERVICE.
4. MATERIAL FOR ALL STORM SEWER PIPING 15" AND SMALLER SHALL BE ASTM D 3034, SDR 35, FOR SOLVENT-CEMENTED OR GASKETED JOINTS. 16" AND LARGER PVC ASTM F 875, T-1 WALL THICKNESS BELL AND SPIGOT FOR GASKETED JOINTS WITH ASTM F 477 ELASTOMERIC SEALS.

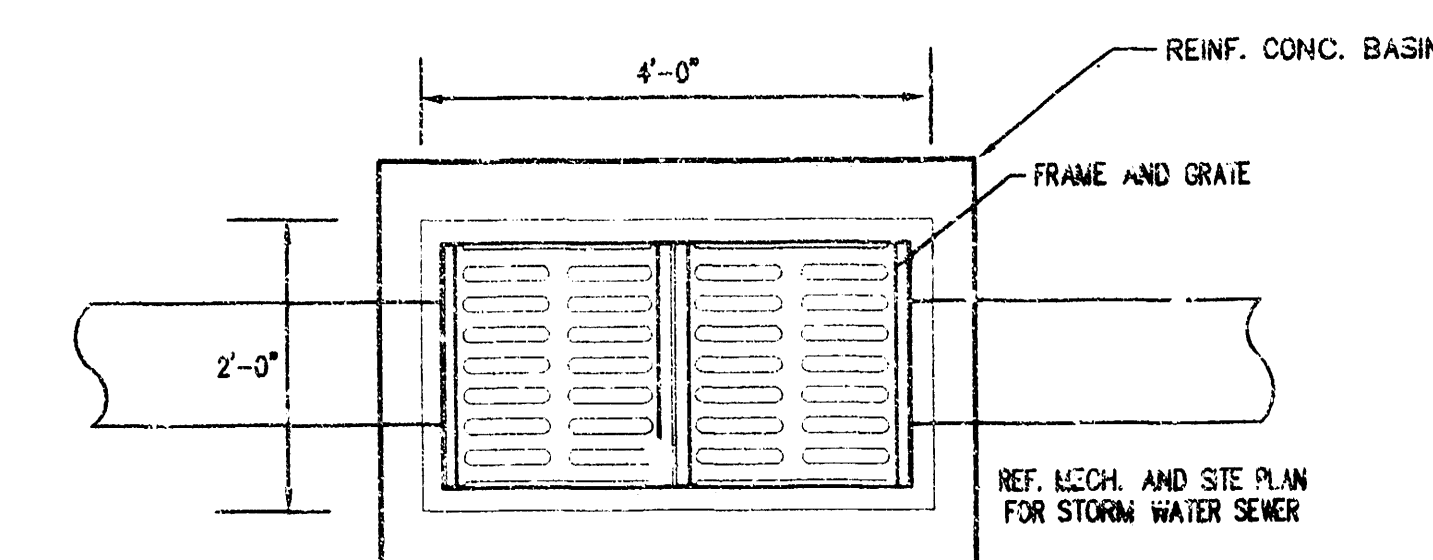

CATCH BASIN - PLAN
N.T.S.

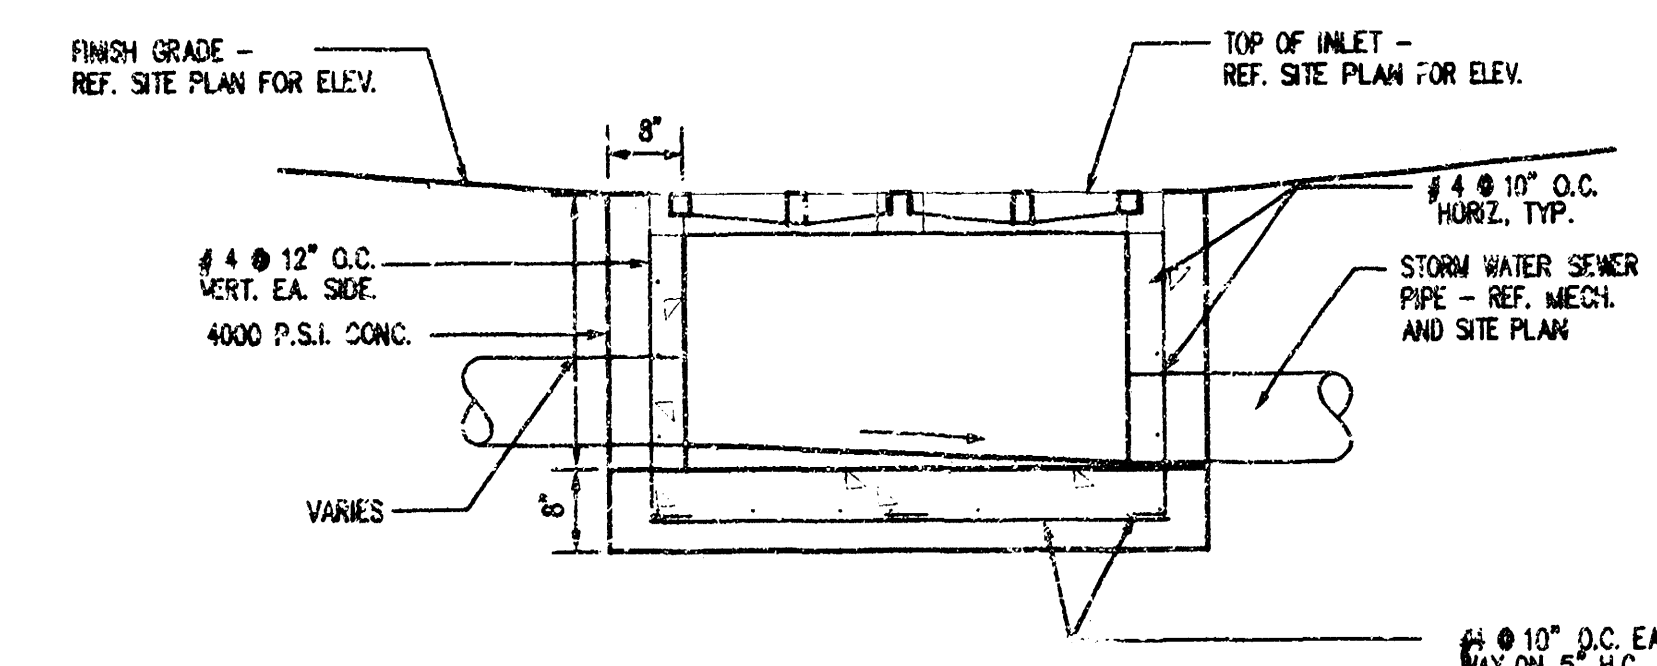

CATCH BASIN - SECTION
N.T.S.

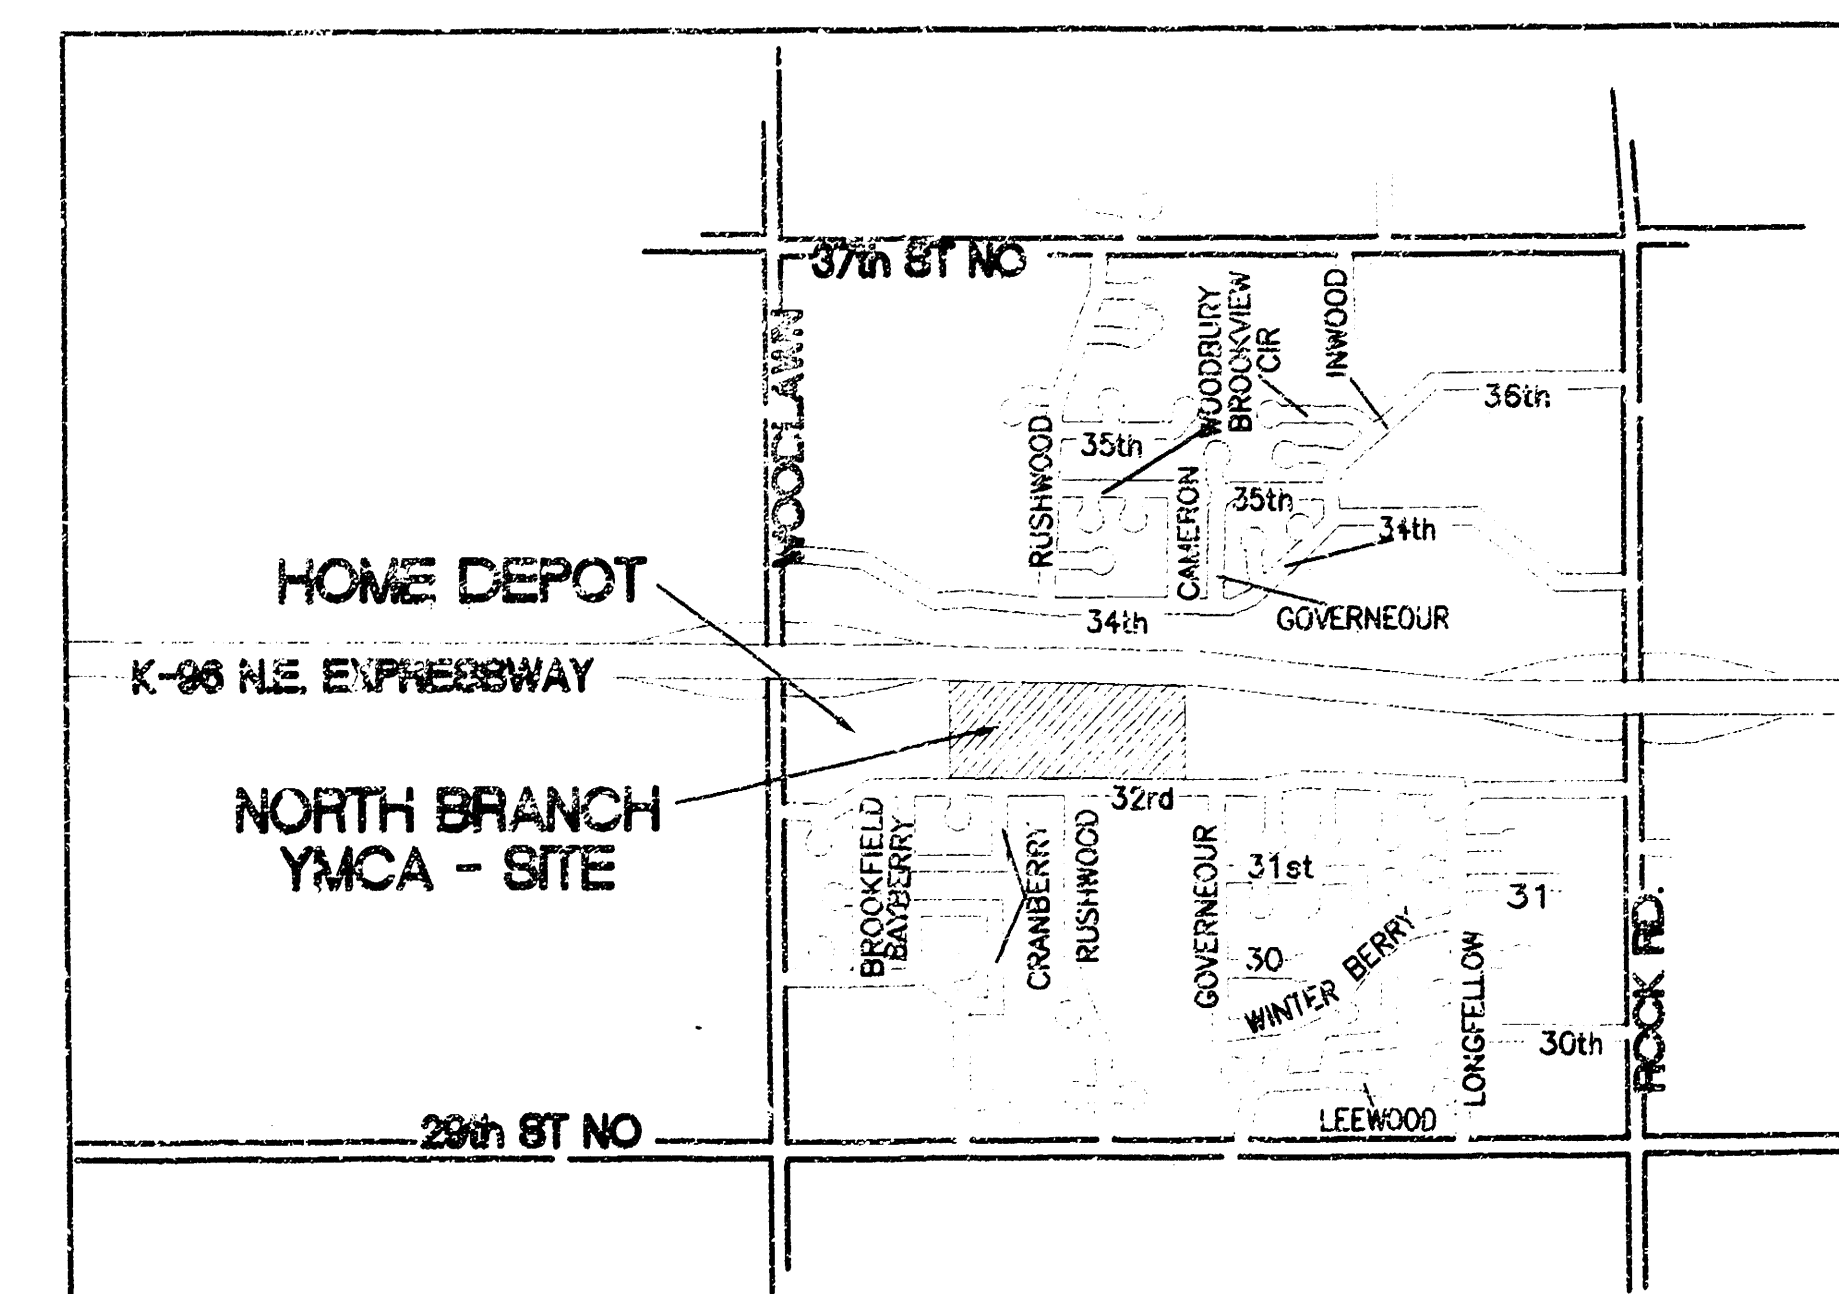


LOCATION MAP A. Built 9/02 KK Baughman Co.

DRAIN STRUCTURE SCHEDULE

MARK	STRUCTURE	TOP ELEV.	INVERT ELEV.	LINEAR FEET	SLOPE	REMARKS
A	CATCH BASIN	178.00	178.00	—	.5%	PRECAST
B	CATCH BASIN	178.00	178.00	100.00	.5%	PRECAST
C	CATCH BASIN	178.00	178.00	100.00	.5%	PRECAST
D	CATCH BASIN	178.00	178.00	100.00	.5%	PRECAST
E	CATCH BASIN	178.00	178.00	100.00	.5%	PRECAST
F	END SECTION	178.00	178.00	250.00	.5%	PRECAST
G	END SECTION	178.00	178.00	—	.3%	PRECAST
H	MANHOLE	178.00	178.00	—	.5%	PRECAST
J	MANHOLE	181.00	178.00	100.00	.5%	PRECAST

STORM WATER SEWER PLAN
SCALE 1" = 40'

Booked
E-9
1/03/04
RDL

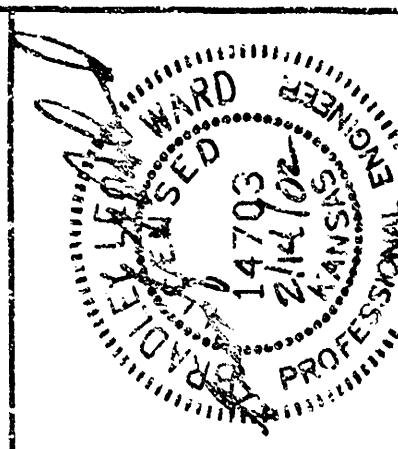

SCHAEFER JOHNSON COX FEEY & ASSOCIATES P.A.
14703
12/31/04
PROFESSIONAL ENGINEER
STATE OF KANSAS
MICHAEL E. LINDEBAK
P.E.

YMCA

YMCA NORTH BRANCH