



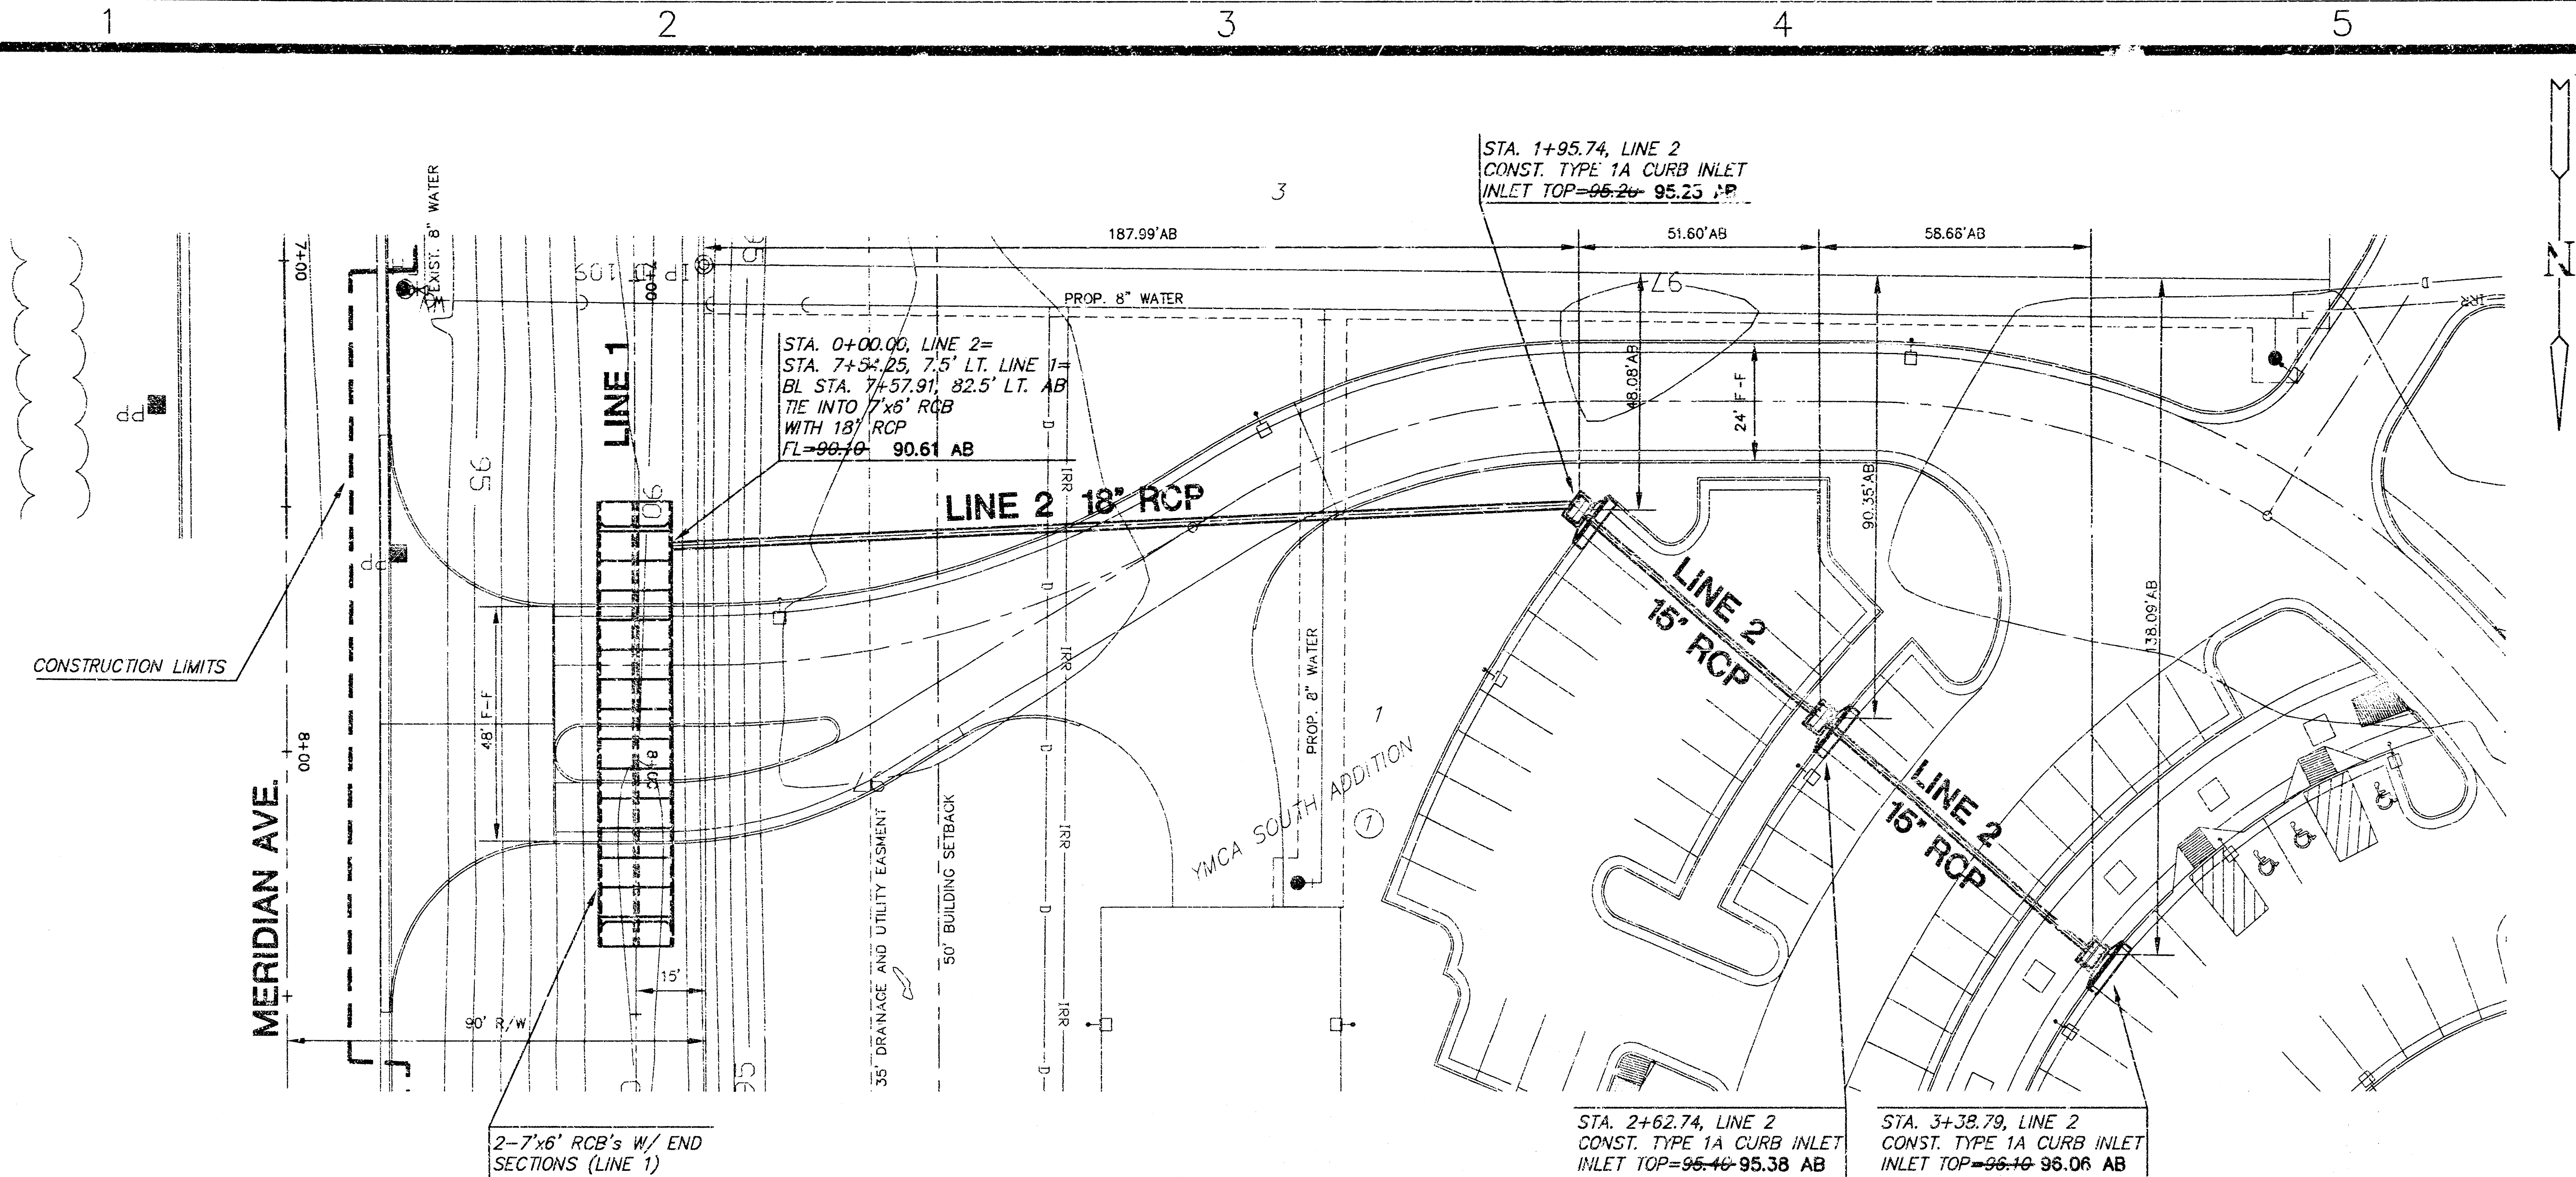

PLAN - LINE 2
SCALE: 1" = 20'

PROFILE - LINE 2
HORIZONTAL SCALE: 1" = 20'
VERTICAL SCALE: 1" = 5'

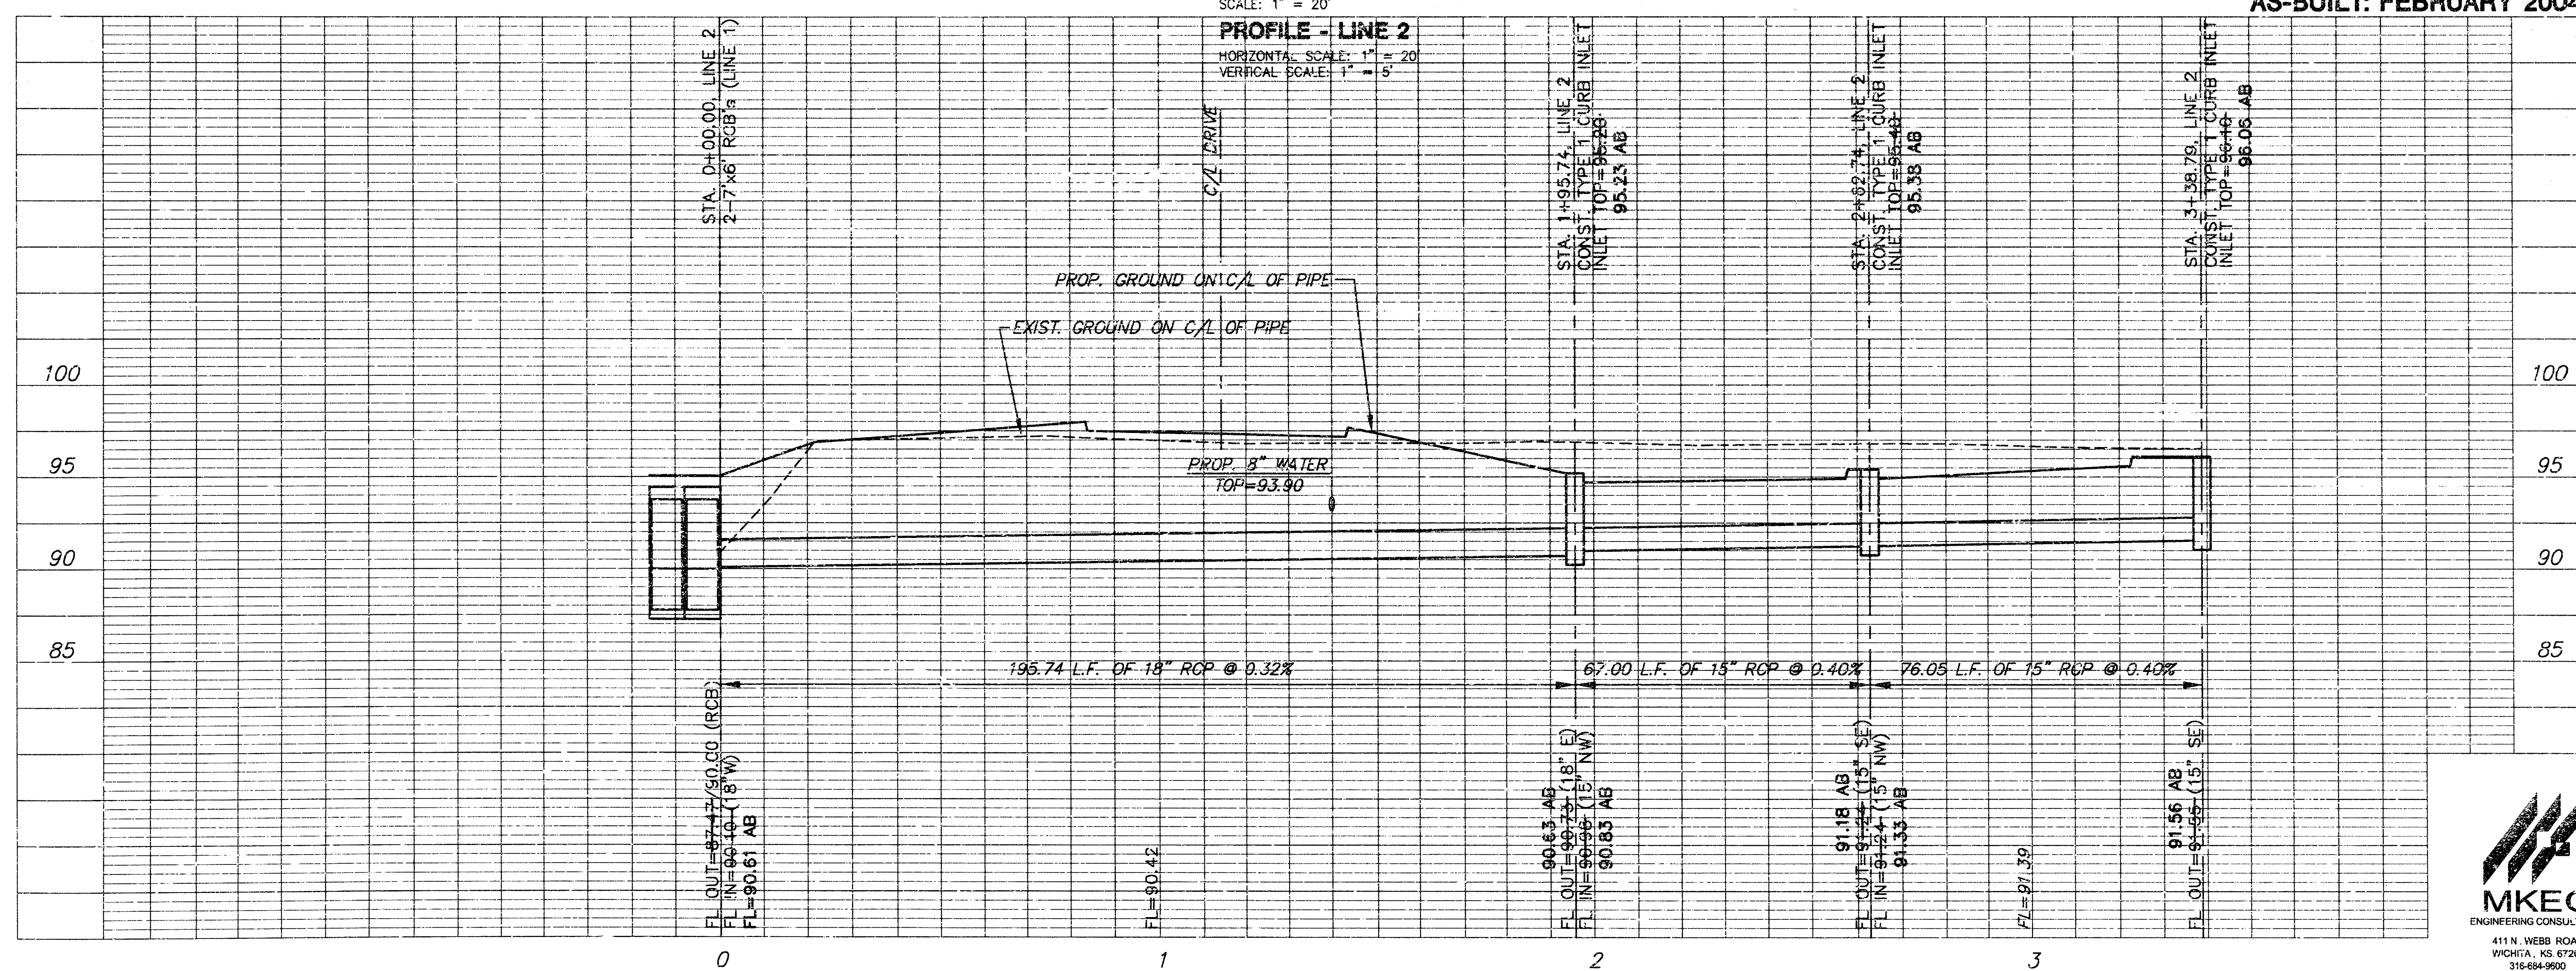

1204 PPS (607861)
AS-BUILT: FEBRUARY 2004

Gossen Livingston
Architecture
420 South Emporia
Wichita, KS 67202
Tel: (316) 265-9367
Fax: (316) 265-5846
Email: archlact@att.net

Fire Station No. 12
3443 S. Meridian

2001 Gossen Livingston Associates, Inc.
All work herein is the exclusive property of Gossen Livingston Associates, Inc. and is not to be copied or used in any way without the express written consent of Gossen Livingston Associates, Inc. All drawings, specifications, notes, designs and arrangements appearing herein constitute the original and copyrighted work of:

Regional Library & Fire Stations
(No. 4, 7, 12, 13, & 19)
for the City of Wichita, Kansas

Work	Date	Mark	Description

STORM WATER SEWER
PLAN & PROFILE

Job No. 1036.000
Date 01/23/02
Drawn
Checked
1204 PPS

C-CU103
OF
Dwg. 9 of 56
2 of 4

MKEC
ENGINEERING CONSULTANTS
411 N. WEBB ROAD
WICHITA, KS 67206
316-684-9600

