


**STORM WATER SEWER IMPROVEMENTS TO SERVE
LOT 4, J.W. RUSSELL 2ND ADDITION
MILLINEUM CONCEPTS
PROJECT NUMBER
1199 PPS (607881)
CITY OF WICHITA, KANSAS
MICHAEL LINDEBAK, P.E., CITY ENGINEER**

C. A.T. & S.F. RAILROAD

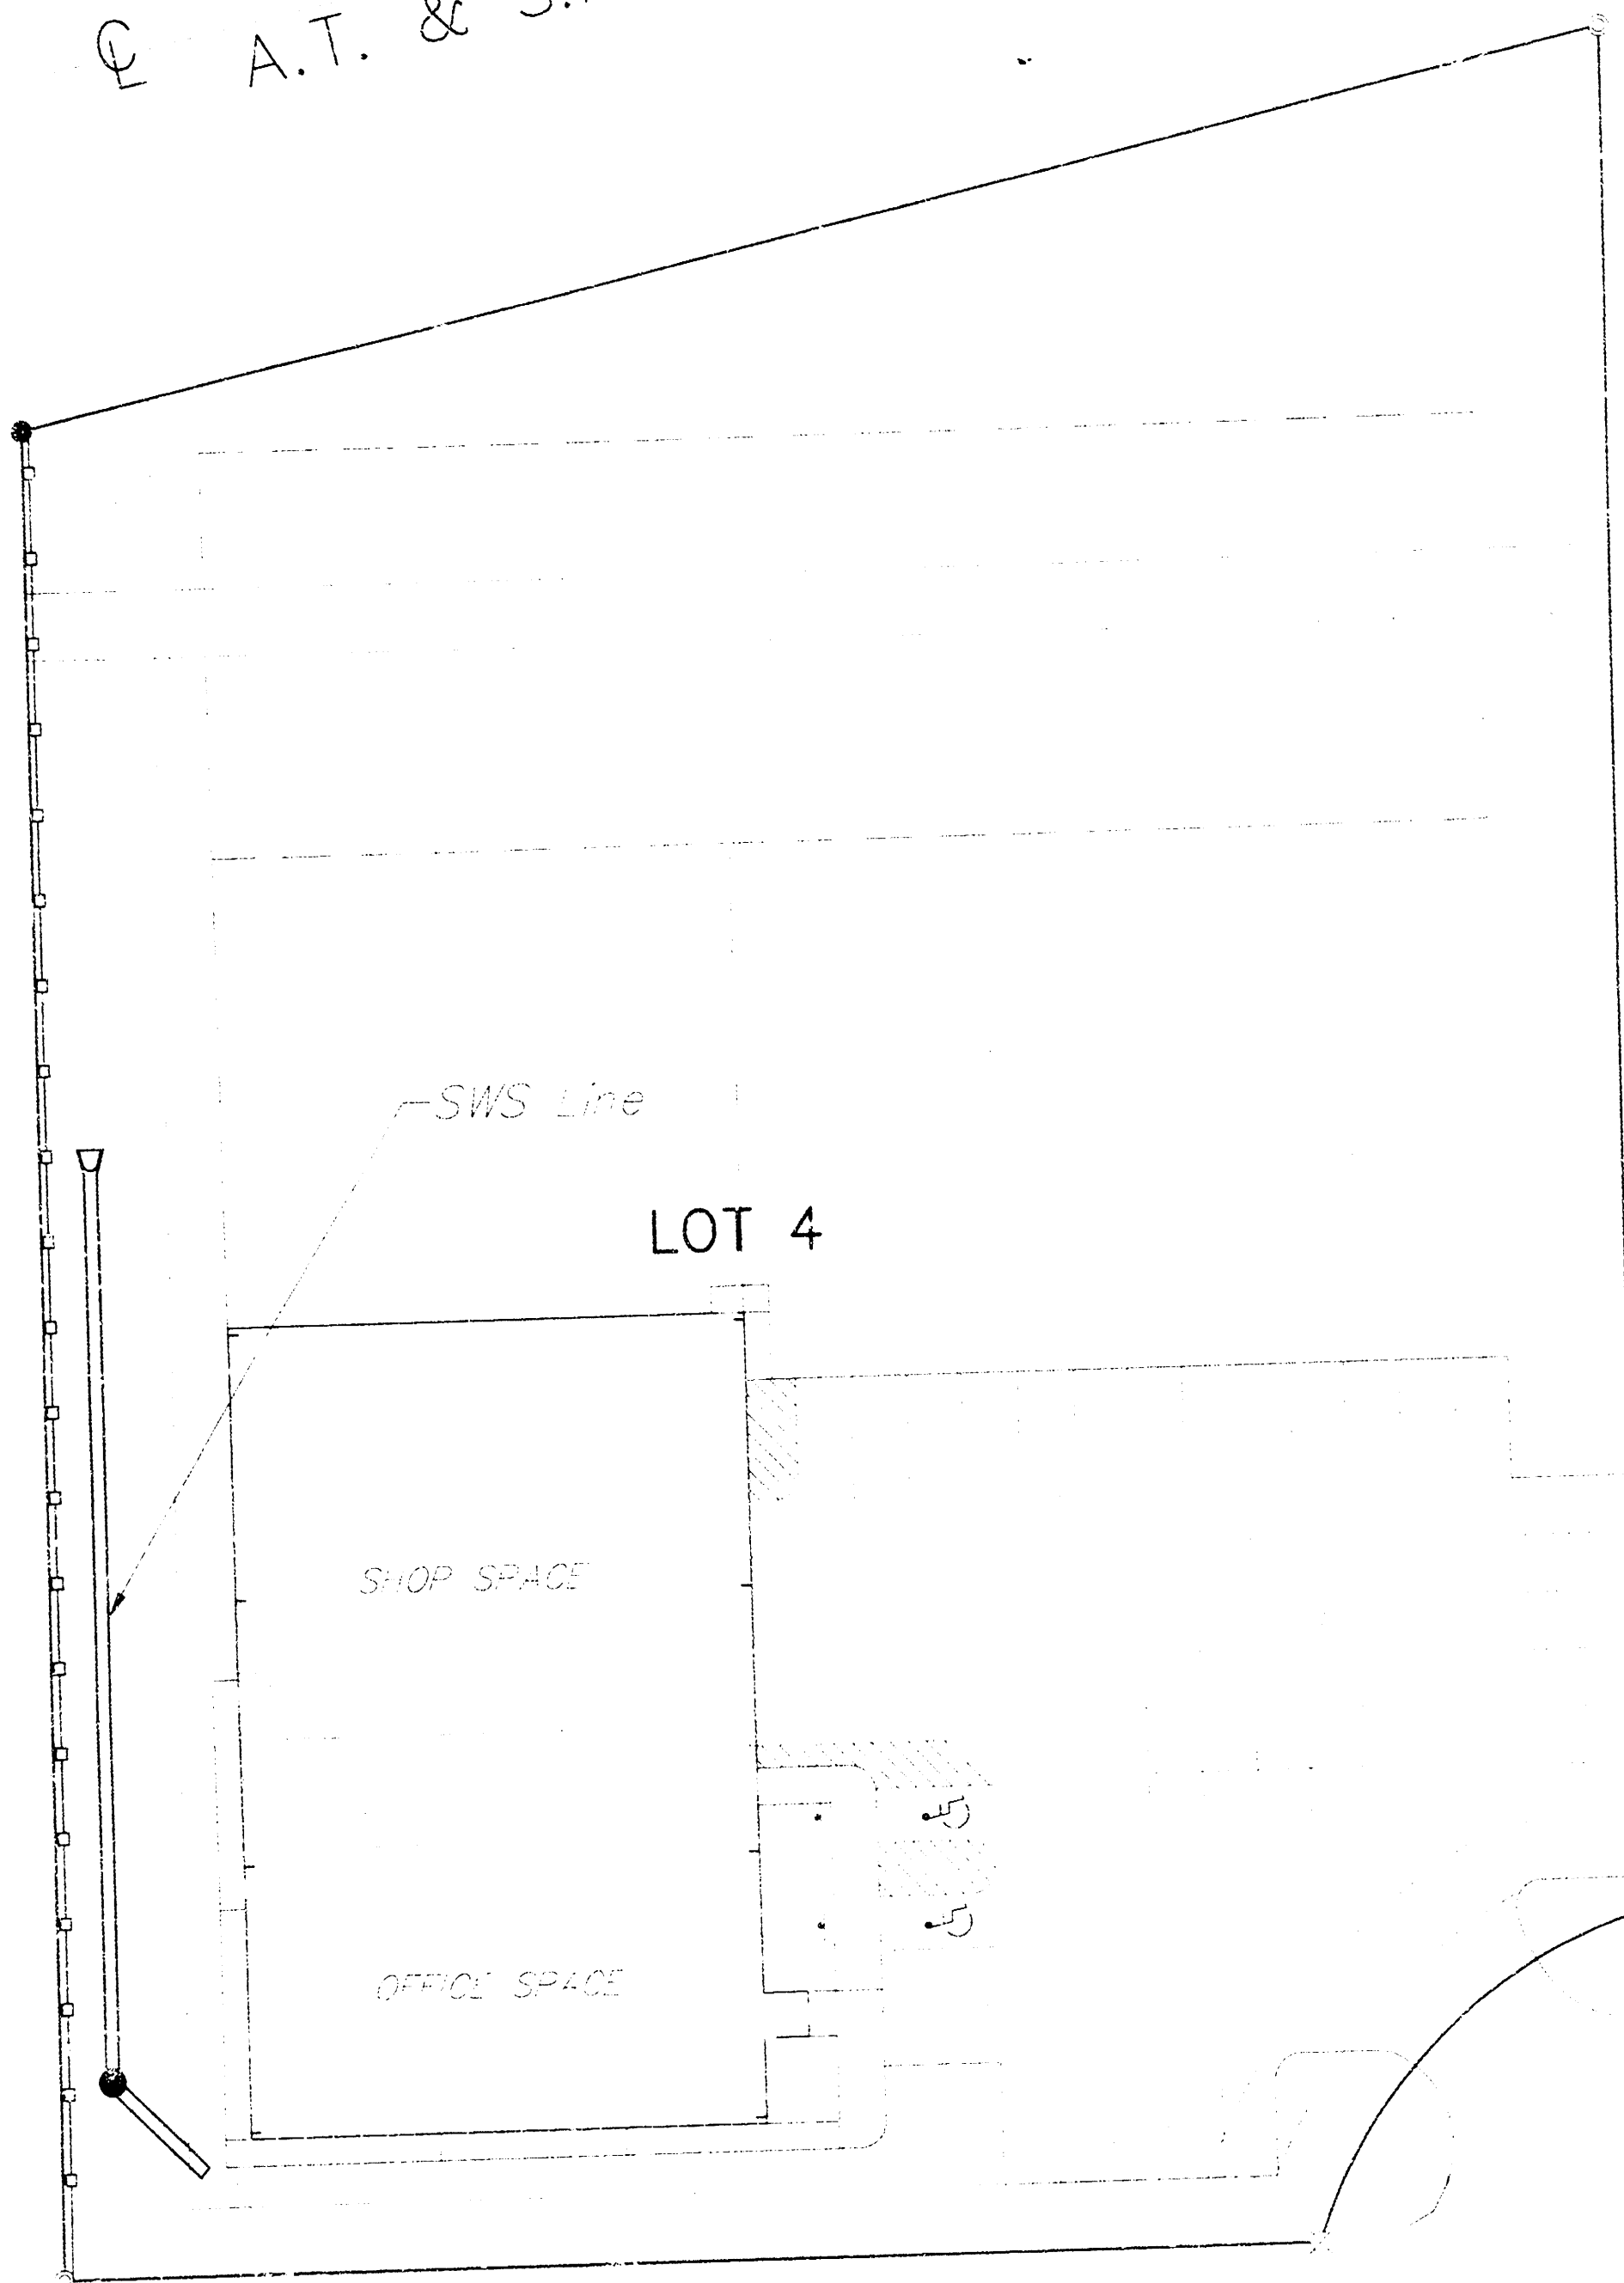


MONROE CIRCLE

N

INDEX

BENCHMARK

... 100 100 100 100
 ... 100 100 100 100
 ... 100 100 100 100
 ... 100 100 100 100

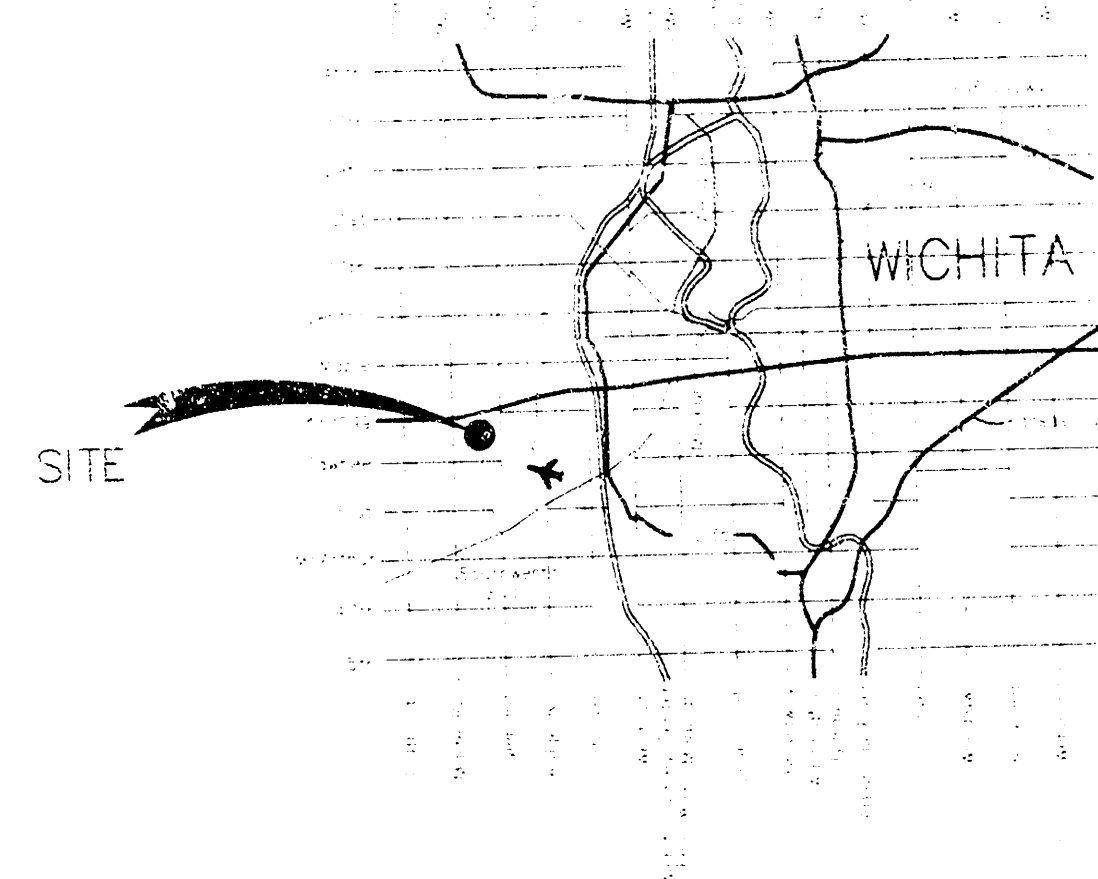

BOOKED
5-30-02
MCL
D-416

LOCATION
MAP


AS-BUILT
Date: 4/15/03
Signed: [Signature]

APPROVED AS NOTED BY CITY ENGINEER OF WICHITA



STORM SEWERS VRH 2/5/02

navigation and fishing in the navigable area to be provided by a Licensed
personnel (including the Captain) except with the Master/Personnel
Duty Manual for the vessel. The vessel must be in the City of Manila during
operation. The engineering documents and certified by a Licensed
Engineer. The documents to be submitted in duplicate documents to the
City of Manila by the Captain. Without such documents, the ship
will be considered at fault. Authorization by the City Engineer
for operation and navigation and control of the City of Manila
navigation and fishing in the navigable area of the City Engineer
Office.

Erin M. Hall
1/29/02

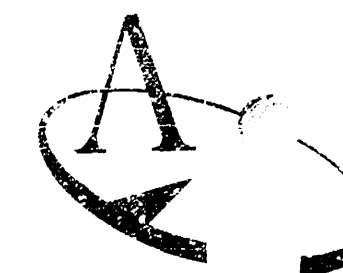


AUSTIN
ENGINEERING SERVICE

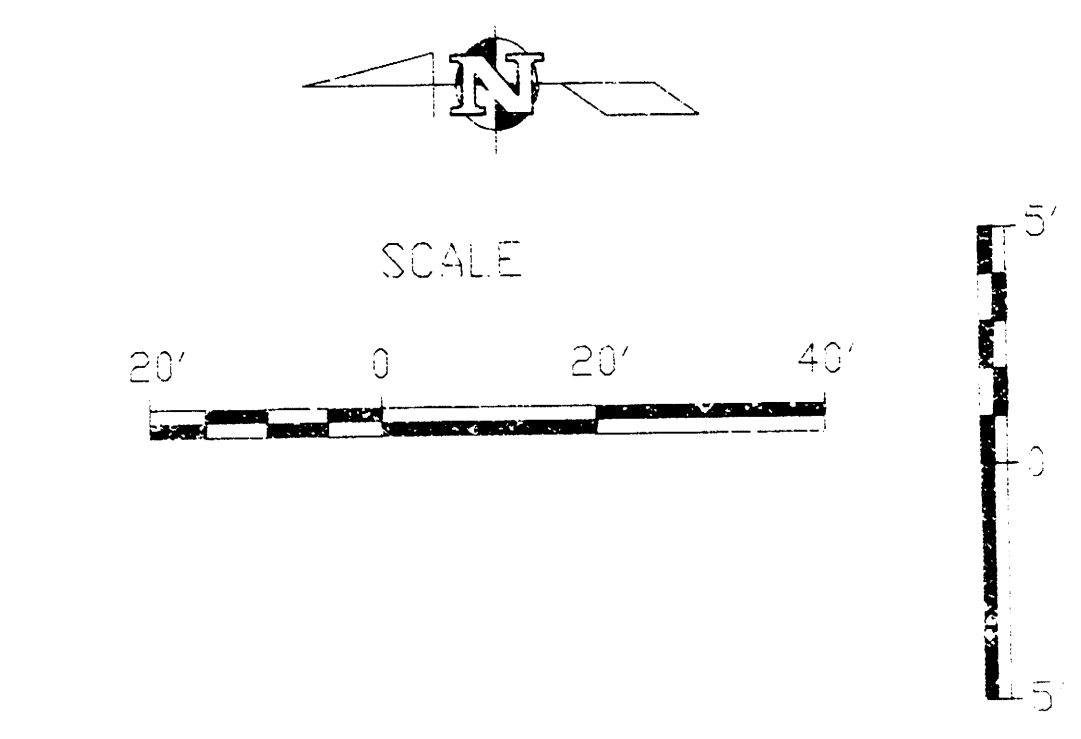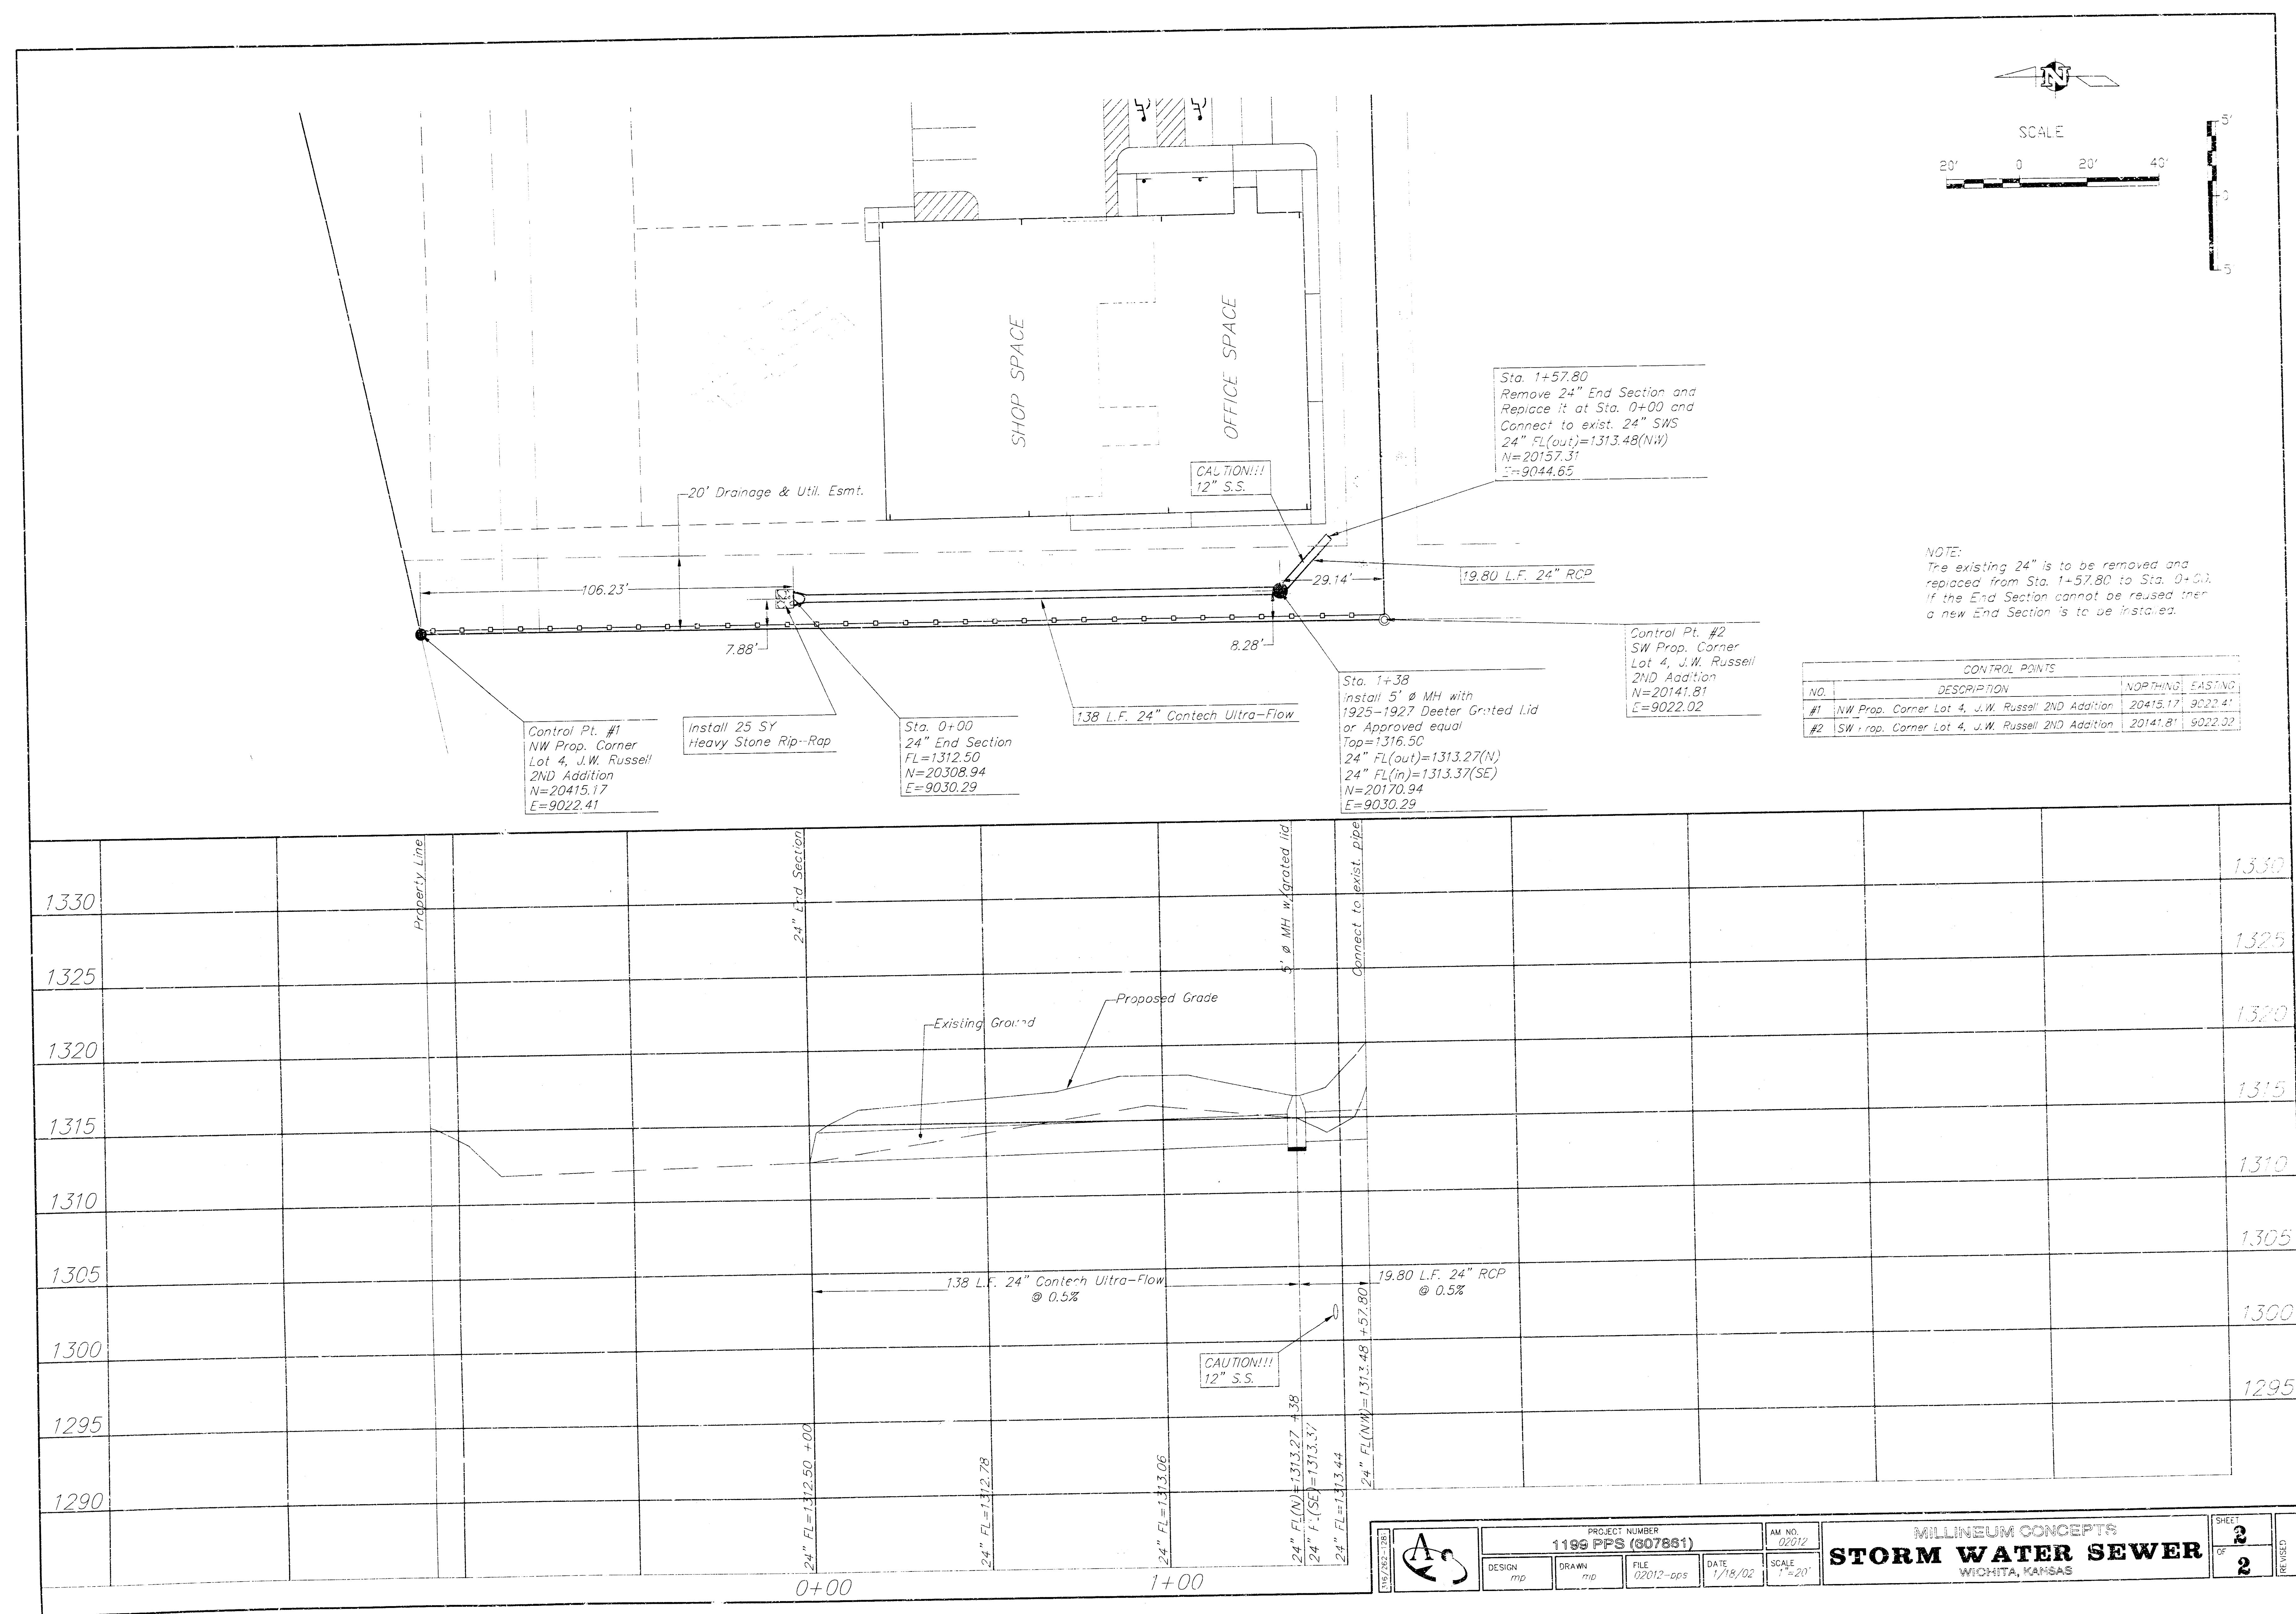

NOTE:
The existing 24" is to be removed and replaced from Sta. 1+57.80 to Sta. 0+00. If the End Section cannot be reused then a new End Section is to be installed.

CONTROL POINTS			
NO.	DESCRIPTION	NORTHING	EASTING
#1	NW Prop. Corner Lot 4, J.W. Russell 2ND Addition	20415.17	9022.41
#2	SW Prop. Corner Lot 4, J.W. Russell 2ND Addition	20141.81	9022.02

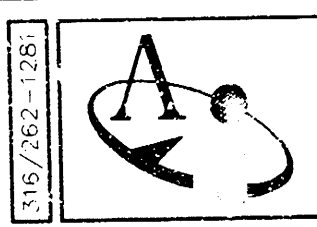

PROJECT NUMBER 1199 PFS (807851)				AM NO. 02012	
DESIGN mp	DRAWN md	FILE 02012-pps	DATE 1/18/02	SCALE 1"=20'	

MILLINEUM CONCEPTS
STORM WATER SEWER
WICHITA, KANSAS

SHEET
2
OF
2
REVISED