


BENCHMARK:
Railroad Spike in the E side of Power Pole, @ the NW Corner intersection of Eisenhower & 3rd St. N.
Elevation = 122.76 (City Datum)


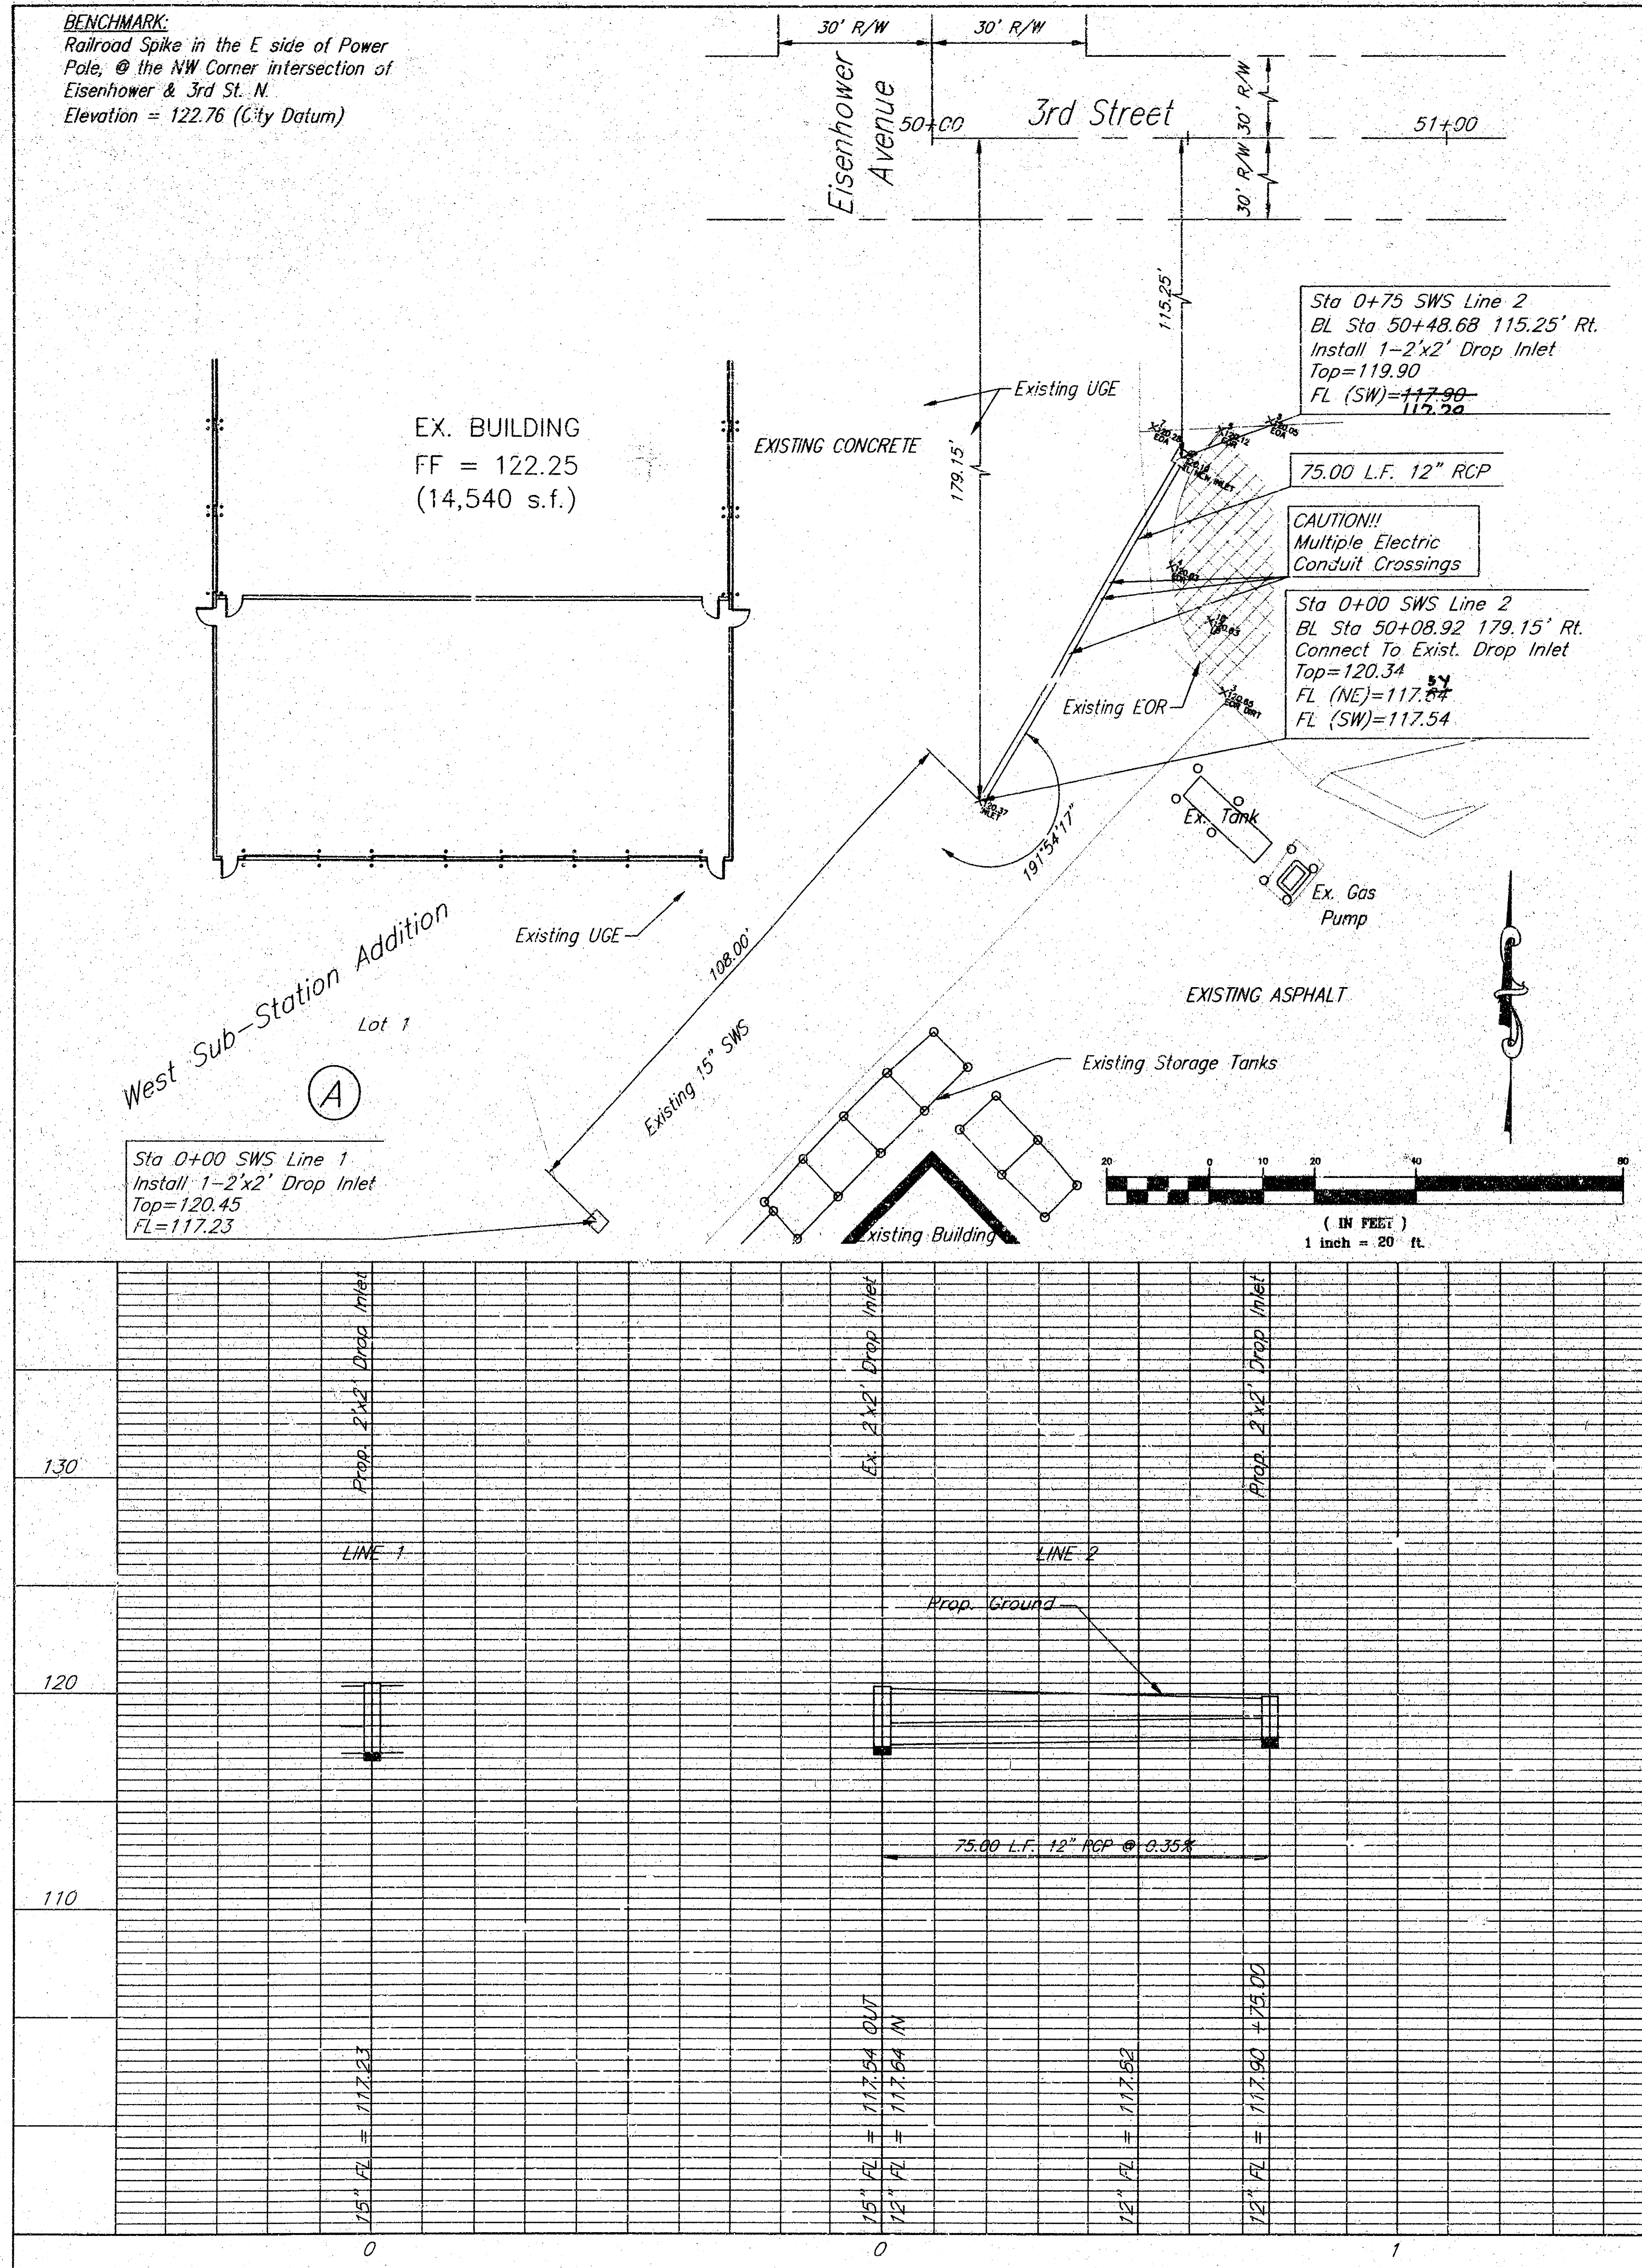


STORM SEWER TO SERVE WEST SUB-STATION 5801 W. 3RD STREET LOT 1, BLOCK A WEST SUB-STATION ADDITION 1263 PPS (607861) CITY OF WICHITA, KANSAS


GENERAL NOTES

- Contractor will be required to provide notice to utility companies a minimum of twenty-four (24) hours prior to any excavation, as follows:
Kansas One-Call 687-2470
The Contractor must notify the following in case of an emergency:
Cablevision 262-4270
or 263-2061
K.P.L. Gas Service Company 363-8850
Kansas Gas & Electric Company 363-8800
Peoples Natural Gas 1-571-2611
Southwestern Bell Telephone Company 268-4908
City of Wichita Water Department 268-4071
City of Wichita Sewer Department 312-1168
Kansas Gas Service 312-3167
or Peoples Natural Gas 942-8811
or 1-800-301-0357
- Exist. utilities and their locations, as shown on the plans, represent the best information obtainable for design. Loc. information has been obtained from the various utility companies and is either from company record drawings or company-provided field locations. The Contractor will be required to work around existing utilities which do not conflict with proposed construction.
- The Contractor to verify utility locations prior to construction of this project.
- Utility service and installation shall be coordinated with the respective utility owners. Contacts are:
Kansas Gas Service 831-3122
James Stoltz 261-8251
Kansas Gas & Electric Russ Chilwood 942-8811
Peoples Natural Gas John Stark 268-4555
Wichita Water Paul Bryant 268-4908
Steve Palmer 268-4908
Southwestern Bell Jim Tobin 268-2759
Multimedia Cablevision Mark Anyas 262-4270
- All lower/lower areas disturbed by construction of proposed improvements shall be restored with soil. All existing work shall be in accordance with the City of Wichita standard specifications and the City of Wichita administrative regulation No. AR78 which governs cleanup and replacement following construction. All costs for this work shall be subsidiary to the lump sum price bid for "Site Restoration."
- Traffic affected by the construction of this project shall be handled in accordance with the latest edition of the Manual on Uniform Traffic Control Devices.
- All commercial signs to be moved by others prior to construction.
- Properties within the project may have underground irrigation systems (furnace sprinklers) which conflict with the new construction. Contractor shall remove such components as needed during construction of the project. The irrigation system shall be reinstalled in like and before project completion. Any irrigation system modifications required because of project improvements shall be coordinated with the property owner. Portions of underground irrigation systems not in conflict with construction shall be protected from damage and shall remain in place. All work related to underground irrigation/sprinklers shall be subsidiary to Site Restoration.
- Cuts made to paved surfaces on public property will be repaired by the City's contractor and charged against the owner / applicant. Unit repair prices are available from the City at 268-4416. A surcharge may be applicable. Call 268-4416 for details. Repair costs to be paid prior to release of water service if water service is affected.


24" x 24" Frame and Grate Detail

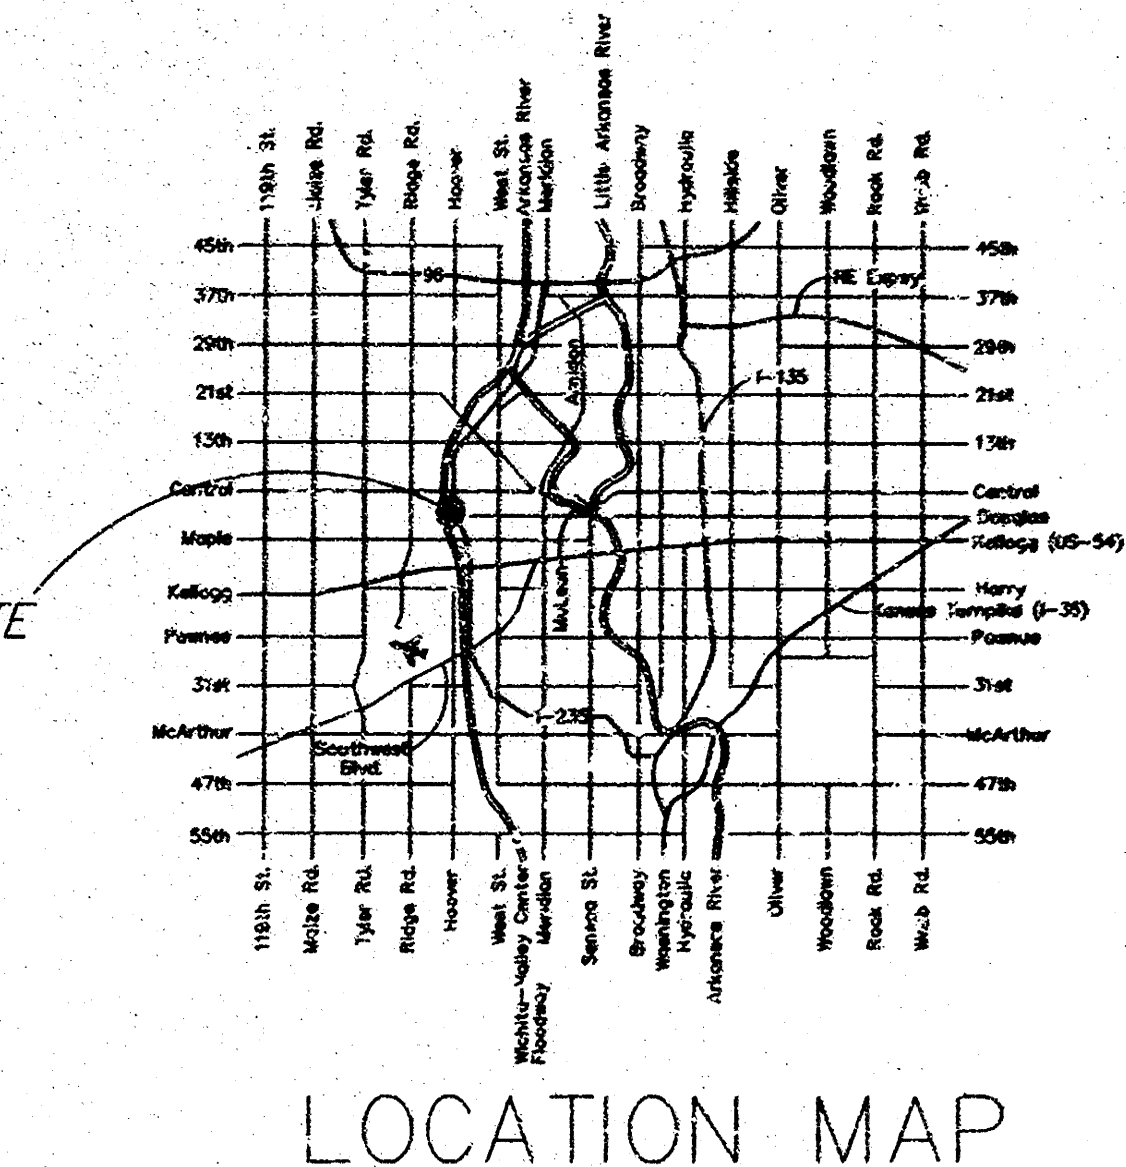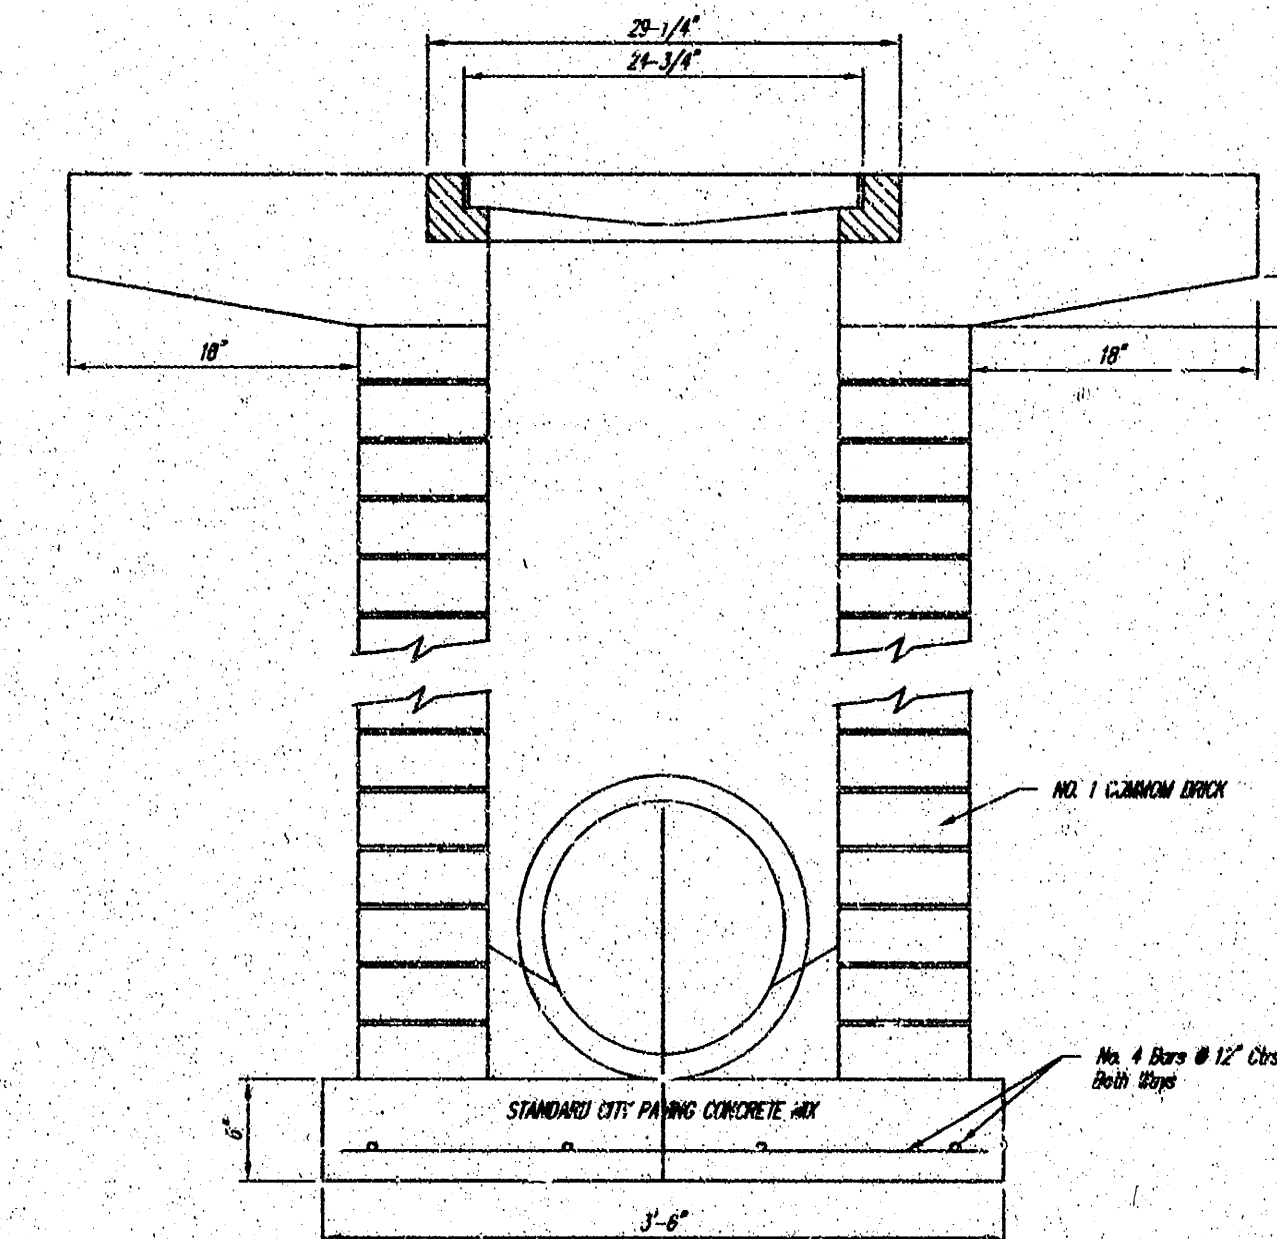

APPROVED AS NOTED
Storm Sewers
Julianne Kellman 7-23-02
NOTE TO CONTRACTORS
Installation, inspection and testing for this project is to be provided by a Licensed Consulting Engineering firm under contract with the Owner/Developer. Said inspection to be in accordance with the City of Wichita standard construction engineering practices and certified by a Licensed Professional Engineer. No work shall be performed in dedicated easements or public right-of-way by the Contractor without such inspection nor shall any work be commenced without written authorization by the City Engineer. All Construction and Materials shall comply with the City of Wichita Specifications and Standards (on file and available in the City Engineer's Office).

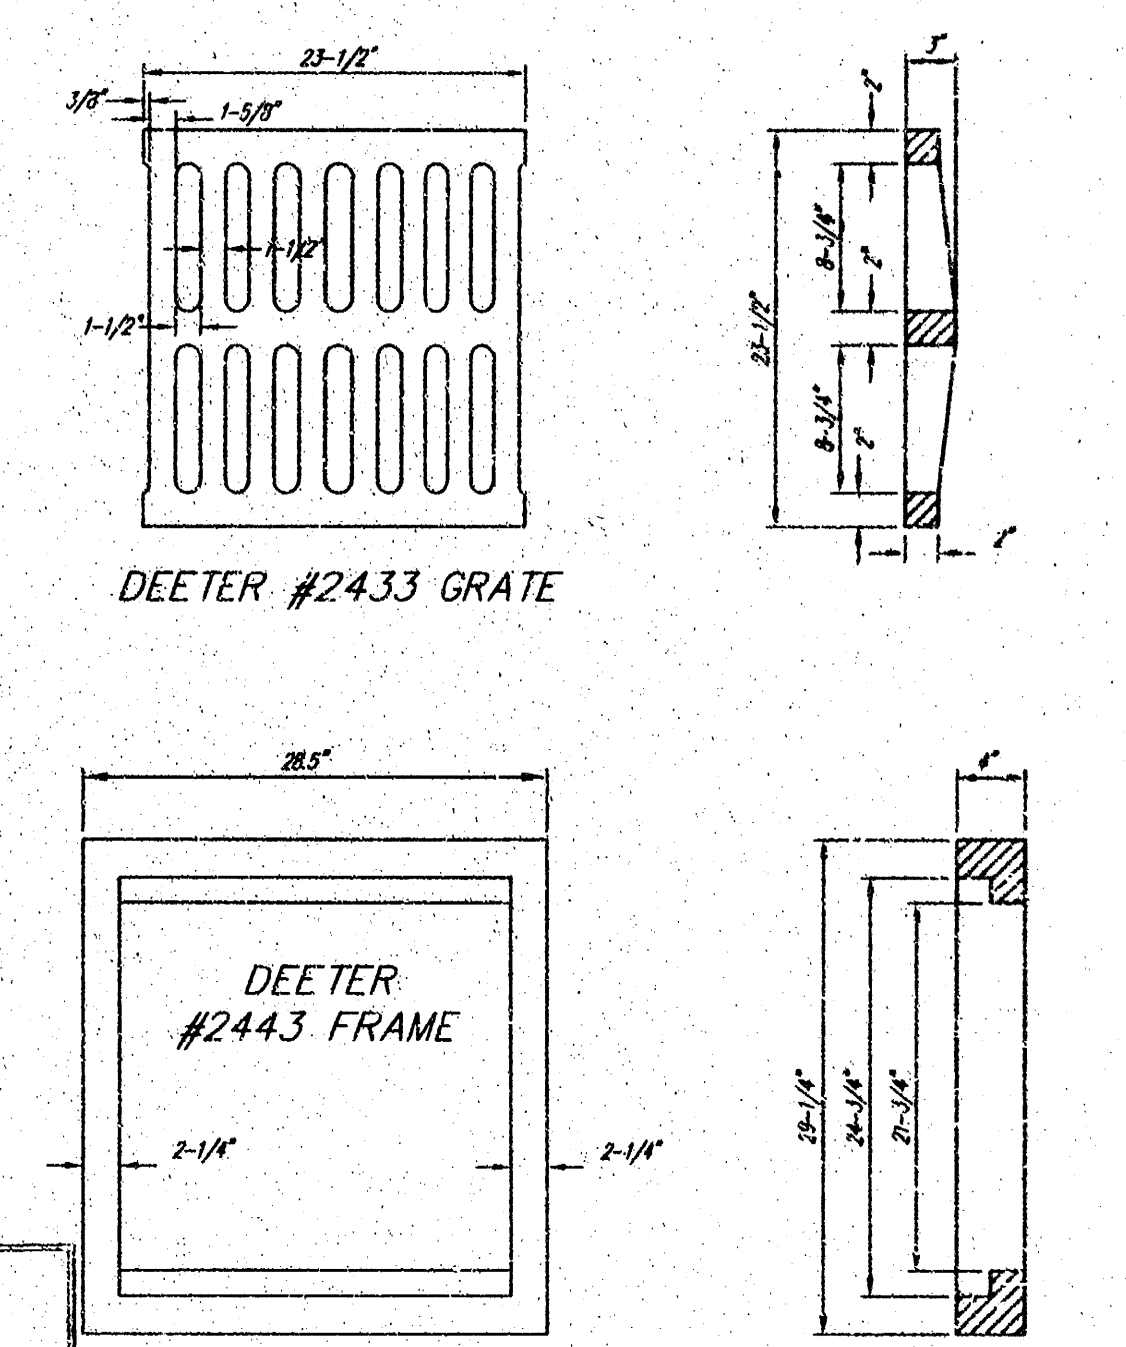

AS-BUILT
8/1/02
Date
Signed

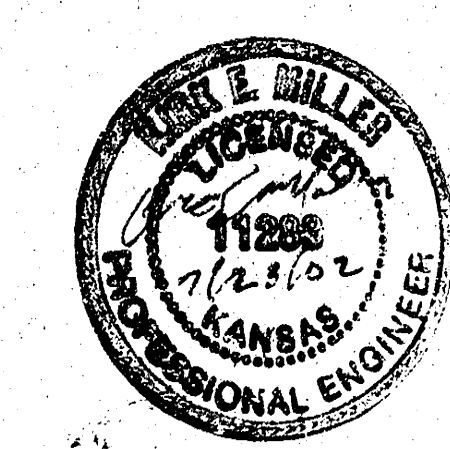

NOTES:
1. Grates shall be imprinted on the top surface with "CITY OF WICHITA" using letters of least 1" in height. Other marking methods may be approved by the engineer.
2. Cuts made to paved surfaces on public property will be repaired by the City's contractor and charged against the owner / applicant. Unit repair prices are available from the City at 268-4416. A surcharge may be applicable. Call 268-4416 for details. Repair costs to be paid prior to release of water service if water service is affected.

Wichita Water & Sewer Department Storm Sewer Wichita, Kansas			
PROJECT NUMBER			
KEM NO. 02061	FILE SWS1	DATE 7/02	SHEET 1
DESIGN KM	DRAWN TR	REVISED	OF 1