

INDEX OF SHEETS

- 1. TITLE SHEET
- 2. LEVEE BREACH DETAILS AND GENERAL NOTES
- 3-5. PLAN AND PROFILE
- 6. REINFORCED CONCRETE MANHOLE
- 7. MANHOLE FRAME AND COVER DETAILS
- 8. TYPE 1A CURB INLET
- 9. SLUICE GATE STRUCTURE
- 10. CONCRETE HEADWALL AND FLAP GATE
- 11. PROJECT SIGN DETAILS


CITY OF WICHITA, KANSAS

# STORM WATER DRAIN NO. 64

## (WEST MAPLE STREET)

RIDGE RD. TO W. END OF FLOODWAY BR.  
 MICHAEL E. LINDEBAK, CITY ENGINEER  
 SEPTEMBER, 1984

PROJ. NO. 468-76-245-81373-000-000-001

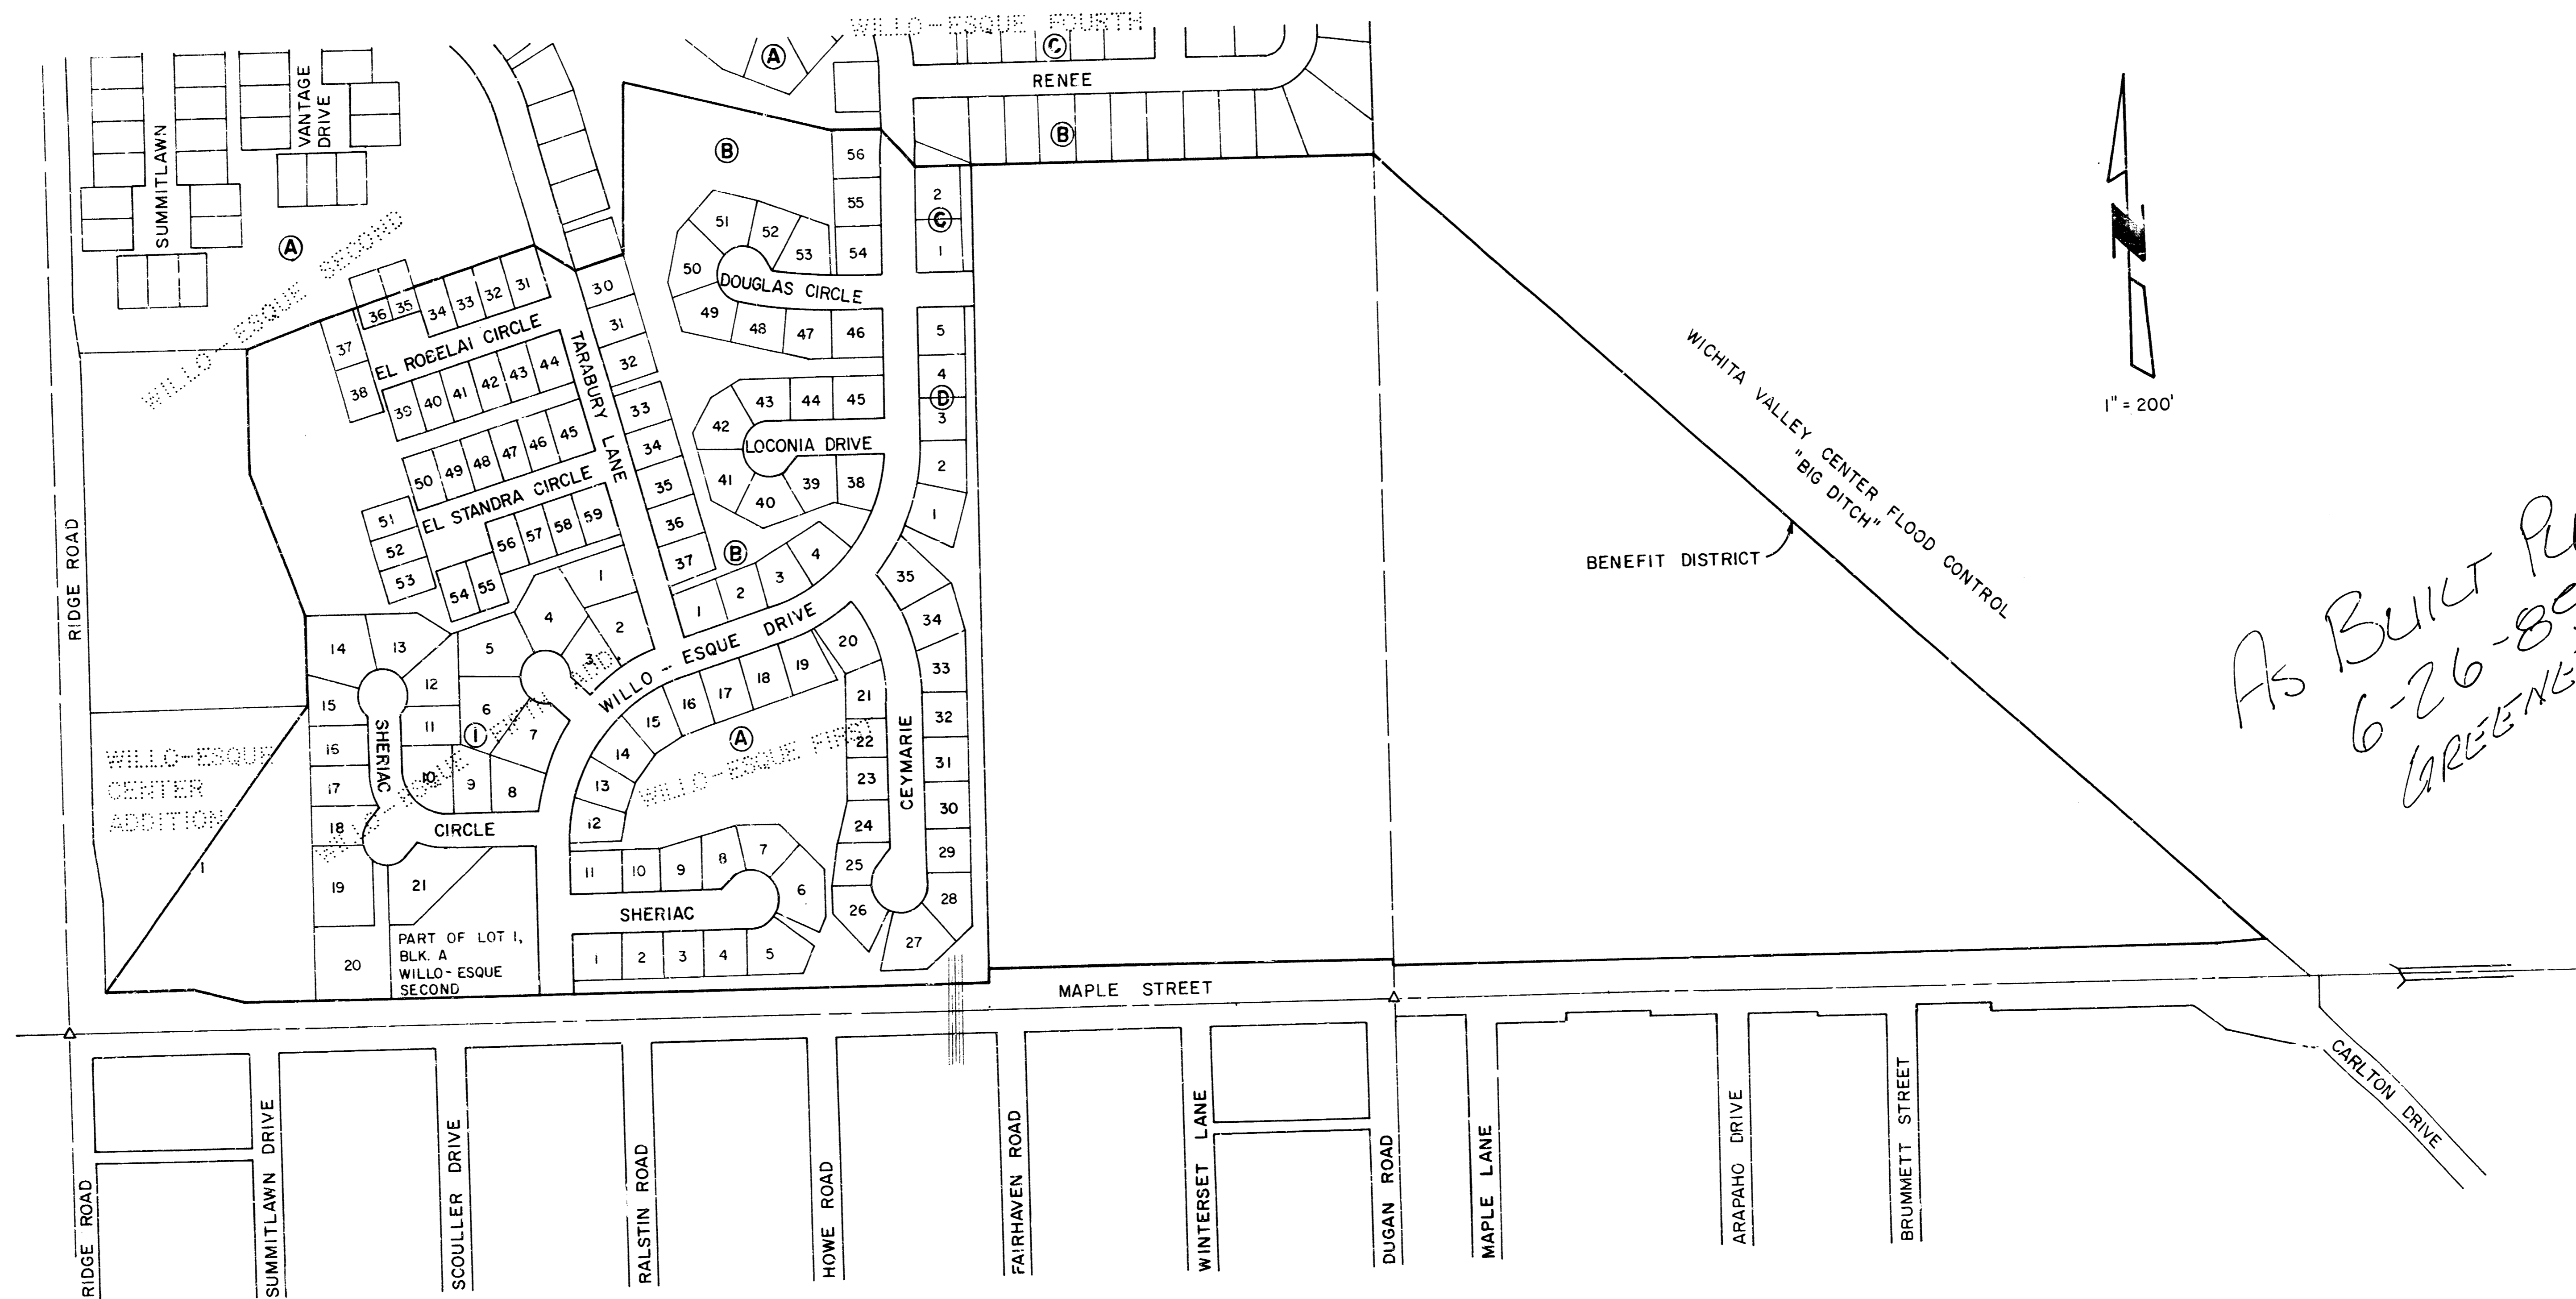


*AS BUILT PLANS  
 6-26-85  
 GREENE*



PLANS PREPARED BY  
**Booker/Freund**  
 Engineers Architects Planners  
 WICHITA, KANSAS

Rev. 12-7-84

FILMED FROM THE BEST AVAILABLE COPY ....

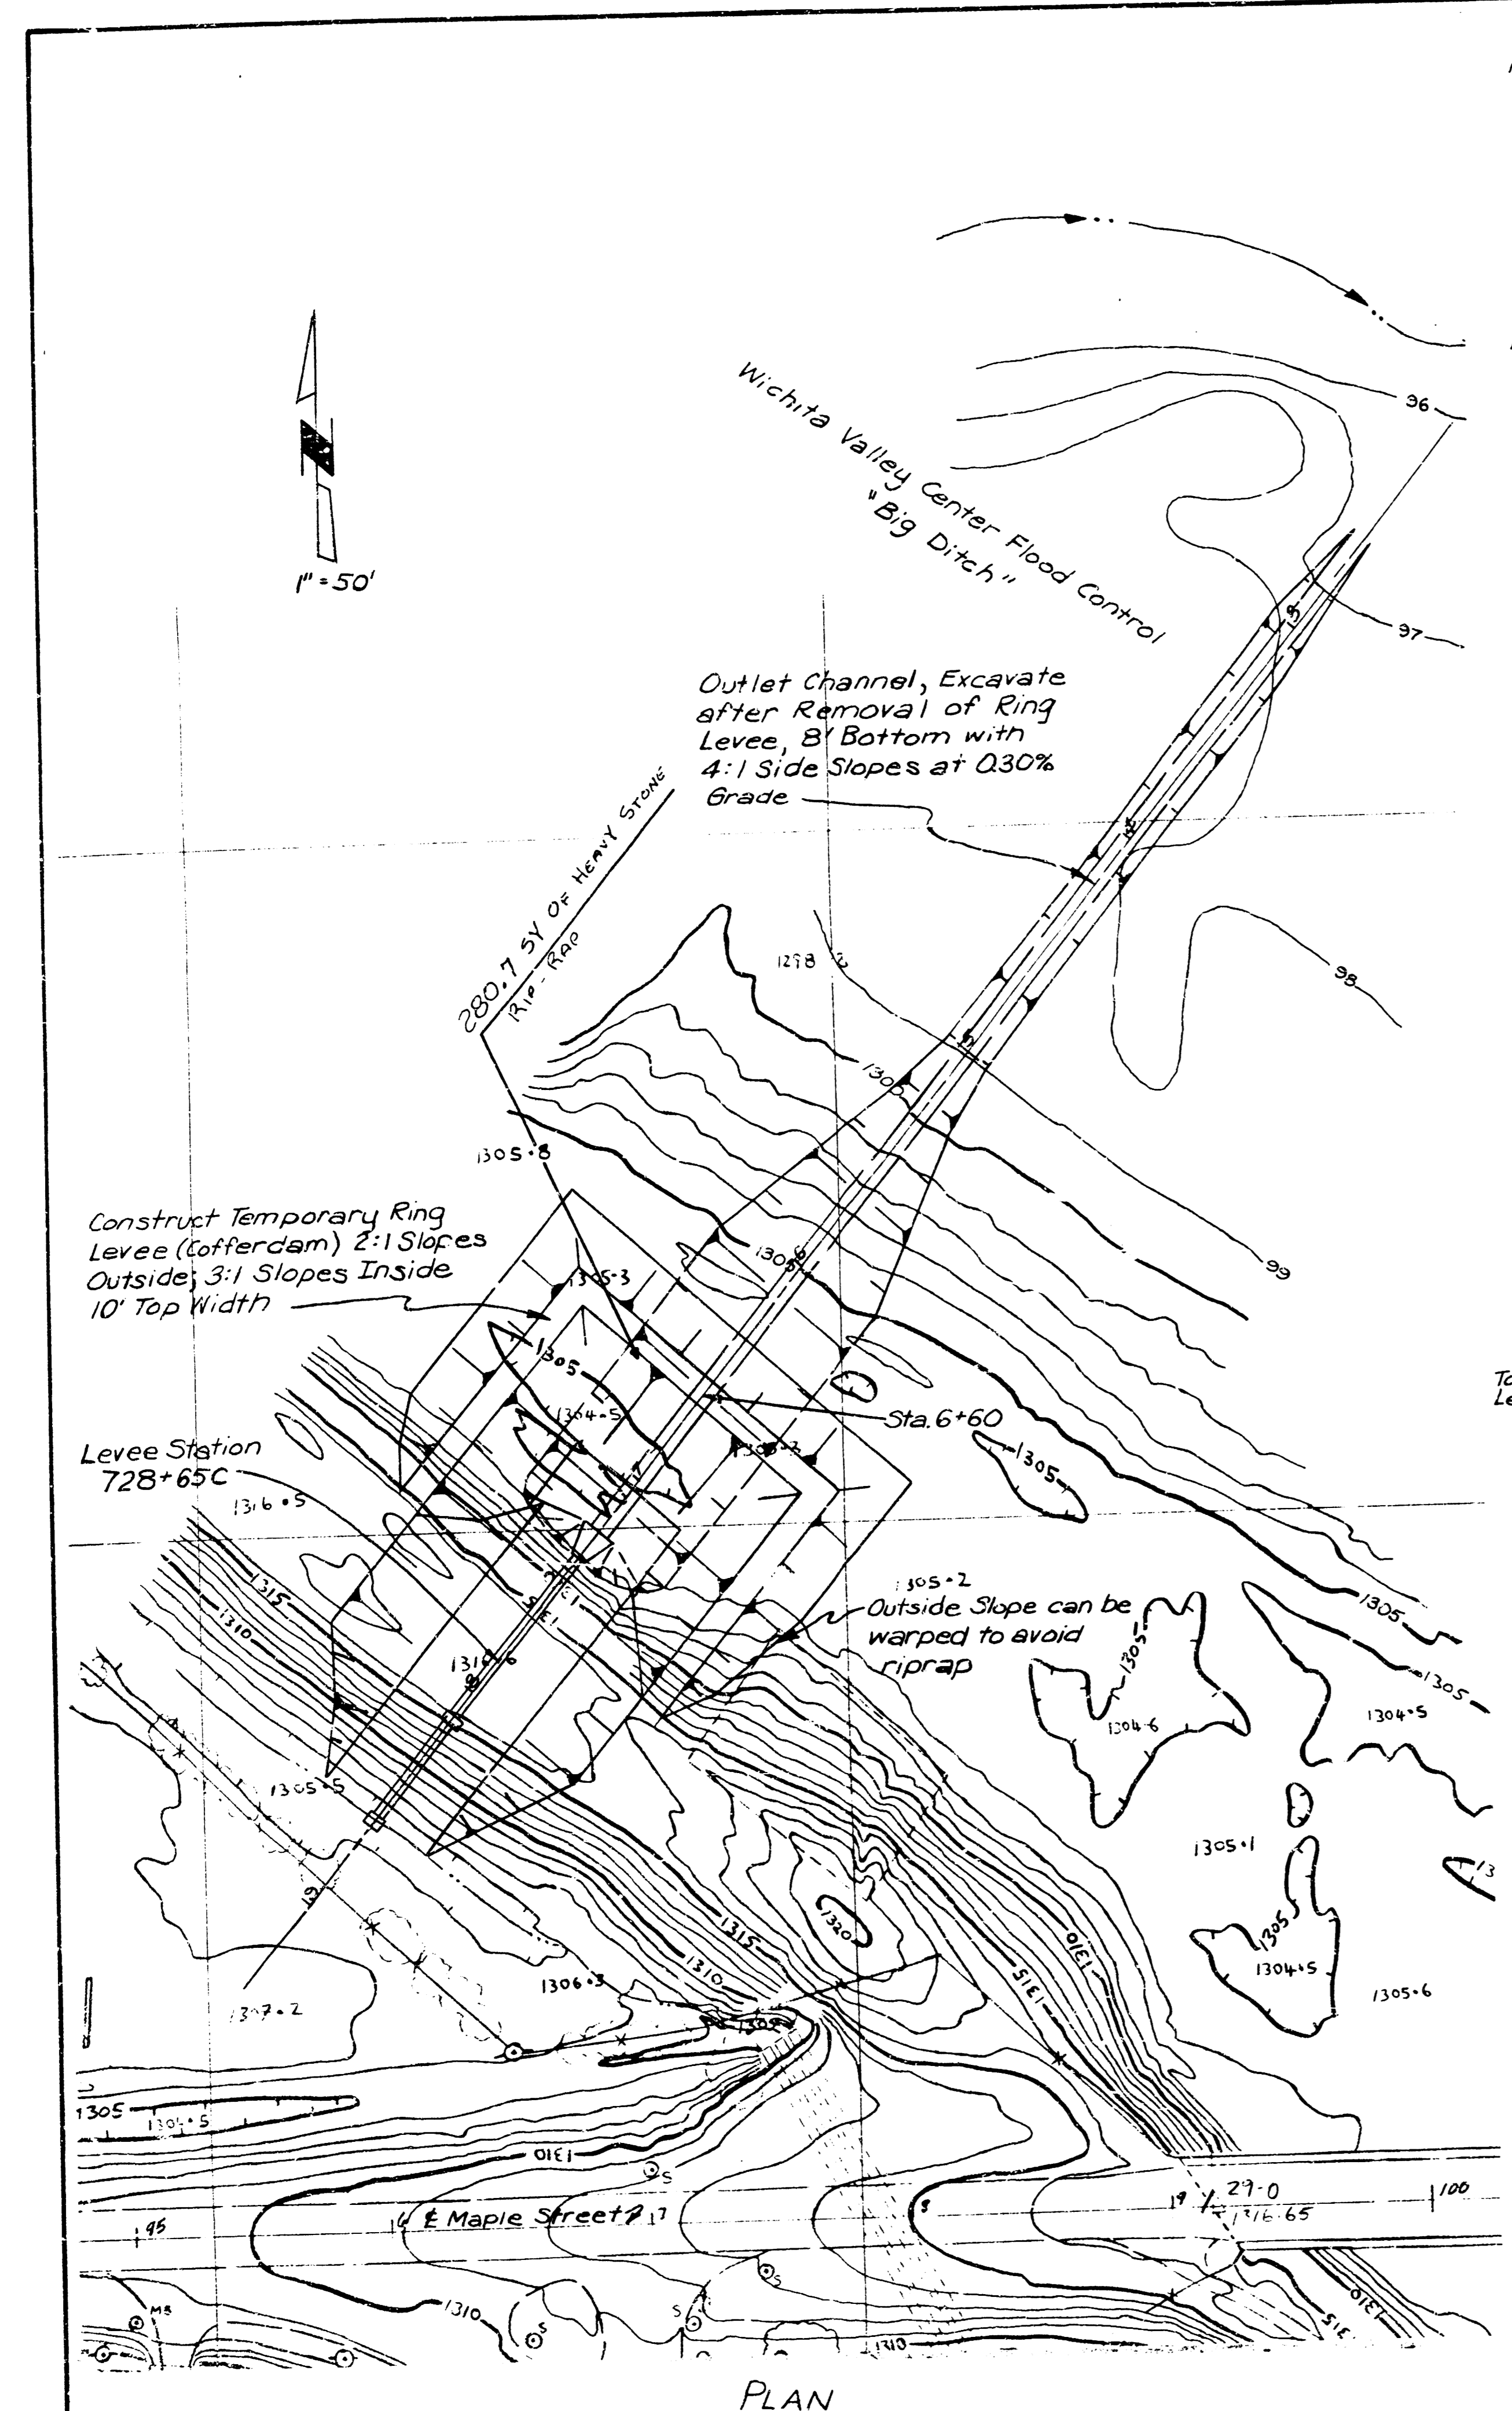

- NOTES:**
1. Provide a temporary ring levee (cofferdam) on the river side of the existing levee at the location of the subject crossing to the same top elevation as the existing levee. Construct the levee of impervious materials in accordance with the provisions specified in paragraph 6.
  2. Corners of ring levee may be rounded to facilitate construction.
  3. Locate sources for borrow materials a minimum of 500 feet from the land side toe of the existing levee.
  4. When the temporary ring levee is complete, excavate the existing levee using 1 vertical on 3 horizontal cut slopes.
  5. Backfill of pipe trench and a minimum of 2 feet of fill directly over the pipe from sta. 7+37 to sta. 8+60 shall be compacted to a density as per paragraph 7 by means of hand tamping, or manually directed power tampers or plate vibrators. Heavy equipment shall not be operated within 2 feet of any structure. Vibrating rollers shall not be operated within 5 feet of any structure. Compaction by means of drop weights operating from a crane or hoist will not be permitted.
  6. Upon completion of the hand backfill and before placing the levee fill, the entire foundation area to be occupied by the levee fill shall be scarified, plowed, and/or harrowed to a depth of 6 inches and then compacted by at least 16 complete passes of the tamping roller.

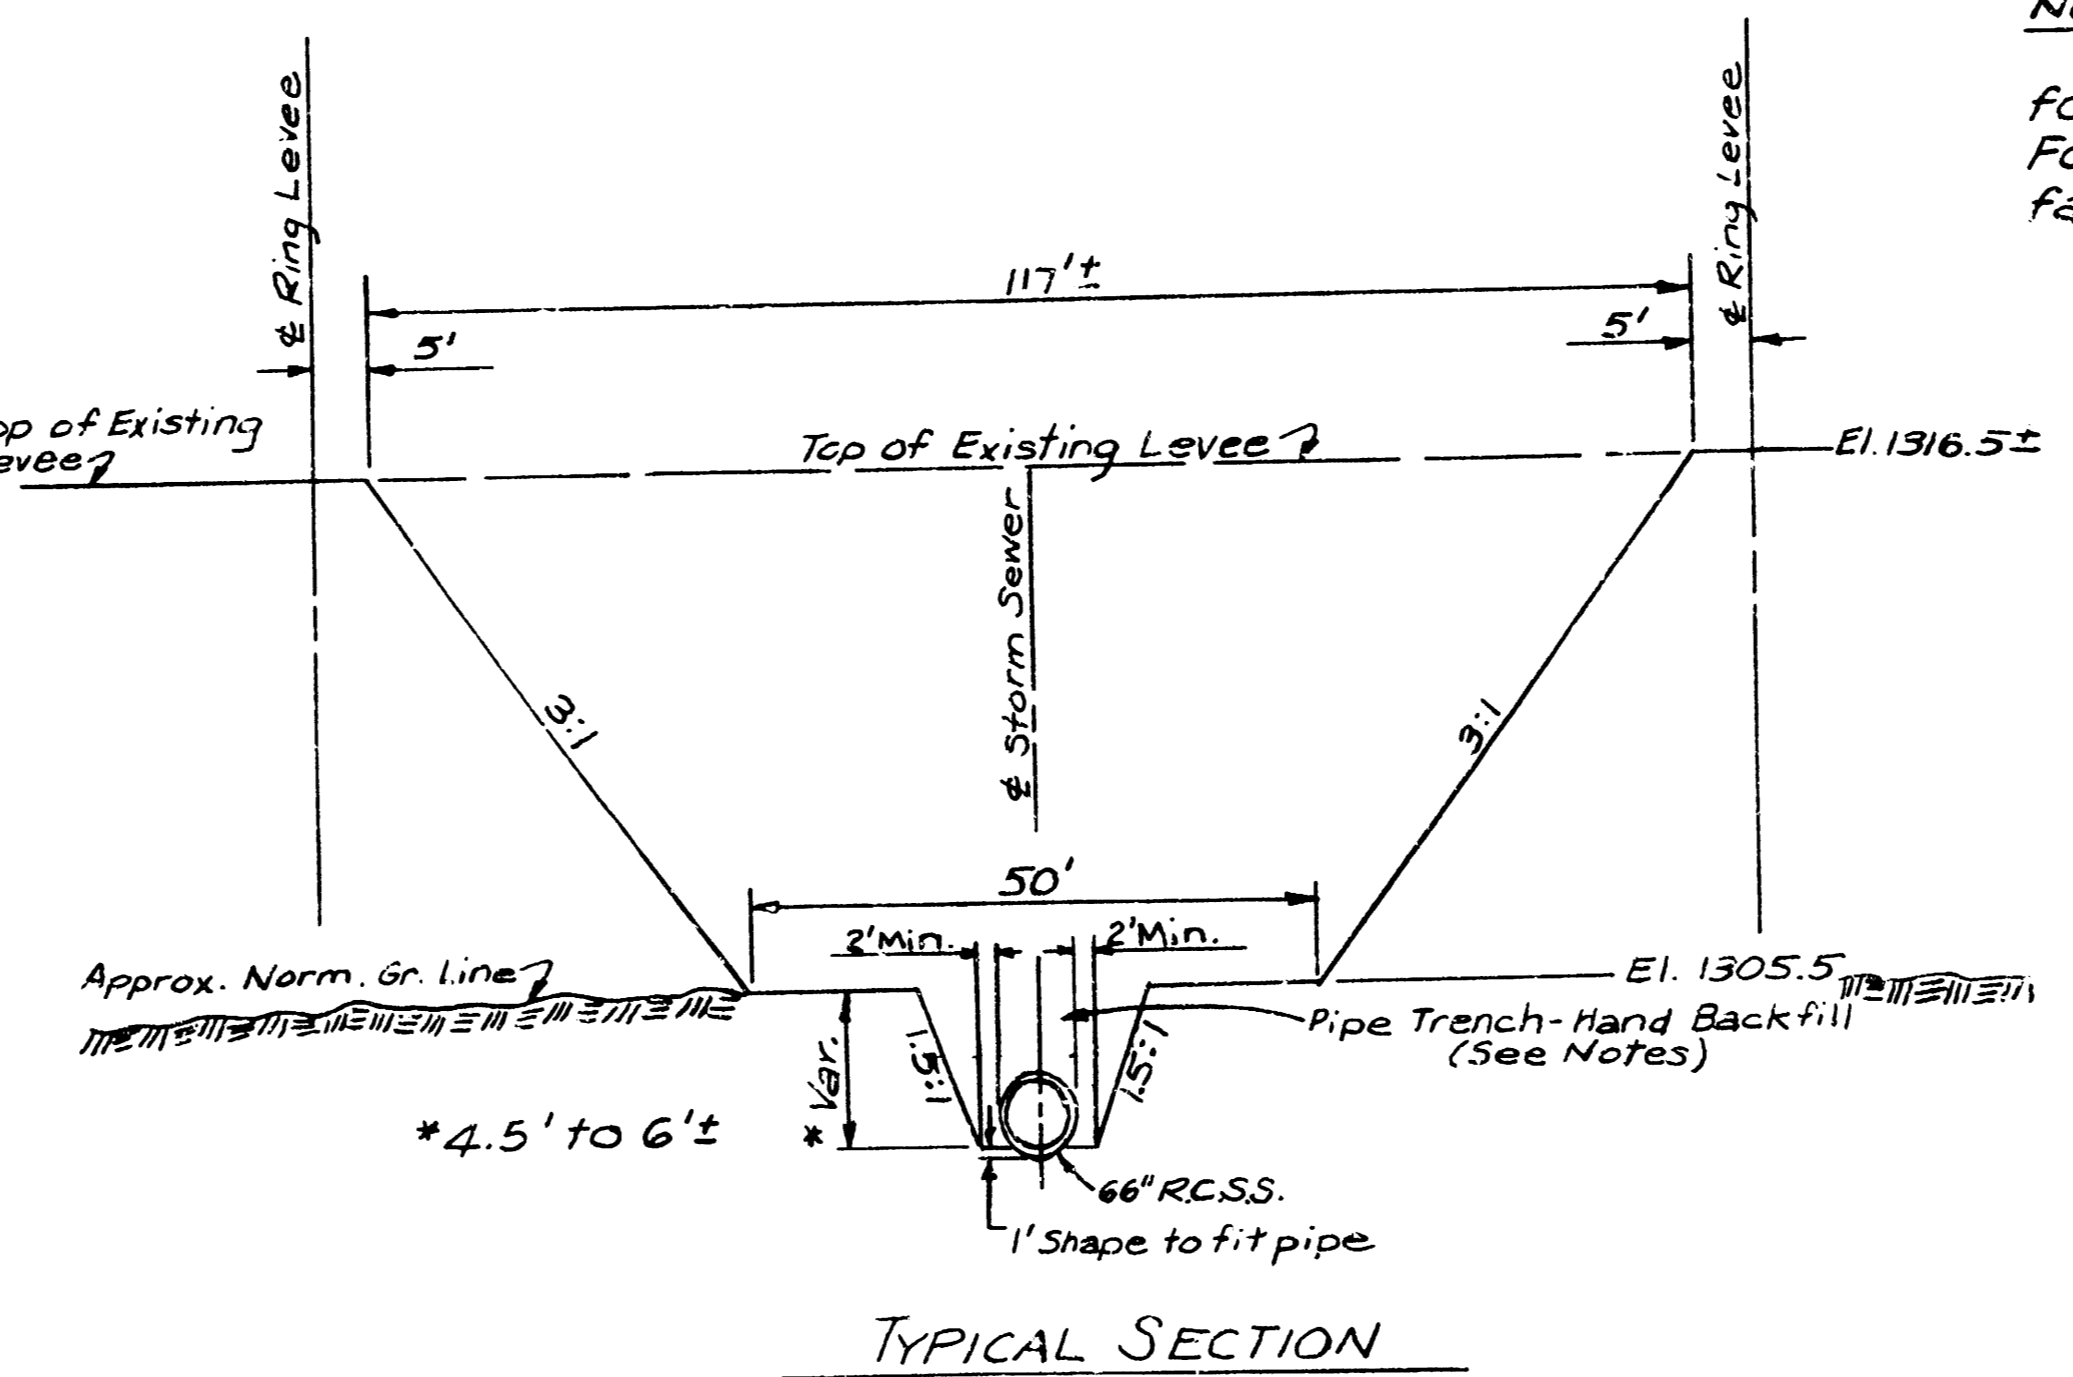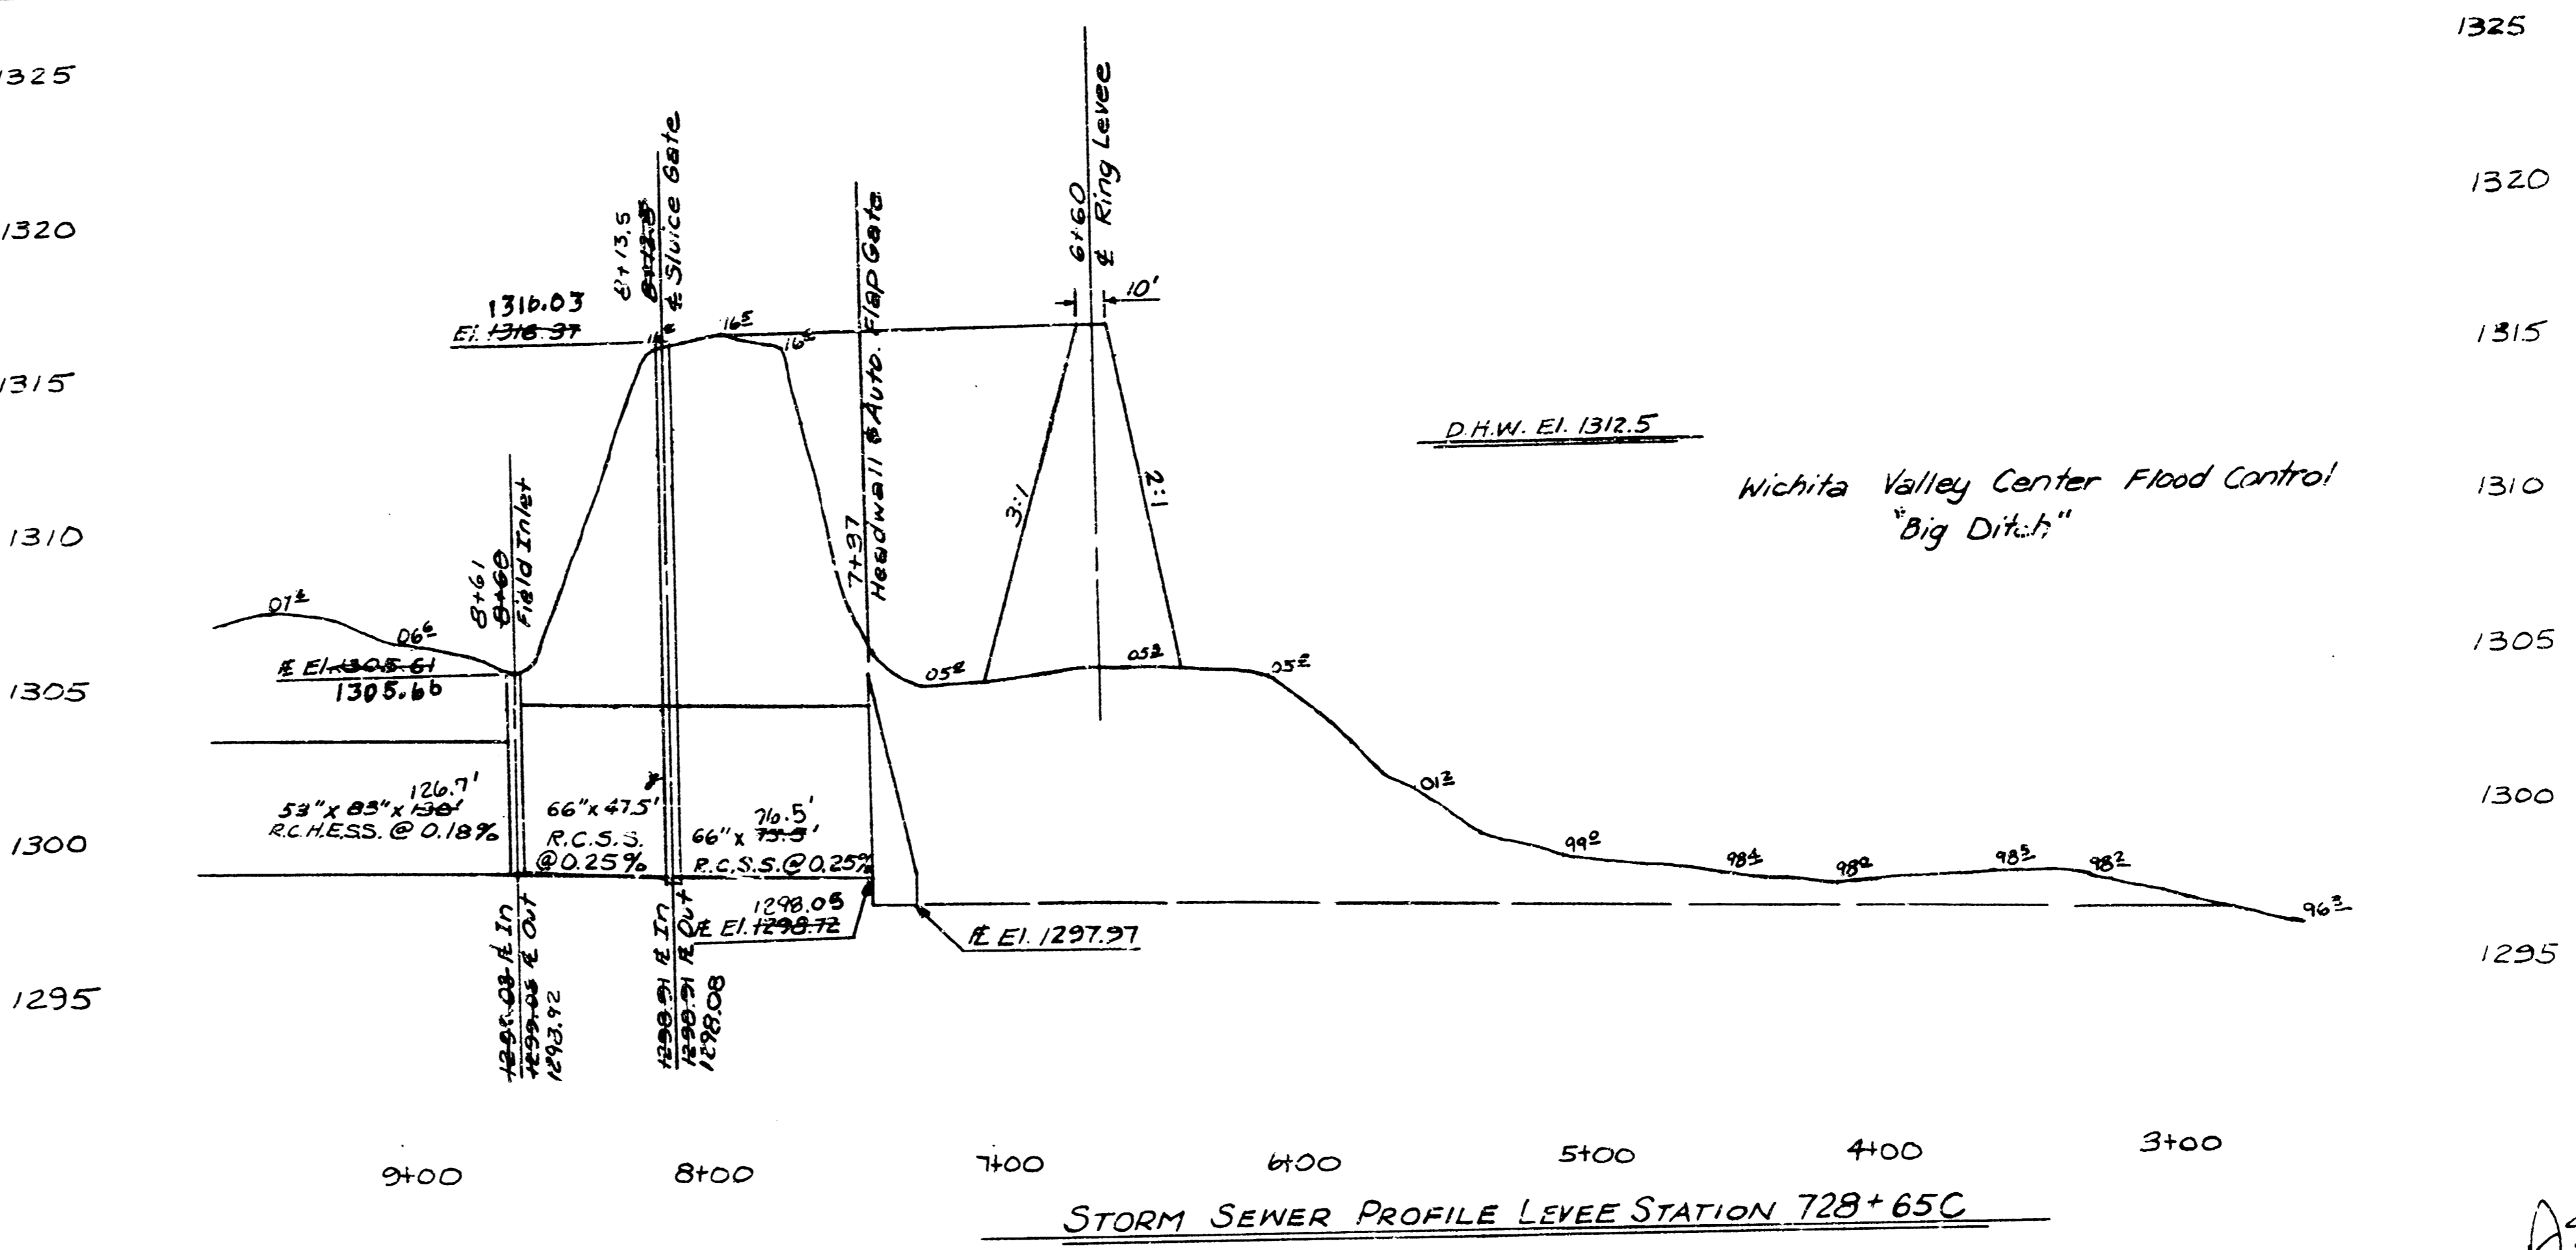

7. Accomplish levee replacements by placing fill in 6-inch lifts and compacting by not less than eight complete passes of a tamping roller. The fill shall also be equal to 95 percent Standard AASHTO density. After compaction the moisture content shall be within the limits of 3 percentage points above optimum to 2 percentage points below optimum moisture content. All levee backfill shall consist of impervious materials.
8. Determine the in-place moisture content and density of the levee fill on a frequency of about one sample for each 2500 cubic yards of backfill placed.
9. When the breached levee has been reconstructed to its original grade, remove the temporary ring levee and dress and turf the surface areas of the plugged section and outlet channel with 450 lb. per acre mixture of 50 percent brom and 50 percent fescue.
10. Construction of ring levee, excavation of existing levee, compacted backfill of pipe under levee, replacement of compacted fill for levee, removal of ring levee, excavation of outlet channel and reseeding of disturbed areas will be paid for as 1 lump sum bid item of "Levee Breach."

**NOTE:**  
Levee Breach Details drawn to M.S.L. elevations for convenient reference to Flood Control Plans. For reference to City Datum, use conversion factor of -1187.40.

AS BUILT  
6-BS  
GREENE


**GENERAL NOTES**

1. Interurban traffic generated outside the project area and local business or apartment traffic generated within the project area are to be carried through construction.
2. Underground utility service lines and overhead utility pole lines are to be adjusted as necessary by others prior to or during construction unless the plans specifically call for their adjustment by the Contractor. Existing utilities and their location, as shown on the plans, represent the best information obtainable for design. Location information has been obtained from the various utility companies and is either from company record drawings or company provided field locations. The plan locations shown are not guaranteed. Additional existing utilities may also be encountered. The Contractor will be required to work around existing utilities within the right-of-way which do not conflict with proposed construction.
3. A saw cut of at least one-half the depth of existing surface courses or one-fourth the depth of the existing total pavement thickness shall be provided at locations where proposed construction abuts an existing surface course or pavement for which partial removal of that surface or pavement is required. Such saw cuts will not be paid for directly and this cost shall be considered as subsidiary to the removal of the surface or pavement.
4. Rubble from the removal of miscellaneous structures and excess excavation which is to be wasted shall be disposed of on sites to be provided by the Contractor. These sites shall be approved by the Engineer as to suitability, appearance and site location. Locations that, in the opinion of the Engineer, will leave an unsightly appearance will not be approved.
5. The Contractor will notify pipeline companies at least 24 hours in advance of any work being performed across and/or adjacent to pipelines.
6. Trees and shrubs in public right-of-way which are in direct conflict with proposed new construction shall be removed by the Contractor with the Engineer's approval. Trees and shrubs which are not in conflict with proposed new construction shall be saved and protected from damage.
7. The Contractor shall give all property owners and/or tenants of developed property directly affected by the construction of this project a minimum of 24 hours advance notice prior to start of construction.
8. The Contractor shall be responsible for preserving property irons. The Contractor will be required to re-establish any property irons which are damaged or destroyed by his construction operations. Such irons shall be re-established by a licensed land surveyor or a licensed professional engineer in accordance with state laws.

Rev. 12-7-84

**LEVEE BREACH DETAILS AND GENERAL NOTES**

Nov. 1981

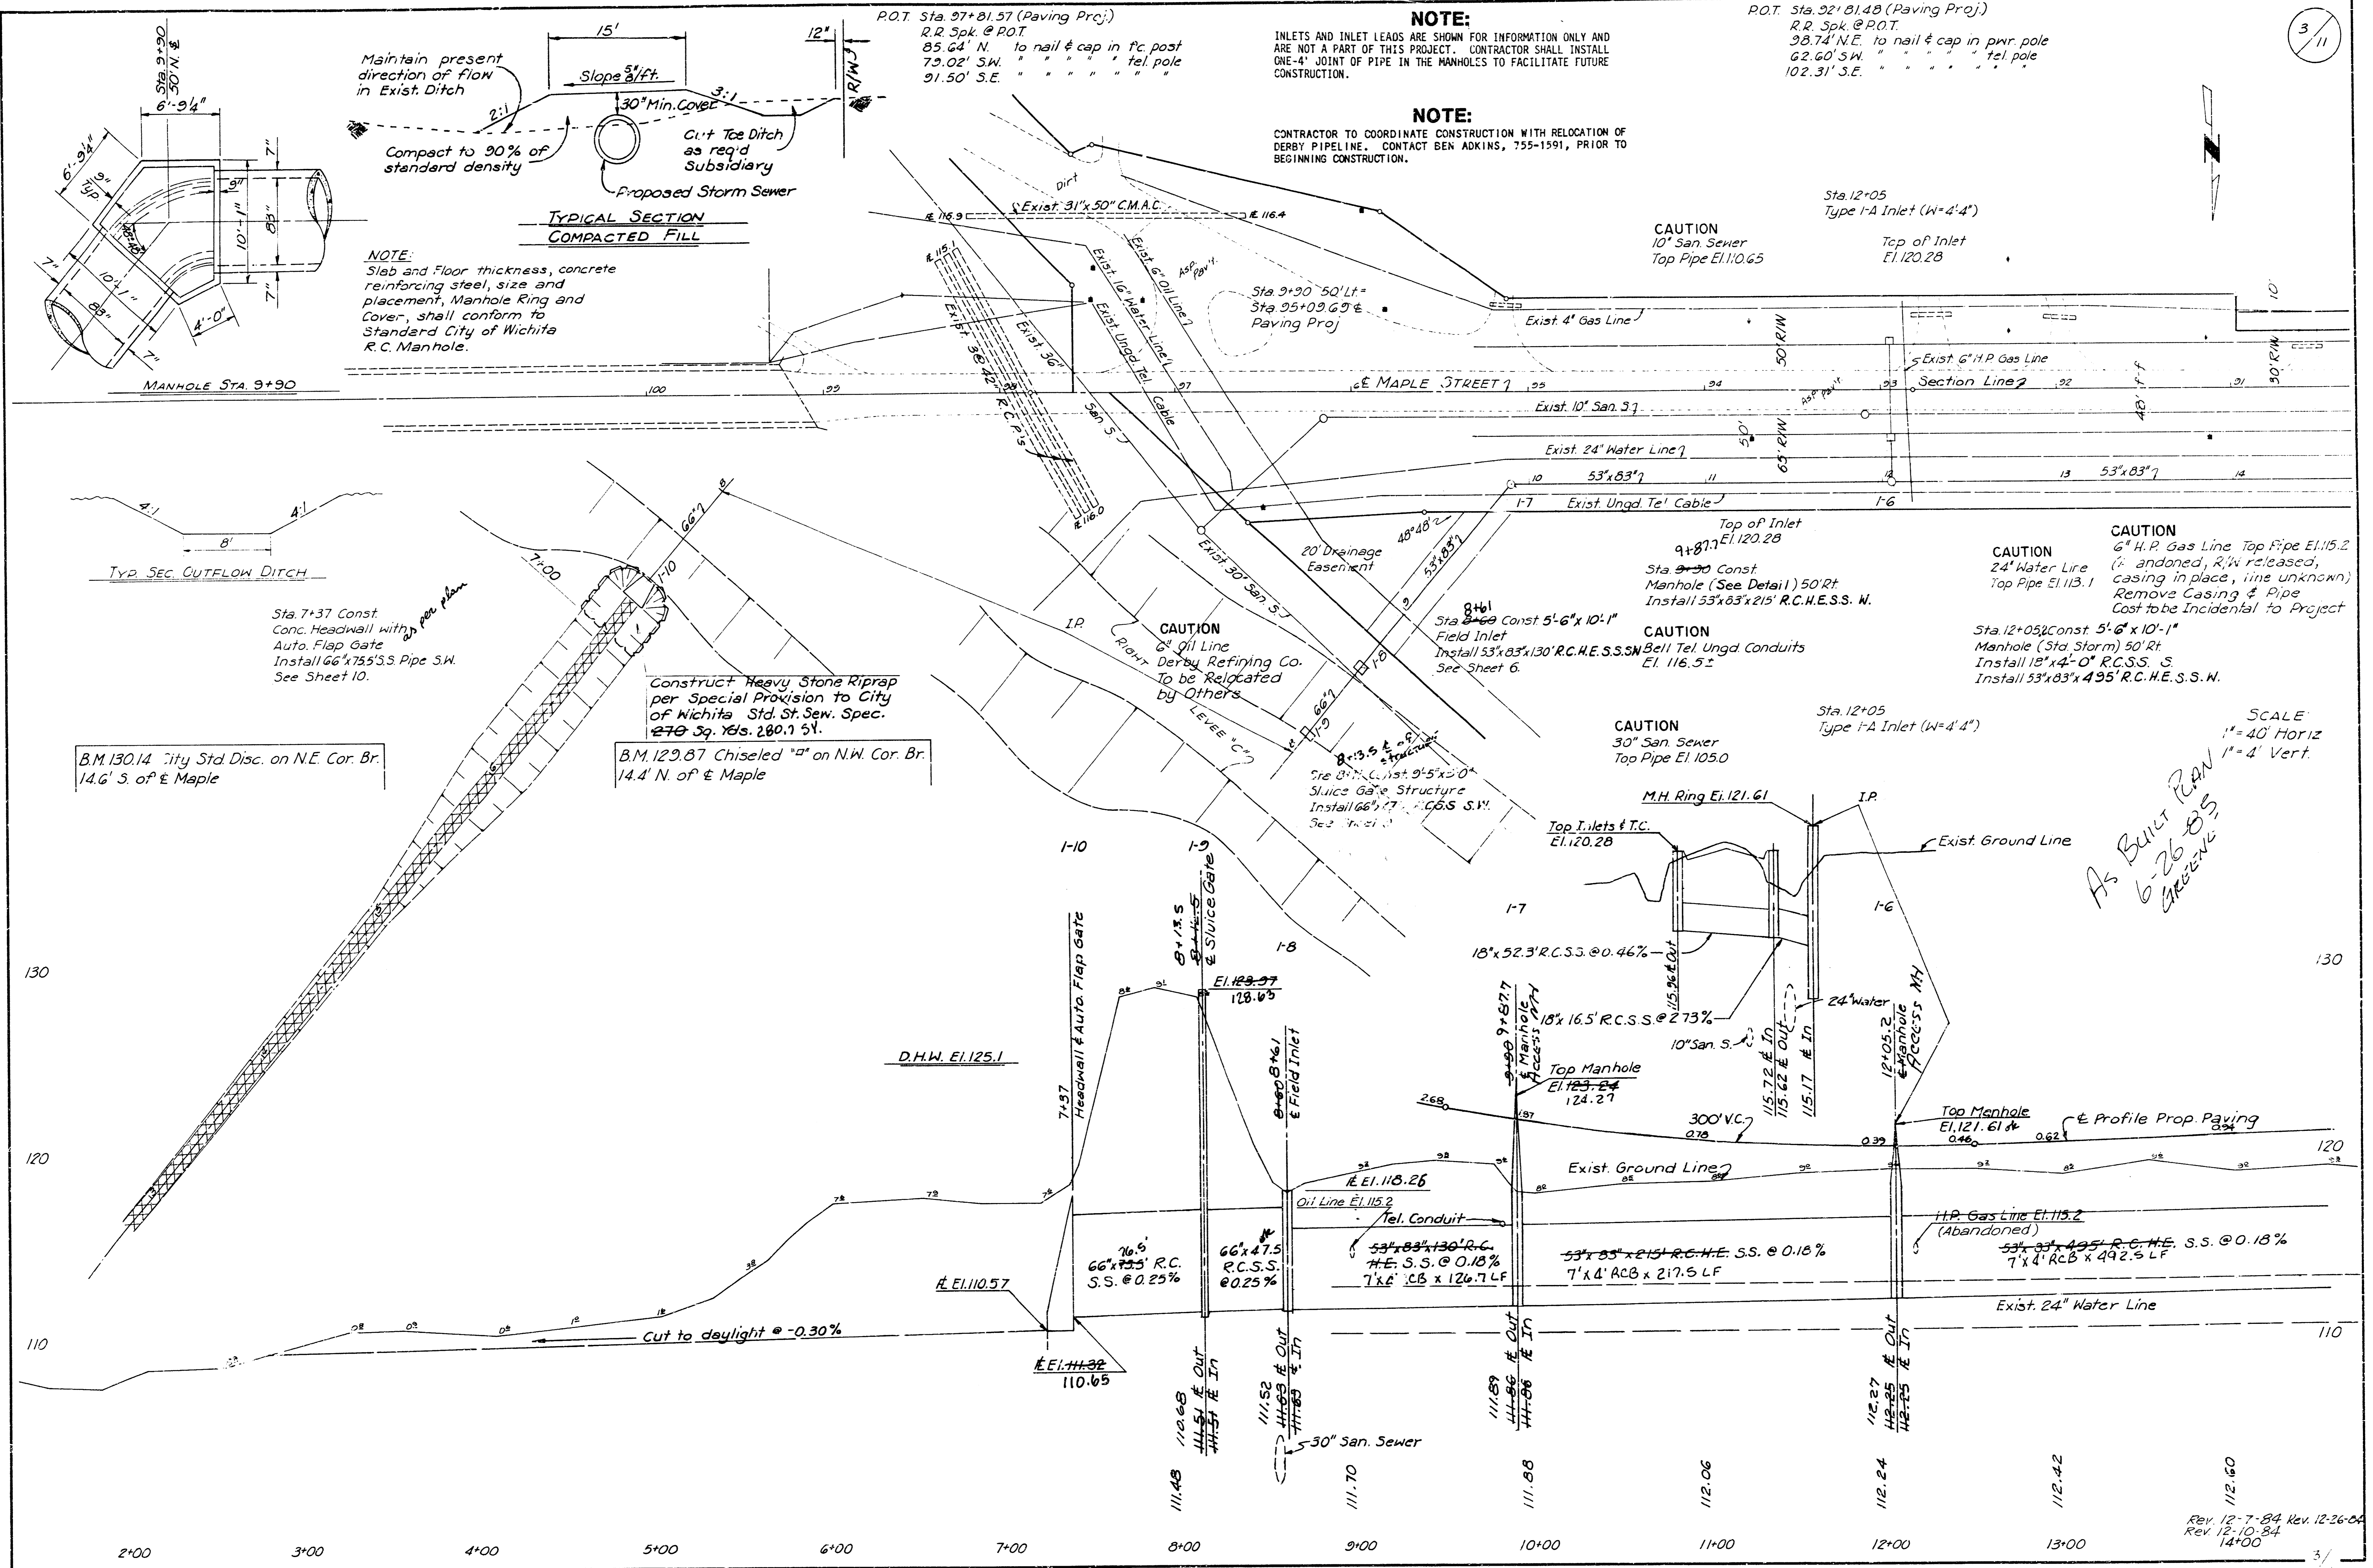

Maintain present direction of flow in Exist. Ditch

Compact to 90% of standard density

**TYPICAL SECTION COMPACTED FILL**

**NOTE:**  
Slab and floor thickness, concrete reinforcing steel, size and placement, Manhole Ring and Cover, shall conform to Standard City of Wichita R.C. Manhole.

P.O.T. Sta. 97+81.57 (Paving Proj.)  
R.R. Spk @ P.O.T.  
85.64' N. to nail & cap in p.c. post  
79.02' S.W. " " " " " " tel pole  
91.50' S.E. " " " " " " " "

**NOTE:**  
INLETS AND INLET LEADS ARE SHOWN FOR INFORMATION ONLY AND ARE NOT A PART OF THIS PROJECT. CONTRACTOR SHALL INSTALL ONE-4" JOINT OF PIPE IN THE MANHOLES TO FACILITATE FUTURE CONSTRUCTION.

**NOTE:**  
CONTRACTOR TO COORDINATE CONSTRUCTION WITH RELOCATION OF DERBY PIPELINE. CONTACT BEN ADKINS, 755-1591, PRIOR TO BEGINNING CONSTRUCTION.

P.O.T. Sta. 92+81.48 (Paving Proj.)  
R.R. Spk @ P.O.T.  
98.74' N.E. to nail & cap in pwr. pole  
62.60' S.W. " " " " " " tel pole  
102.31' S.E. " " " " " " " "

Sta. 7+37 Const. Conc. Headwall with Auto. Flap Gate  
Install 66"x75" S.S. Pipe S.W.  
See Sheet 10.

B.M. 130.14 City Std. Disc. on N.E. Cor. Br. 14.6' S. of E Maple

Construct Heavy Stone Riprap per Special Provision to City of Wichita Std. St. Sew. Spec. 1278 Sp. 16s. 280.1 51.

B.M. 129.87 Chiseled "M" on N.W. Cor. Br. 14.4' N. of E Maple

D.H.W. El. 125.1

**CAUTION**  
30" San. Sewer  
Top Pipe El. 105.0

**CAUTION**  
10' San. Sewer  
Top Pipe El. 110.65

**CAUTION**  
24" Water Line  
Top Pipe El. 113.1

**CAUTION**  
6" H.P. Gas Line  
Top Pipe El. 115.2  
(Abandoned, R/W released, casing in place, line unknown)  
Remove Casing & Pipe  
Cost to be Incidental to Project

**CAUTION**  
Sta. 12+05 Const. 5'-6" x 10'-1" Manhole (Std. Storm) 50' Rt.  
Install 18"x4'-0" R.C.S.S. S  
Install 53"x83"x495' R.C.H.E.S.S. N.

*As Built Plan  
6-26-85  
Green*

SCALE  
1" = 40' Horiz  
1" = 4' Vert


Rev. 12-7-84 Rev. 12-26-84  
Rev. 12-10-84  
14+00

**FILMED FROM THE BEST AVAILABLE COPY....**

**NOTE:**  
 INLETS AND INLET LEADS ARE SHOWN FOR INFORMATION ONLY AND ARE NOT A PART OF THIS PROJECT. CONTRACTOR SHALL INSTALL ONE-4" JOINT OF PIPE IN THE MANHOLES TO FACILITATE FUTURE CONSTRUCTION.

4 Sec Cor. Sta 79+28.29 (Paving Proj.)  
 1" Iron in Thimble @ Cor.  
 13'11" S. to nail & wshr. in tel. p. 13  
 42'26" N.W. to nail & wshr. in pwr. pole  
 62'95" S.E. to 60d nail in top tree stump

4/11

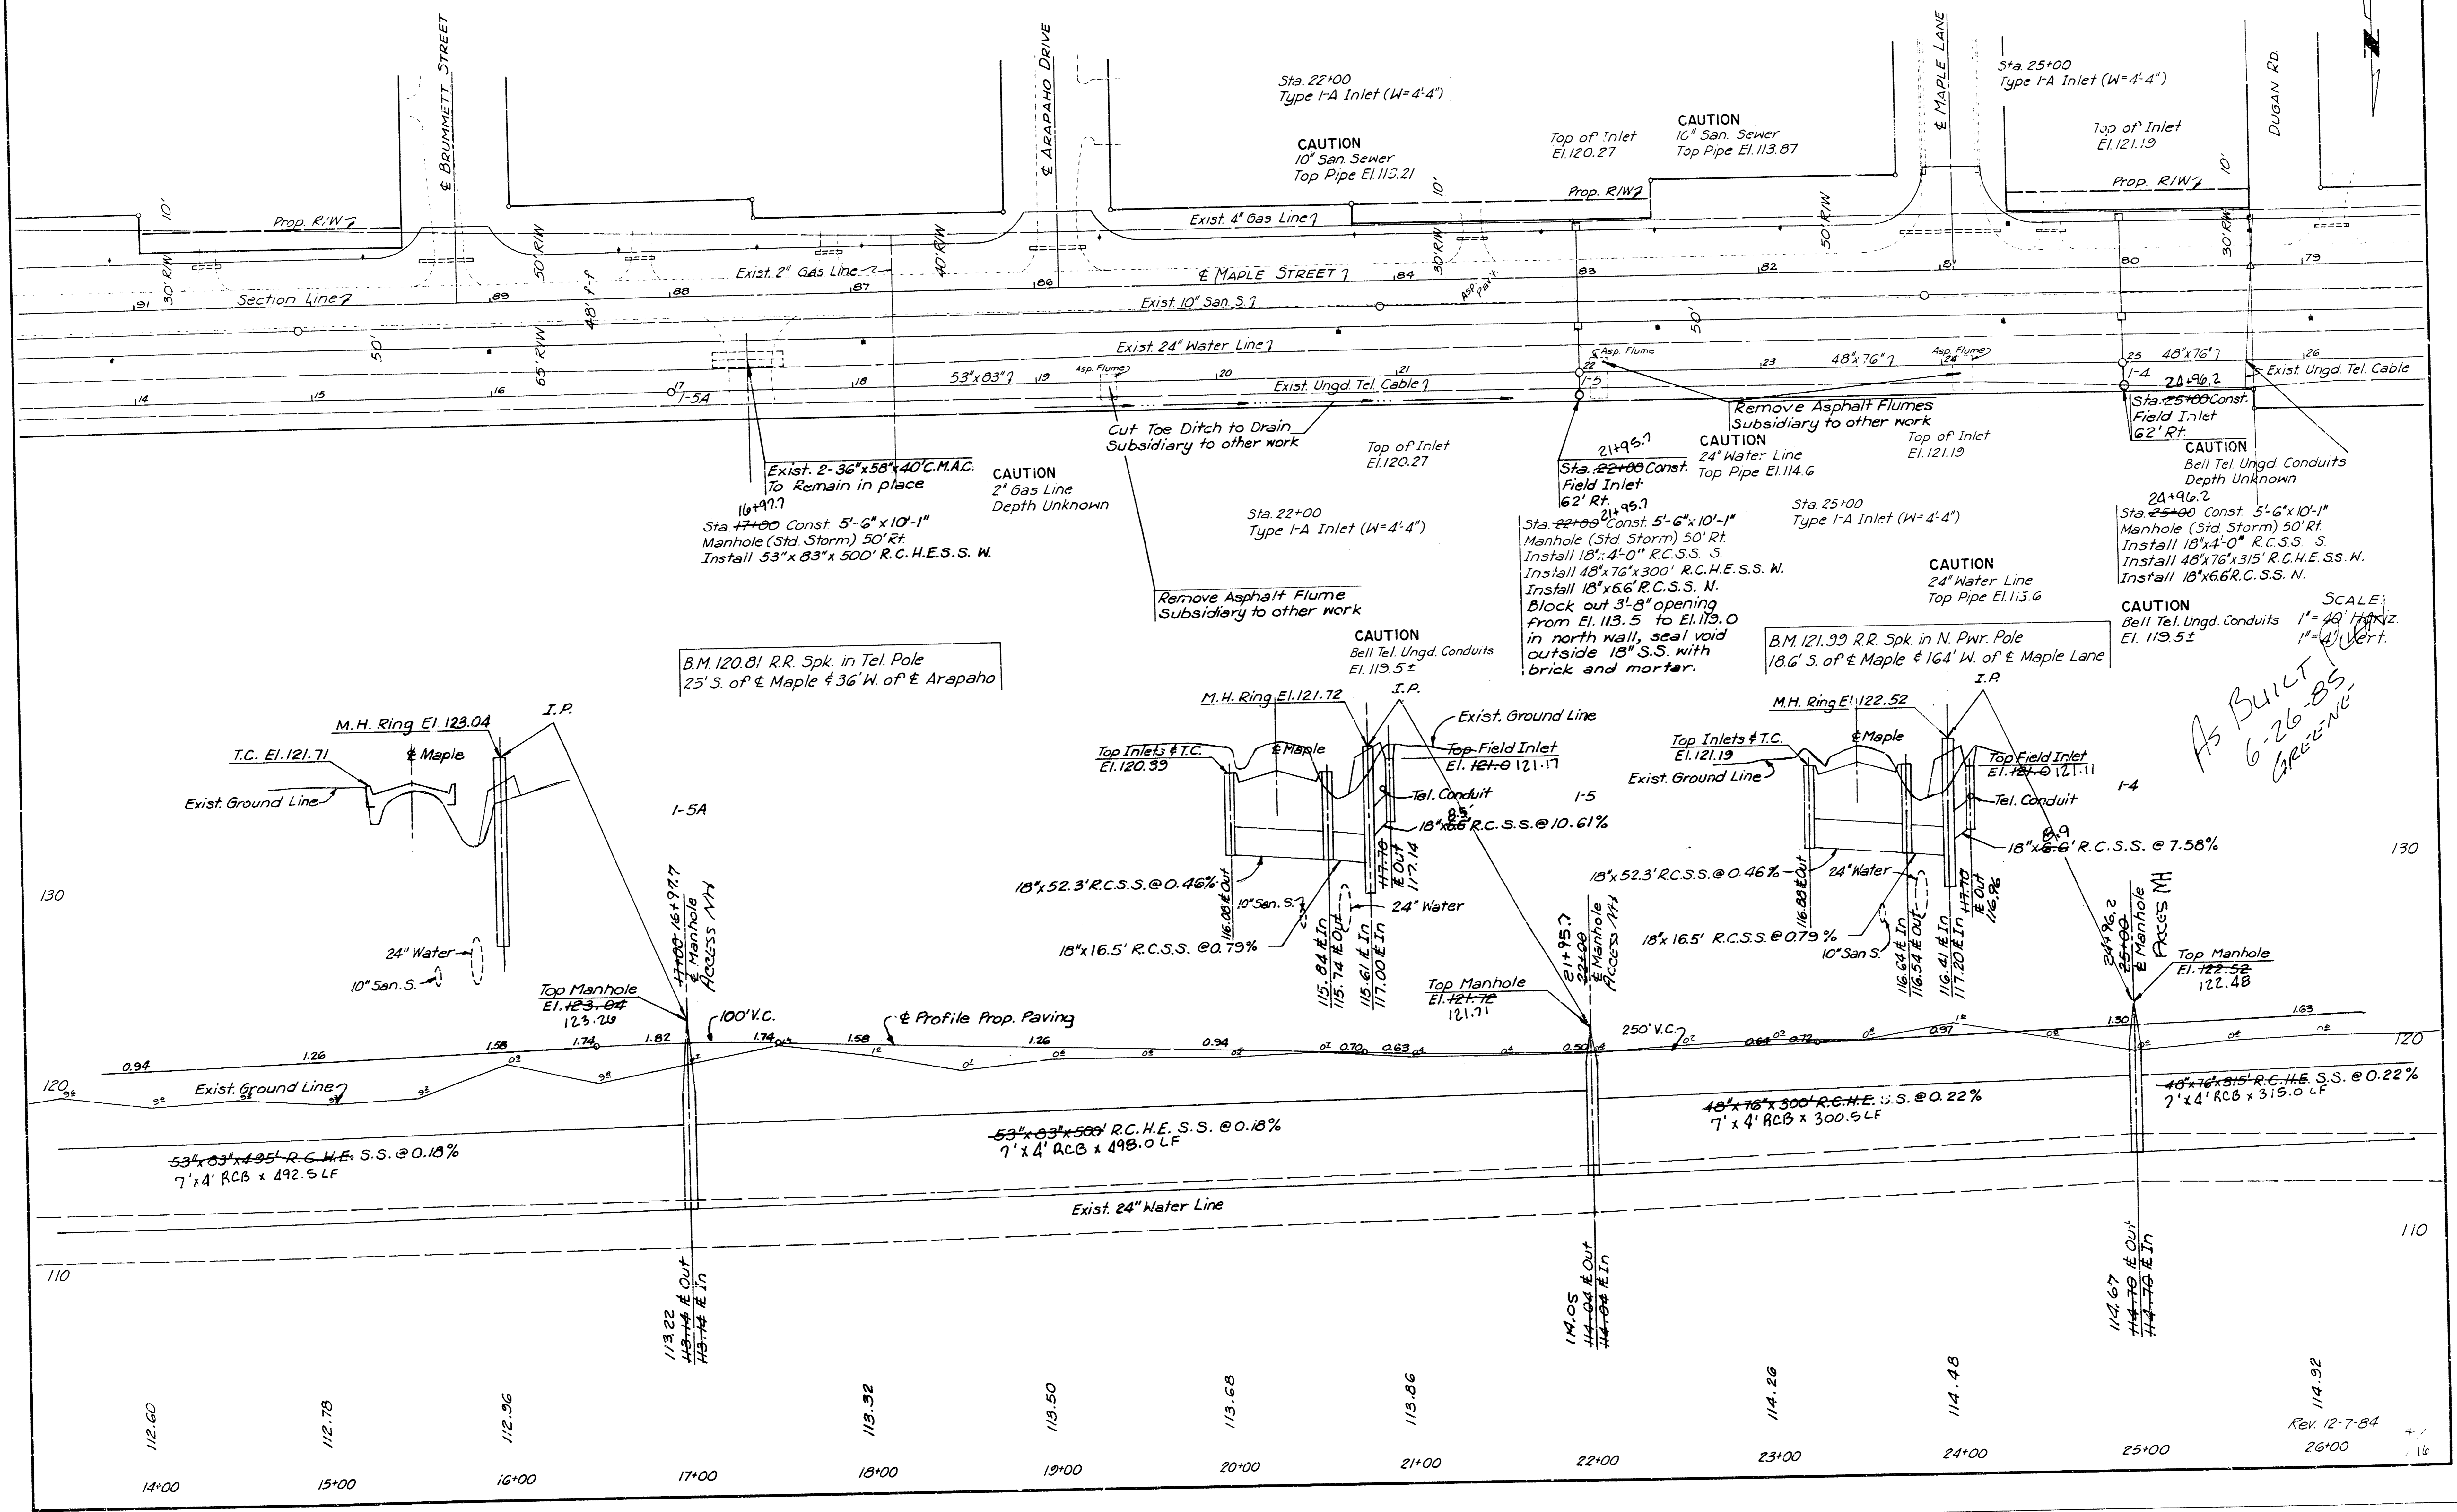


SCALE:  
 1" = 40' Horiz.  
 1" = 4' Vert.

As Built  
 6-26-85  
 GREENE

FILMED FROM THE BEST AVAILABLE COPY ....

**NOTE:**  
INLETS AND INLET LEADS ARE SHOWN FOR INFORMATION ONLY AND ARE NOT A PART OF THIS PROJECT. CONTRACTOR SHALL INSTALL ONE-4" JOINT OF PIPE IN THE MANHOLES TO FACILITATE FUTURE CONSTRUCTION.

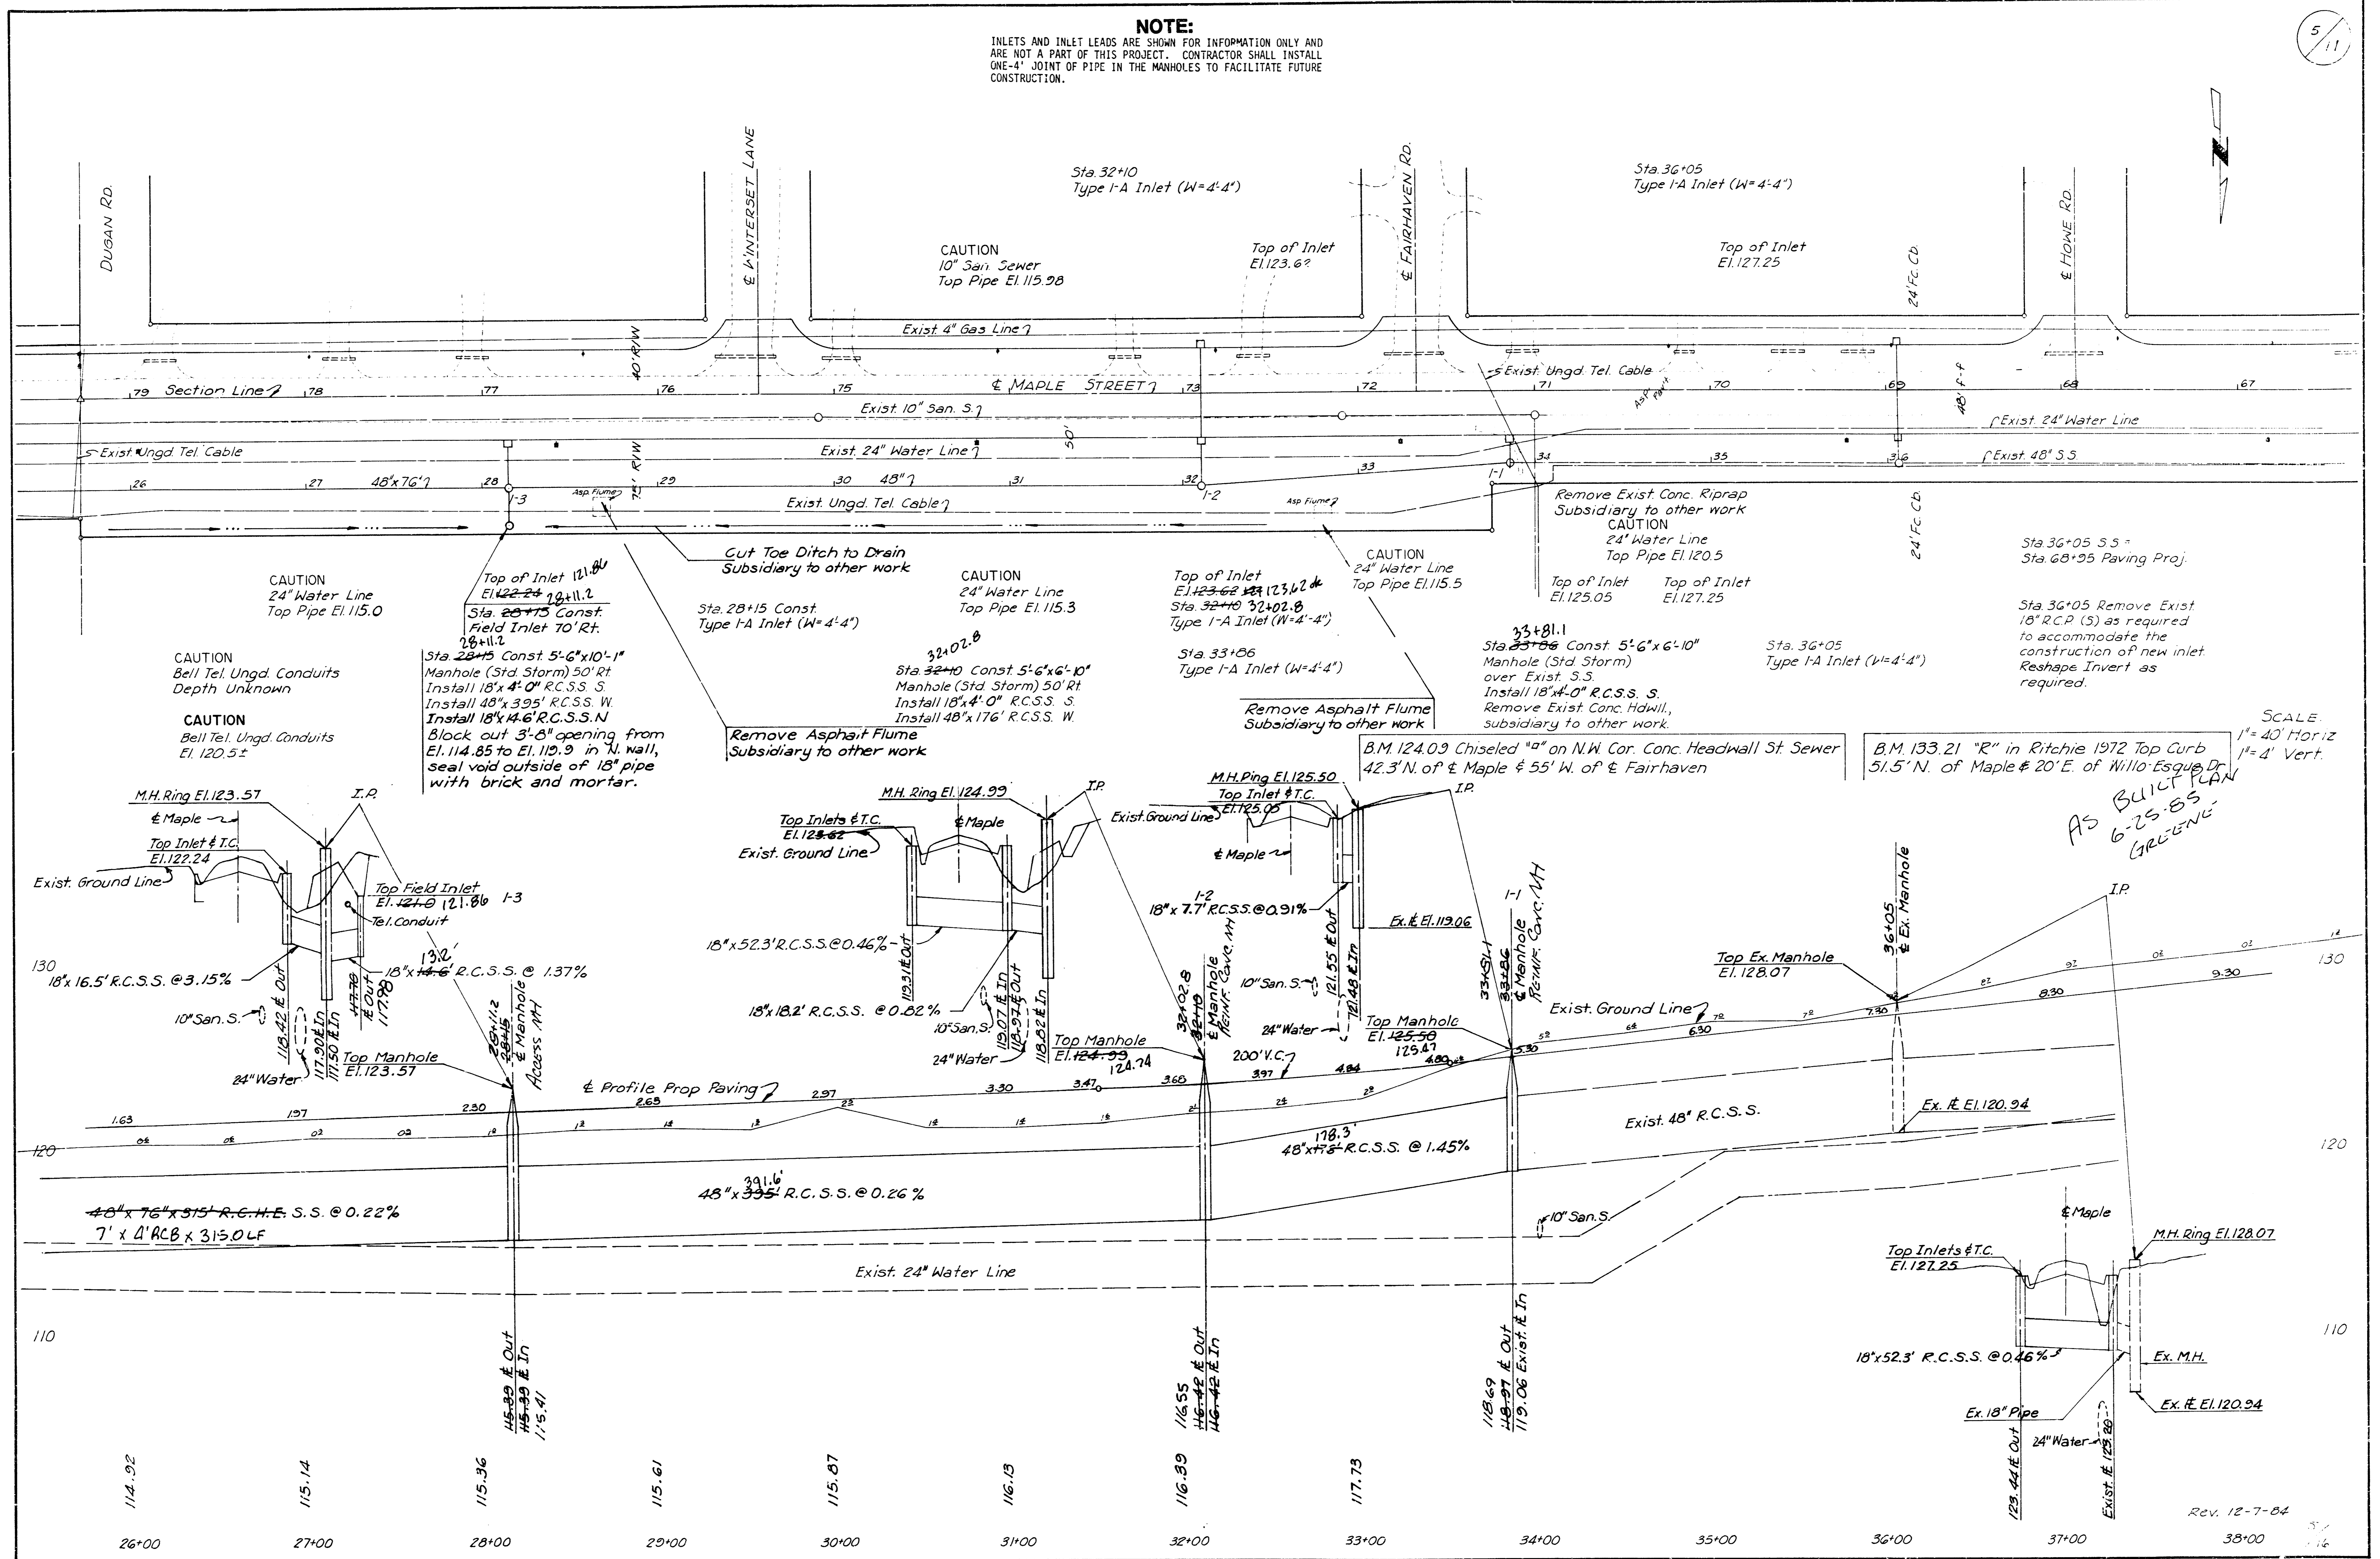


SCALE:  
1" = 40' Horiz  
1" = 4' Vert.  
AS BUILT PLAN  
6-25-85  
GREENE


Rev. 12-7-84

FILMED FROM THE BEST AVAILABLE COPY....




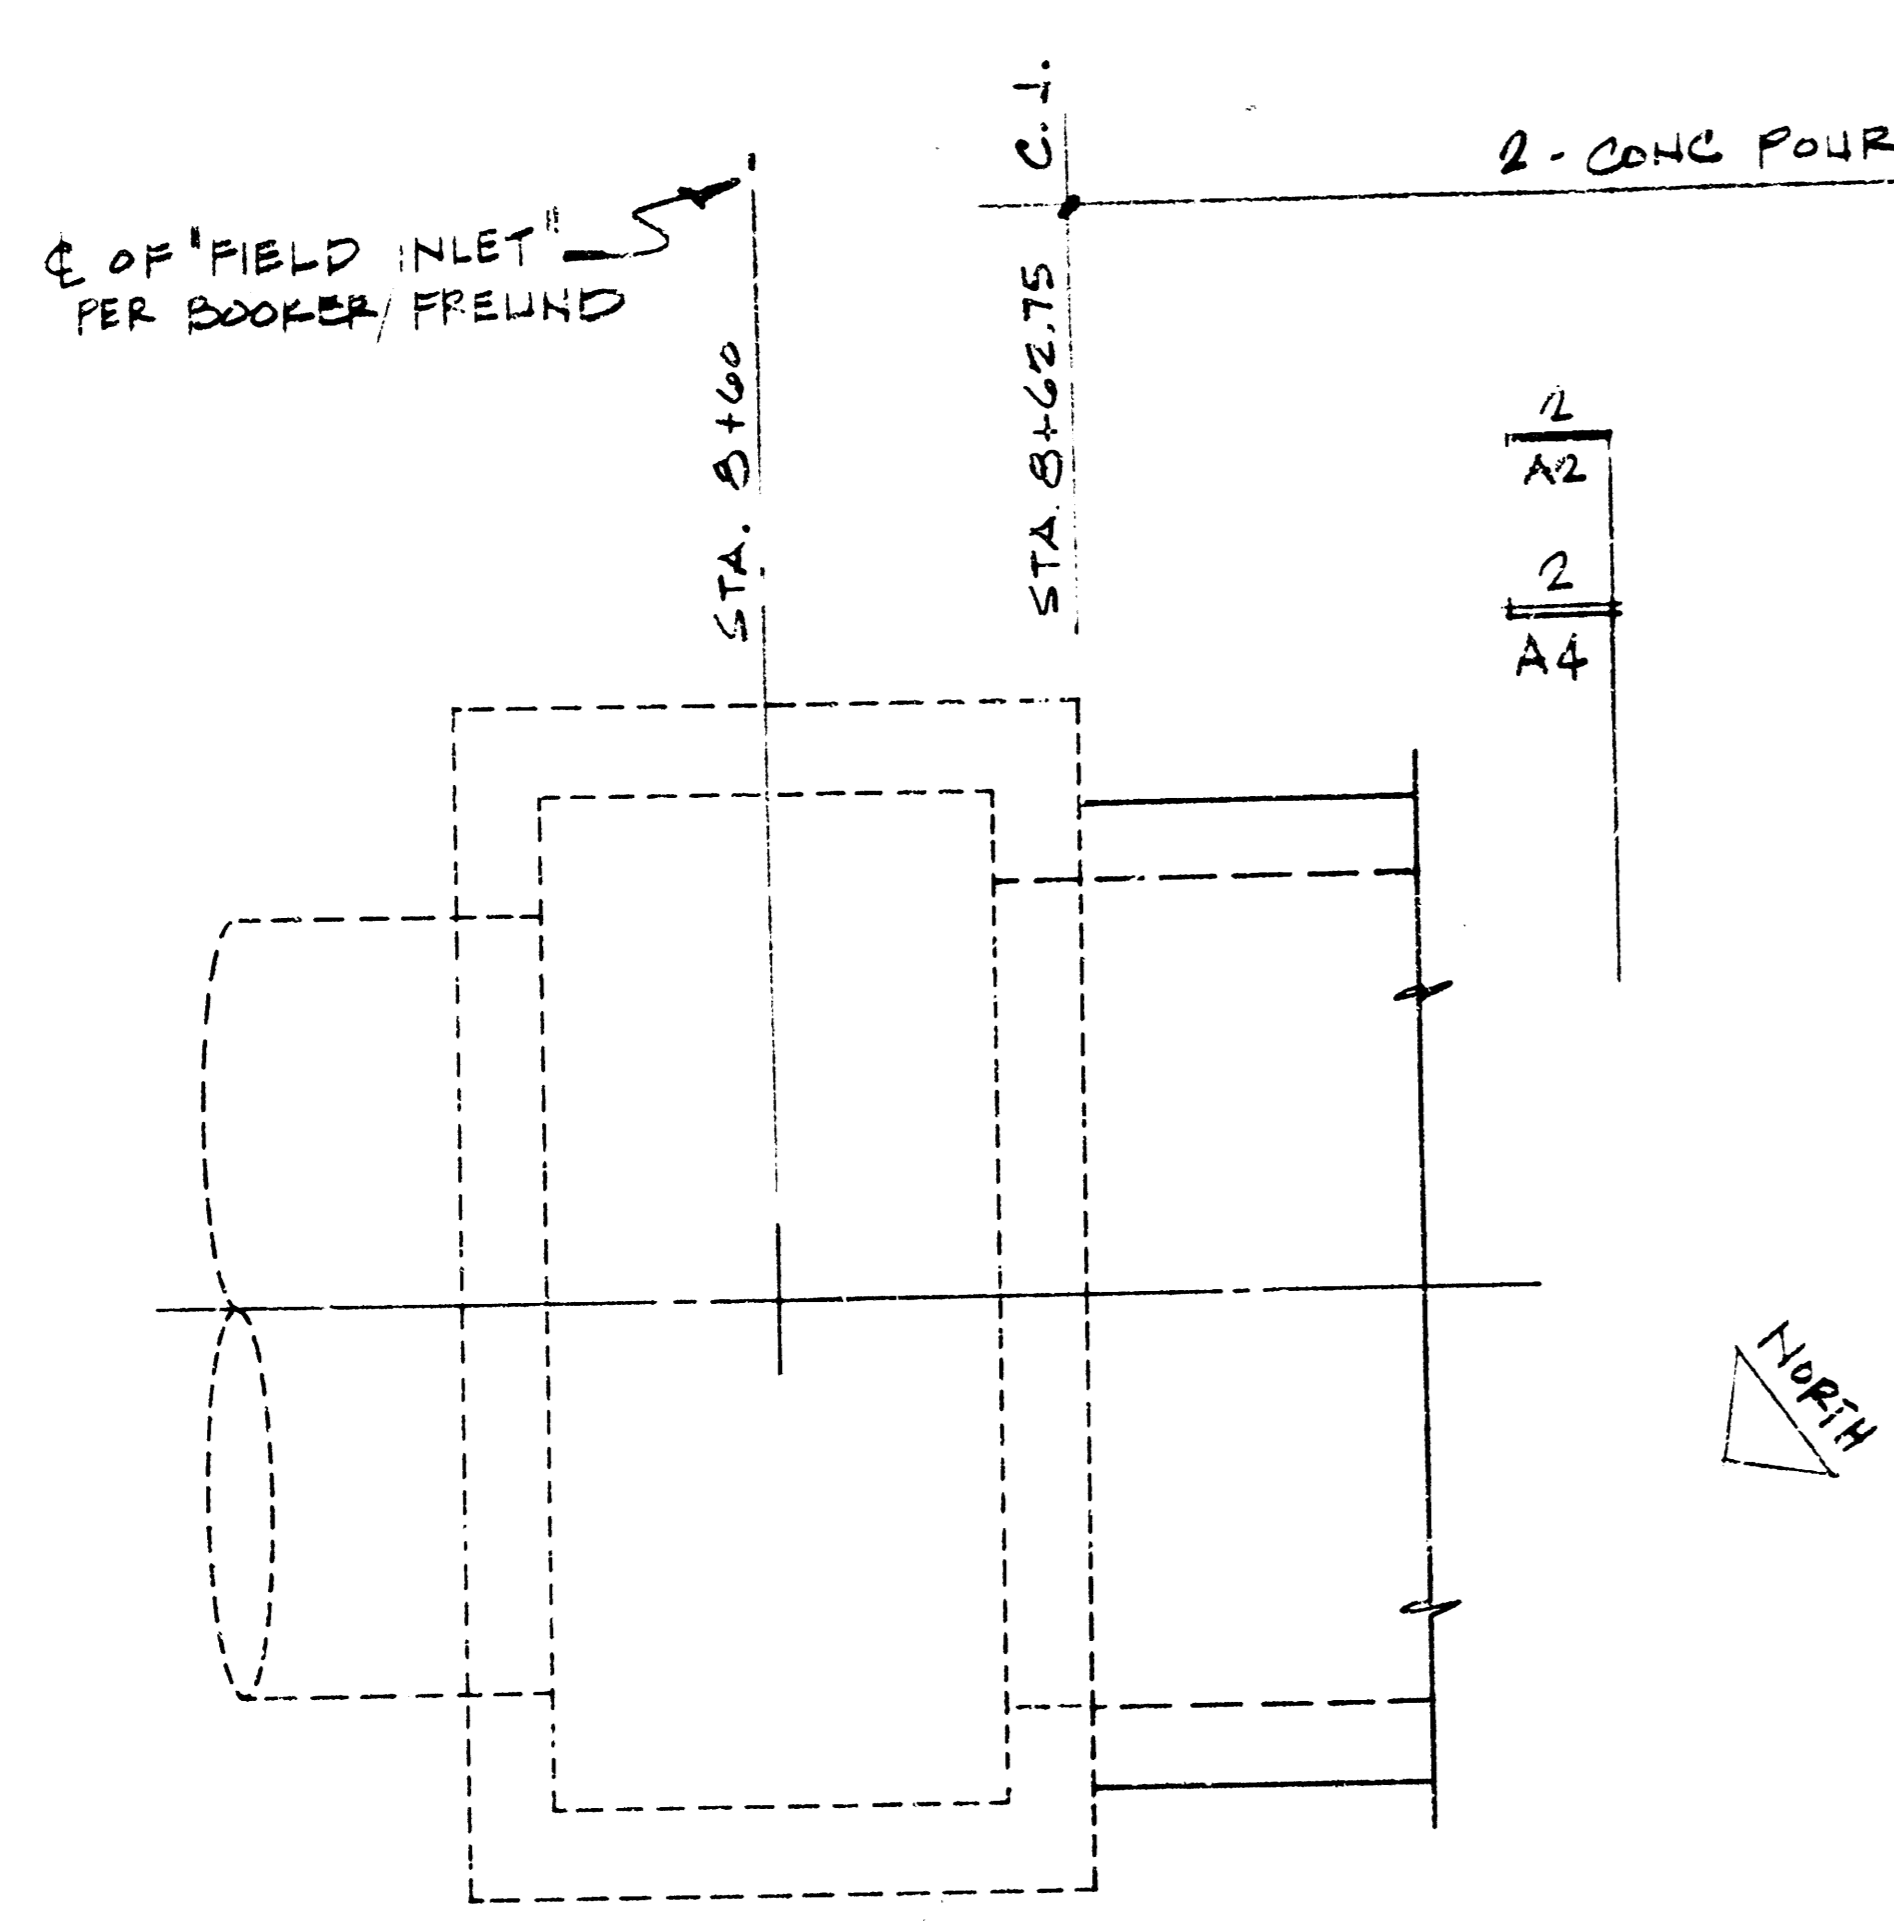


**A** PLAN VIEW @ "FIELD INLET" BY OTHERS  
1/2" = 1'-0"

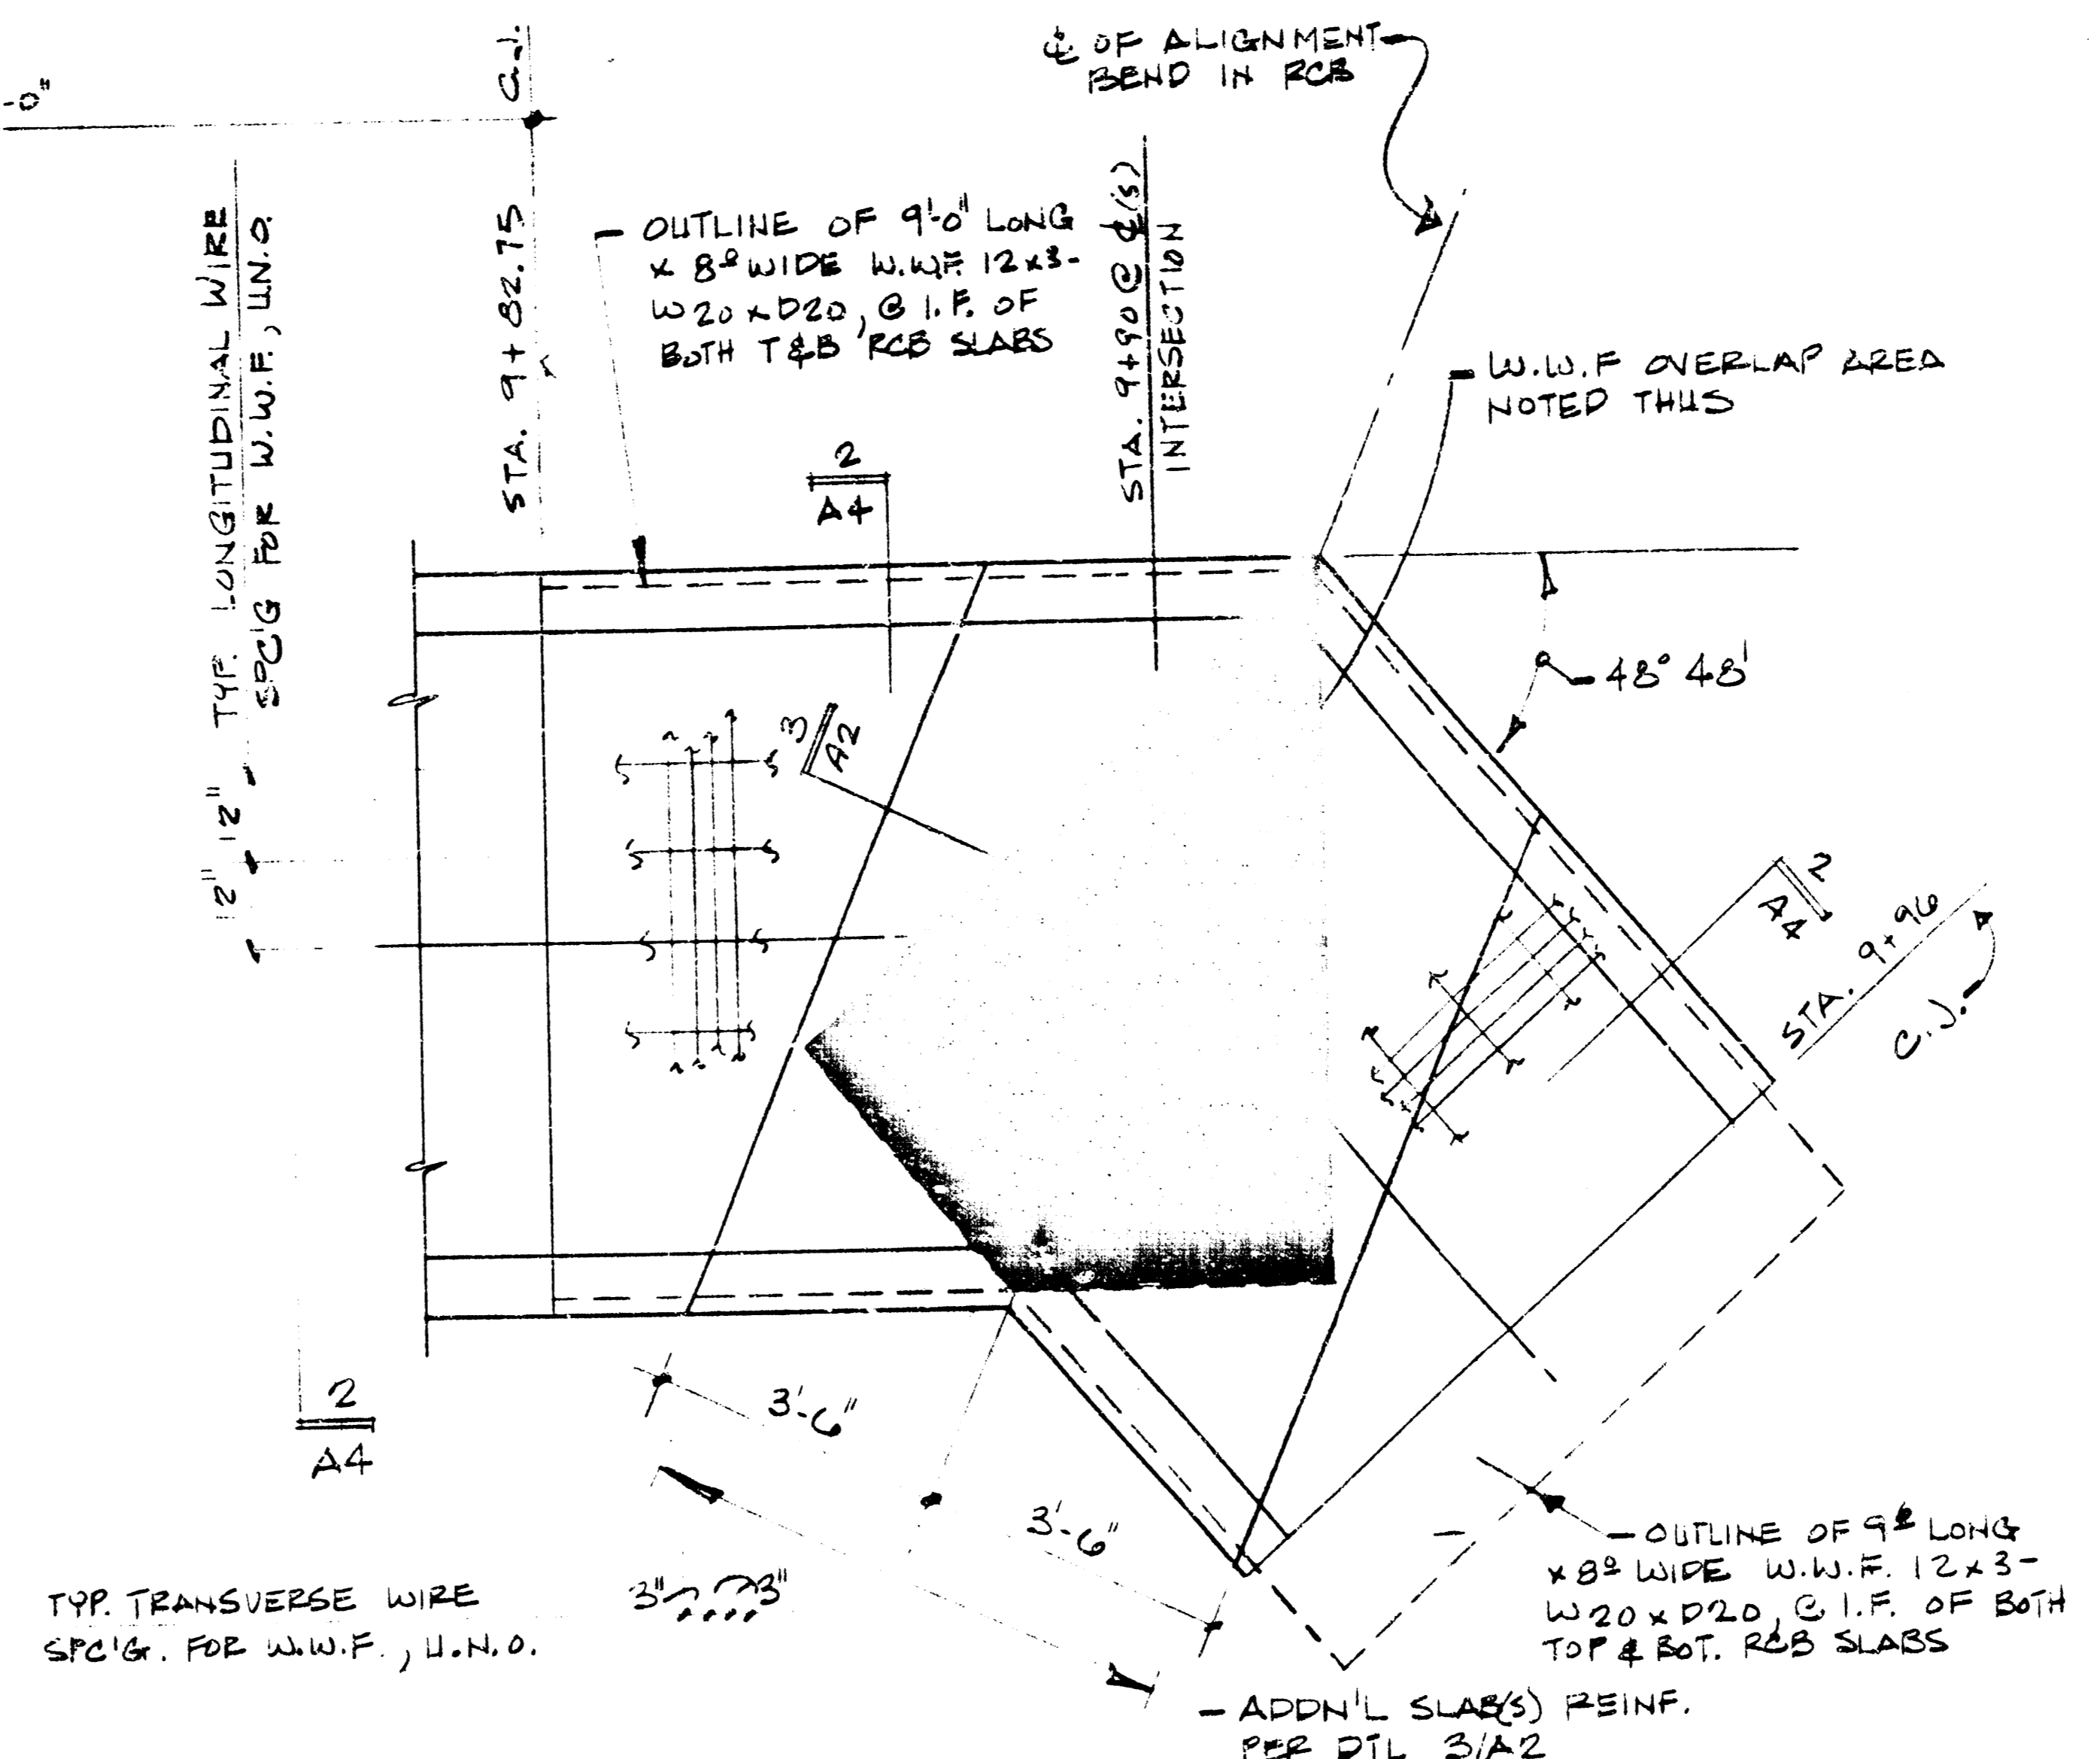


**B** PLAN VIEW @ ALIGNMENT BEND IN 7'-0" x 4'-0" RCB  
1/2" = 1'-0"

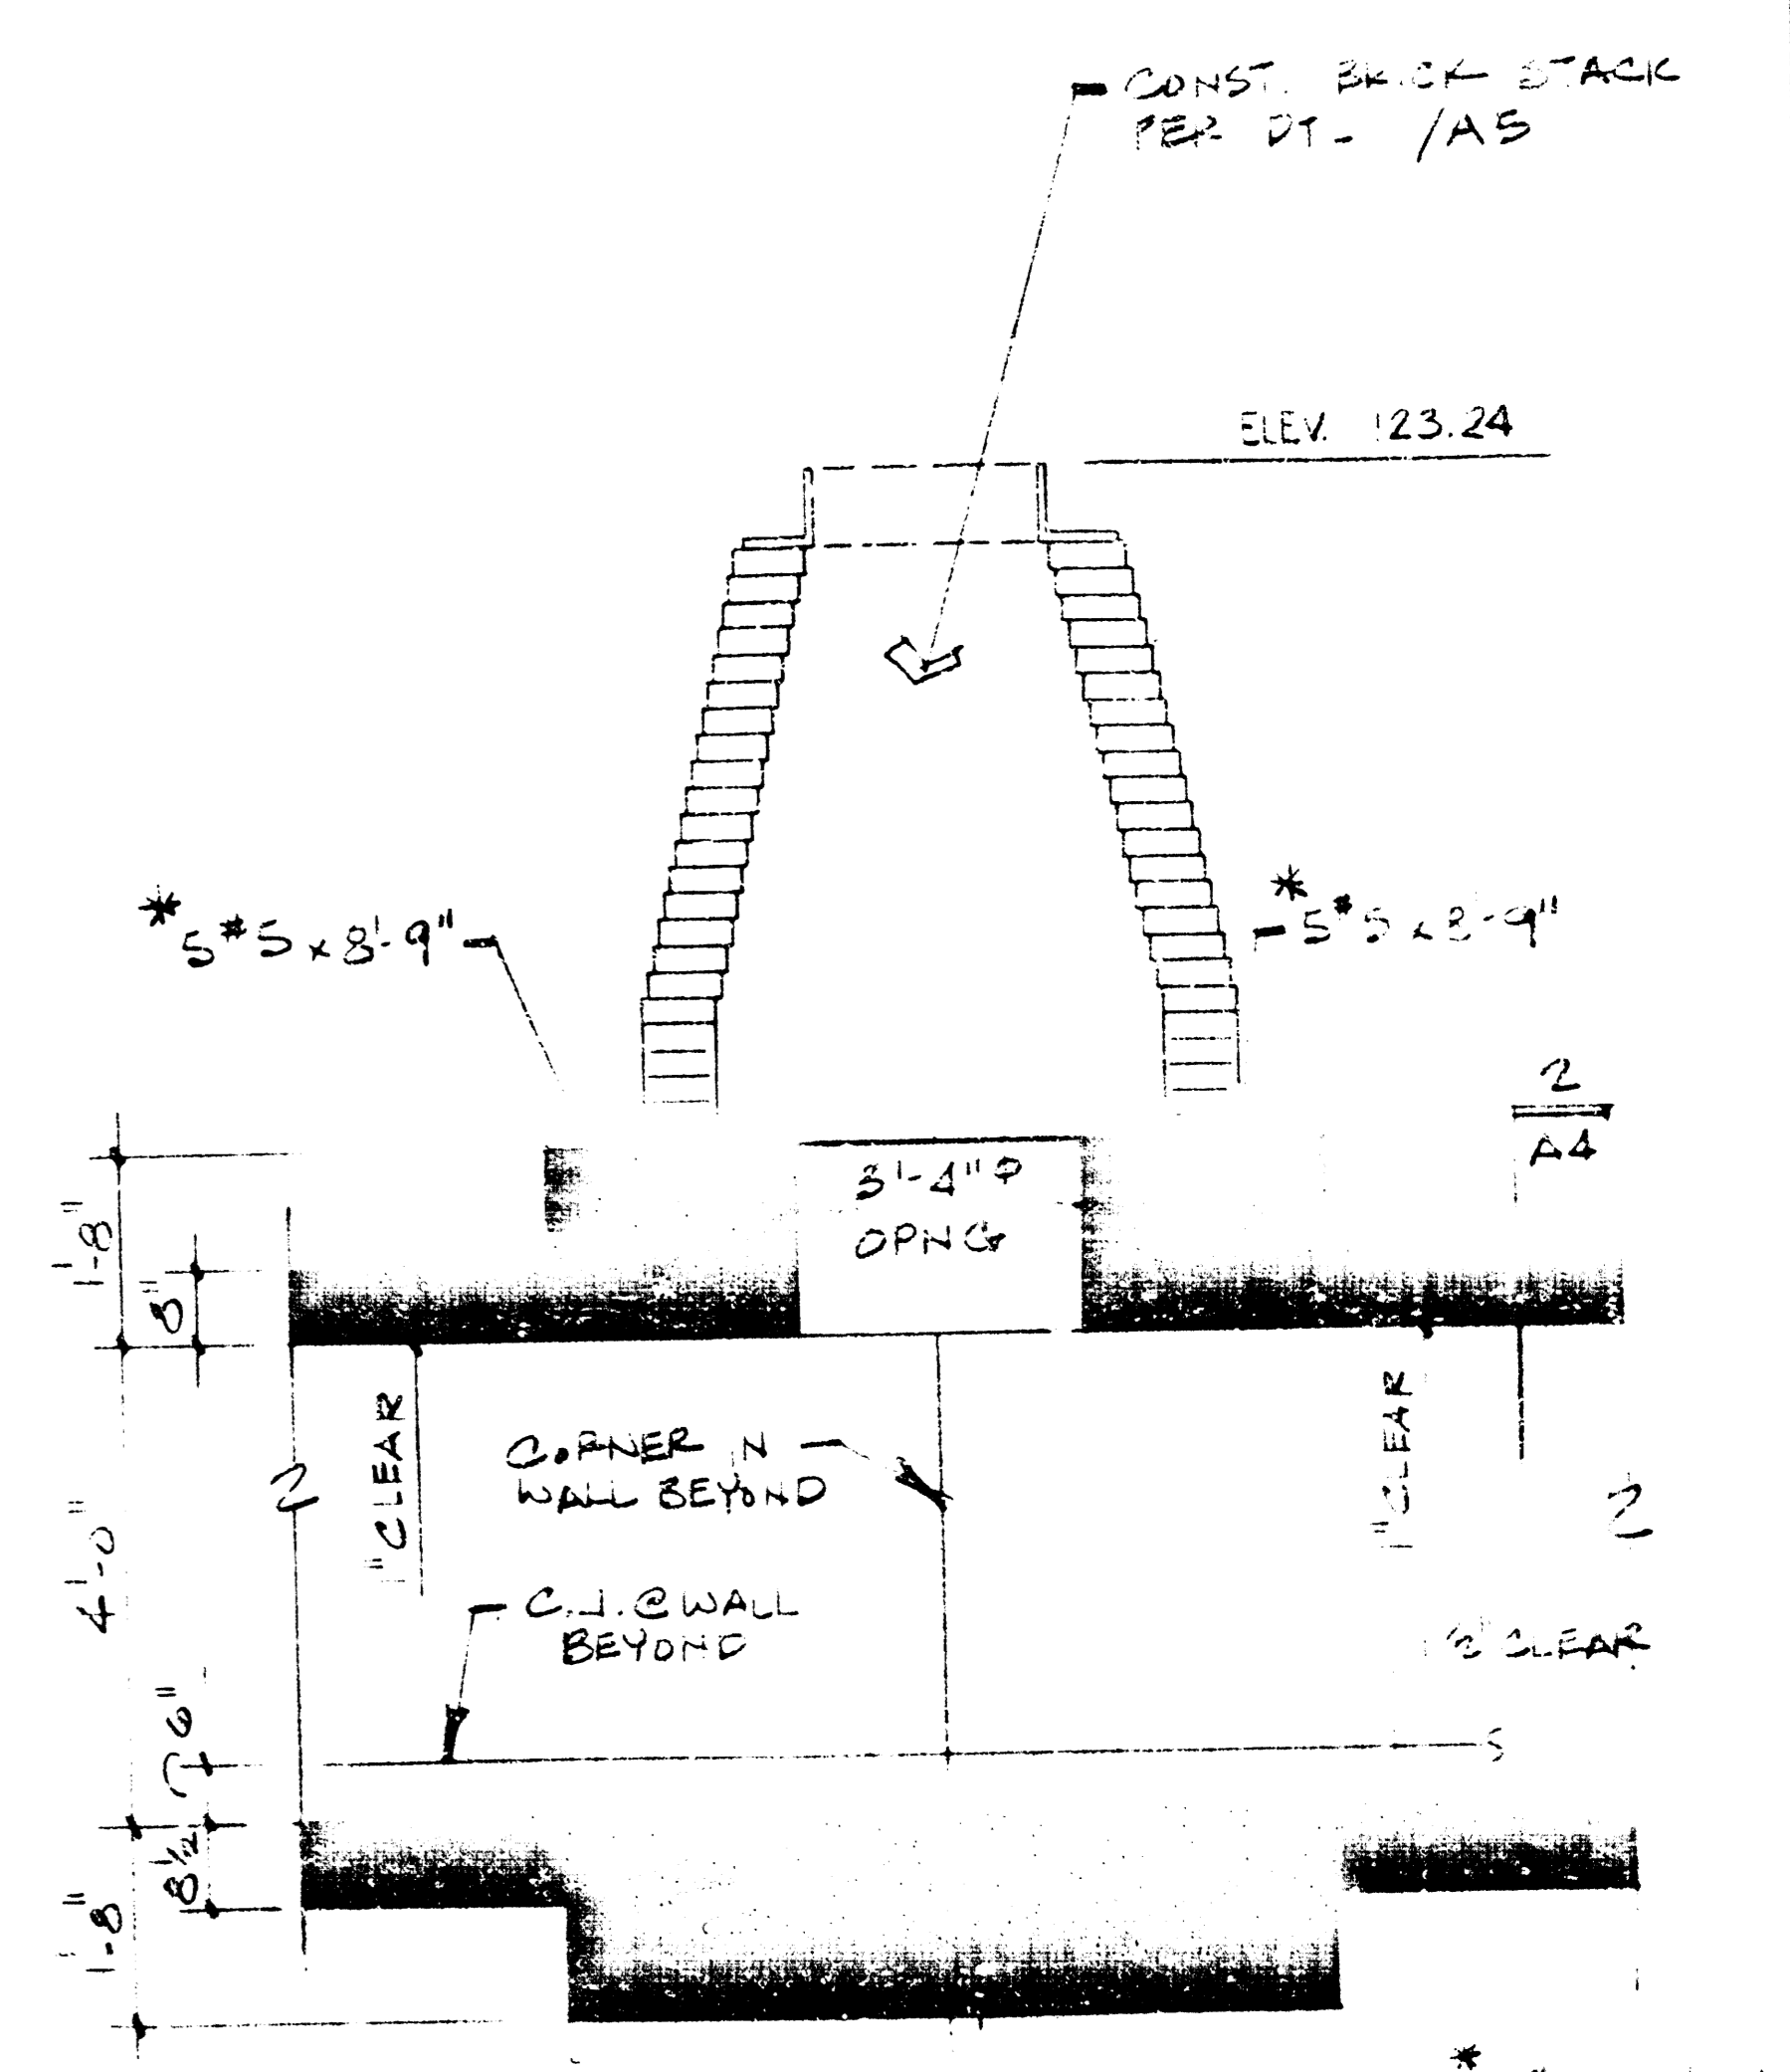

**C** SECT. SHOWING ADD'L REINF @ RCB BEND  
1/2" = 1'-0"

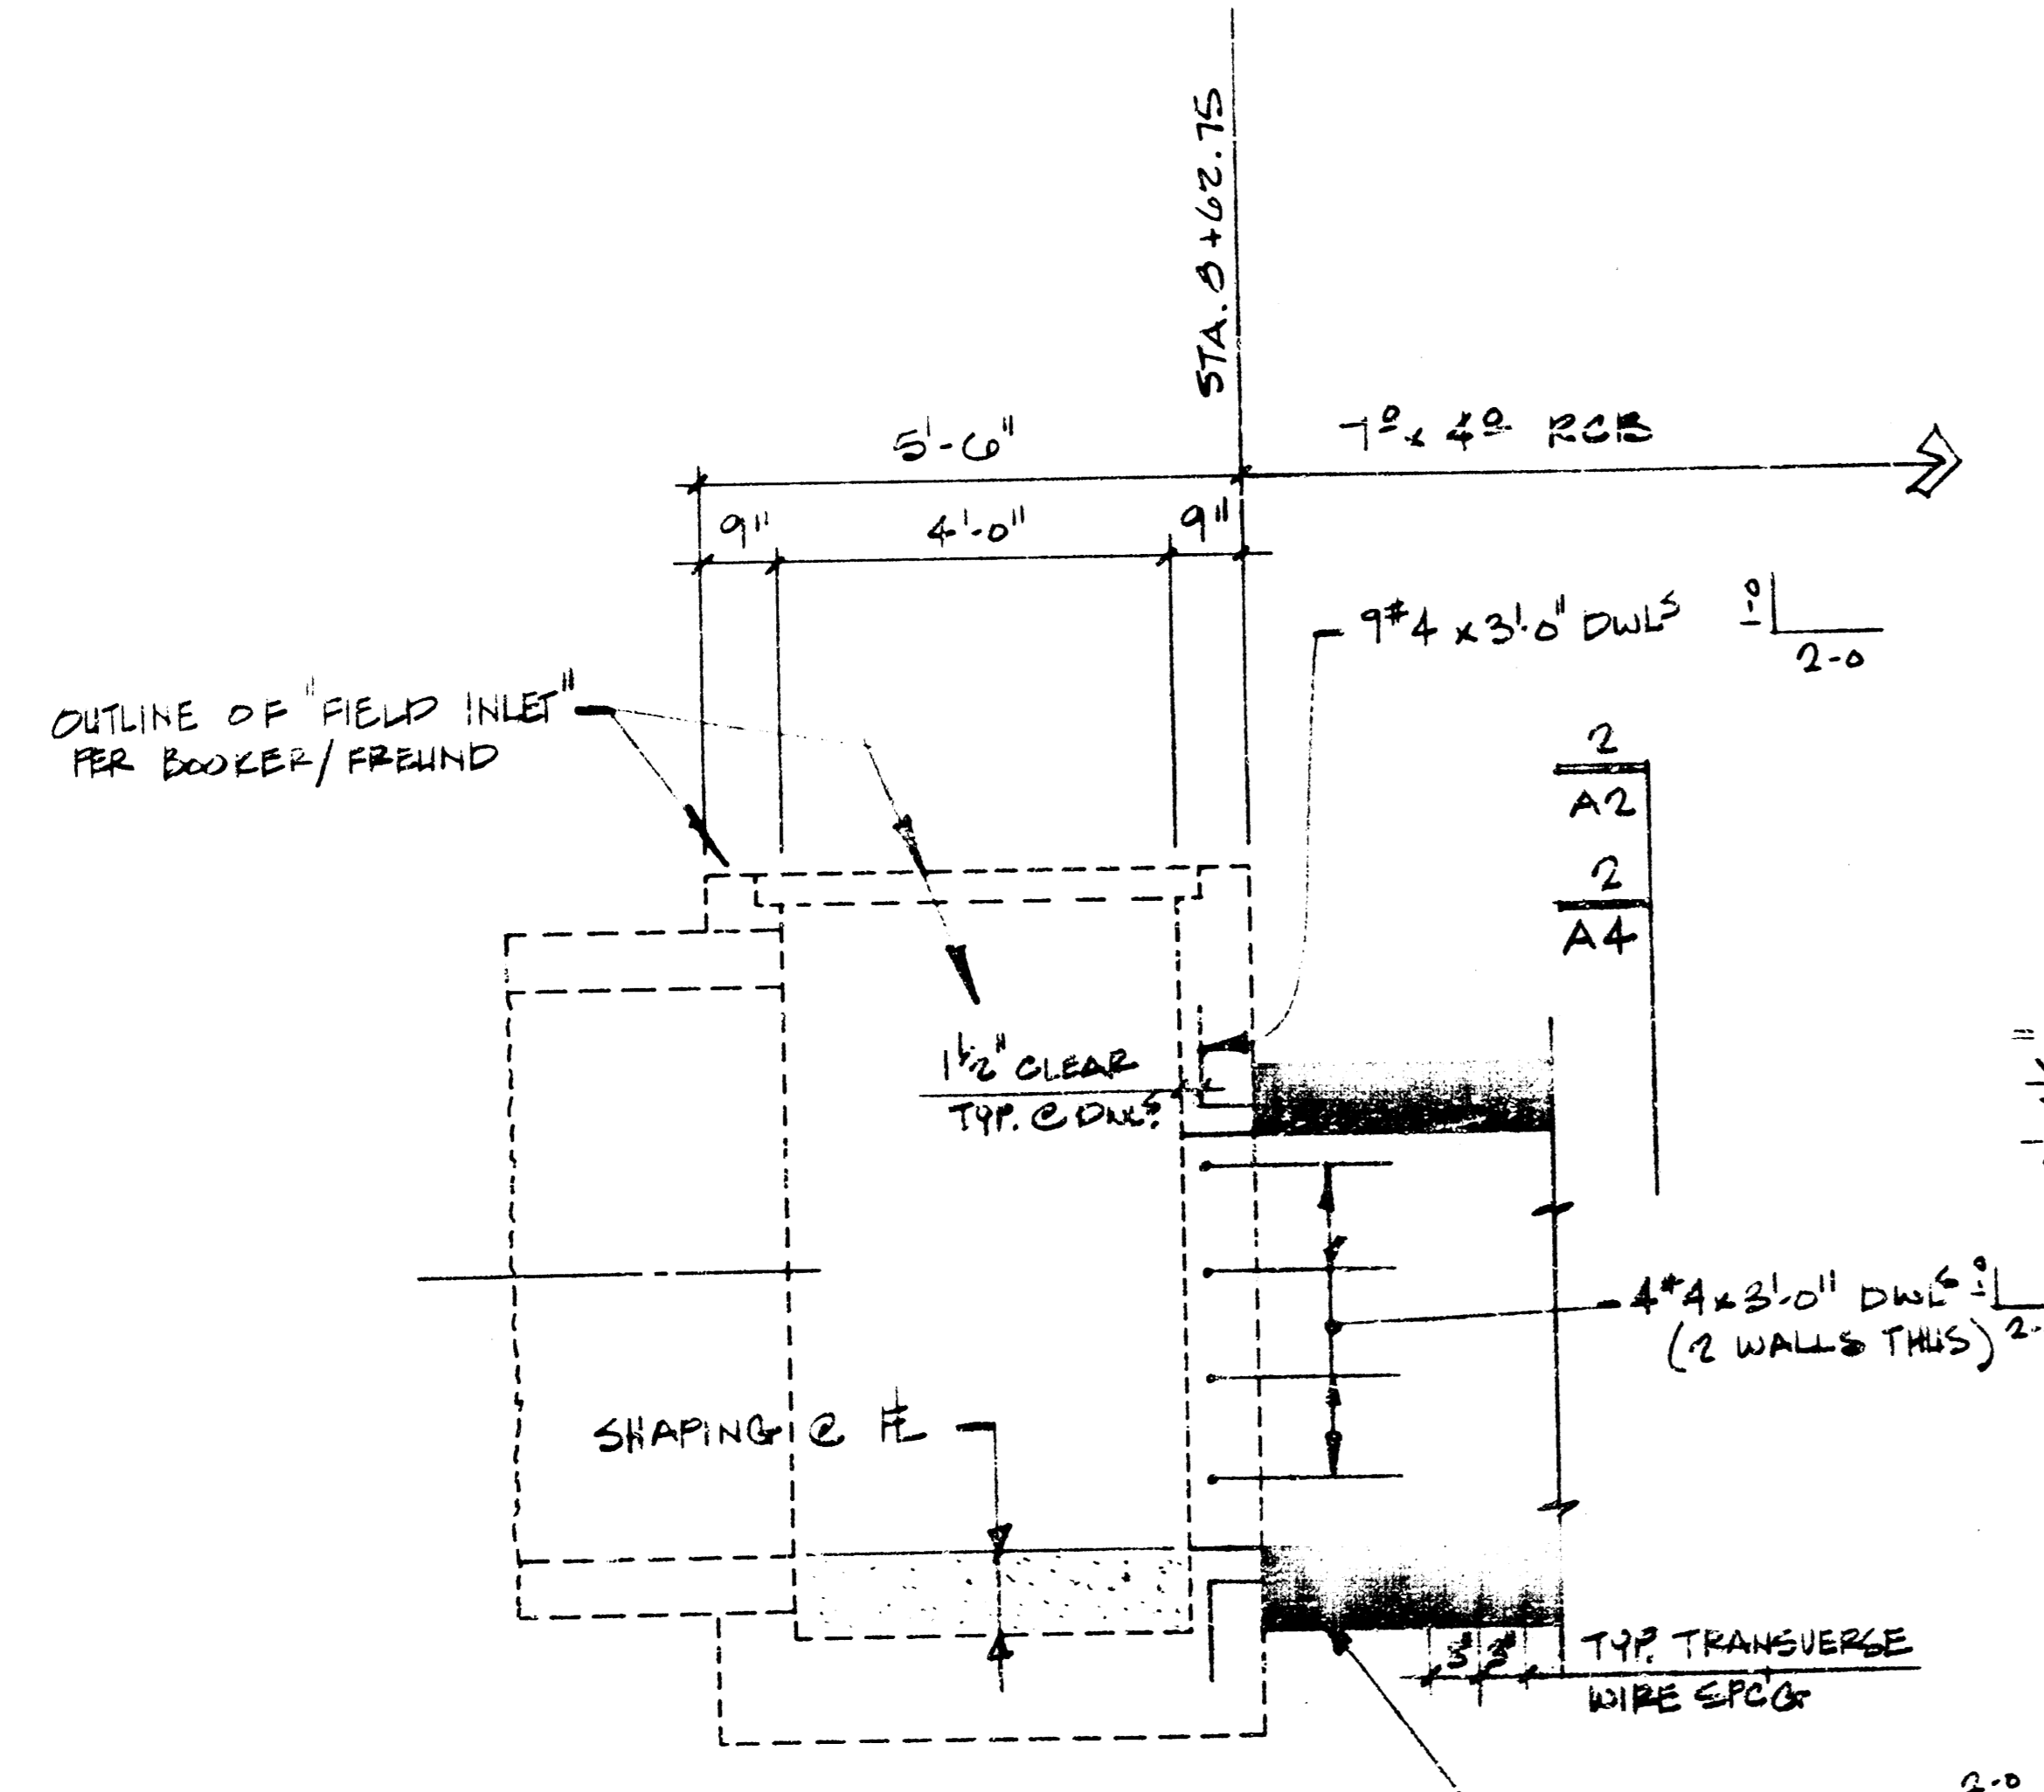

**1** CONN. DTL. OF RCB TO FIELD INLET BY OTHERS  
1/2" = 1'-0"

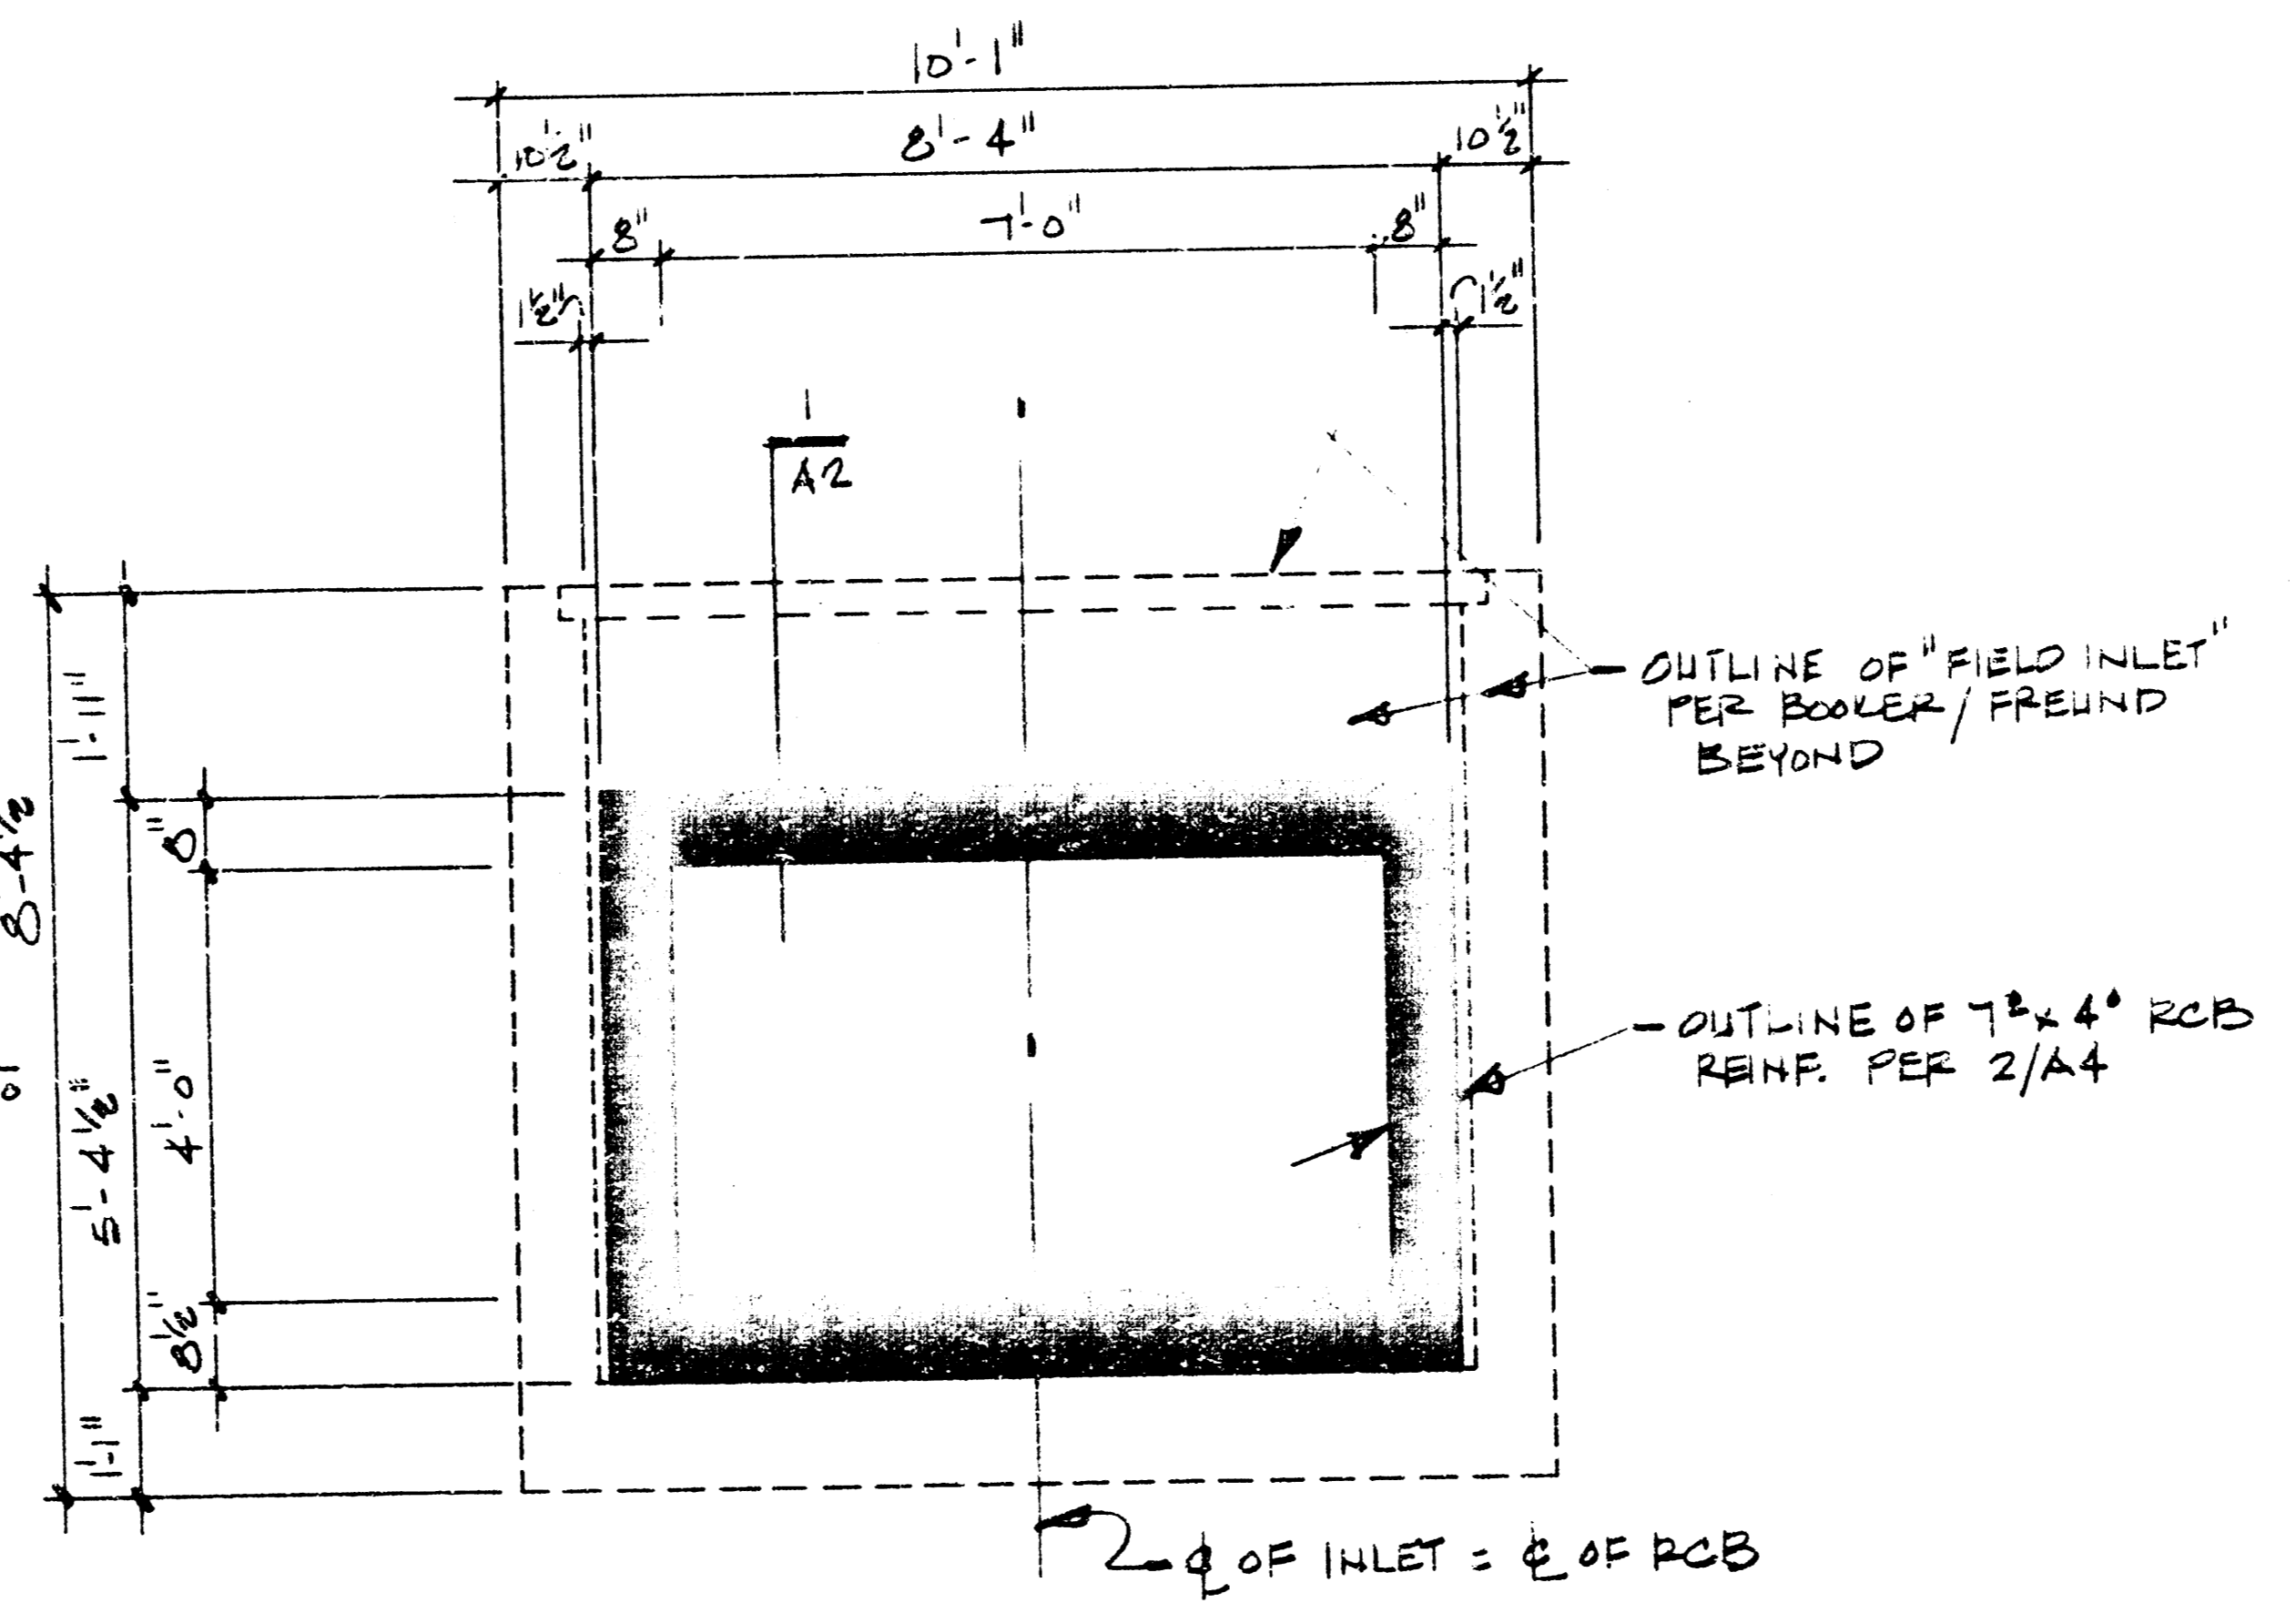

**2** NORTH-EAST ELEVATION OF RCB INTO "FIELD INLET"  
1/2" = 1'-0"

S.W.D. #64 West Maple St.		Design BB
RCB CONSTRUCTION DETAILS		Drawn by D.J.L.
STA 8+60 & STA 9+90		Checked by BB
PROJ. NO. 468-76-245-81373-000-000-001		Date
Van Doren Hazard Stallings FOR WILDCAT CONSTRUCTION		Job no. 85-203-50
Sheet <b>A 2</b>		of

FILMED FROM THE BEST AVAILABLE COPY....



**REBAR LEGEND**

F D	FOOTING DOWEL
C B	CORNER BAR
B	BOTTOM BAR
F	FOOTING BAR
H	HORIZONTAL
V	VERTICAL BAR
R	REINFORCING
T	TOP BAR
O F	OUTSIDE FACE
I F	INSIDE FACE
E F	EACH FACE
N F	NEAR FACE
F F	FAIR FACE
E W	EACH WAY
U N D	UNLESS NOTED OTHERWISE

**GENERAL NOTES**


- Concrete shall be City of Wichita standard paving mix, proportioned and mixed per Pages 21 and 22 of City of Wichita's "Concrete Paving" specification.
- All rebar reinforcing to meet ASTM A615-60,000. Welded Wire fabric shall meet: 1. ASTM A185 smooth (fy=65KSI) 2. ASTM A497 deformed (fy=70KSI)
- Welded wire fabric reinforcing shall be supplied in 16'-0" long x 8'-0" wide flat sheets.  
DESIGNATION KEY: WWF (long spacing)x(transverse spacing)-(long wire)x(transverse wire)  
APPROX. WEIGHTS: WWF 12 x 3 - W20 x D20  $\frac{\#}{100 \text{ sq. ft.}}$  353  $\frac{\#}{\text{sheet}}$  452  
WWF 12 x 12 - W20 x W20 145 195
- Welded wire fabric splices shall be made with a minimum of 12" lap.
- Concrete protection for reinforcing 1-1/2" unless noted otherwise.
- All concrete exposed edges shall be finished with an edging tool.
- All reinforcing steel shall be detailed and placed in accordance with ACI Detailing Manual SP-66, 1980 edition and ACI 315 Manual of Standard Practice for detailing reinforced concrete structures.
- Provide #308 of ASTM A615, grade 40 extra bars to be used as directed. Include labor for placing same.  
SUPPLY: 6 - #4 x 30'-0"  
6 - #5 x 30'-0"

**LOADS:**


01	AASHTO	HS-20-44
----	--------	----------

**SOILS:**


01	Total Load (max.)	1800 psf
02	Lateral on box walls	50 psf

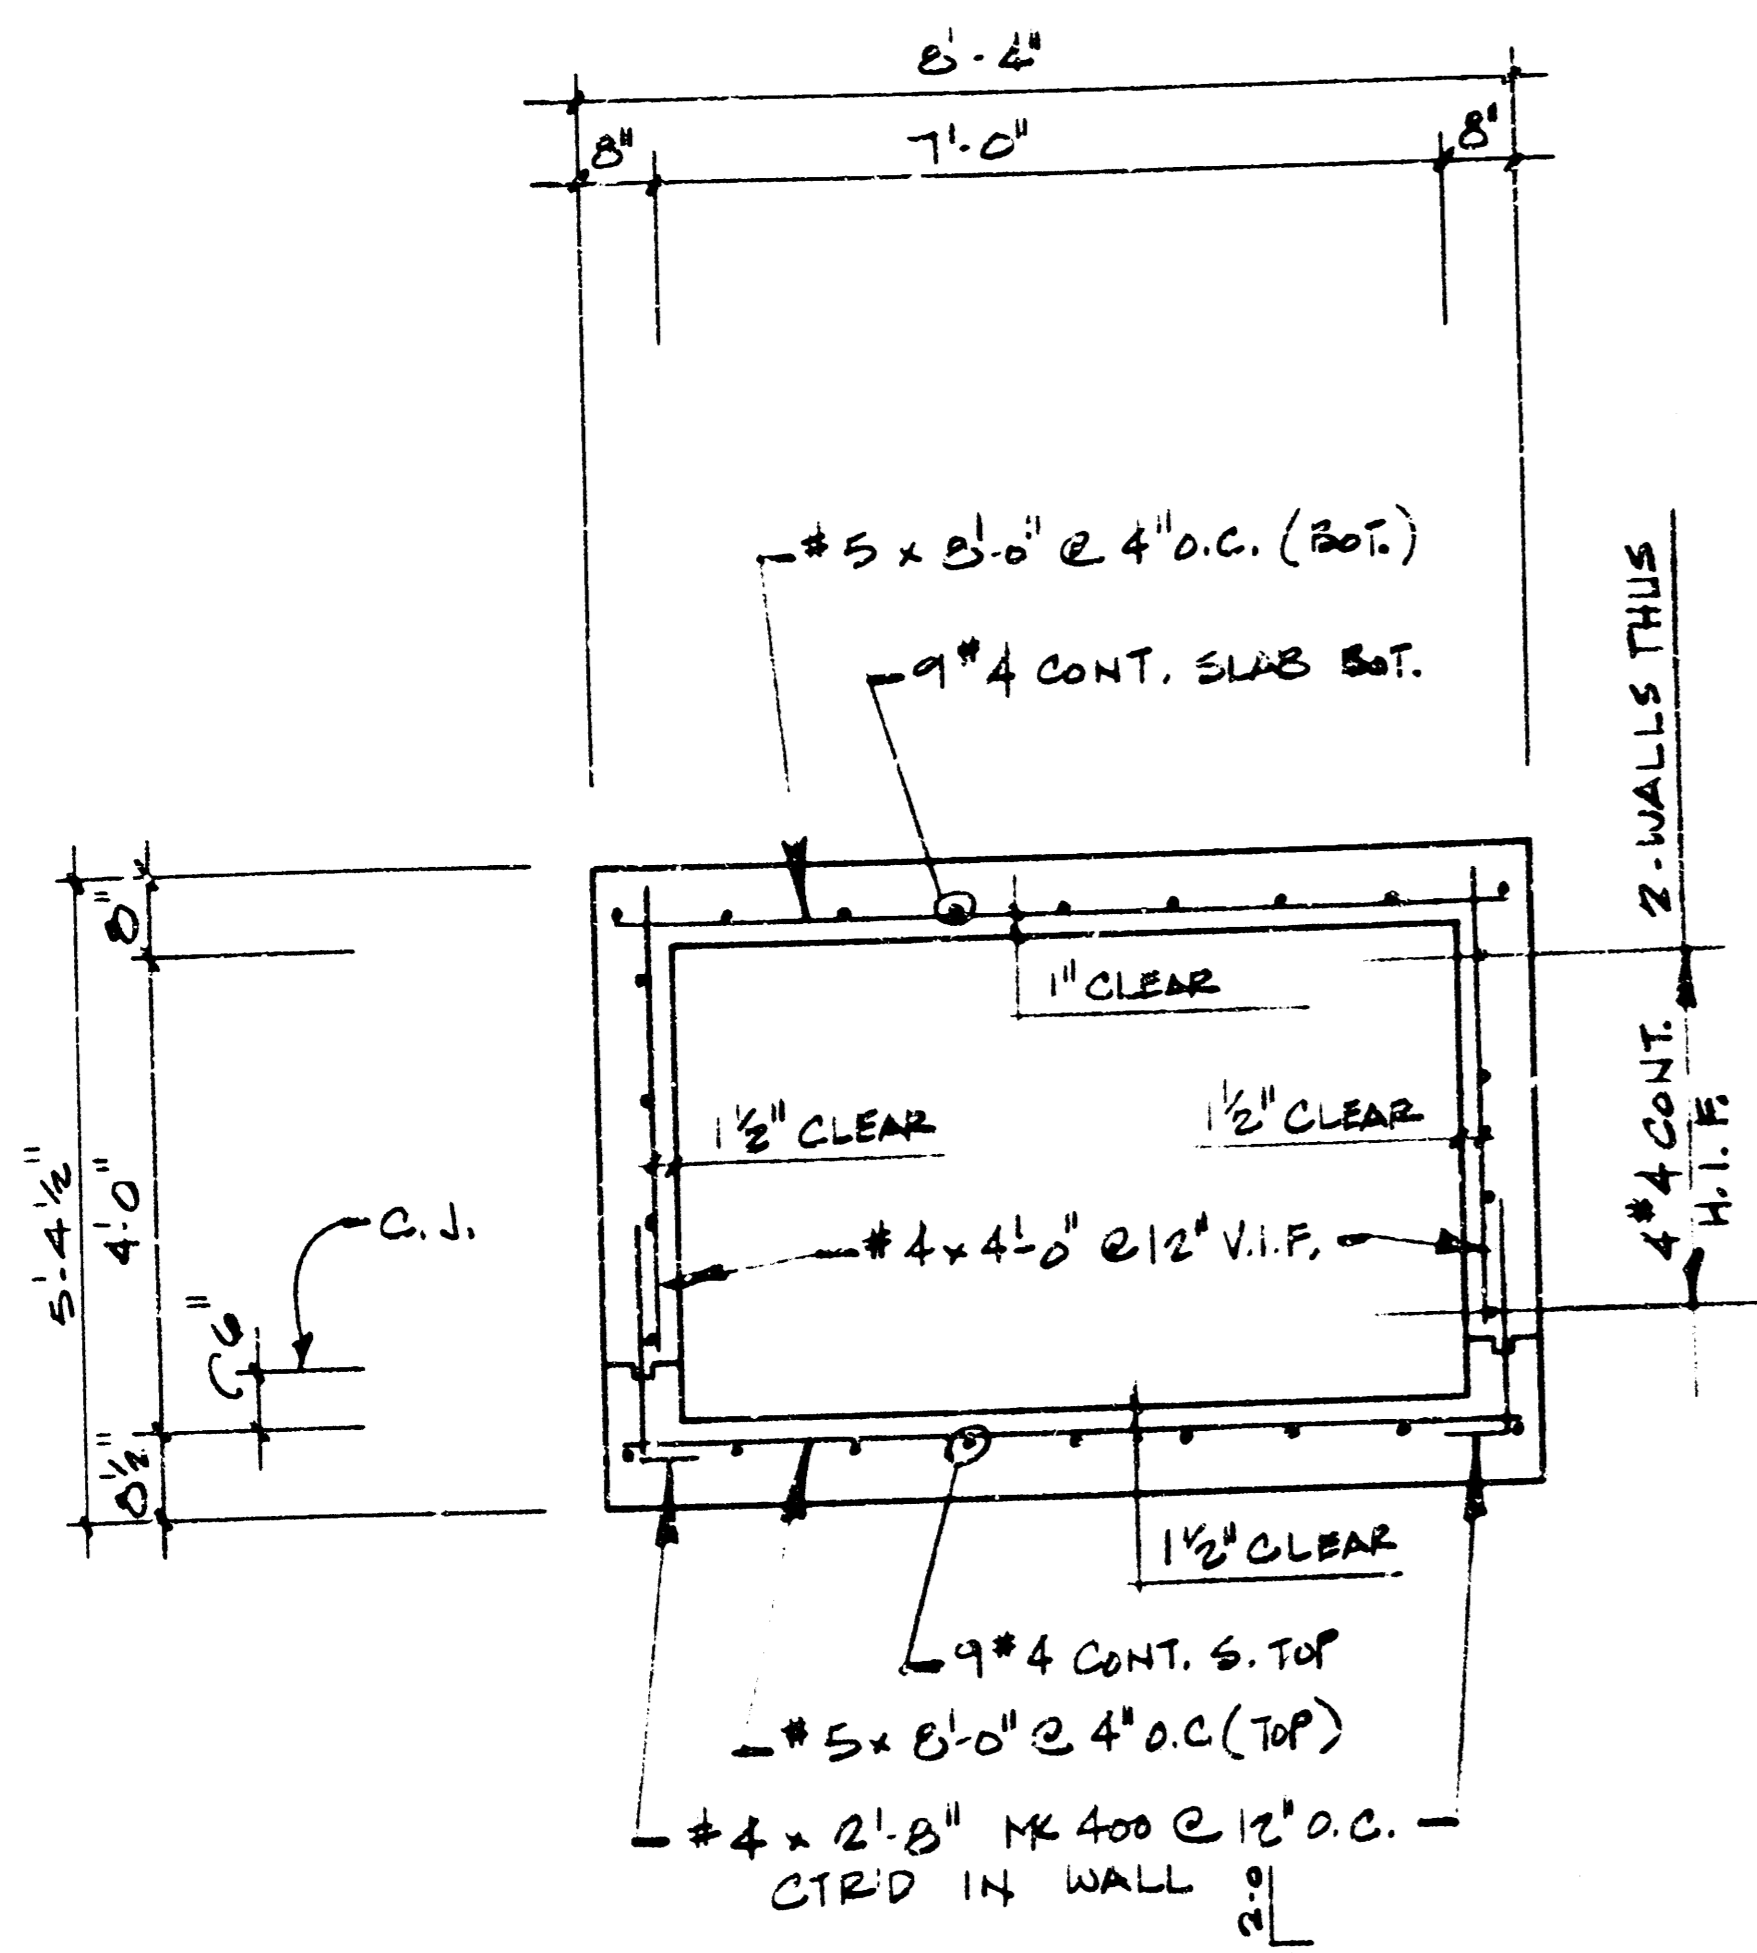


1 TYP. SECT. 7' x 4' SIMPLE RCB w/ REBAR REINF.  $\frac{1}{2}'' = 1'-0''$

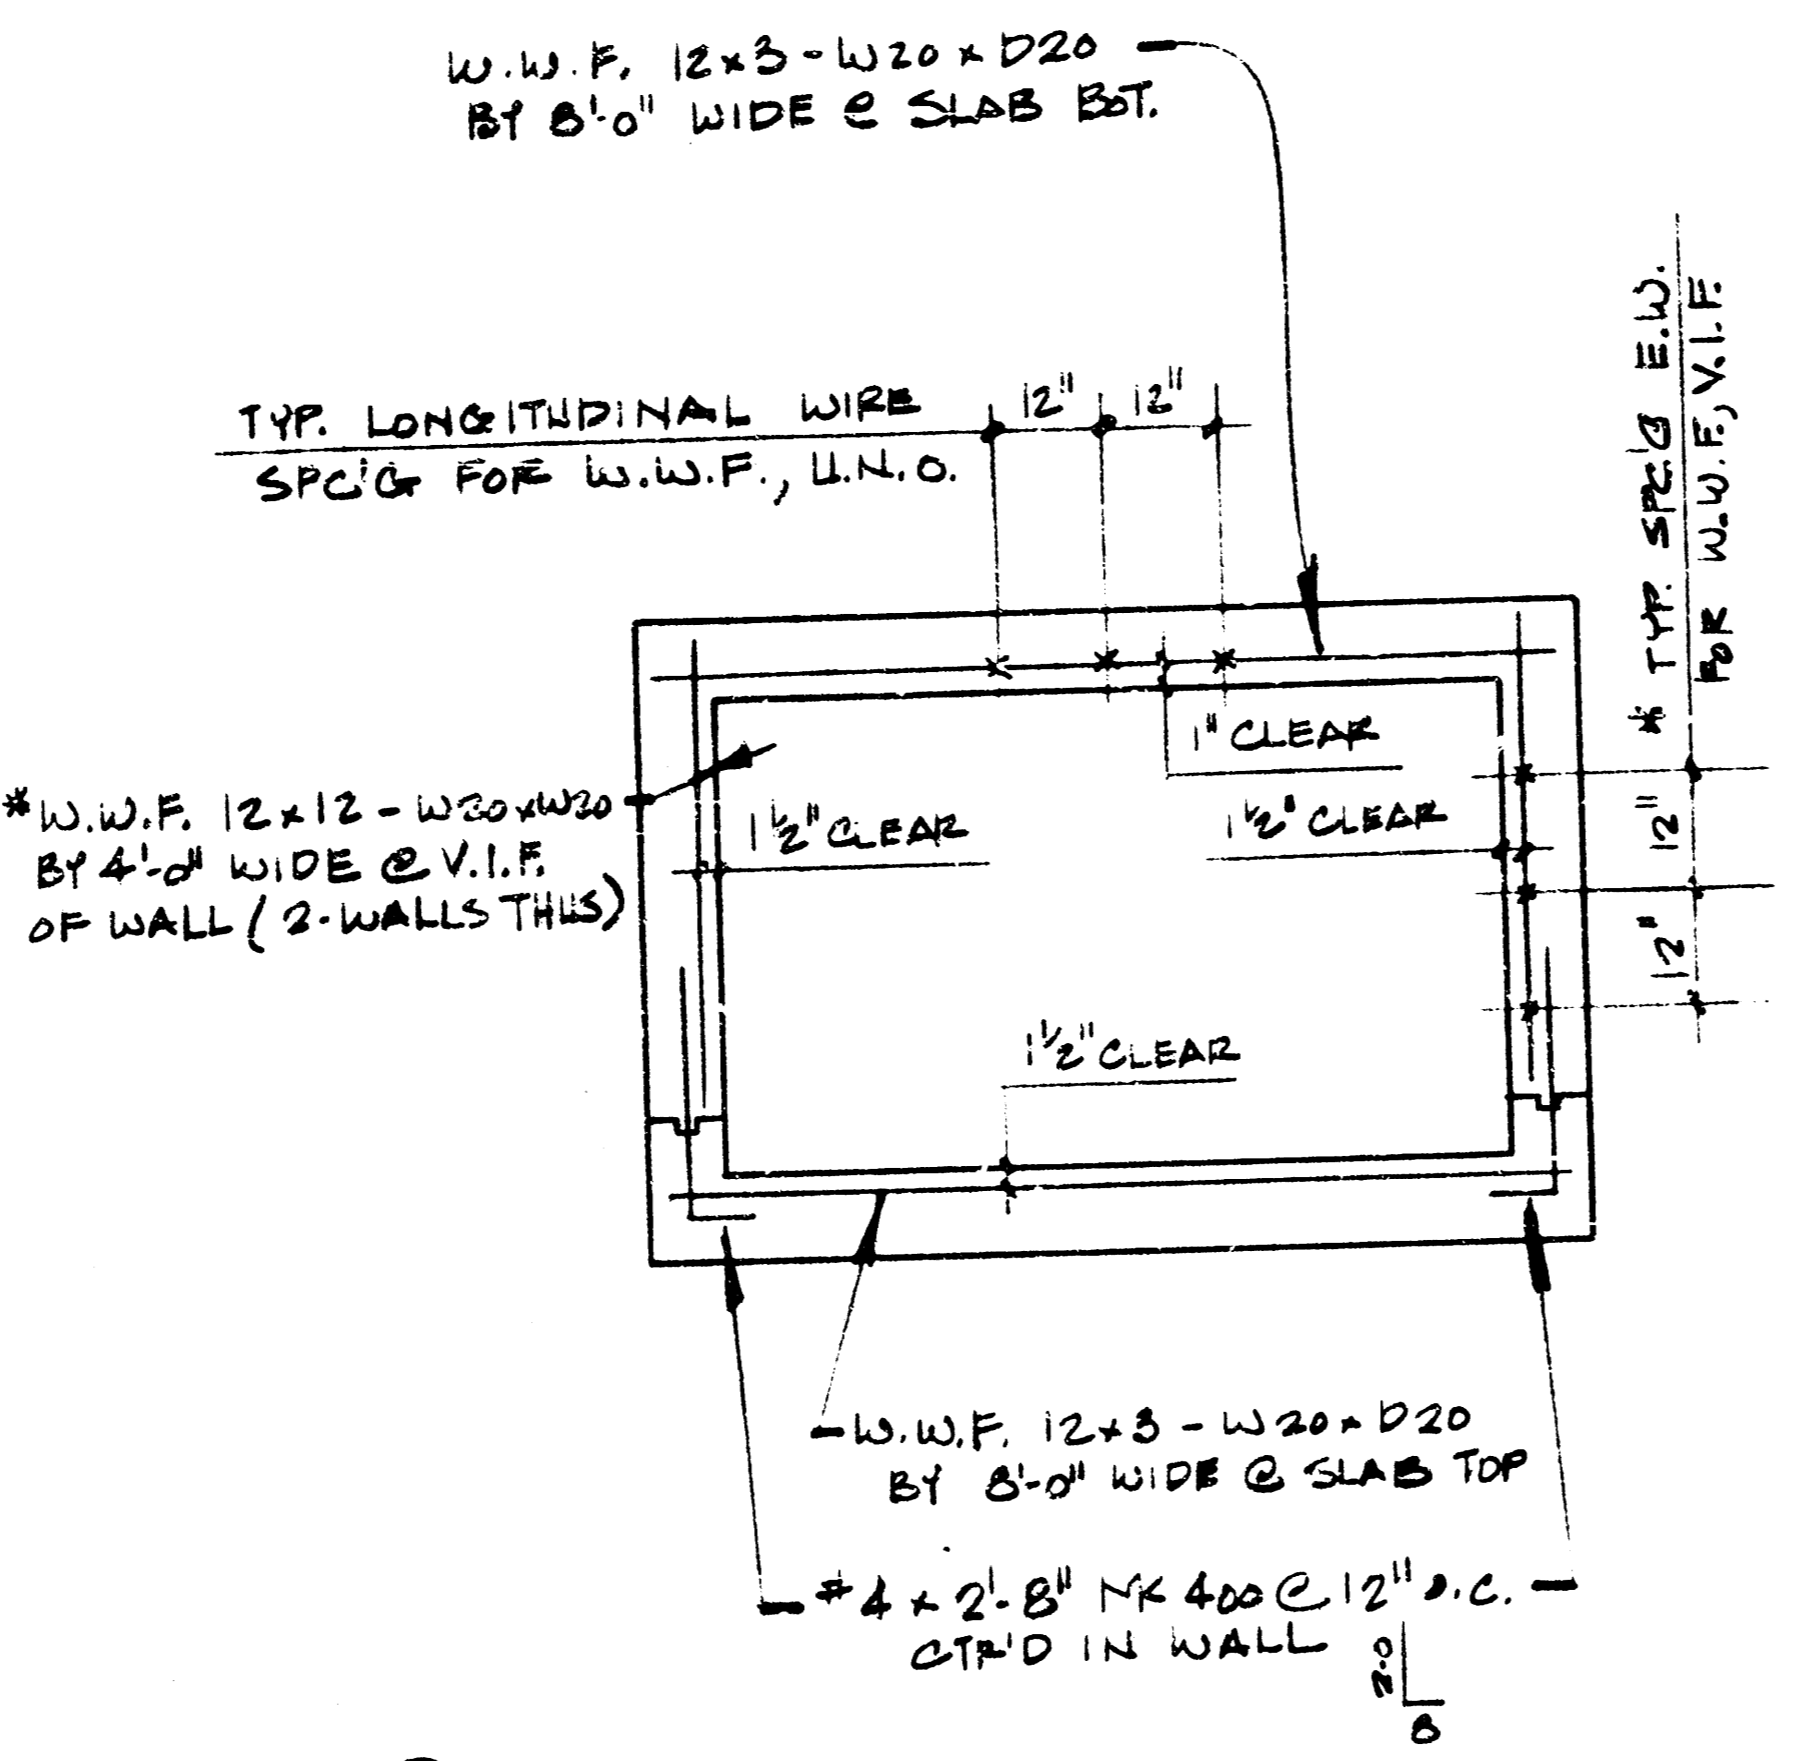

2 TYP. SECT. 7' x 4' SIMPLE RCB w/ WIRE FABRIC REINF. (DIM'S PER SECT. 1, U.N.O.)  $\frac{1}{2}'' = 1'-0''$

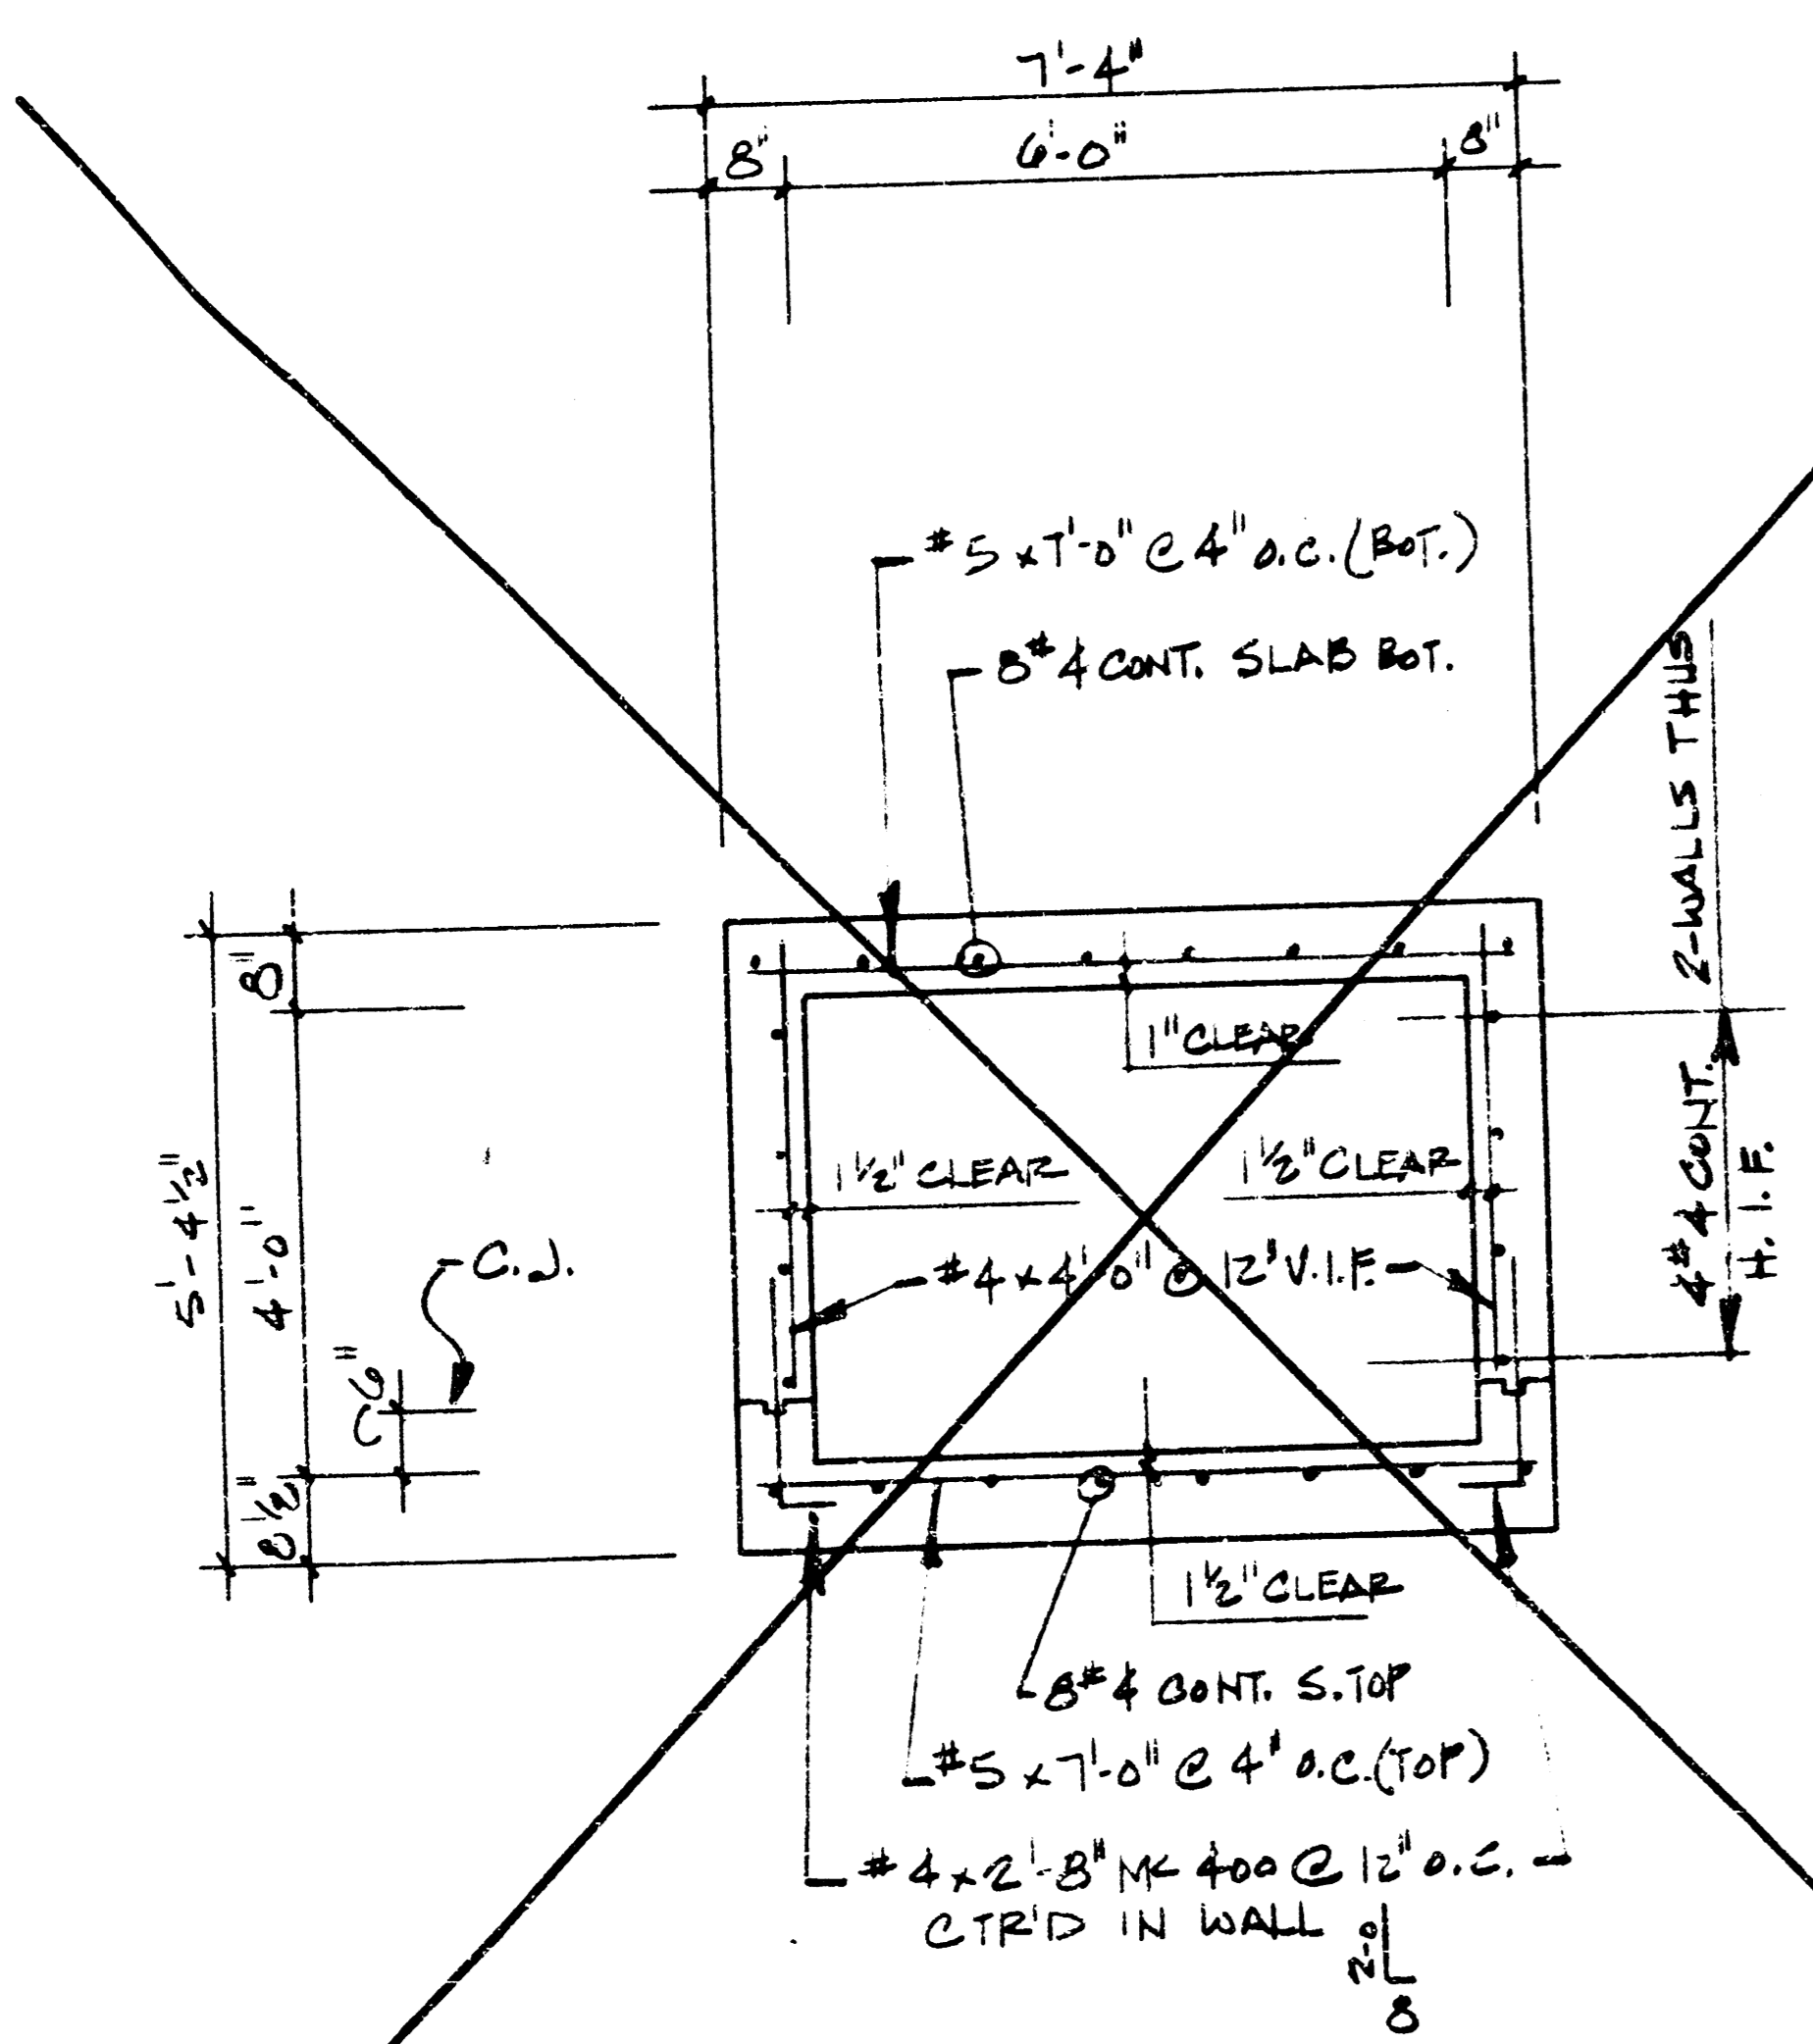


3 TYP. SECT. 6' x 4' SIMPLE RCB w/ REBAR REINF.  $\frac{1}{2}'' = 1'-0''$

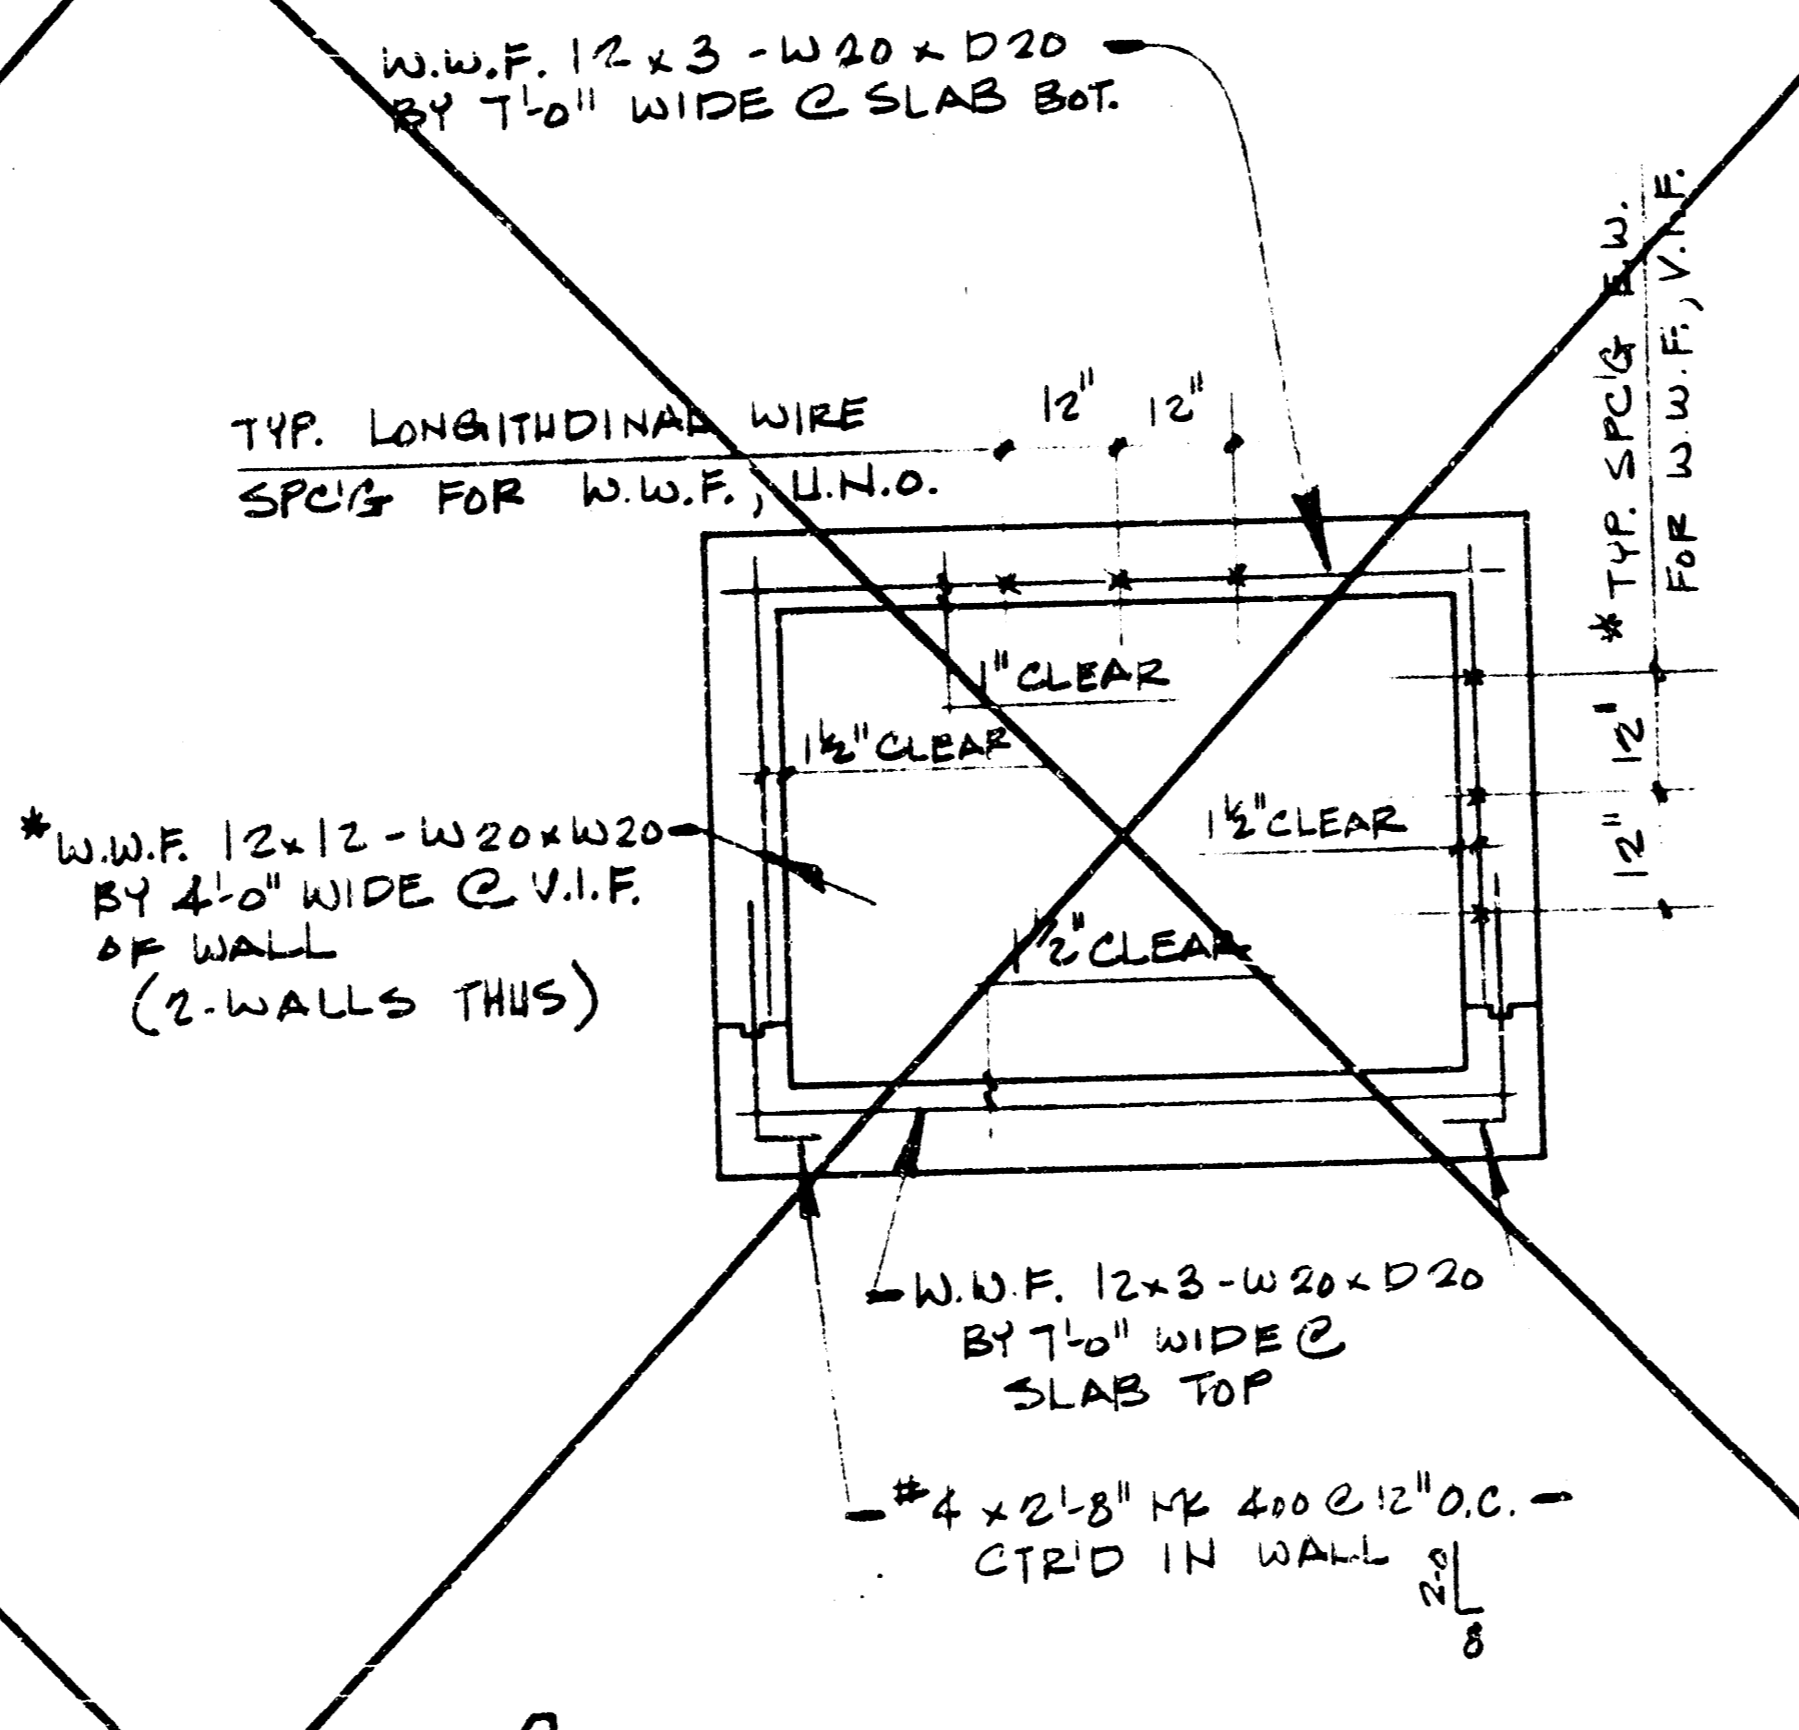

4 TYP. SECT. 6' x 4' SIMPLE RCB w/ WIRE FABRIC REINF. (DIM'S PER SECT. 3 U.N.O.)  $\frac{1}{2}'' = 1'-0''$

BRICK STACK CONSTRUCTION AS NOTED ON PLAN SHT. A1 & DTLS OF SHT. A5

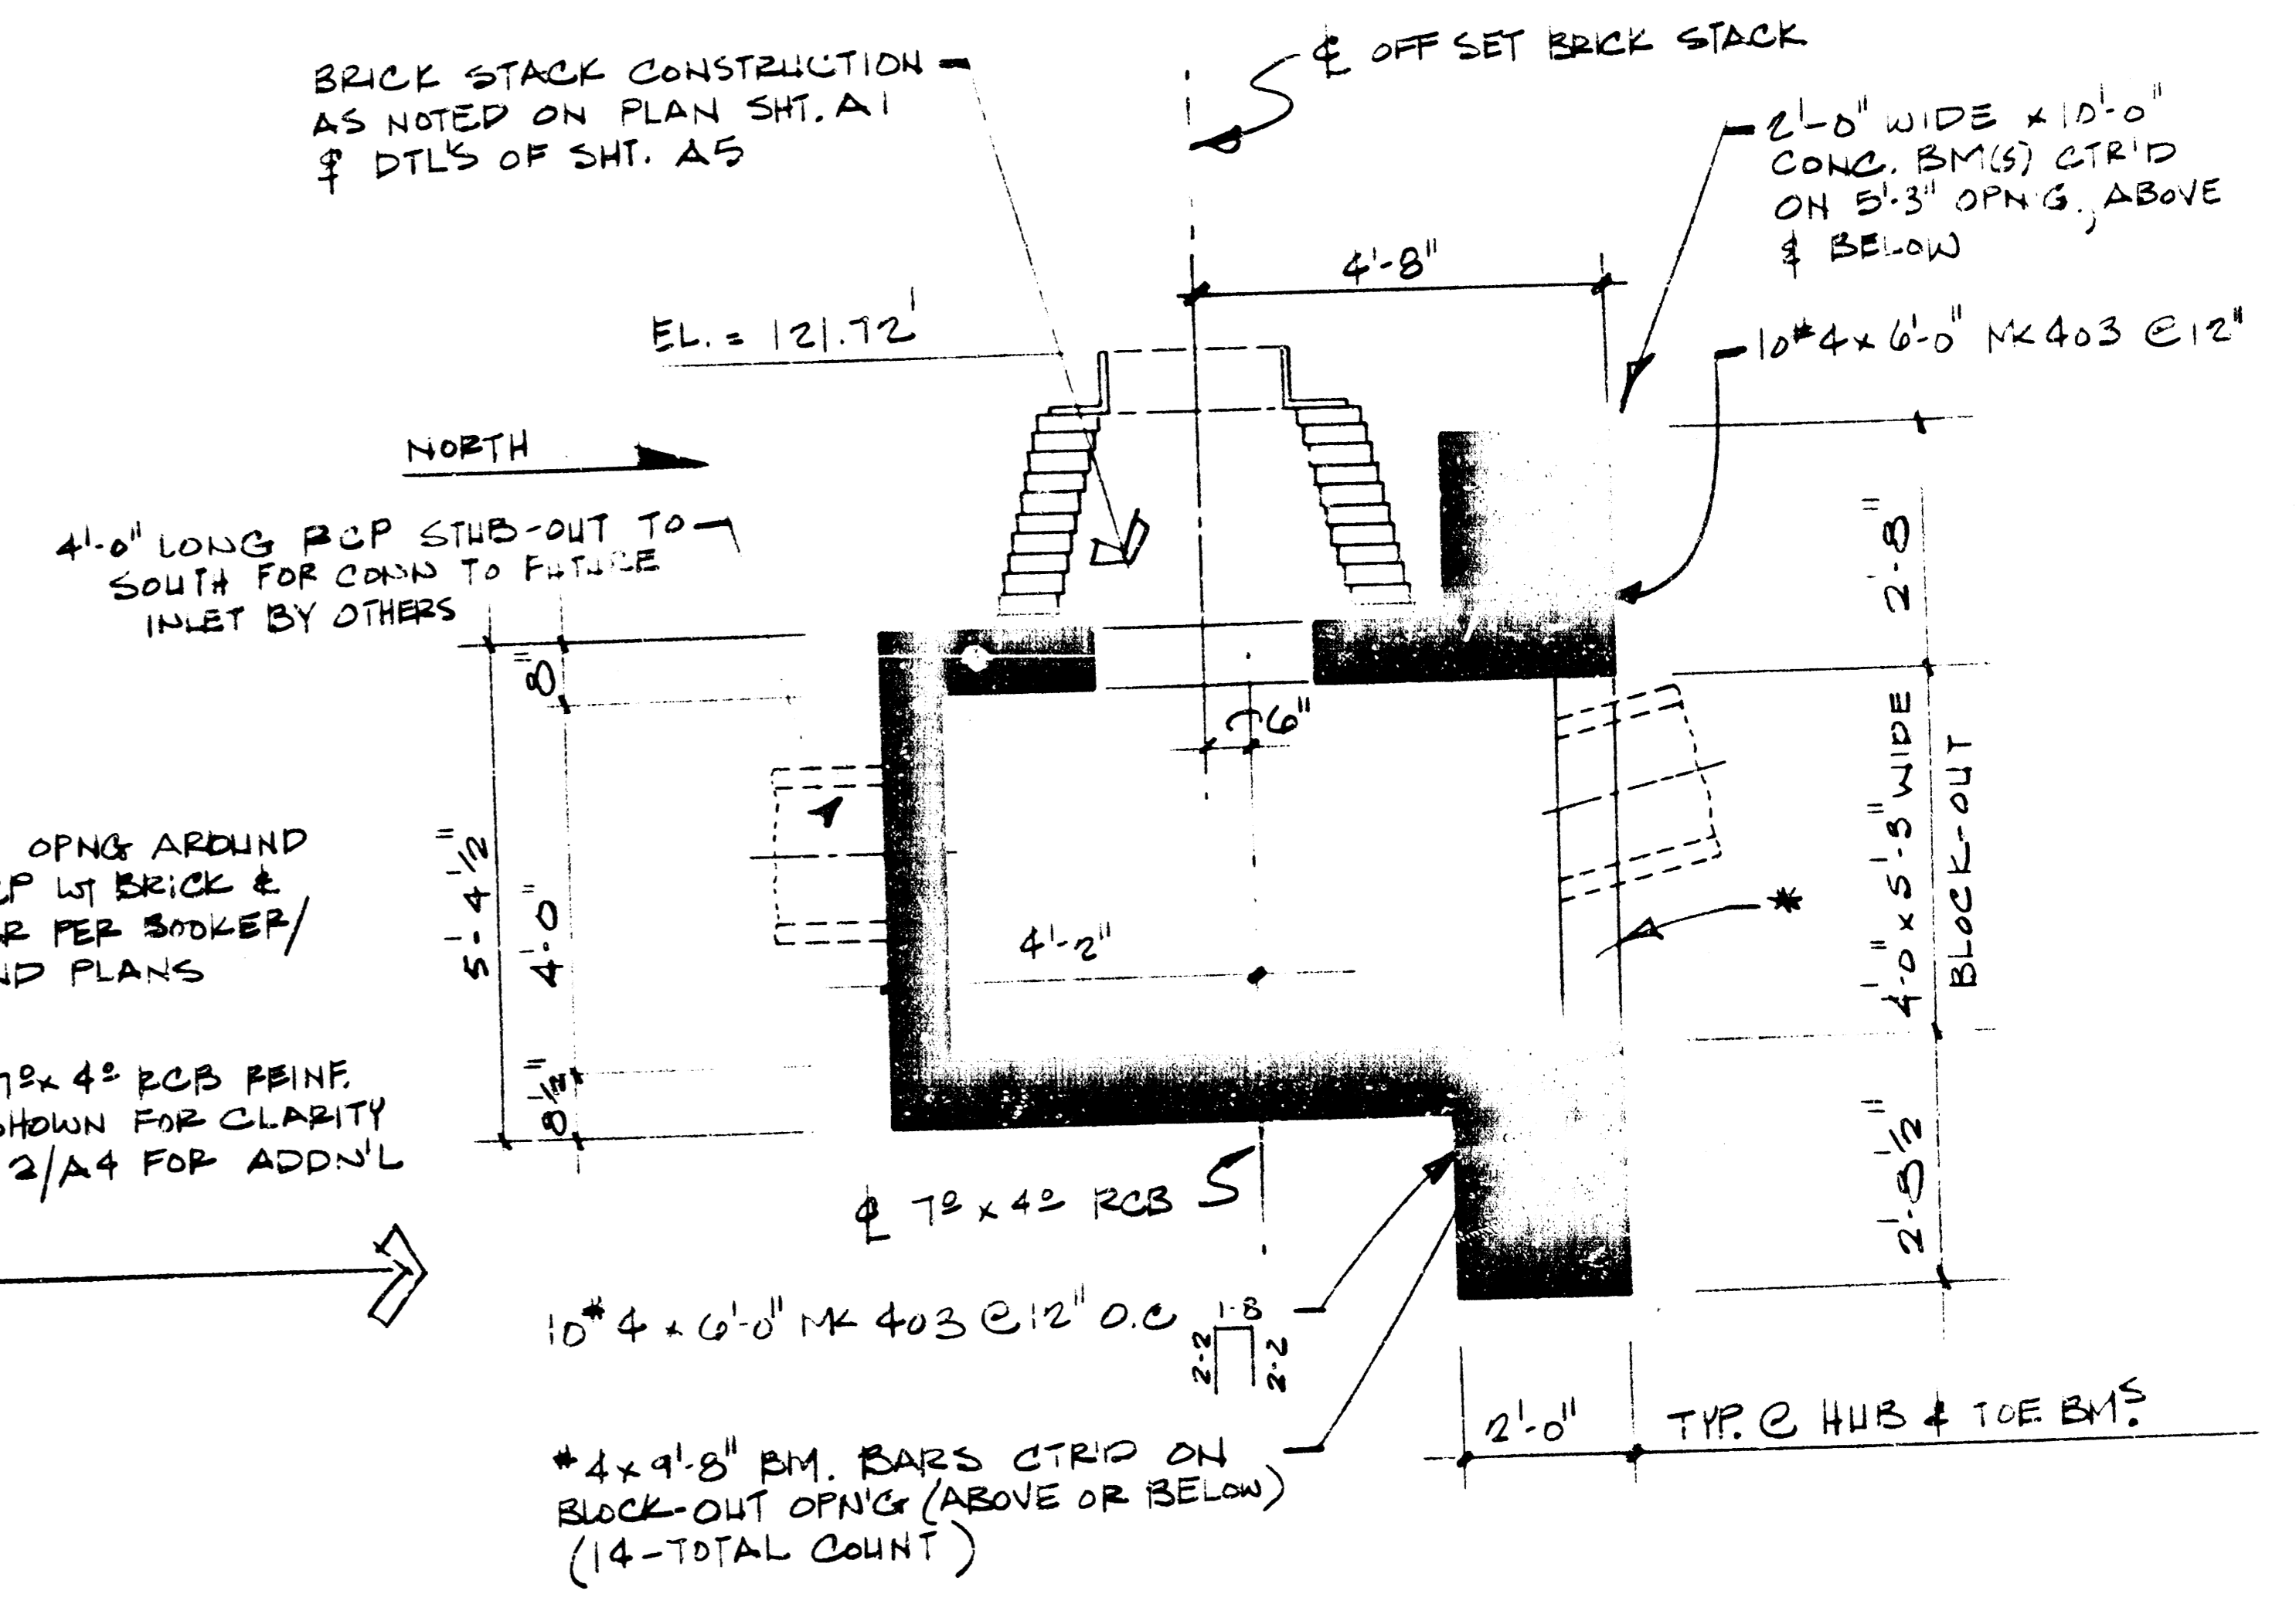

5 SECT. THRU BLOCK-OUT @ STA. 22+00  $\frac{1}{2}'' = 1'-0''$

\*NOTE: SEAL OPENING AROUND 18" RCP W/ BRICK & MORTAR PER BOOKER/FREUND PLANS



\*NOTE: TYP. 7' x 4' RCB REINF. NOT SHOWN FOR CLARITY REF. 2/A4 FOR ADD'L INFO.

S.W.D. #64 West Maple St.  
Simple RCB Alternate  
FROM STA 8+60 TO 28+15  
PROJ. NO. 468-76-245-81373-000-000-001


Van Doren Hazard Stallings  
FOR  
WILDCAT CONSTRUCTION

Design	BB
Drawn by	BB
Checked by	BB
Date	1-28-85
Job no	85-203-50
Sheet	A 4


FILMED FROM THE BEST AVAILABLE COPY....

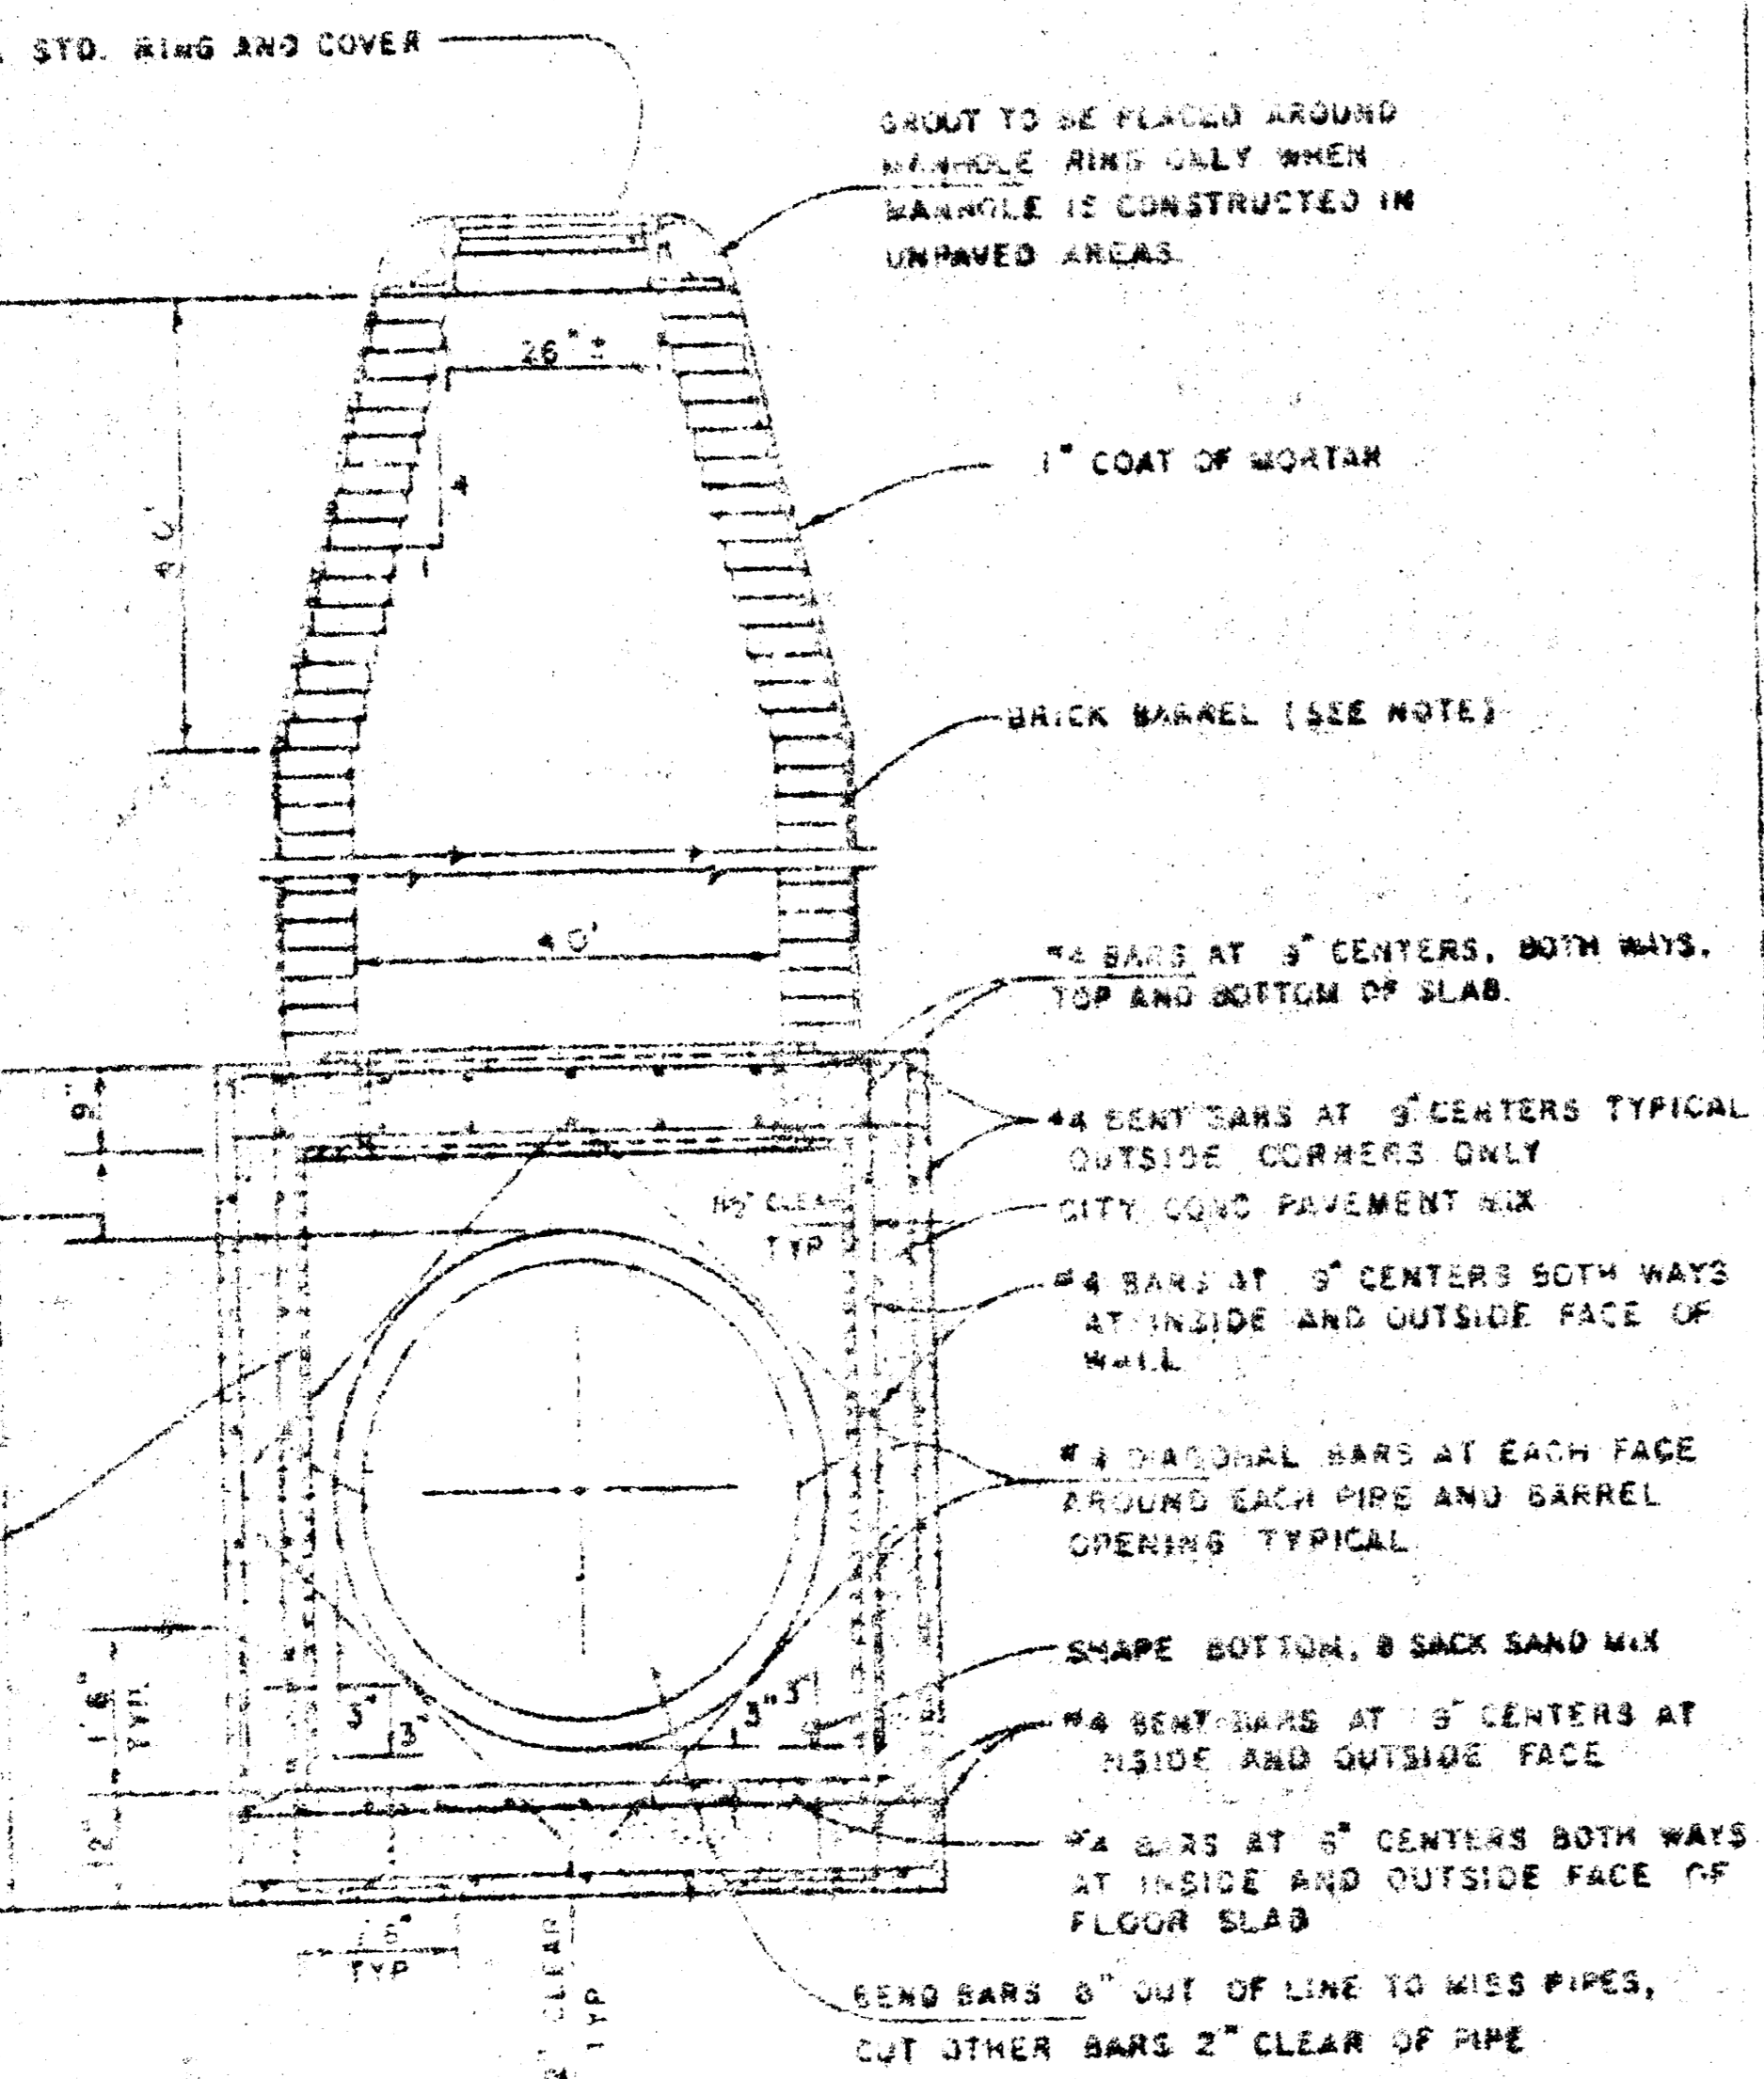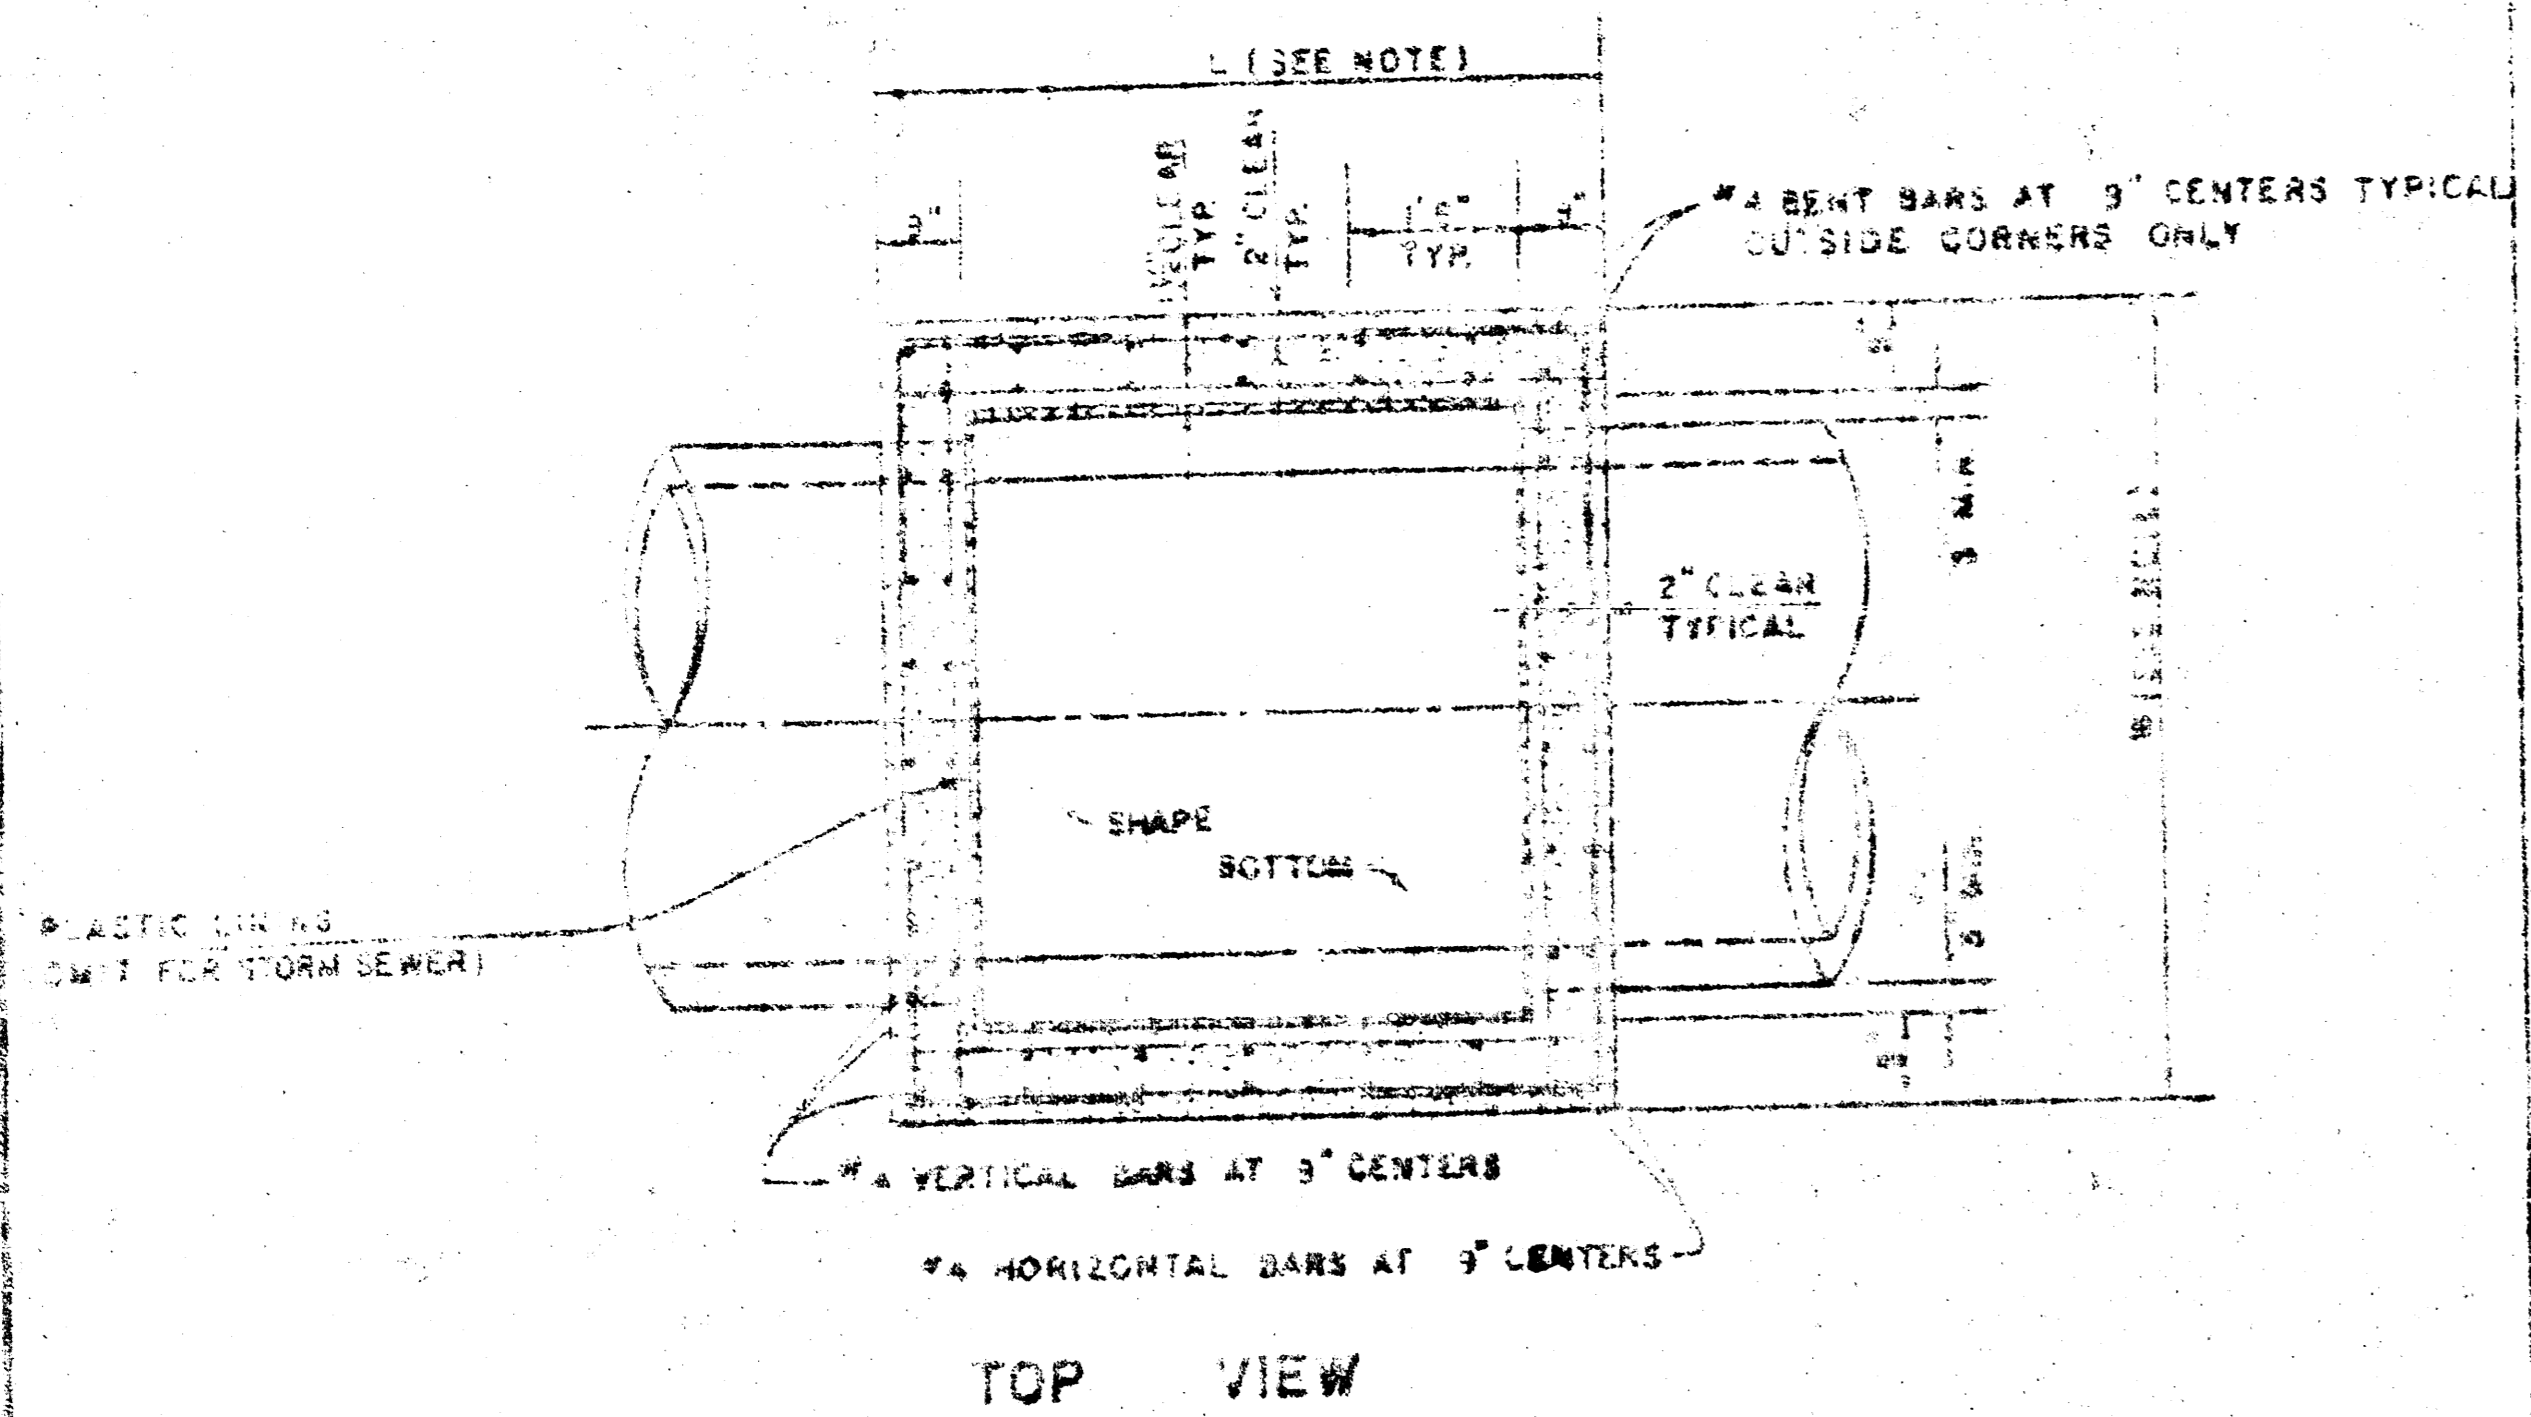


**1** REINFORCED CONCRETE MANHOLE  
DEPTH OF STACK: OVER 4.0'  
SCALE 1" = 2'

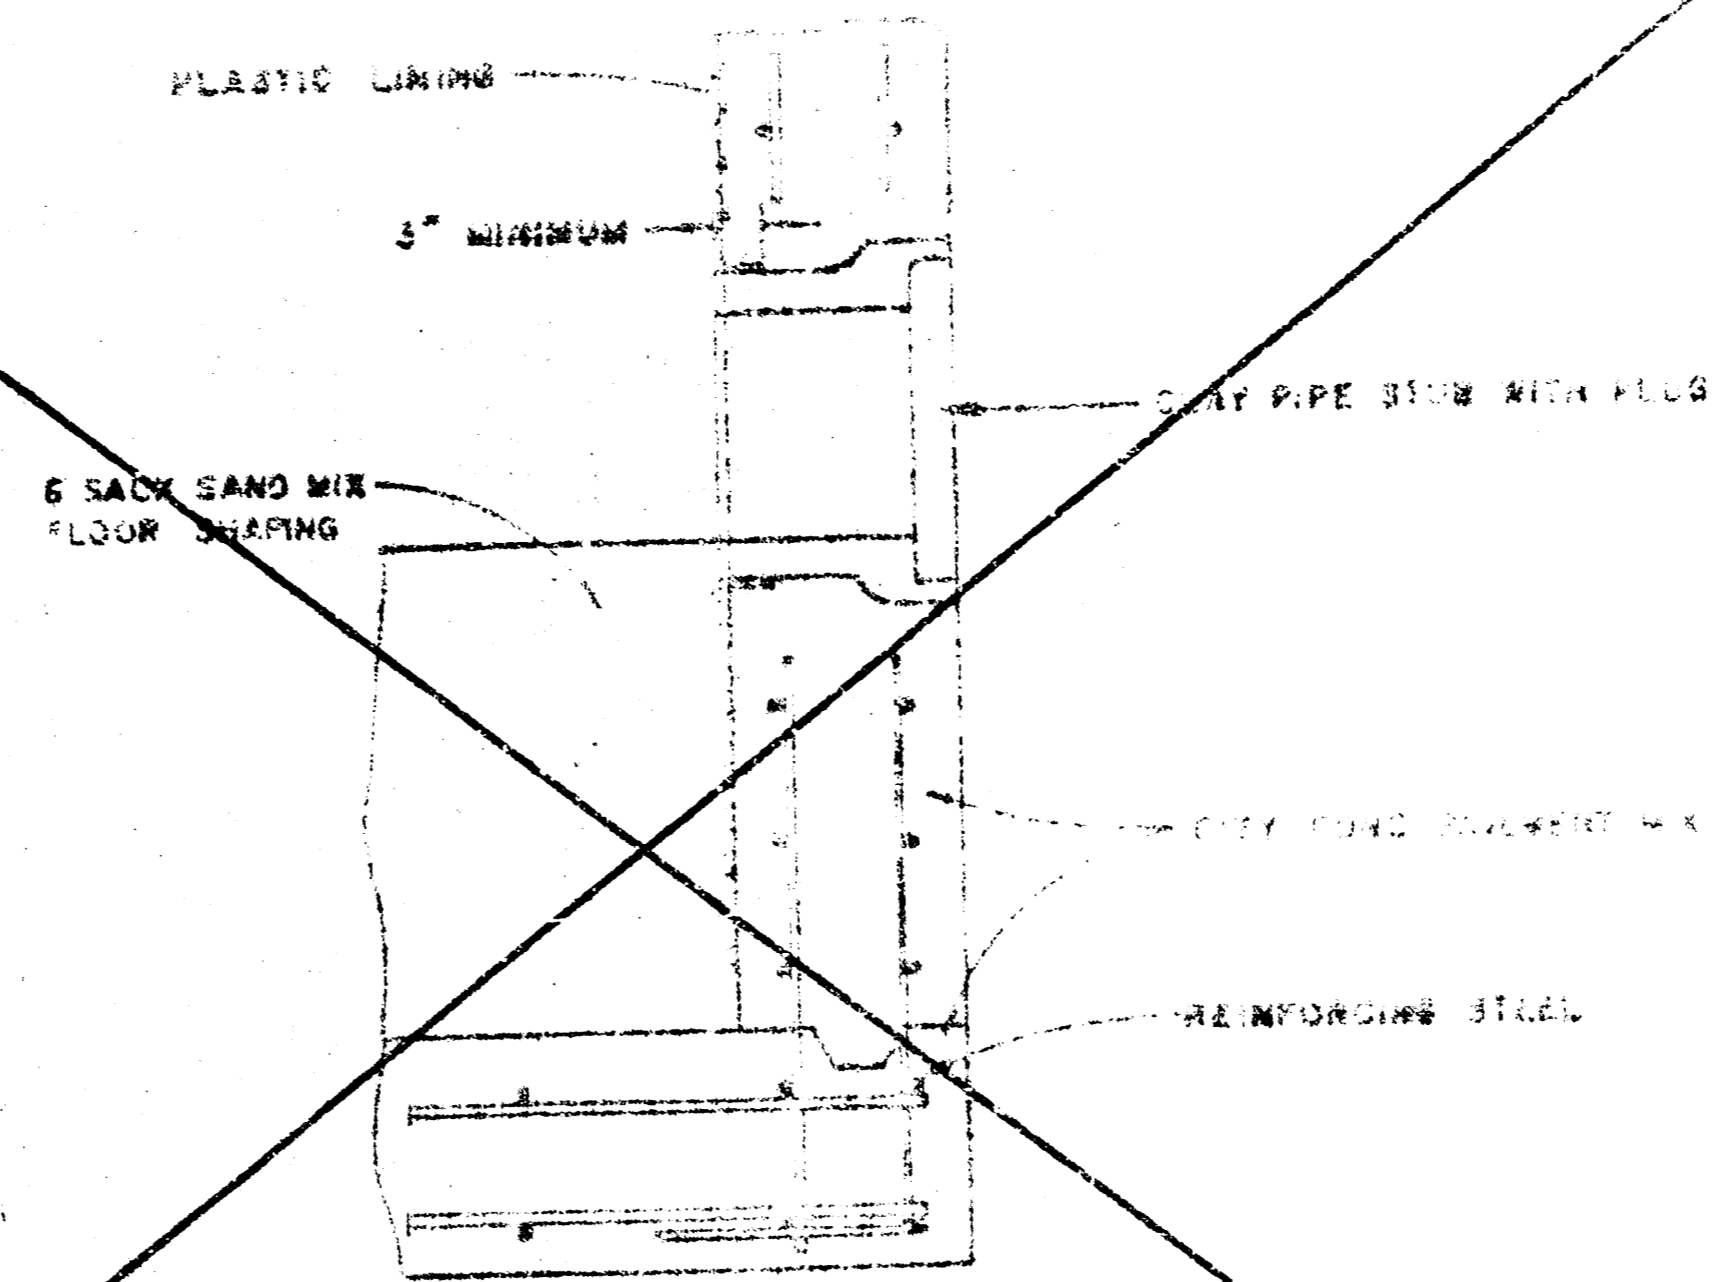


V.C.P. CONNECTION DETAIL  
SANITARY SEWER ONLY

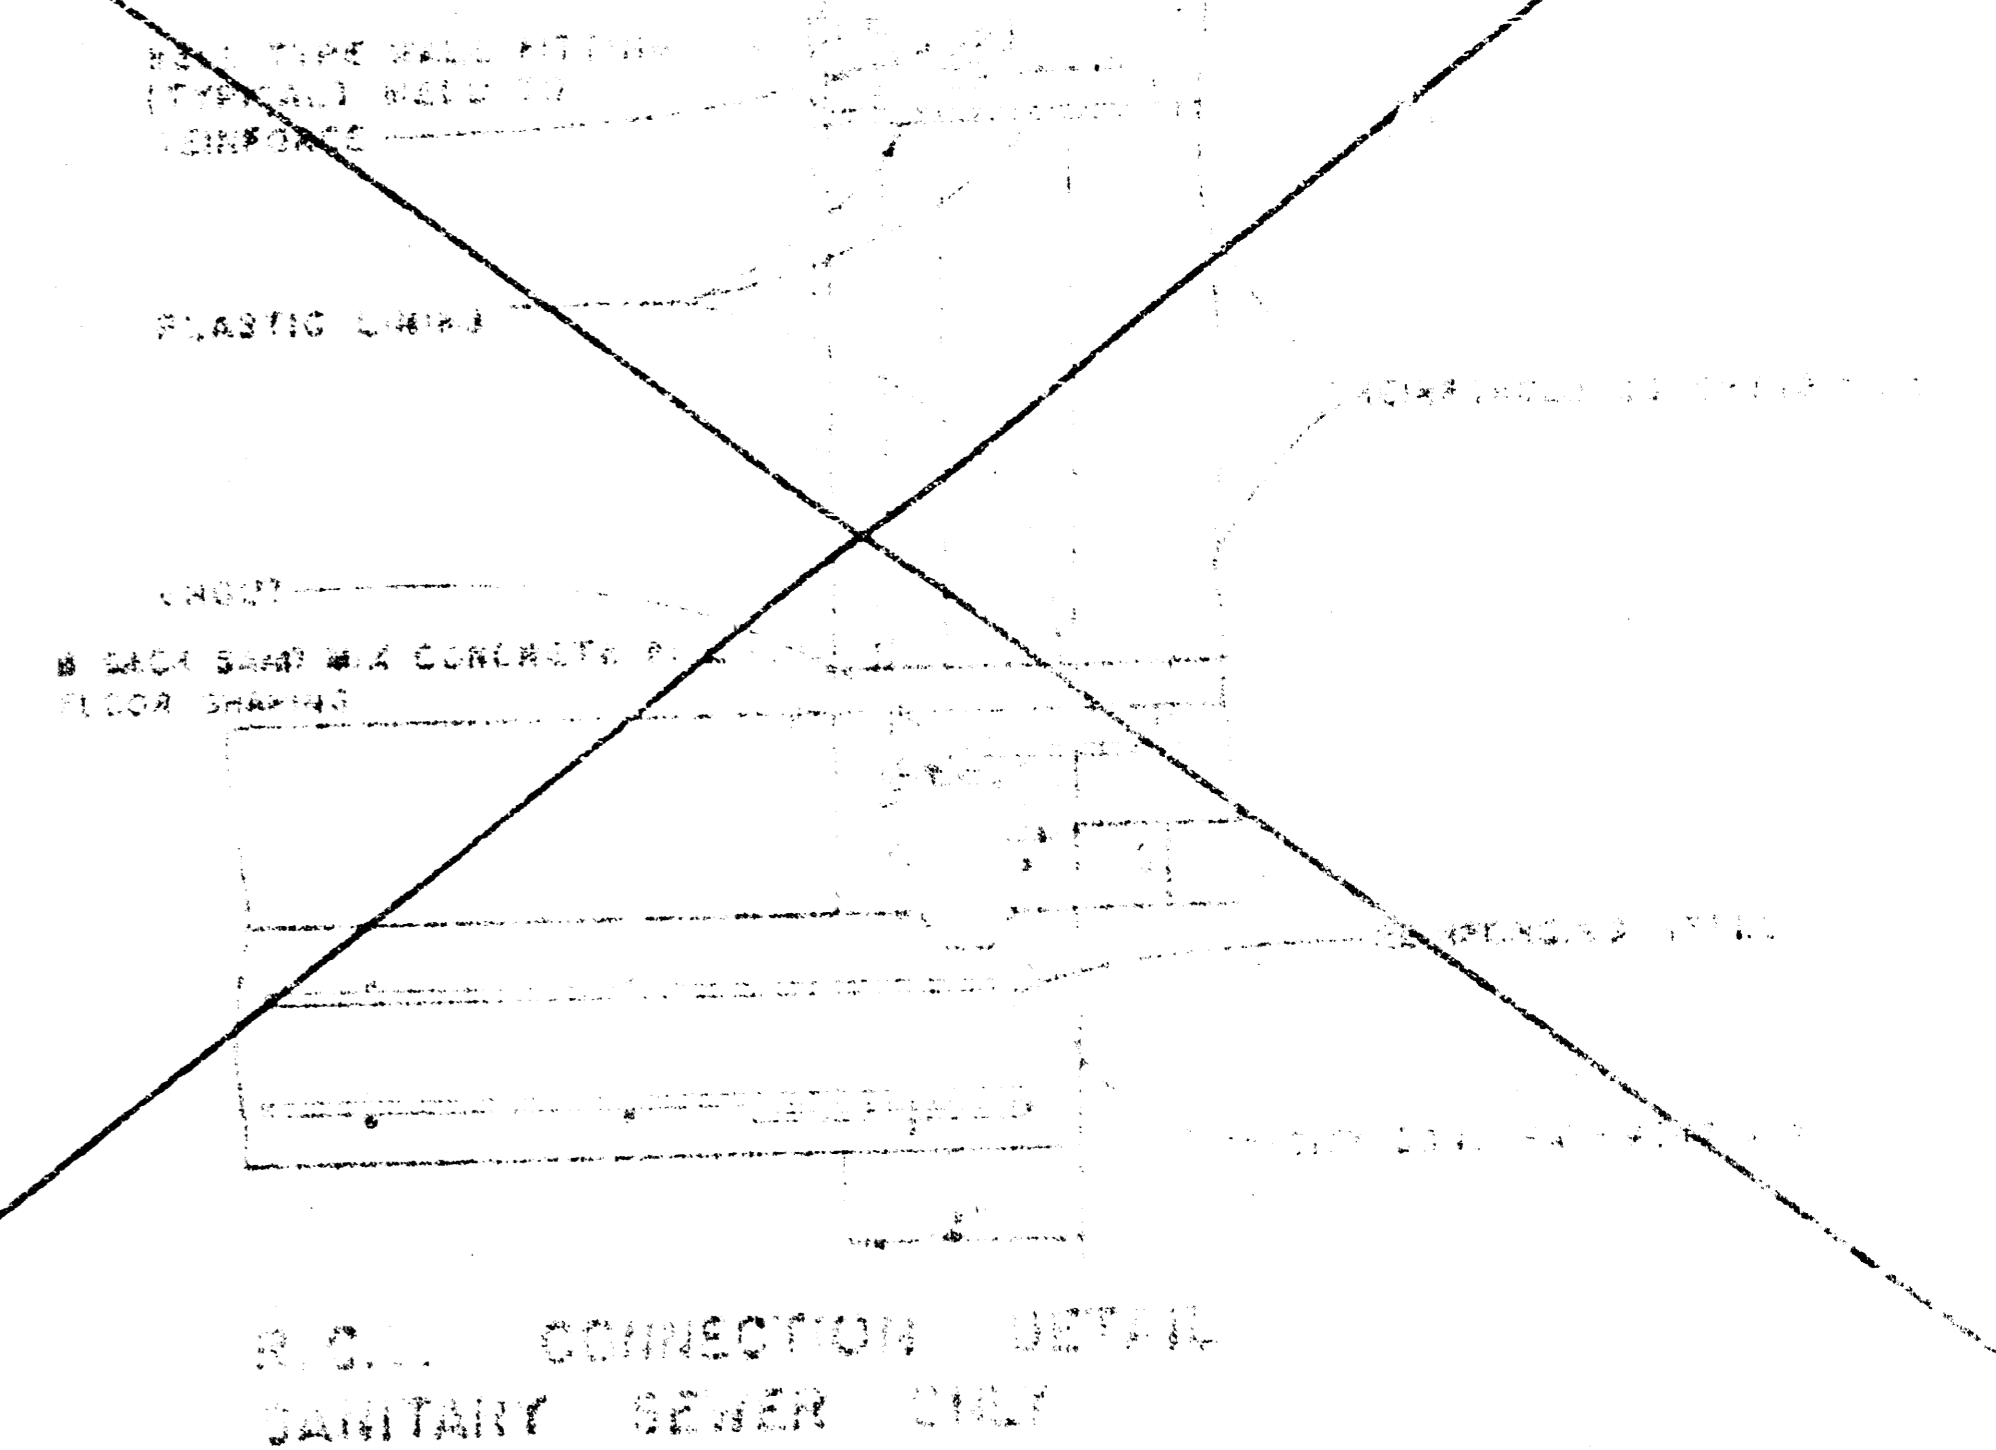

B.C.P. CONNECTION DETAIL  
SANITARY SEWER ONLY

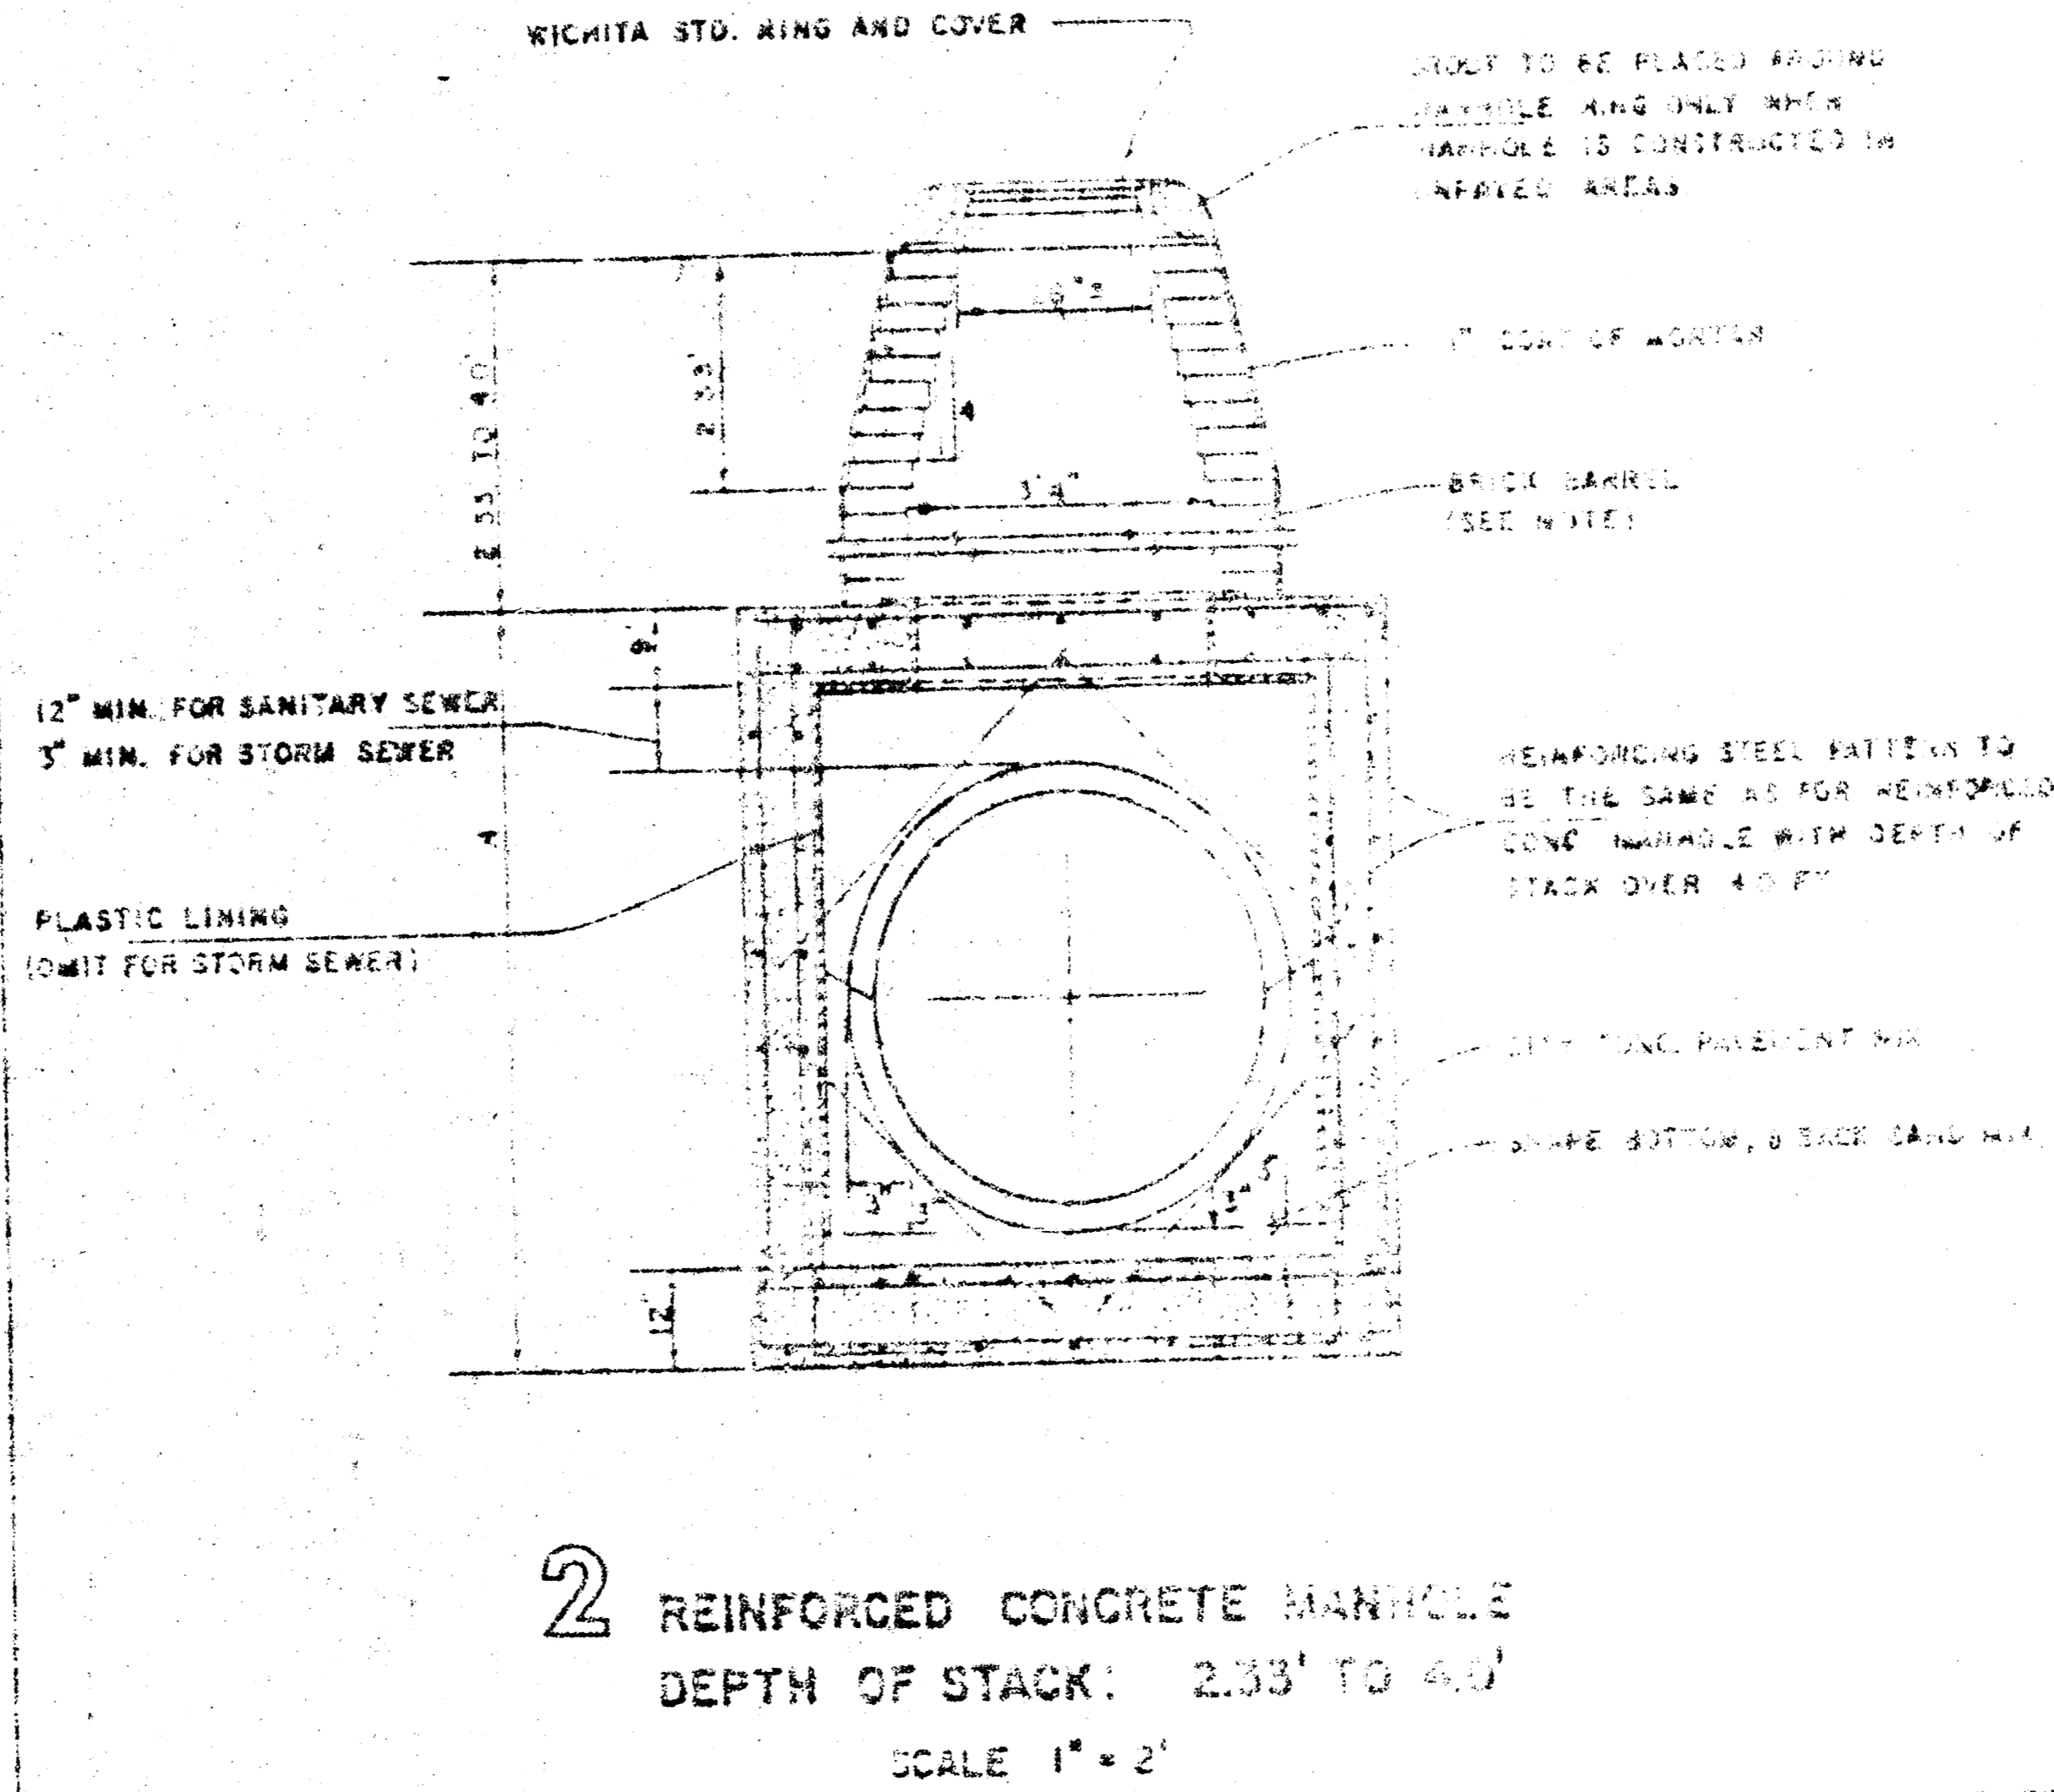

**2** REINFORCED CONCRETE MANHOLE  
DEPTH OF STACK: 2.33' TO 4.0'  
SCALE 1" = 2'

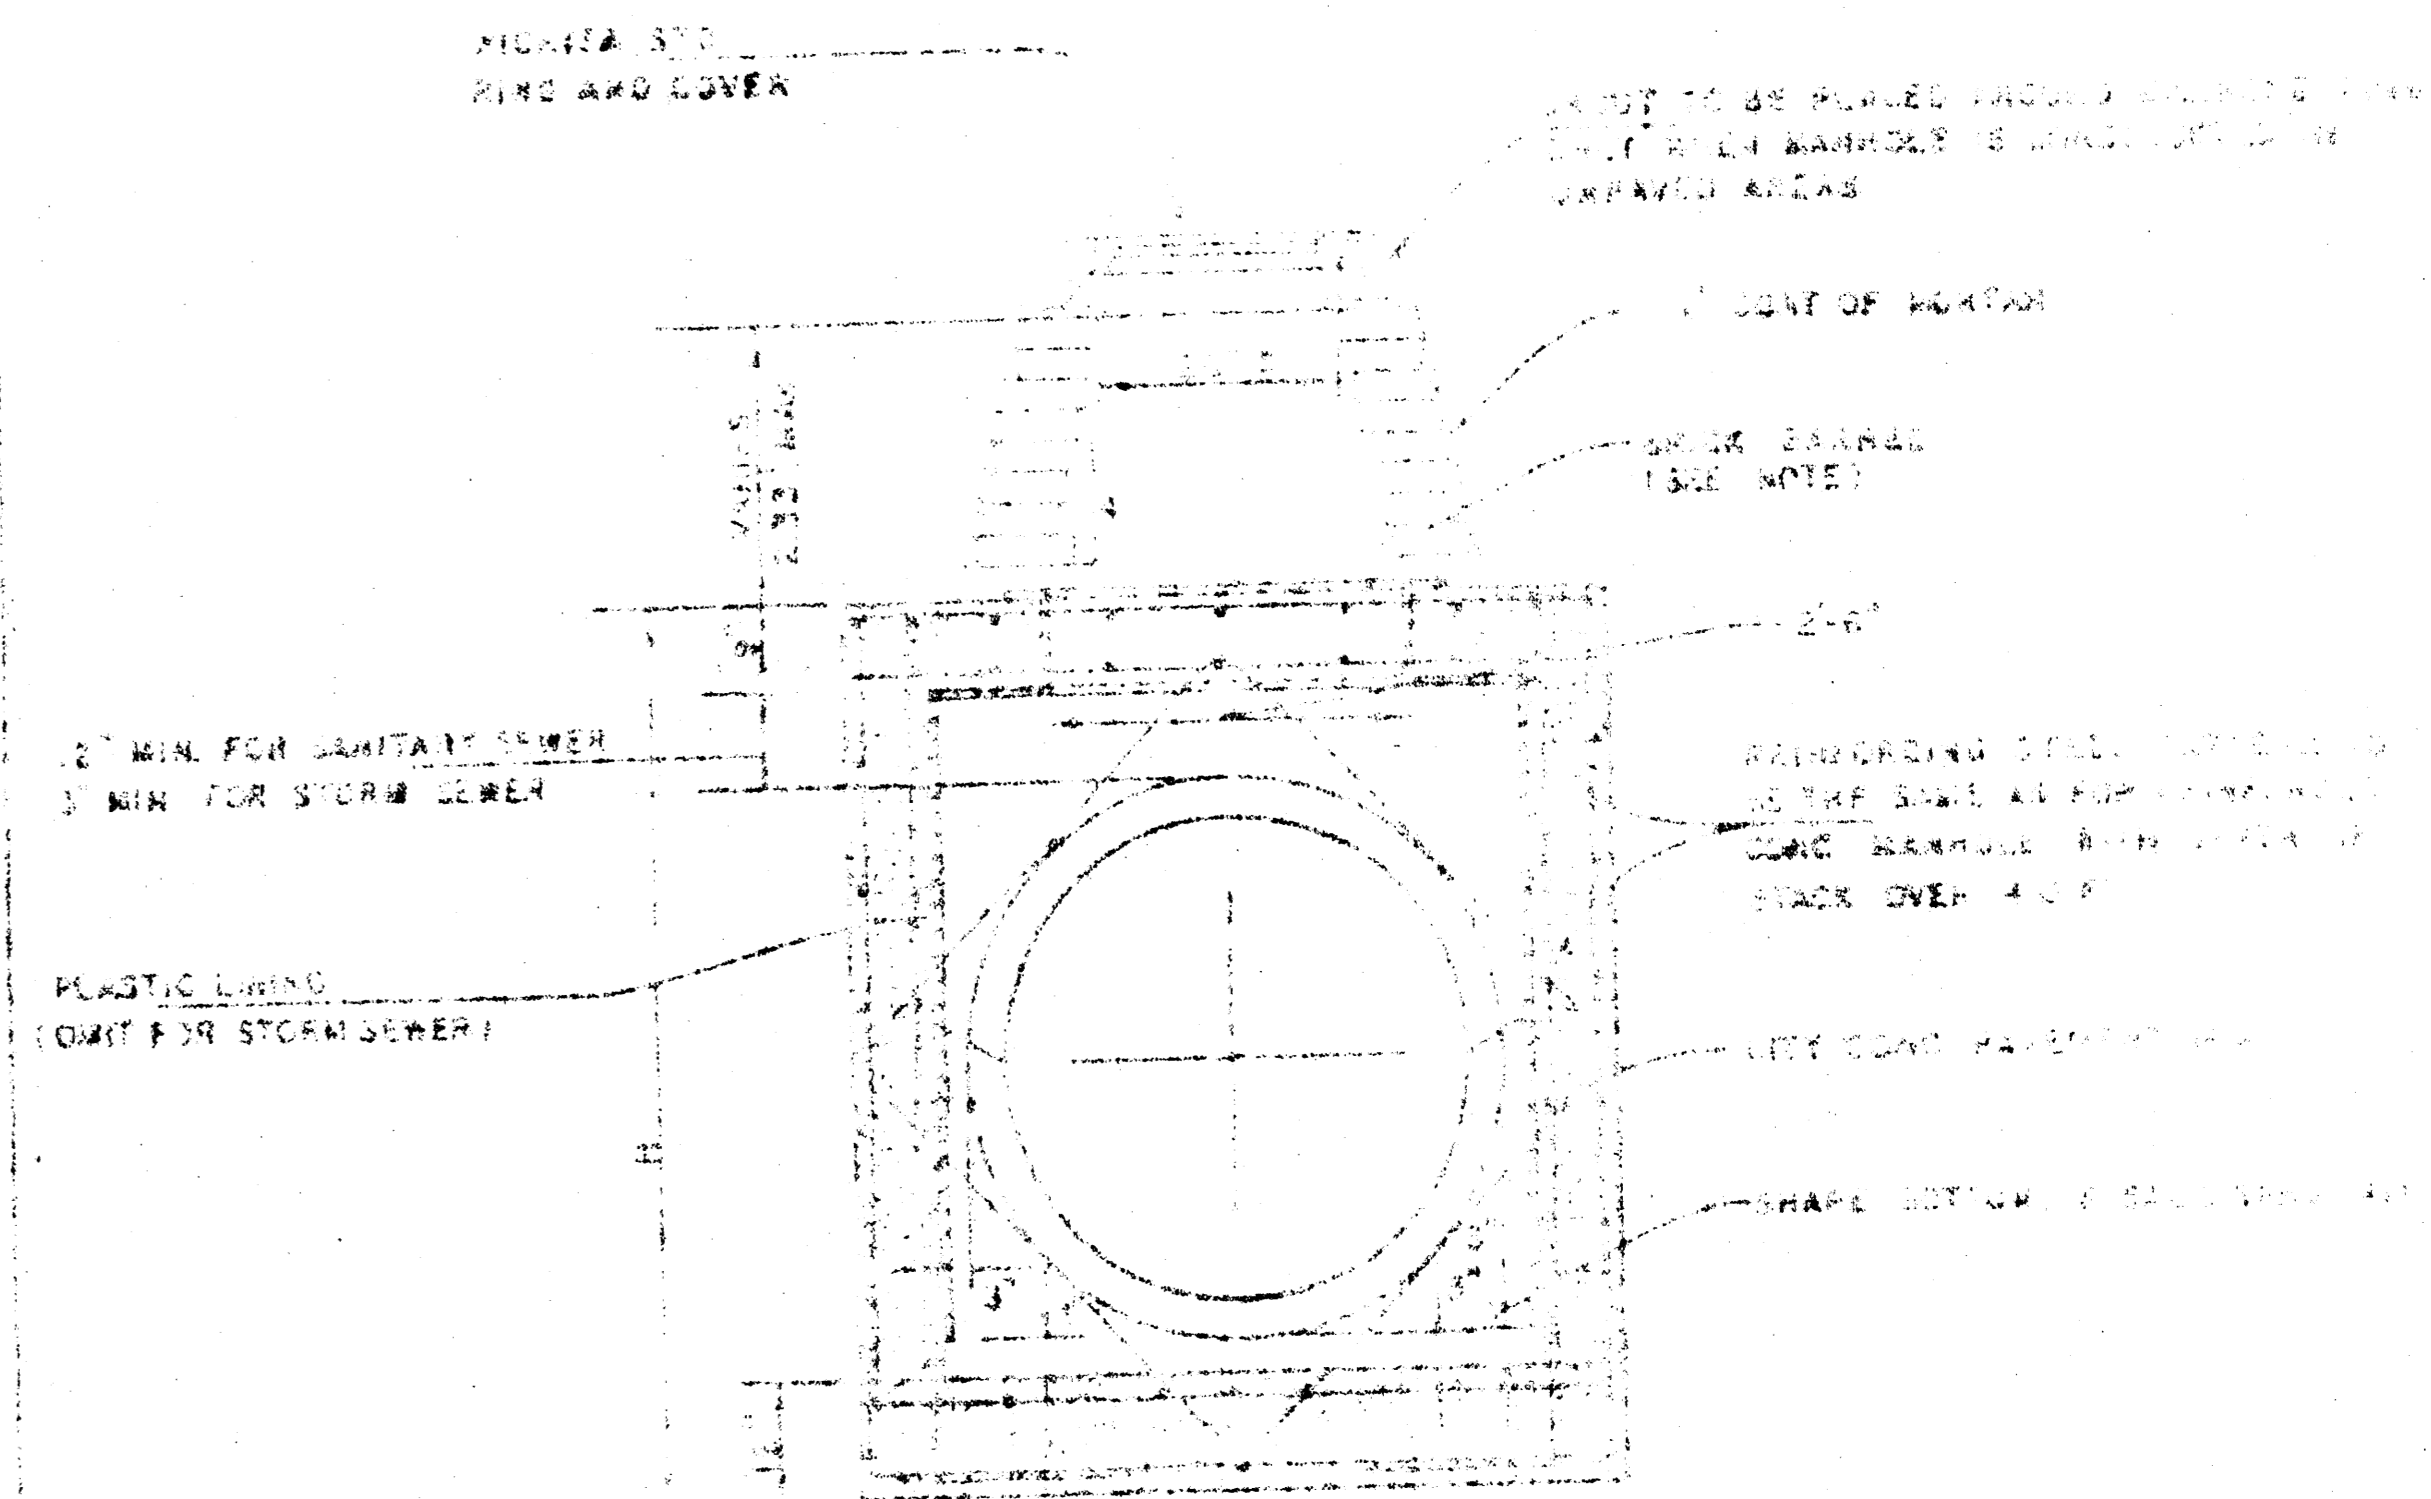

**3** REINFORCED CONCRETE MANHOLE  
DEPTH OF STACK: 0' TO 2.33'  
SCALE 1" = 2'

NOTE 1  
BRICK BARRELS LESS THEN 16' DEEP SHALL HAVE 3" WALLS EXCEPT WHEN LOCATED WITHIN PUBLIC STREET OR ALLEY PAVEMENT THEN THE WALL SHALL BE 12" THICK. BARRELS MORE THEN 16' DEEP SHALL HAVE 12" WALLS TO 27' AND 14" THICKNESS SHALL BE A MINIMUM 6" 1/2" FOR BRICK BARRELS WITH 12" WALLS AND 6" FOR BRICK BARRELS WITH 12" WALLS WHEN THE BRICK BARREL IS OVER 16 FT. IN HEIGHT.

STANDARD DETAILS  
REINFORCED CONCRETE MANHOLES  
CITY OF WICHITA  
A 5

FILMED FROM THE BEST AVAILABLE COPY



# MANHOLE FRAME AND COVER DETAIL


ADOPTED AS STANDARD DESIGN

BY


City of Wichita, Kansas

MANHOLE COVER


Weight: 180 Lbs.

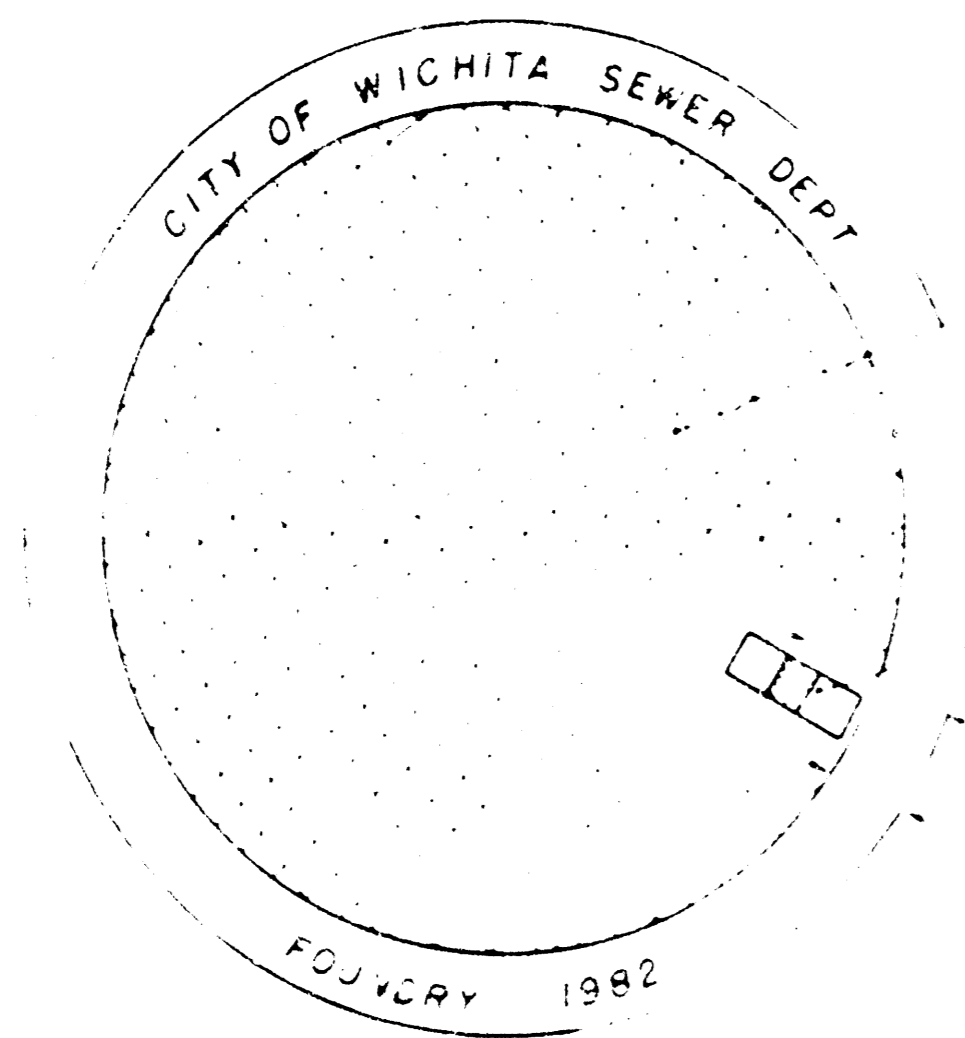

TOP VIEW

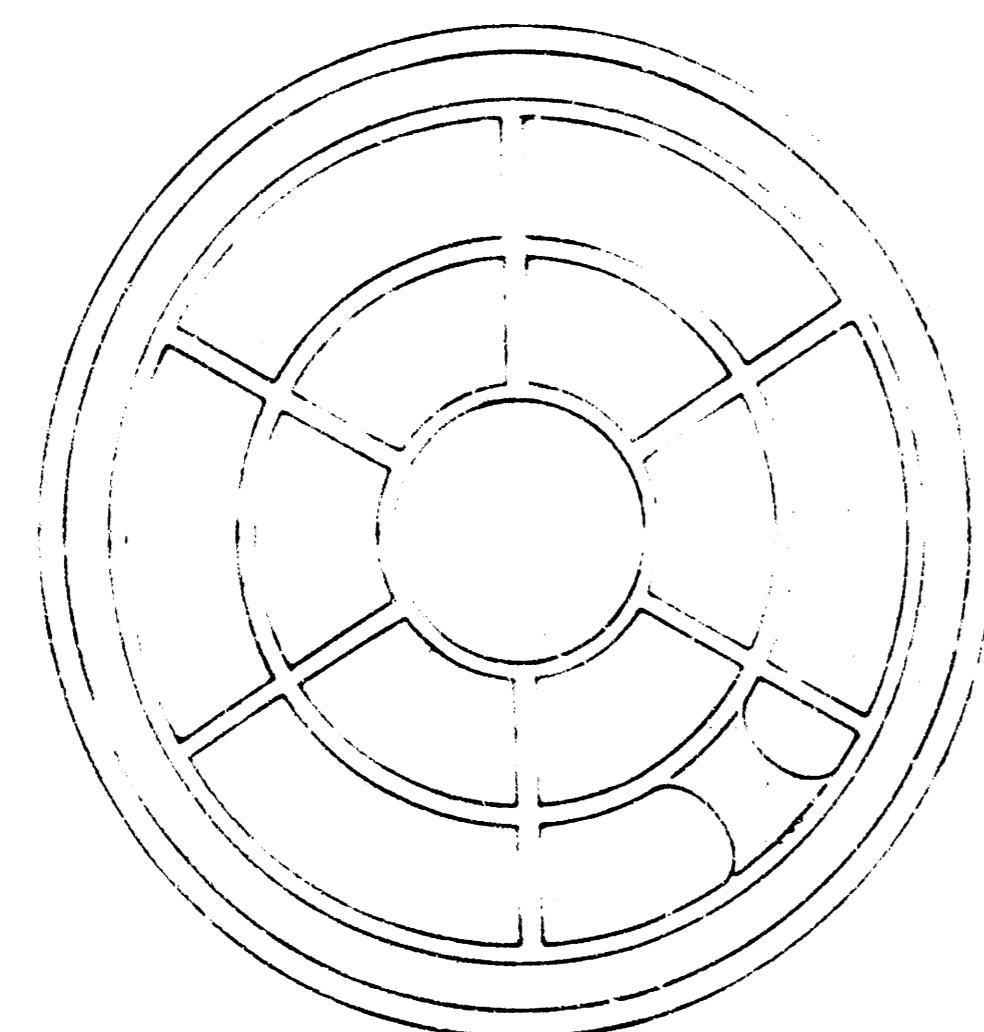


BOTTOM VIEW

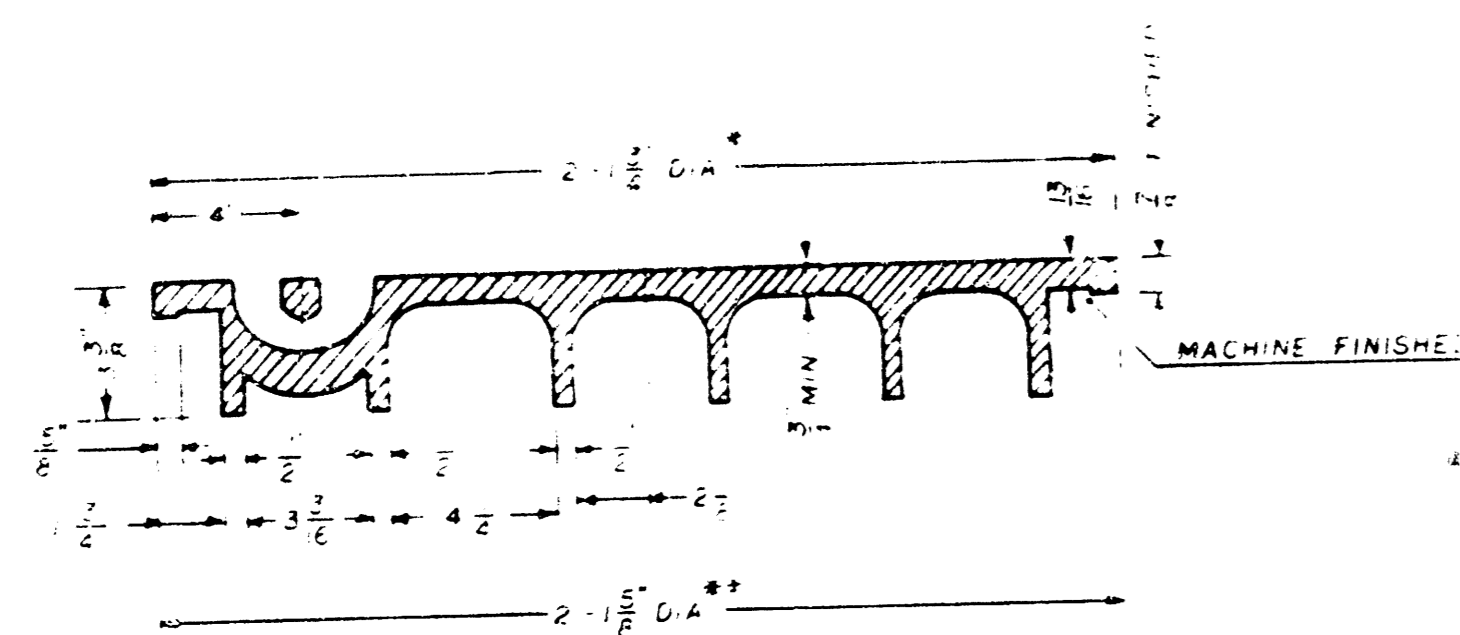

SECTION VIEW

\* OUTSIDE DIA. TOP OF COVER  
 \*\* OUTSIDE DIA. BOTTOM OF COVER

PICKHOLE DETAIL

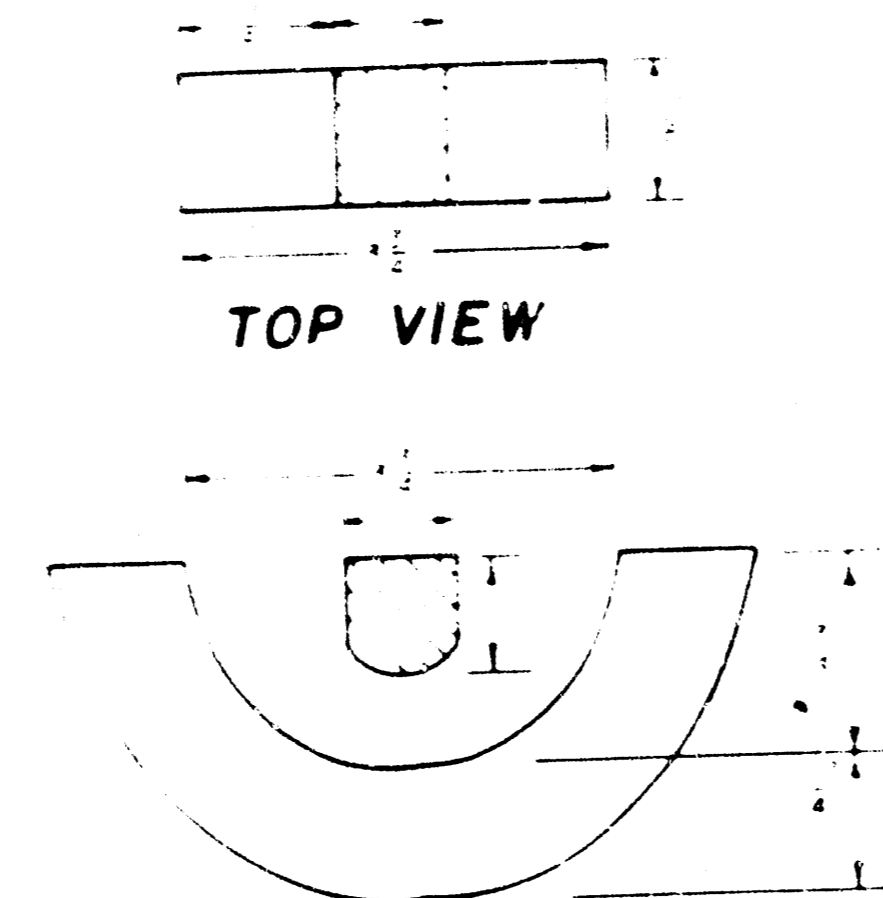


TOP VIEW


SECTION VIEW

MANHOLE FRAME

Weight: 240 Lbs.

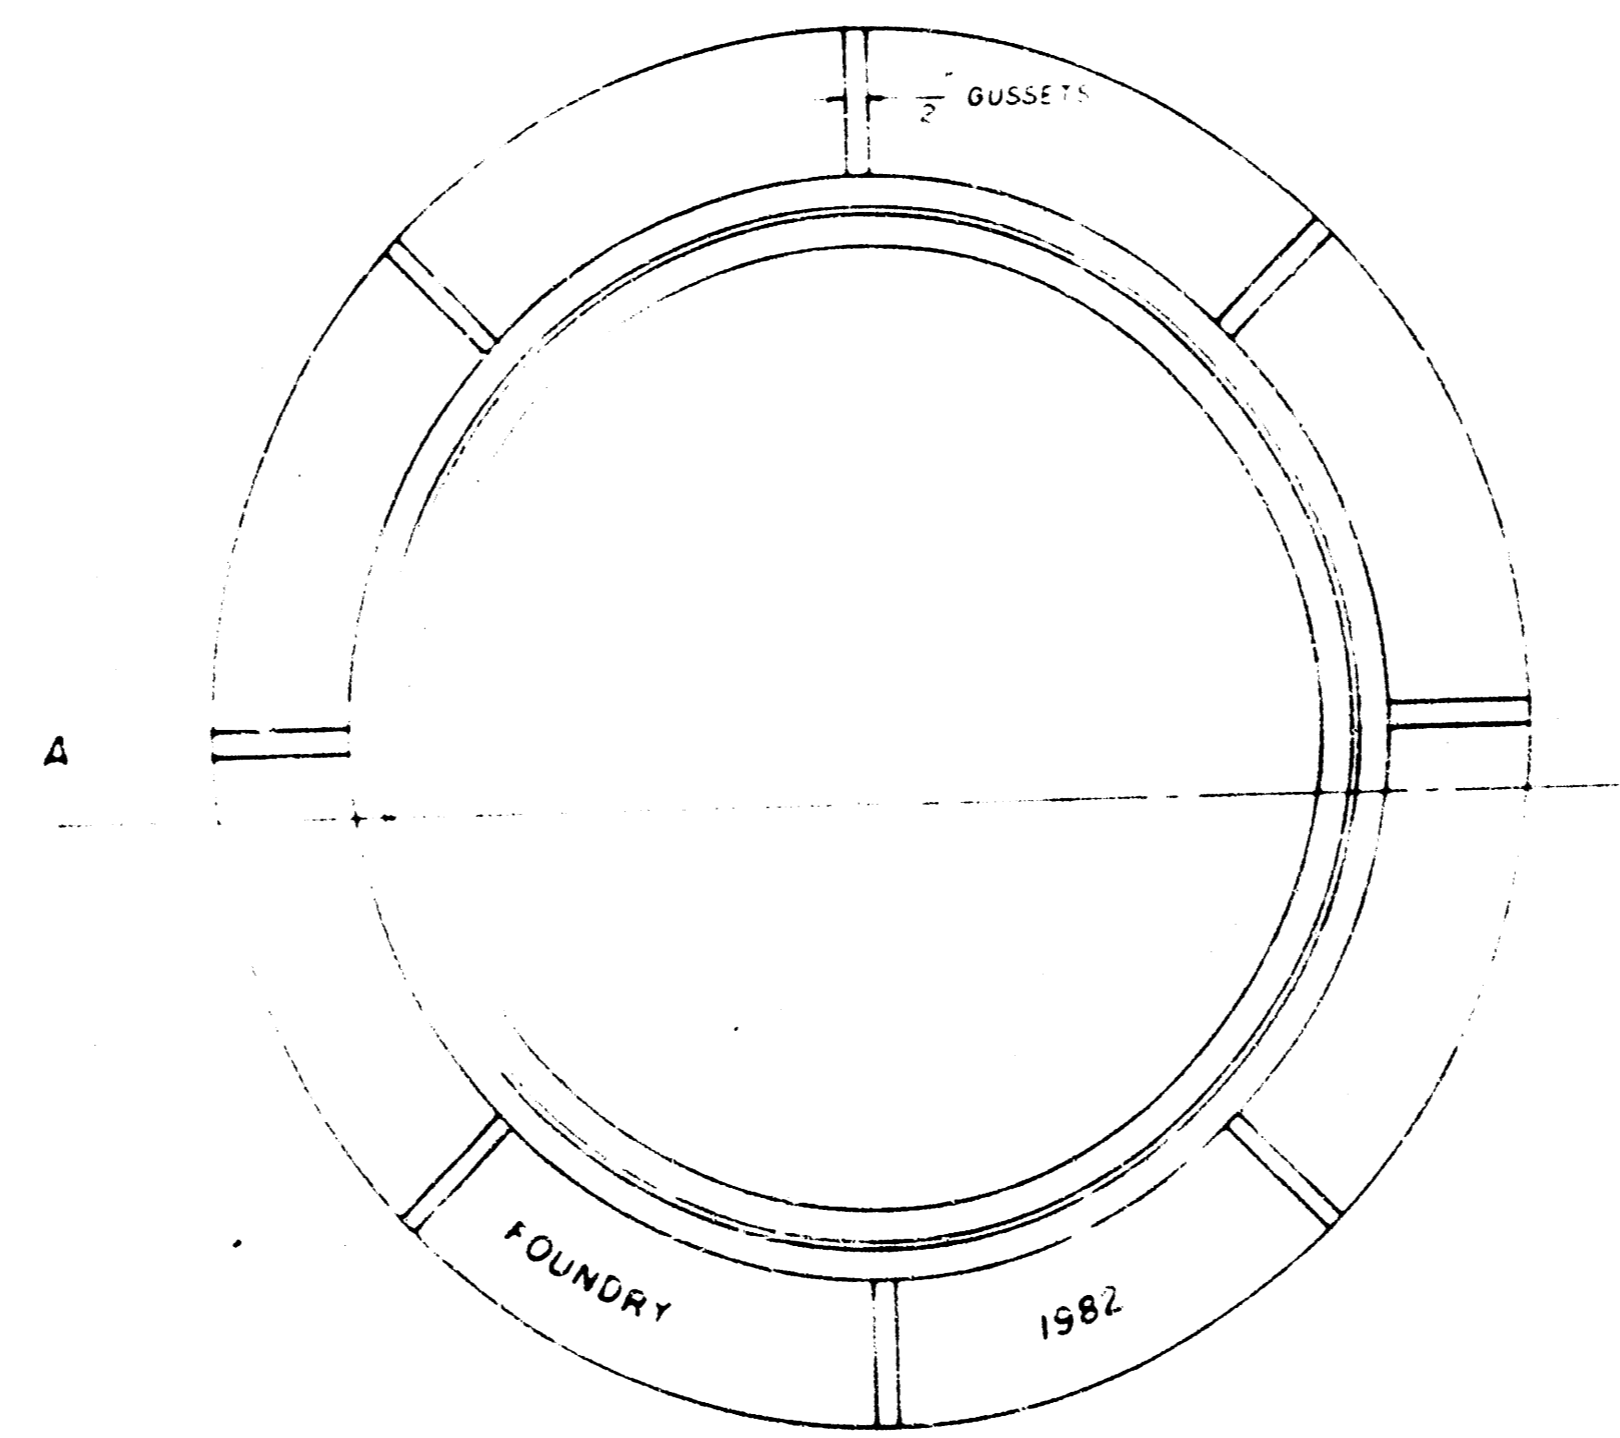


TOP VIEW

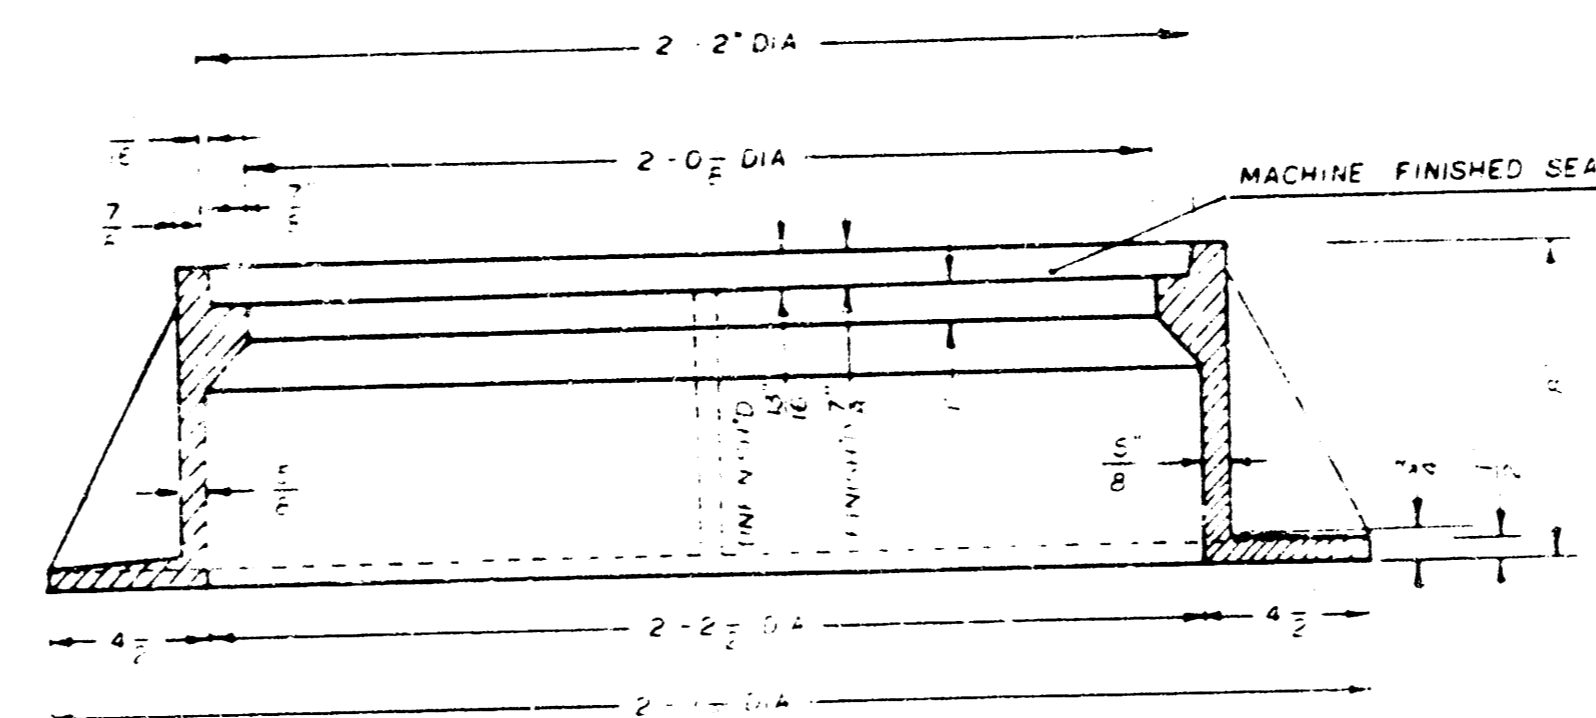

SECTION A-A

- MANHOLE CASTING SHALL BE MANUFACTURED IN ACCORDANCE WITH THE CITY OF WICHITA STANDARD SPECIFICATIONS FOR MANHOLE CASTINGS, WHICH ARE AVAILABLE FROM THE CITY ENGINEER'S OFFICE. THE DIMENSIONS SHOWN ON THIS DRAWING SHALL BE CONSIDERED AS MINIMUM REQUIREMENTS. THE DIMENSIONS SHALL BE SUBJECT TO CHANGE WITHOUT NOTICE BY THE CITY ENGINEER'S OFFICE.
- MANHOLE CASTING SHALL BE COATED WITH AN ASPHALT PAINT FINISHING IN A MANNER TO BE APPROVED BY THE CITY ENGINEER'S OFFICE.
- MANHOLE CASTING SHALL BE MANUFACTURED SUCH THAT A COVER MANUFACTURED BY ANY CITY OF WICHITA FOUNDRY WILL FIT INTERCHANGEABLY INTO A FRAME MANUFACTURED BY ANOTHER CITY OF WICHITA FOUNDRY. THIS WILL REQUIRE THAT THE CLEARANCE AND INTERLOCKING REQUIREMENTS, THIS WILL REQUIRE THE MANUFACTURING OF THE MATCHING FACES OF THE COVER AND THE FRAME TO BE IDENTICAL.
- THE OUTSIDE CIRCUMFERENCE OF THE INTERNAL FACE OF THE COVER AND THE INSIDE CIRCUMFERENCE OF THE INTERNAL FACE OF THE FRAME RECESS SHALL BE MANUFACTURED TO TOLERANCES SUCH THAT THE CLEARANCE BETWEEN THE COVER AND FRAME WILL NOT EXCEED 1/16" AT ANY POINT AROUND THE CIRCUMFERENCE OF THE COVER. THE SEATING SURFACES BETWEEN THE COVER AND FRAME SHALL BE MACHINED SUCH THAT THESE SURFACES SHALL MAKE FULL CONTACT FOR THE FULL CIRCUMFERENCE TO PREVENT THE COVER FROM RIGGING IN THE FRAME.
- THE MANHOLE FRAME AND COVER SHALL BE MARKED WITH LETTERING INDICATING THE NAME OF THE MANUFACTURER AND THE YEAR WHEN THE COVER OR FRAME WAS CAST. THE COVER SHALL BE FURTHER IDENTIFIED WITH REGARDS TO OWNERSHIP USING LETTERS AT LEAST 1/2" HIGH. THIS IDENTIFICATION SHALL BE LOCATED ON THE TOP SURFACE OF THE COVER. THE WORD IDENTIFICATION MAY BE ABBREVIATED. THE TEXTURE OF THE TOP SURFACE OF THE COVER SHALL BE MANUFACTURED IN A CHECKERED PATTERN DESIGN AS INDICATED ON THE DRAWING. SMOOTH BLOCKOUTS SHALL BE USED TO HIGHLIGHT THE LETTERING ON THE COVER SURFACE. THE TOTAL AREA OF SMOOTH SURFACE BLOCKOUT SHALL NOT EXCEED THE AREA AS INDICATED ON THE DRAWING. FINISHING OF SMOOTH BLOCKOUTS AND LETTERING MAY VARY FROM THAT SHOWN ON THE DETAILED DRAWING.

MANHOLE FRAME  
 &  
 COVER DETAIL  
 CITY OF WICHITA, KANSAS

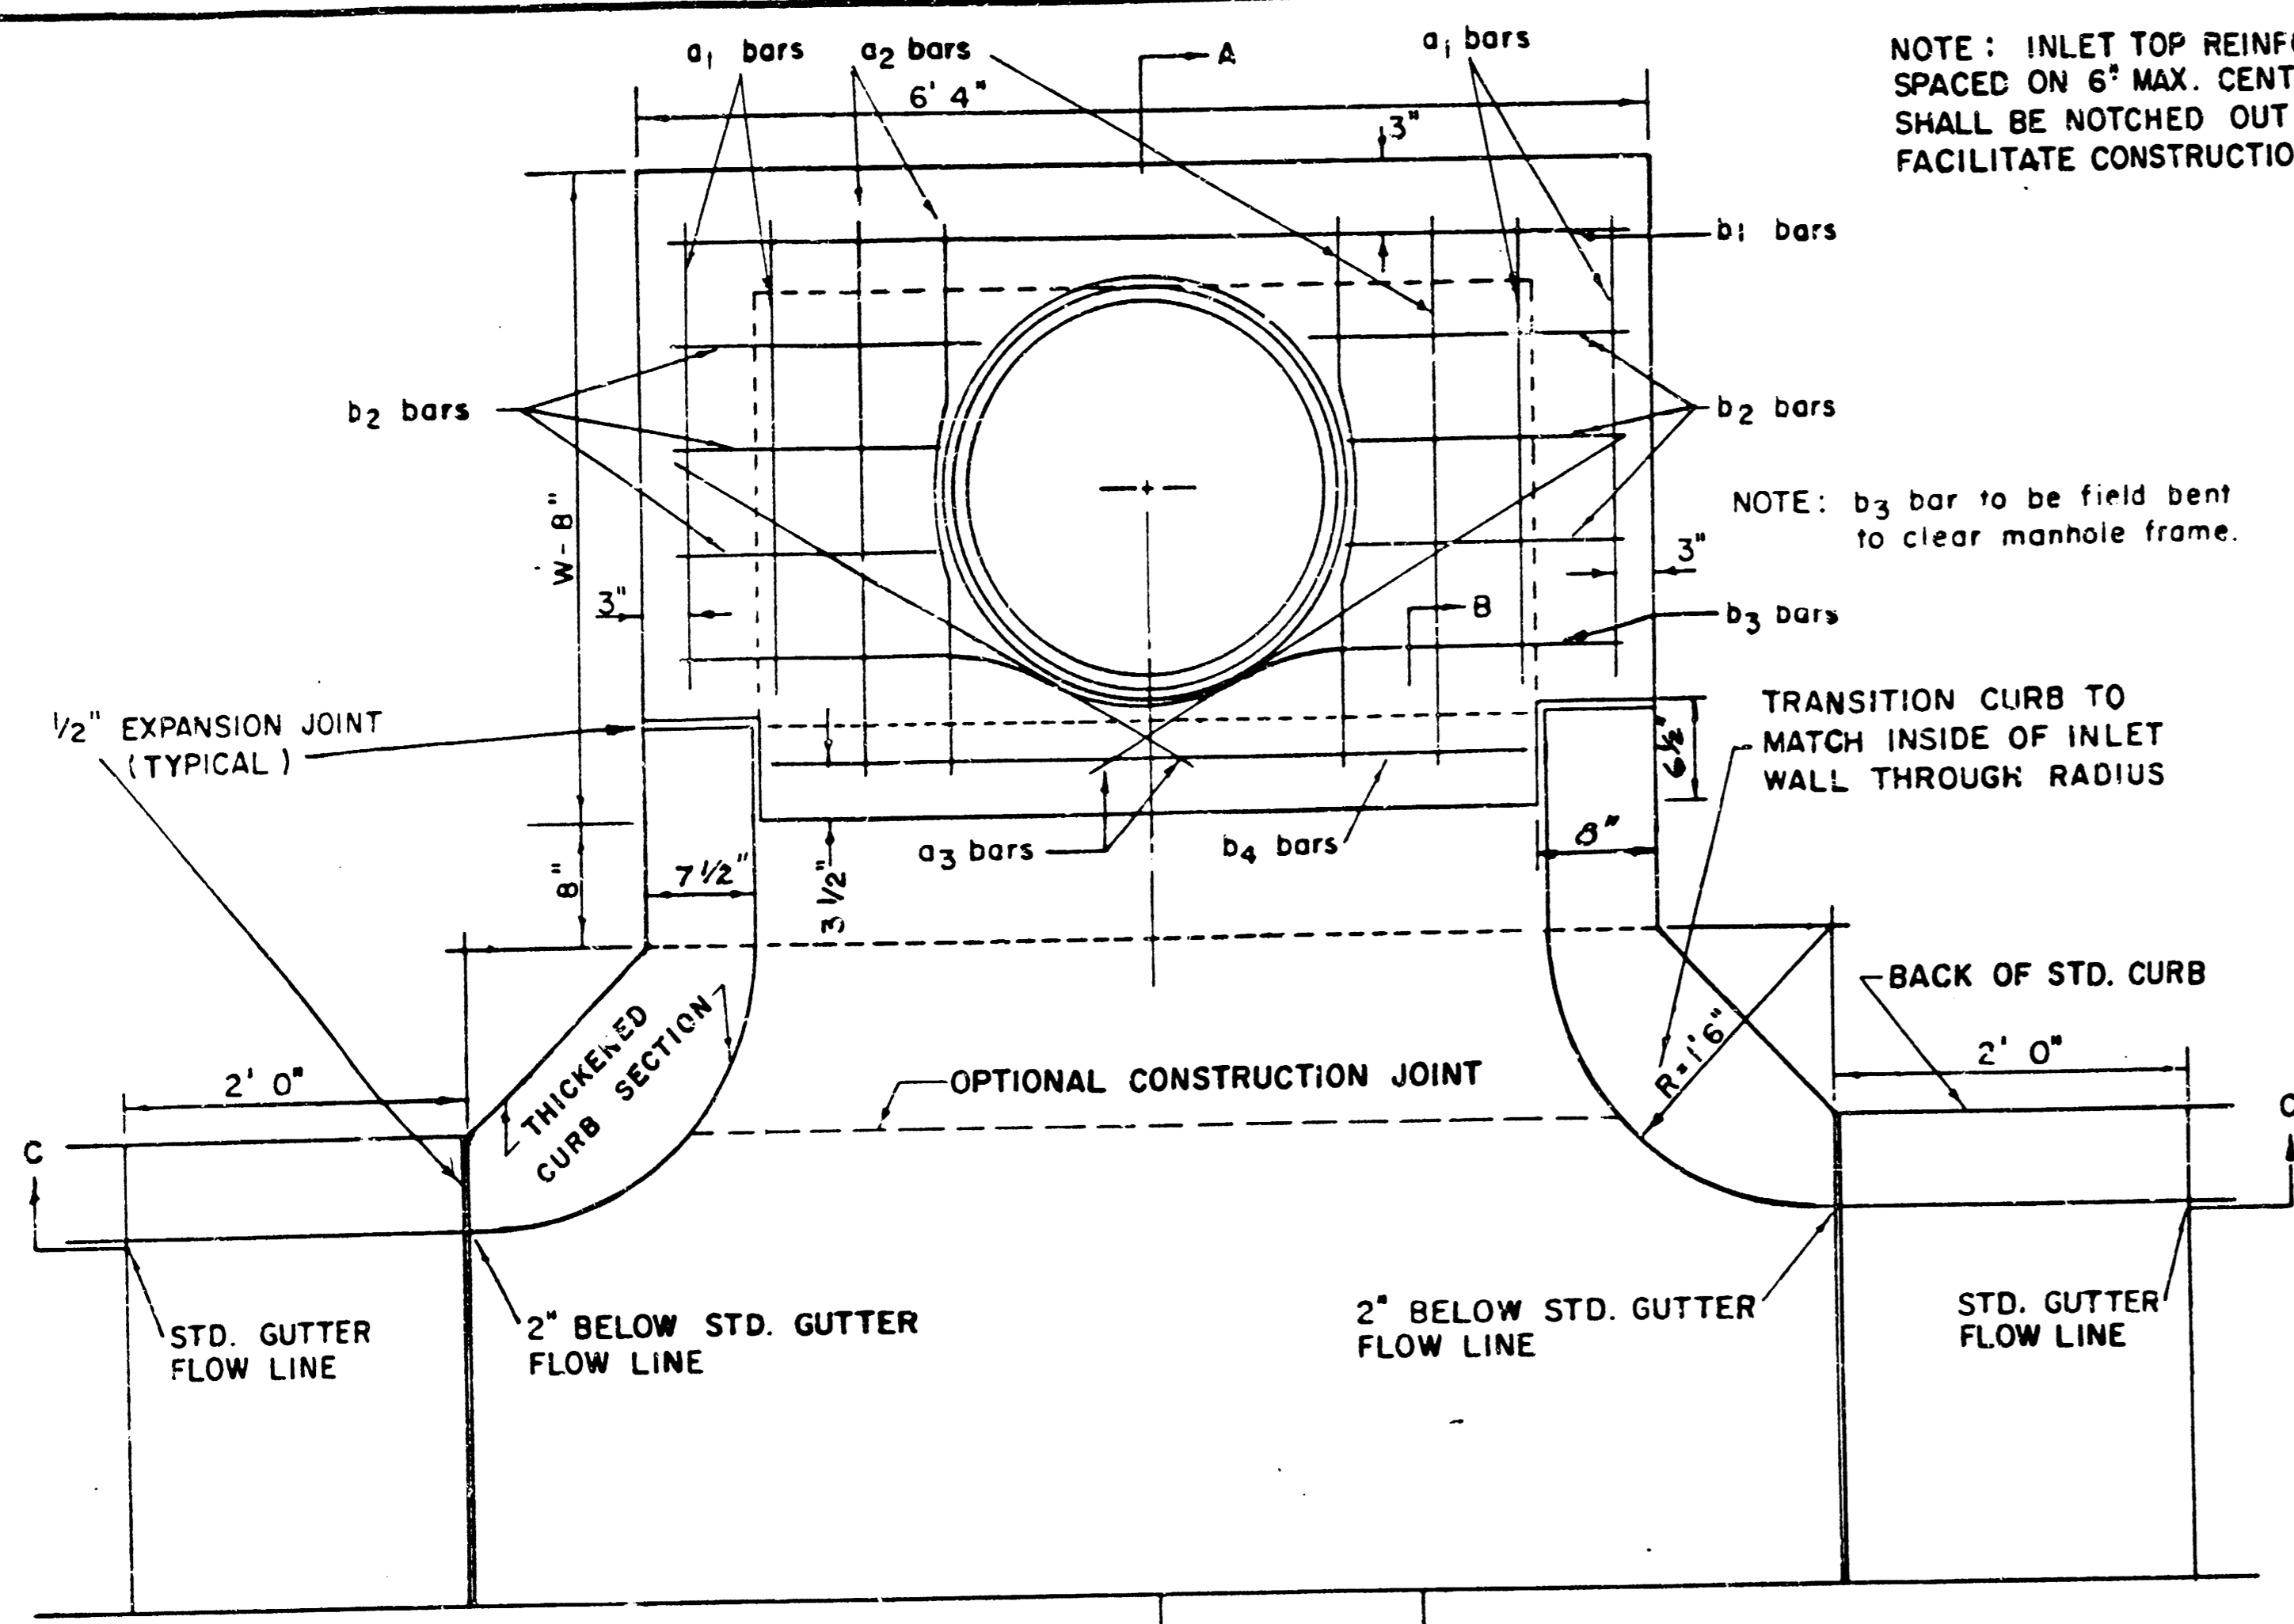


NOTE: EXPANSION JOINT ONLY IN CURB AREA WITH CONC. PAVEMENT.

PLAN

NOTE: INLET TOP REINFORCING SHALL BE SPACED ON 6" MAX. CENTERS. INLET LIDS SHALL BE NOTCHED OUT AS INDICATED TO FACILITATE CONSTRUCTION OF CURB.

NOTE: b3 bar to be field bent to clear manhole frame.

TRANSITION CURB TO MATCH INSIDE OF INLET WALL THROUGH RADIUS

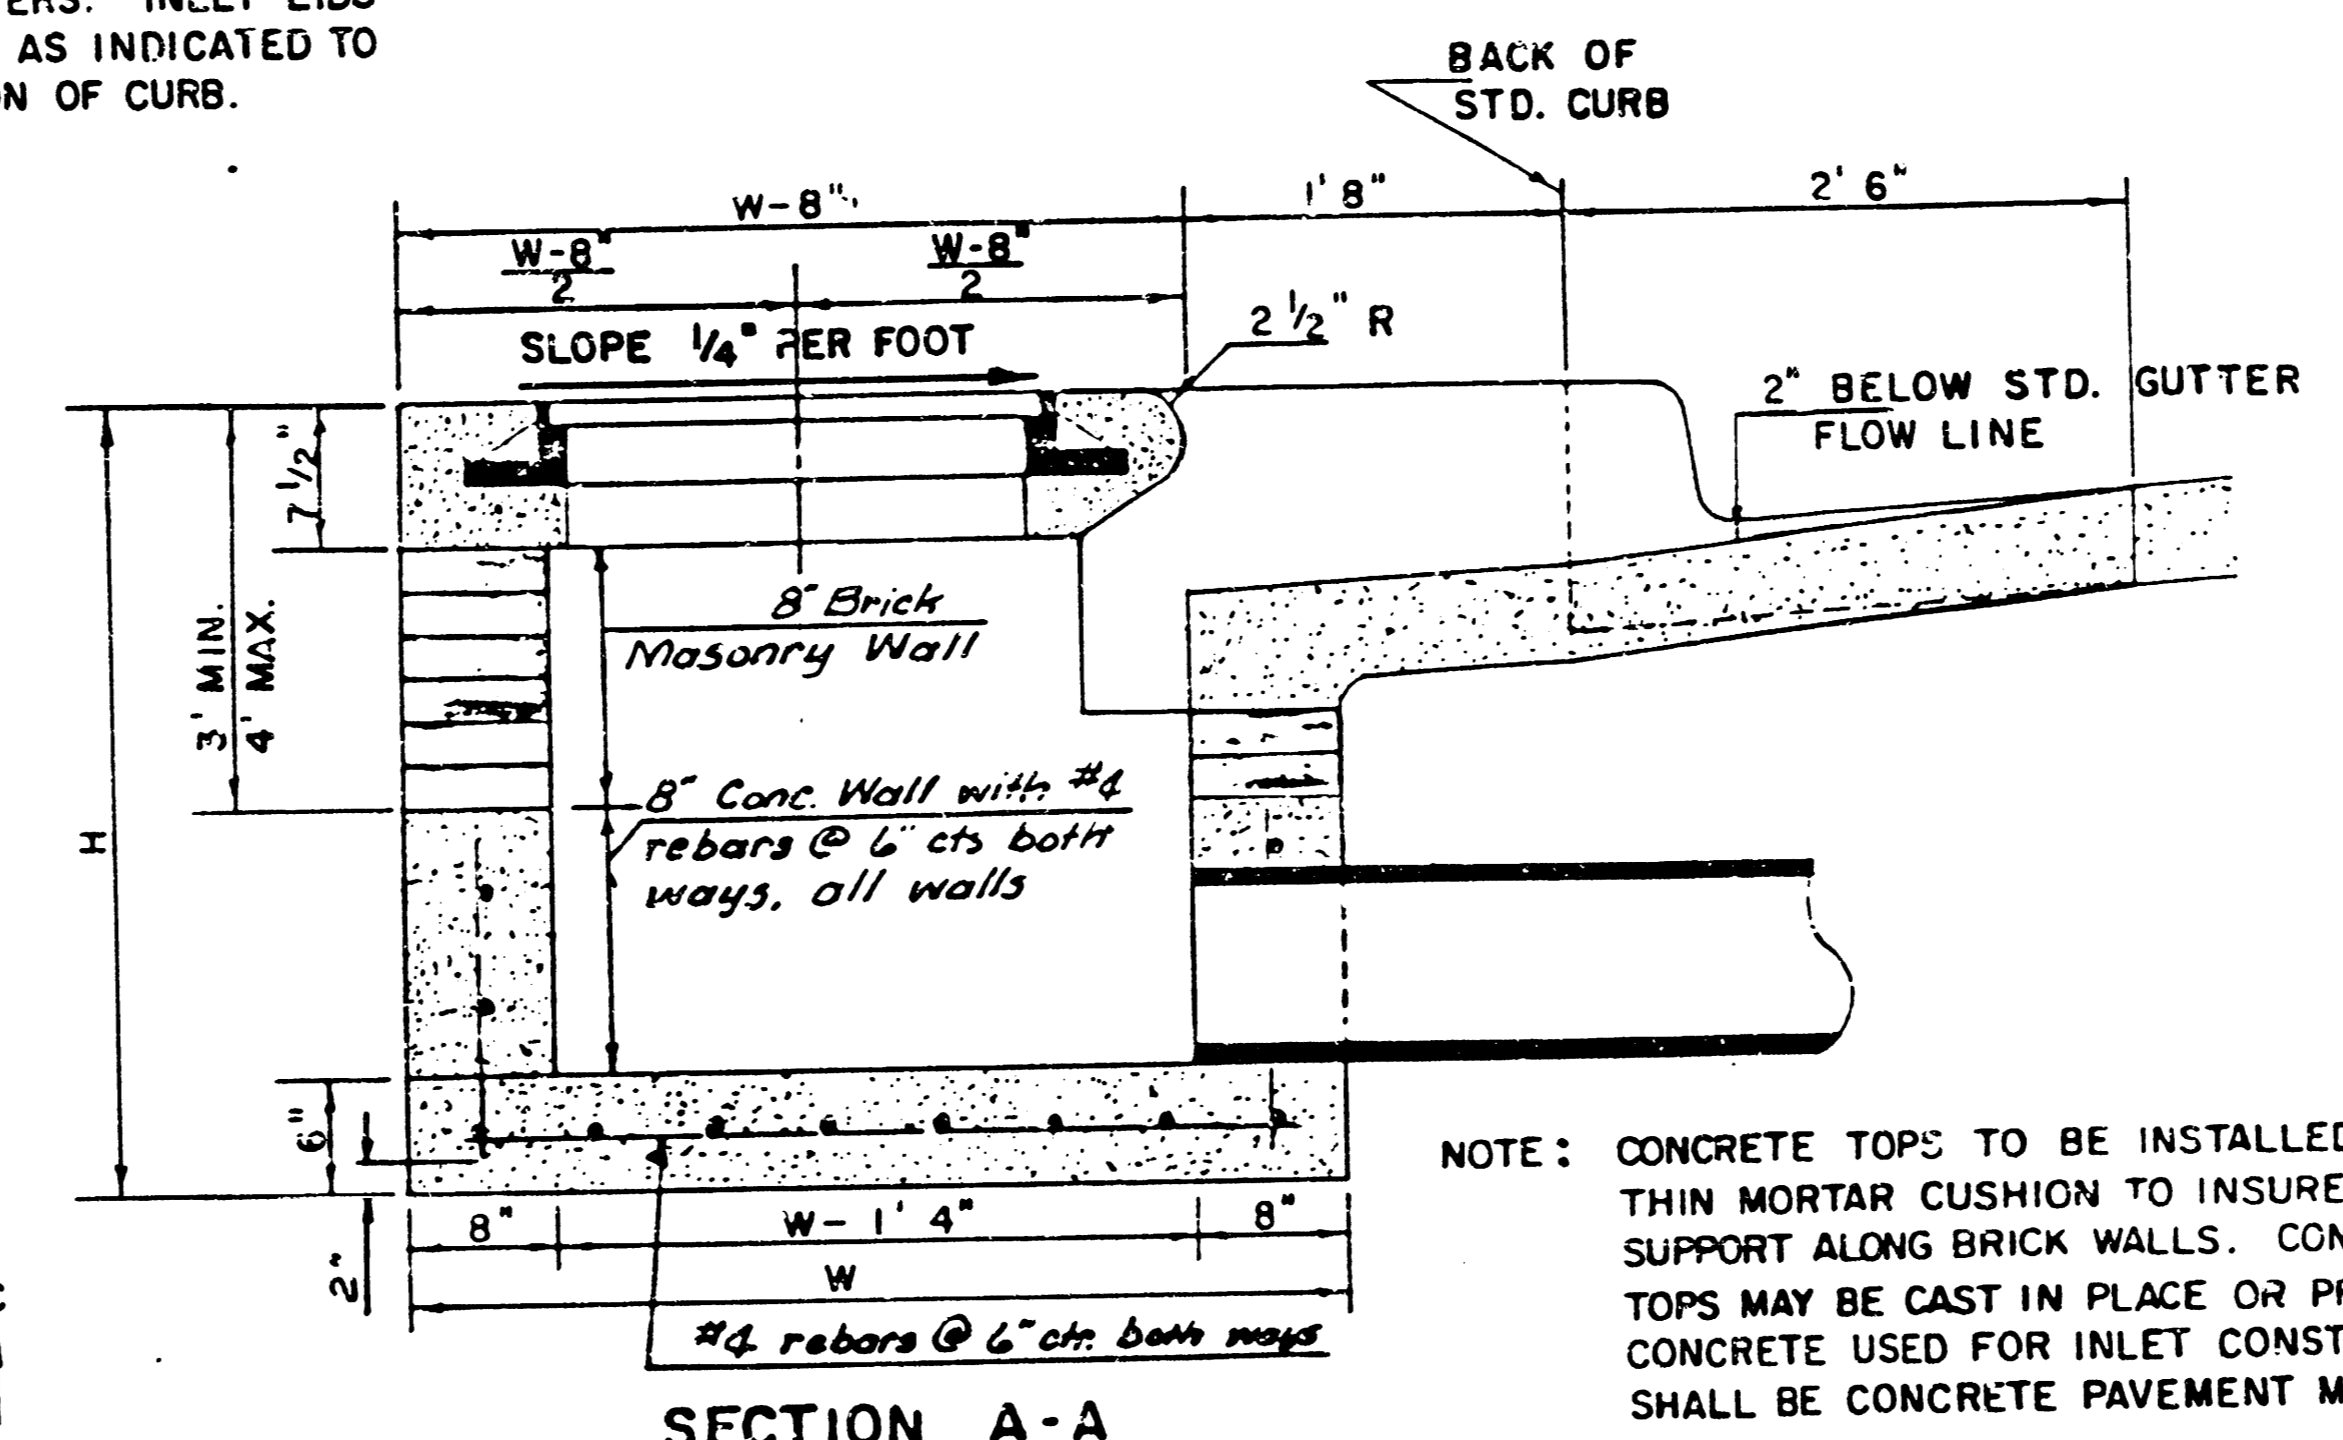


NOTE: CONCRETE TOPS TO BE INSTALLED ON THIN MORTAR CUSHION TO INSURE FULL SUPPORT ALONG BRICK WALLS. CONCRETE TOPS MAY BE CAST IN PLACE OR PRECAST. CONCRETE USED FOR INLET CONSTRUCTION SHALL BE CONCRETE PAVEMENT MIX.

SECTION A-A

NOTE: CONTRACTOR SHALL HAVE THE OPTION OF CONSTRUCTING 8" BRICK MASONRY WALLS BETWEEN THE CONCRETE INLET BASE AND TOP ON THIS INLET WHEN W = 4'4" AND H = 6'6" OR LESS.


ADDITIONAL CURB AND GUTTER CONSTRUCTION NECESSARY TO CONNECT SET-BACK INLET TO PAVEMENT WILL BE PAID FOR AT THE UNIT PRICE BID FOR EACH INLET HOOKUP.

INLET INVERT SHALL BE SHAPED WITH 8 SACK SAND MIX CONCRETE TO CREATE FLOW CHANNELS AND TO INCREASE HYDRAULIC EFFICIENCY SUCH THAT THE INLET WILL BE SELF CLEANING BETWEEN ALL INLET AND/OR OUTLET PIPES.

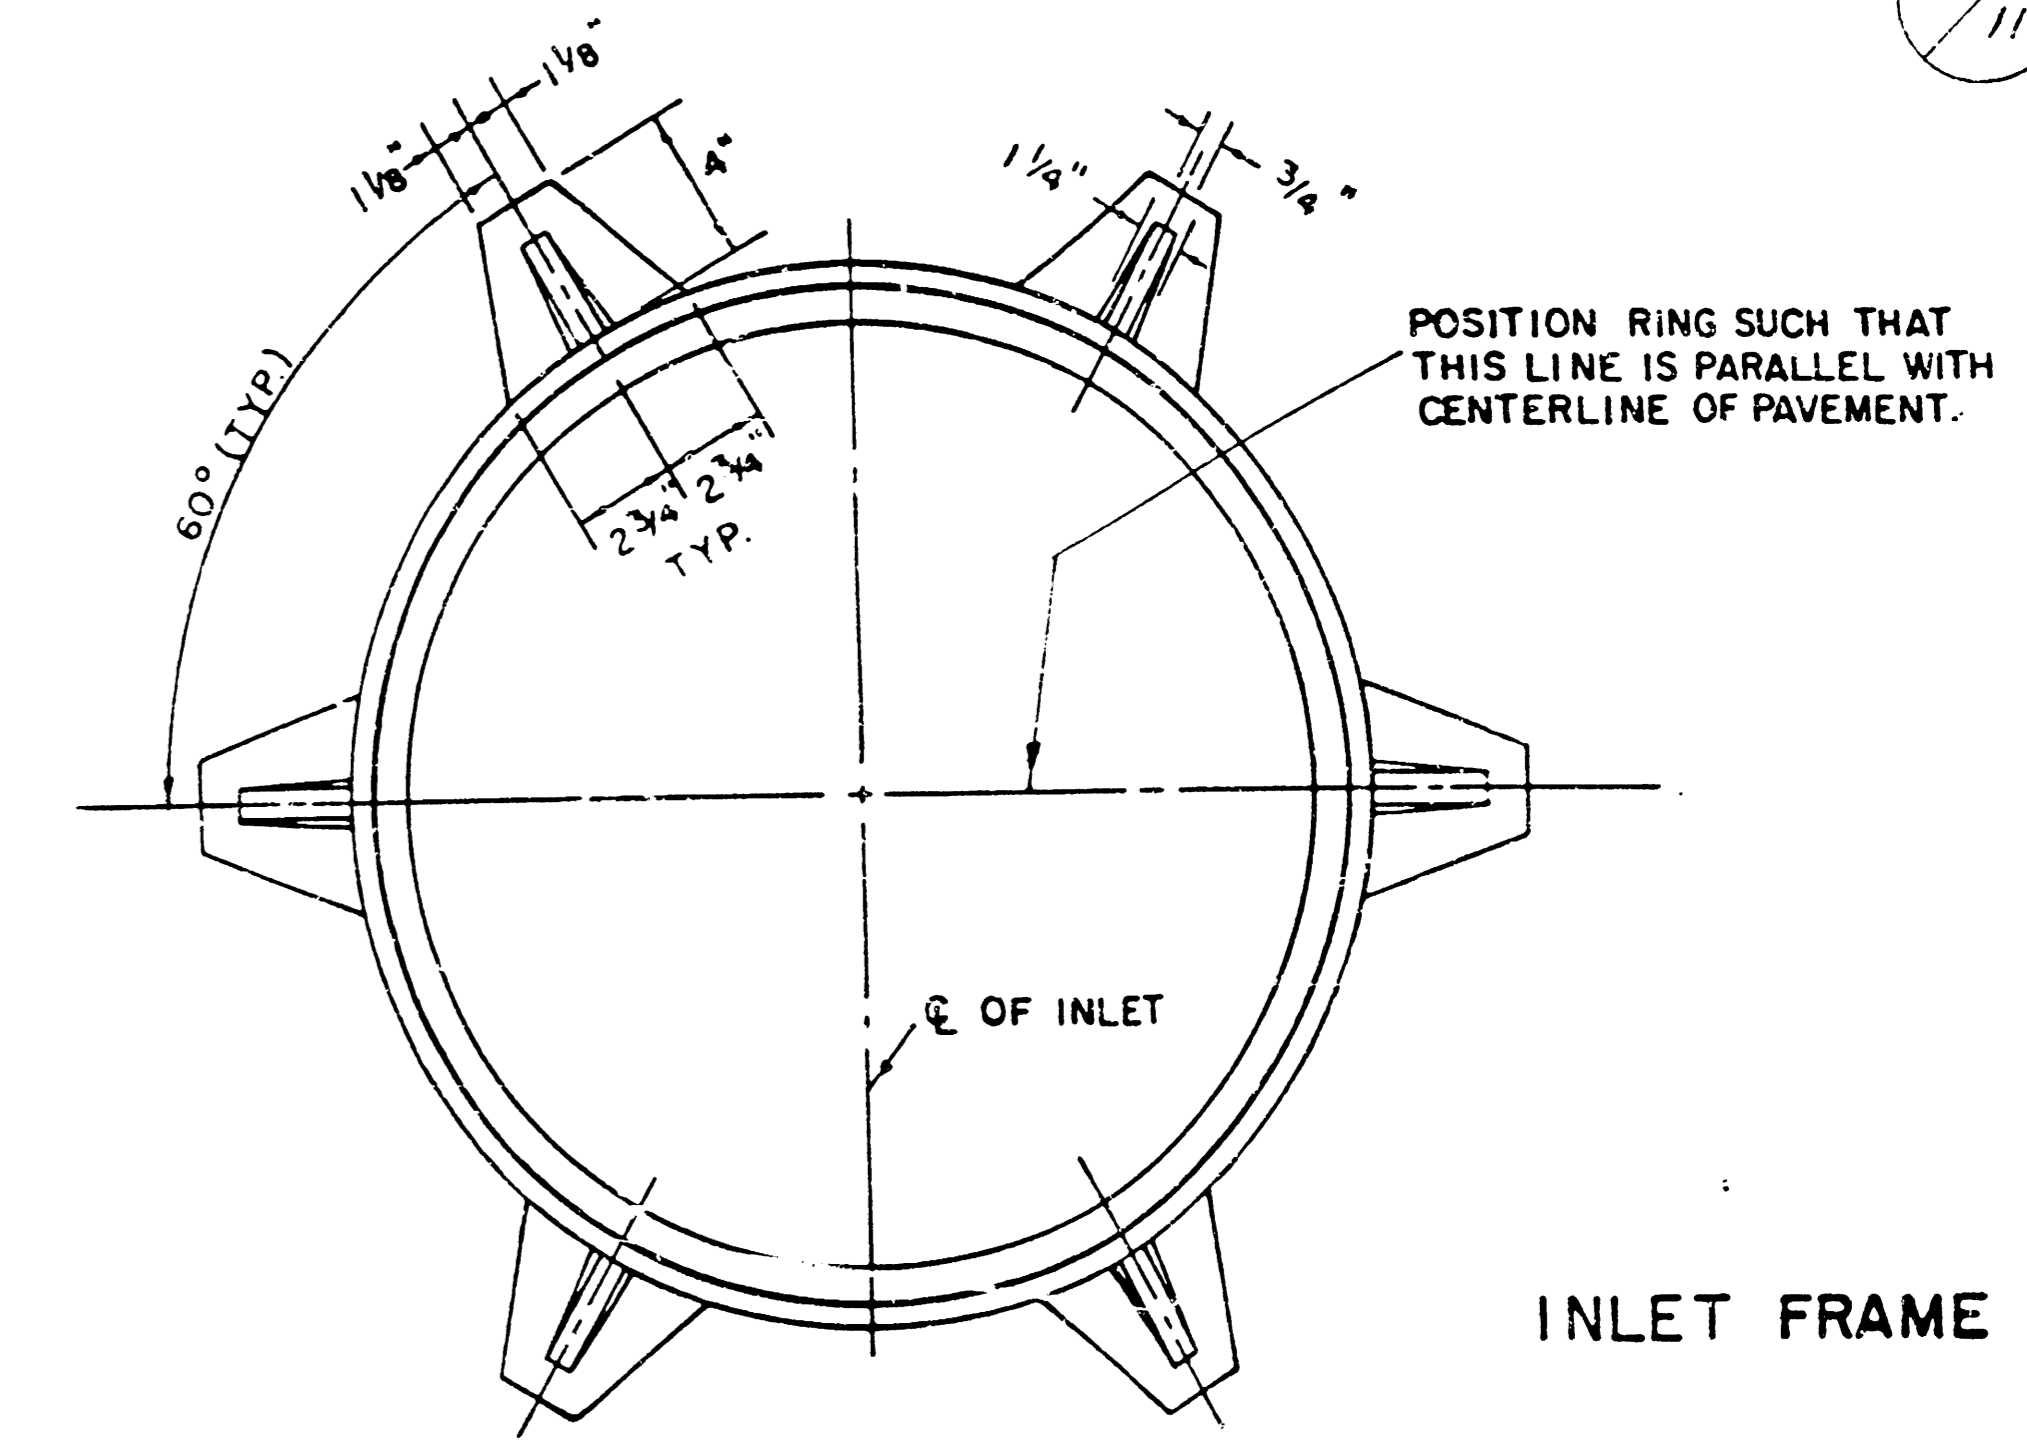

INLET FRAME

WEIGHT = 180 LBS.

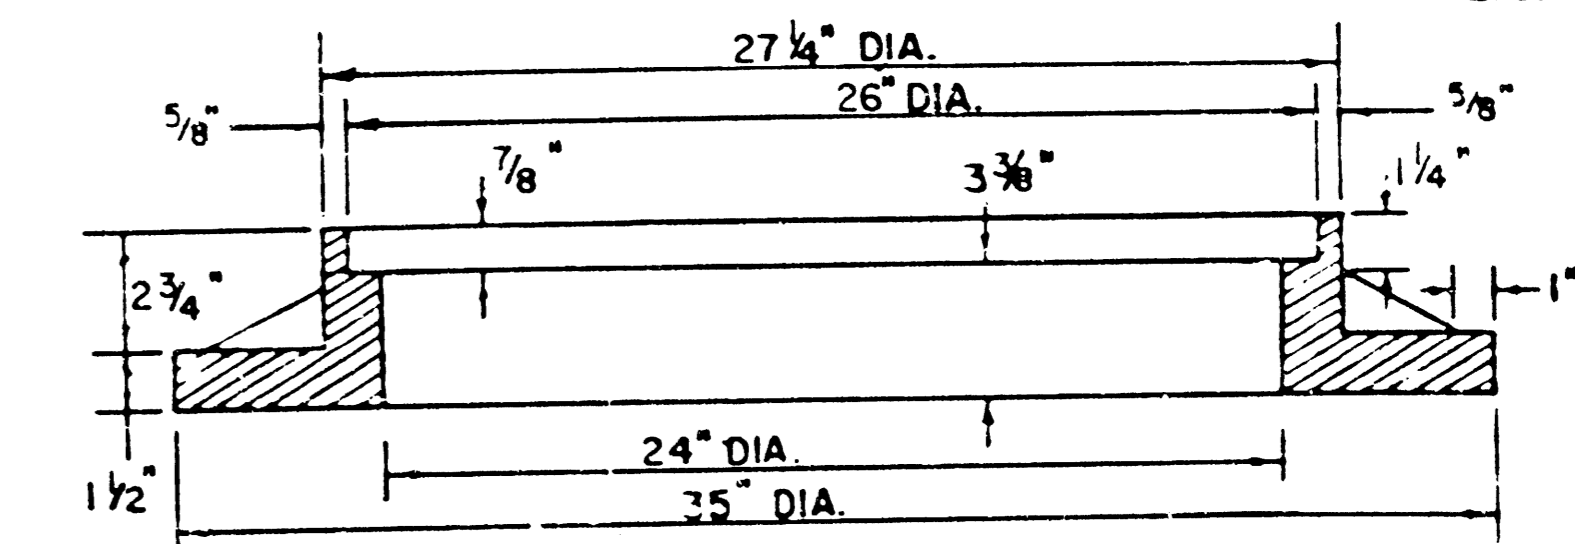

SEE CITY OF WICHITA STANDARD MANHOLE FRAME AND COVER DETAIL SHEET FOR COVER DETAILS TO BE USED WITH INLET FRAME.

STEEL SCHEDULE


BAR NUMBER	a1		a2		a3				b1		b2		b3		b4		WT. LBS.
	4	4	2	1	3	5	7	9	6	1	1	6	4	6	6		
SIZE	#4	#4	#4	#4	#4	#4	#4	#4	#4	#4	#4	#4	#4	#4	#4	#4	
W=4'4"	5'7"	6'7"	4'0"	6'1"	-	-	-	-	1'9"	6'2"	4'8"	60±					
W=5'4"	7'7"	8'7"	5'0"	6'1"	-	-	-	-	1'9"	6'2"	4'8"	81±					
W=6'4"	9'7"	10'7"	6'0"	6'1"	-	-	-	-	1'9"	6'2"	4'8"	101±					
W=7'4"	11'7"	12'7"	7'0"	6'1"	-	-	-	-	1'9"	6'2"	4'8"	121±					
W=8'4"	13'7"	14'7"	8'0"	6'1"	-	-	-	-	1'9"	6'2"	4'8"	141±					

\* NOTE: a3 BARS TO BE PLACED APPROX. 2" BELOW TOP OF INLET COVER


BENDING DIAGRAM

STANDARD CURB INLET PRECAST TOPS

W	PRE-CAST TOP SIZE	PIPE SIZE	CU. YD. CONC.
4' 4"	3' 8" x 6' 4" x 7 1/2"	21" & SMALLER	0.38 ±
5' 4"	4' 8" x 6' 4" x 7 1/2"	24" & 30"	0.51 ±
6' 4"	5' 8" x 6' 4" x 7 1/2"	36" & 42"	0.64 ±
7' 4"	6' 8" x 6' 4" x 7 1/2"	48" & 54"	0.77 ±
8' 4"	7' 8" x 6' 4" x 7 1/2"	60" & 66"	0.90 ±

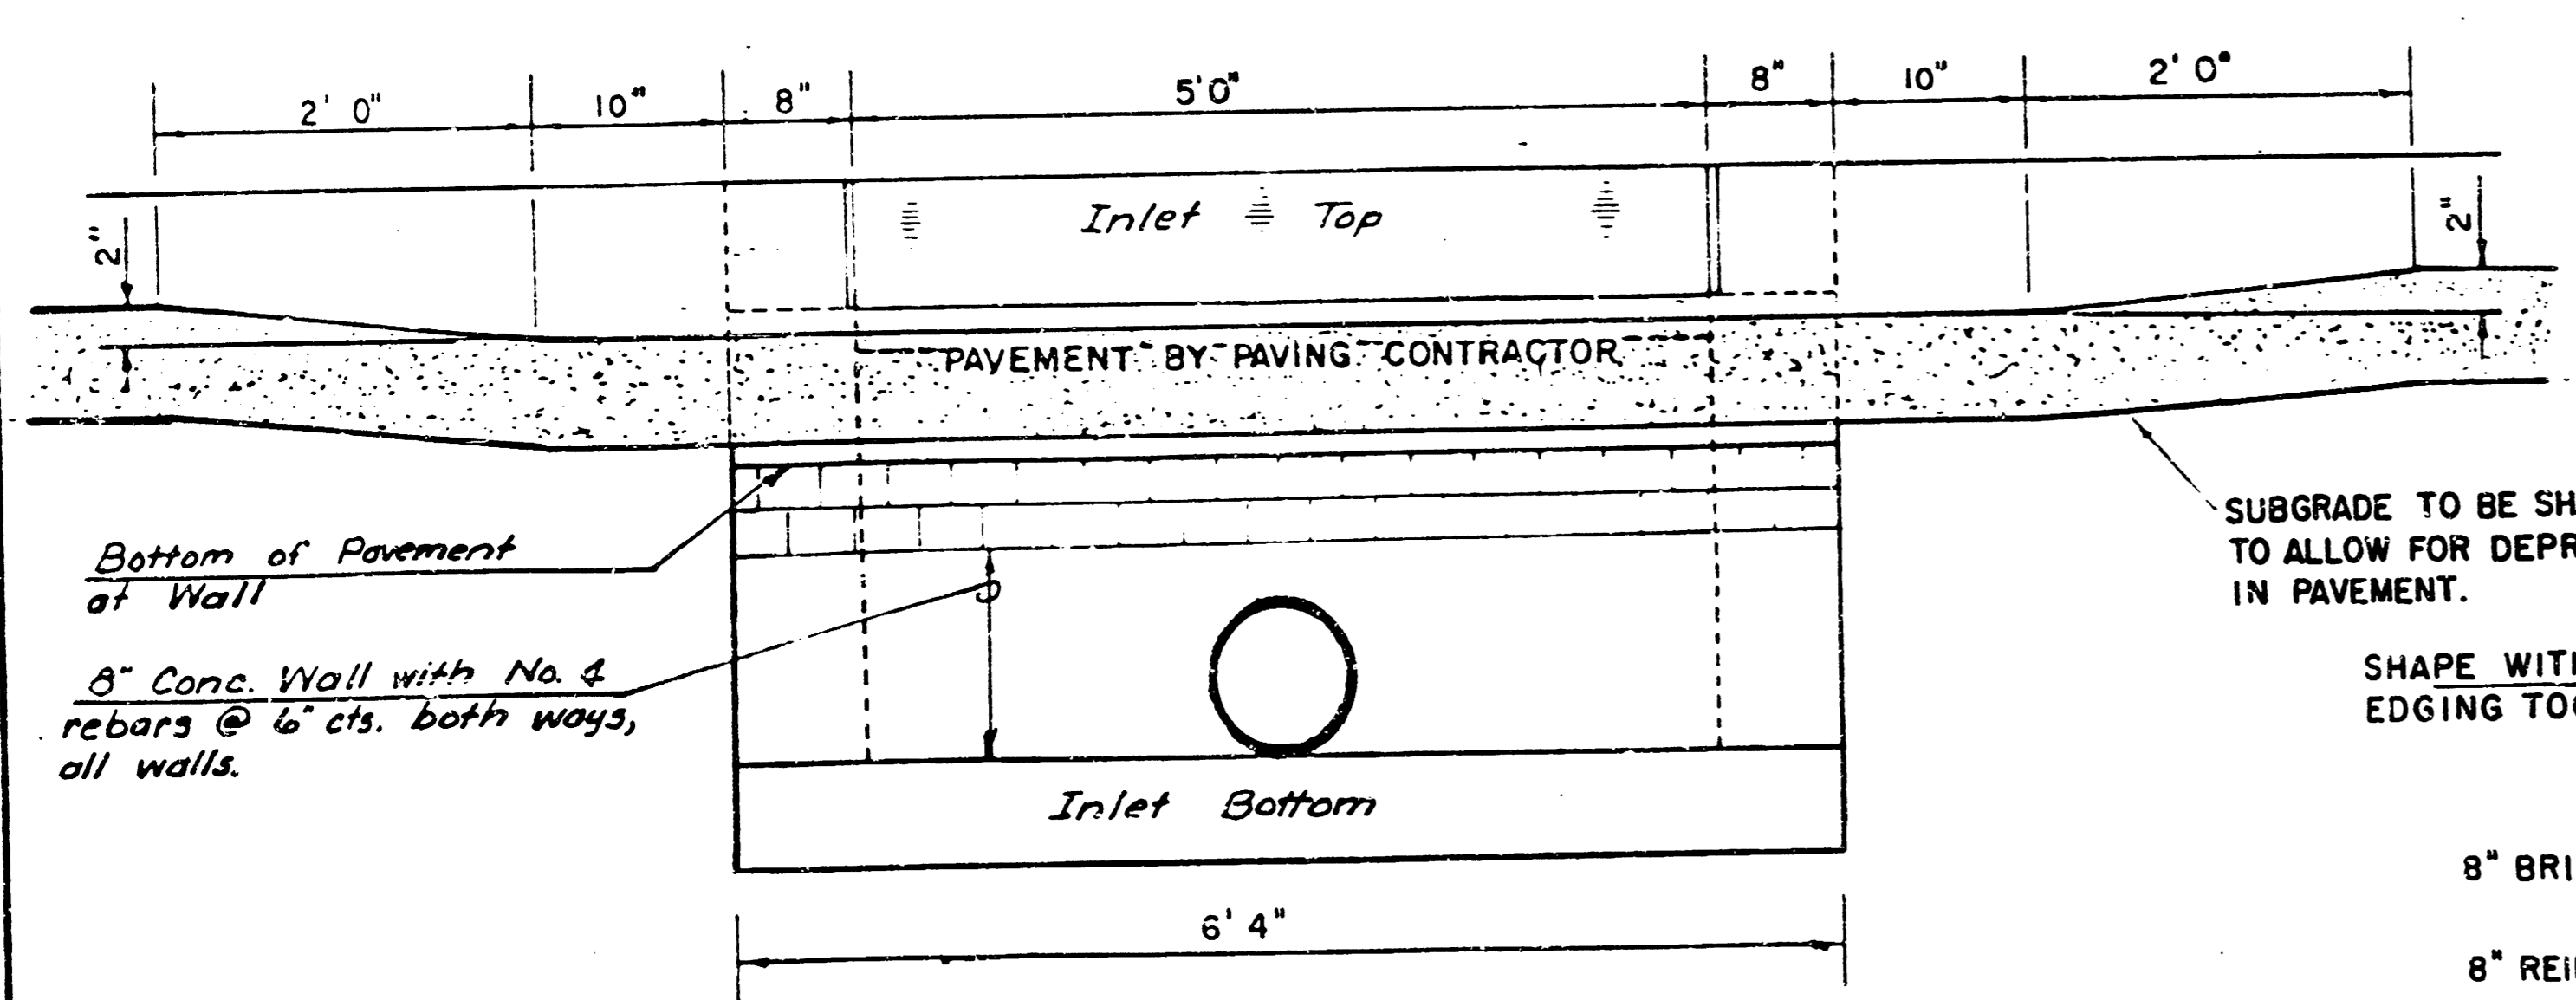

SECTION C-C

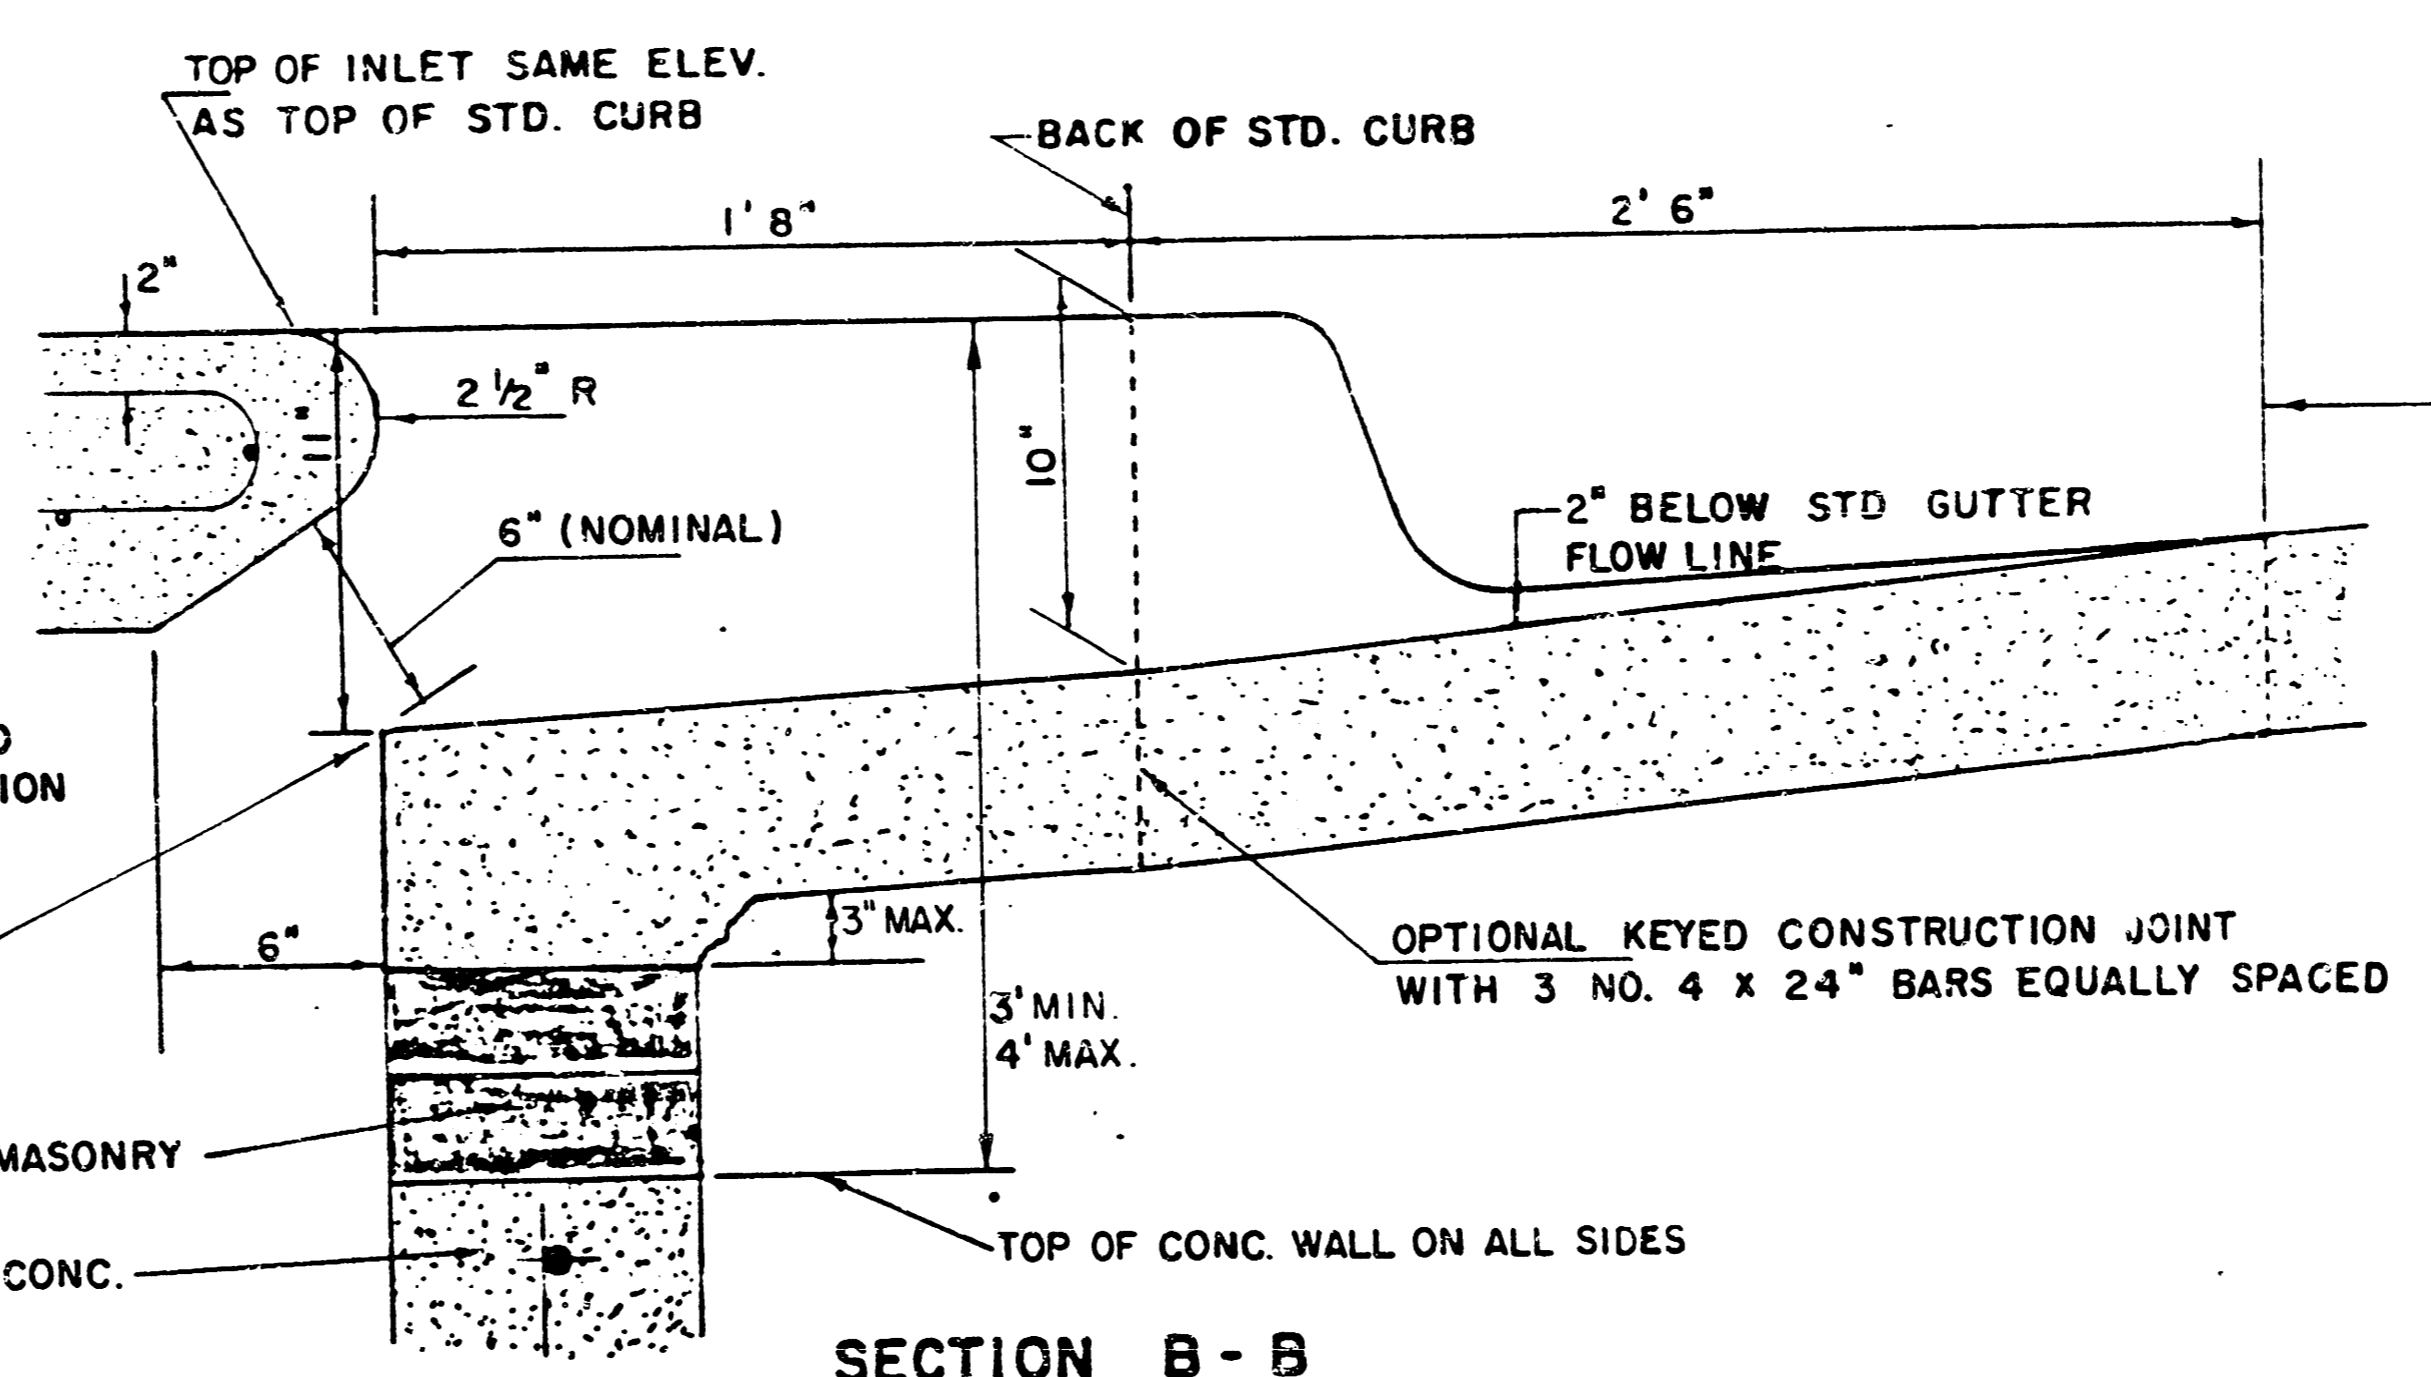

SECTION B-B

LIMITS OF GUTTER SHAPING AND/OR EDGE OF COMB. CURB AND GUTTER




NOTE: INLETS AND INLET LEADS ARE SHOWN FOR INFORMATION ONLY AND ARE NOT A PART OF THIS PROJECT. CONTRACTOR SHALL INSTALL ONE-4" JOINT OF PIPE IN THE MANHOLES TO FACILITATE FUTURE CONSTRUCTION.

DETAIL STANDARD TYPE IA CURB INLET  
CITY OF WICHITA, KANSAS  
INLET OPENING = 6" x 5' 0"  
JUNE 1984




FILMED FROM THE BEST AVAILABLE COPY



10/11

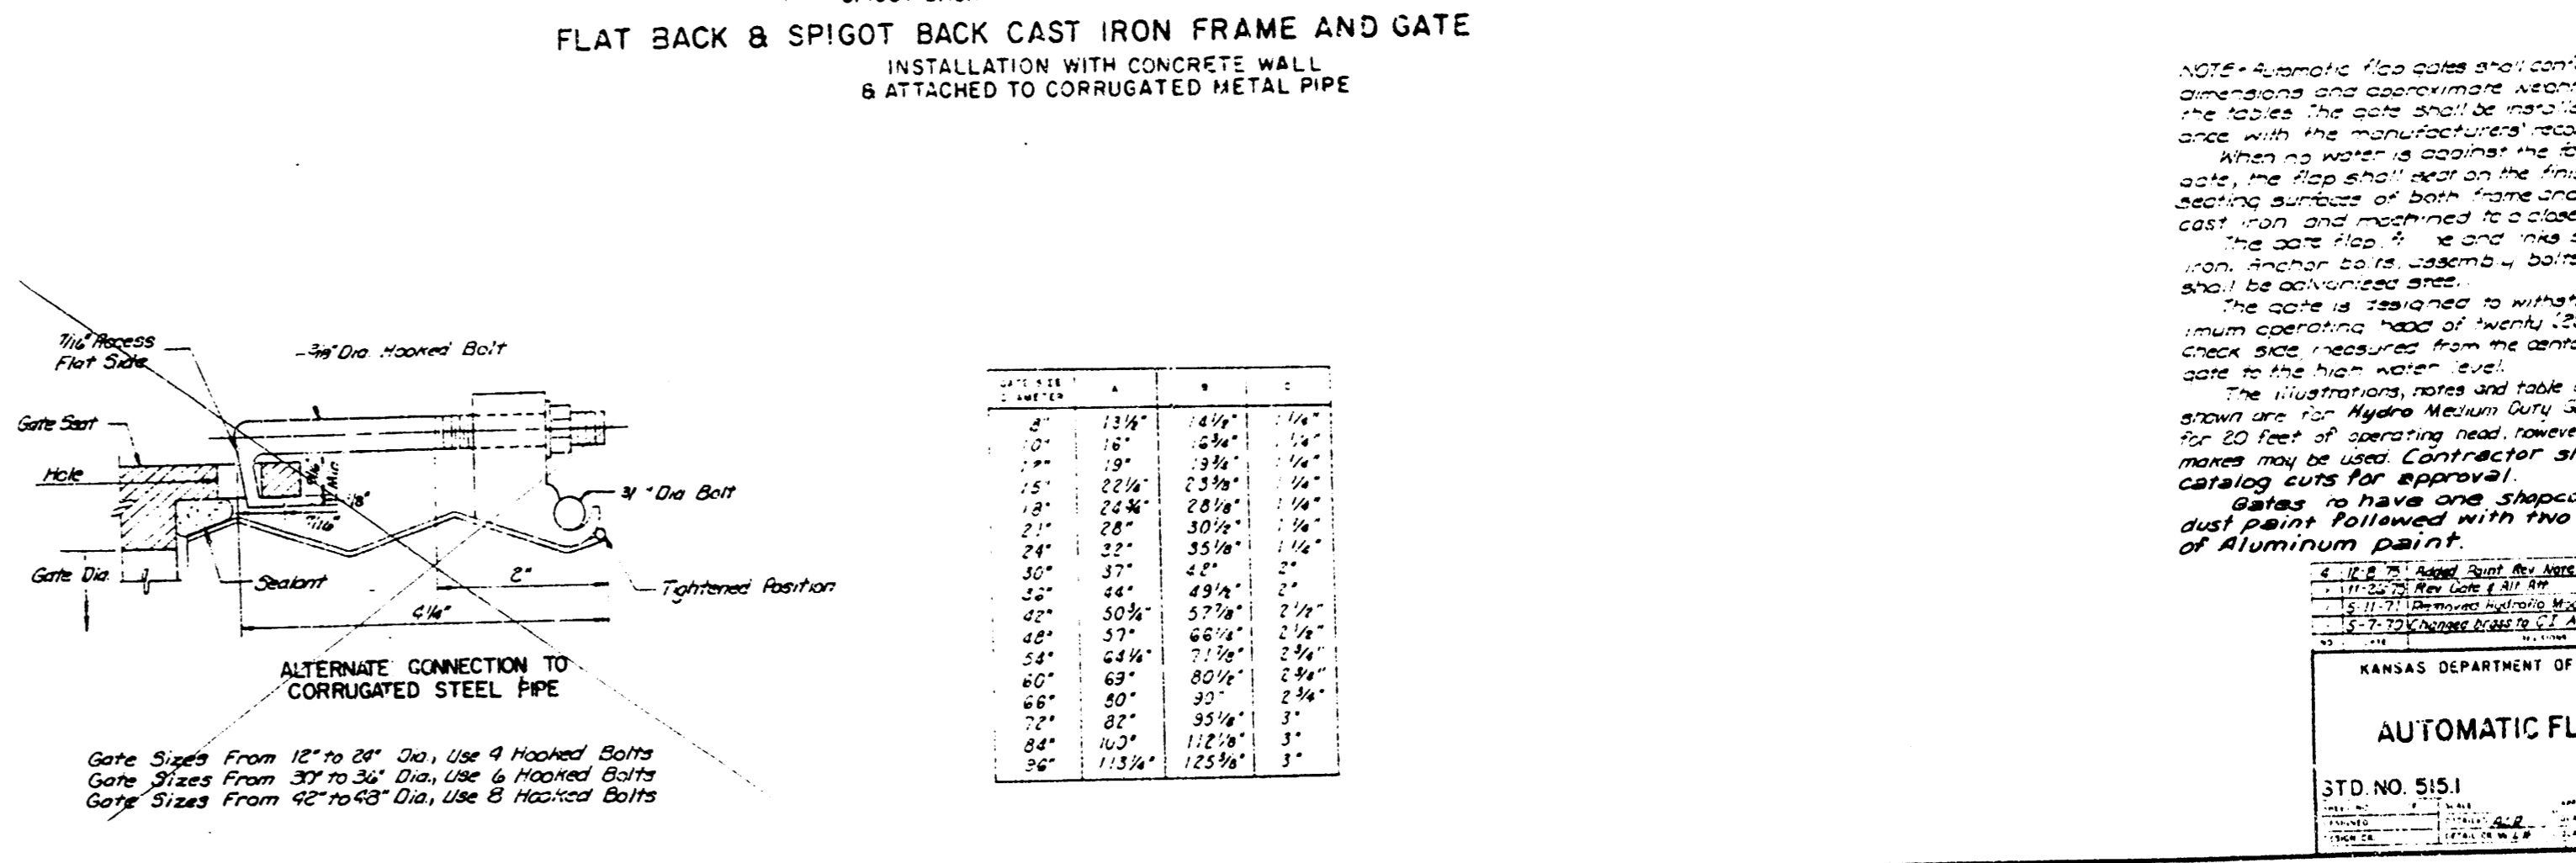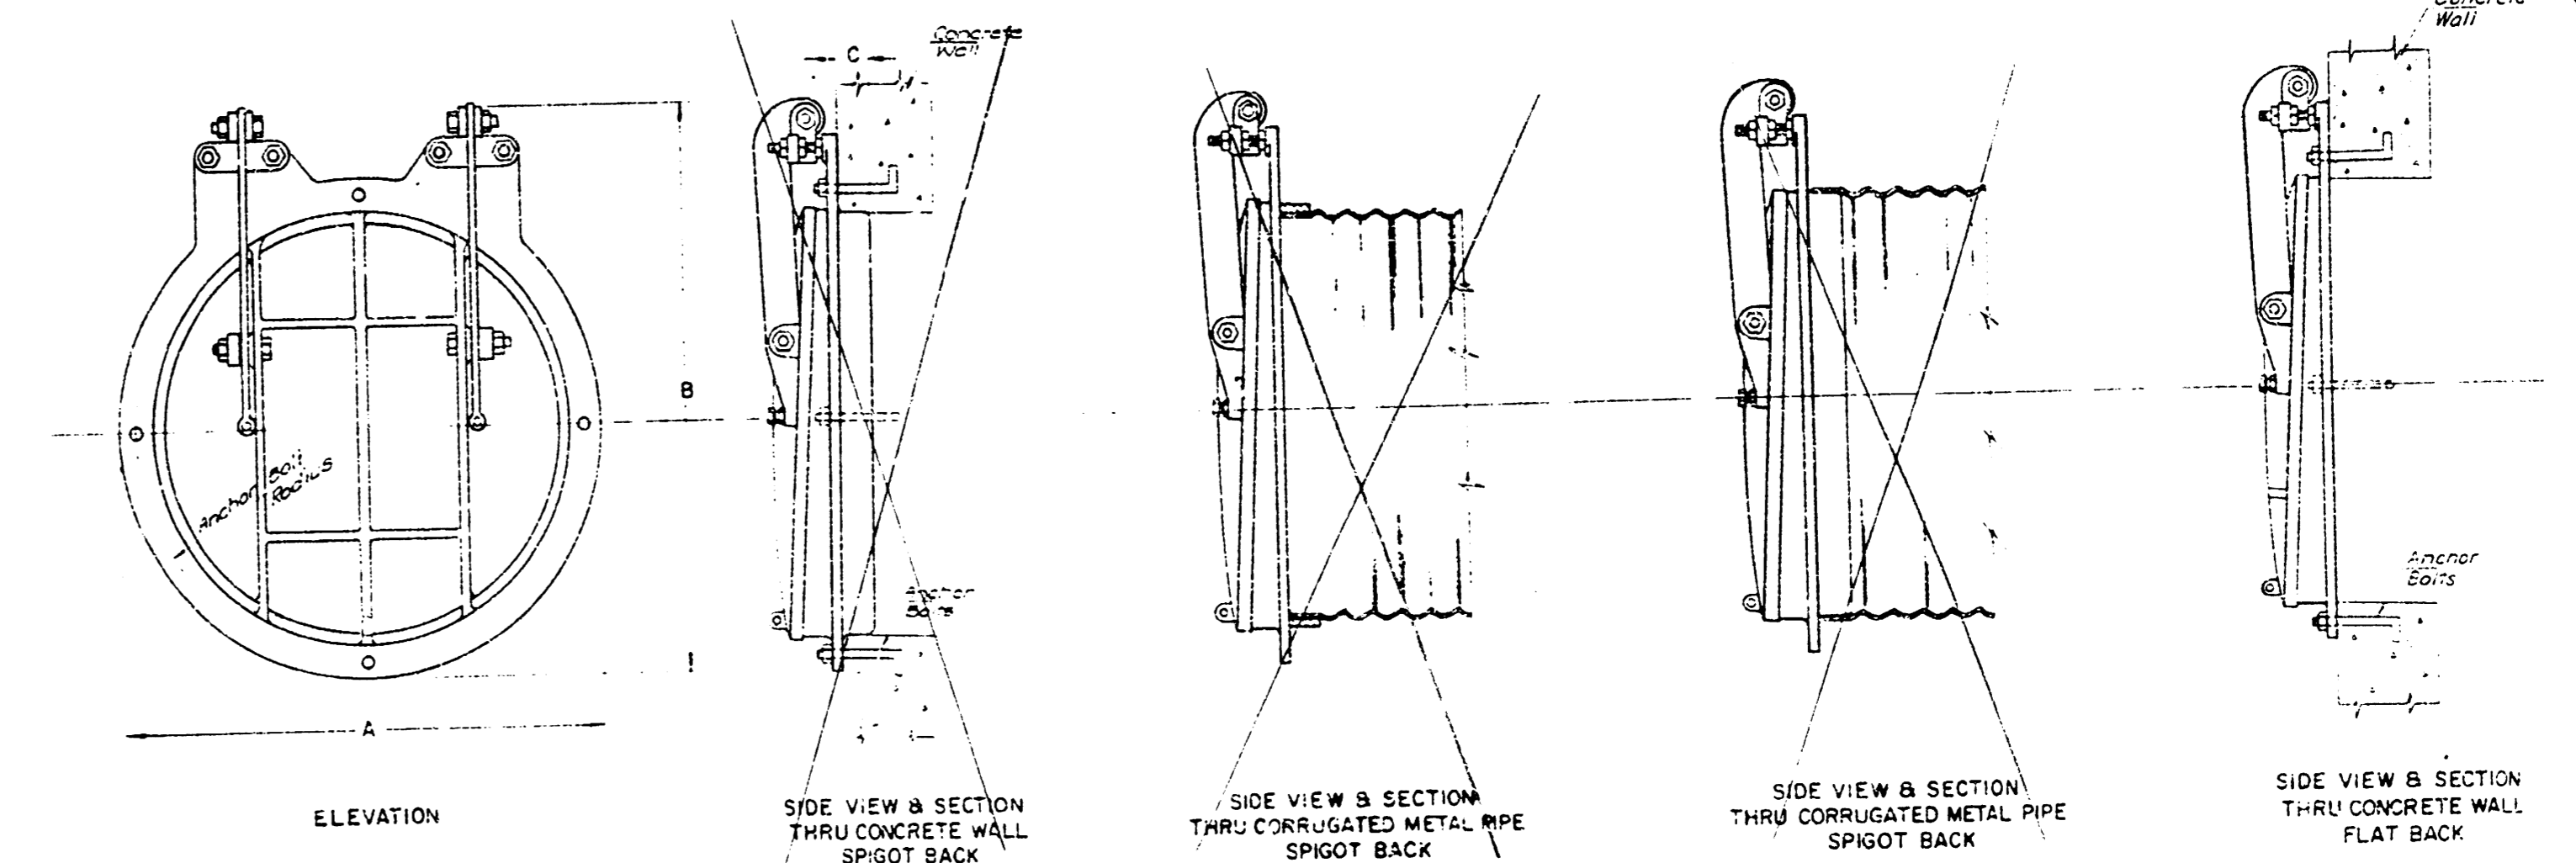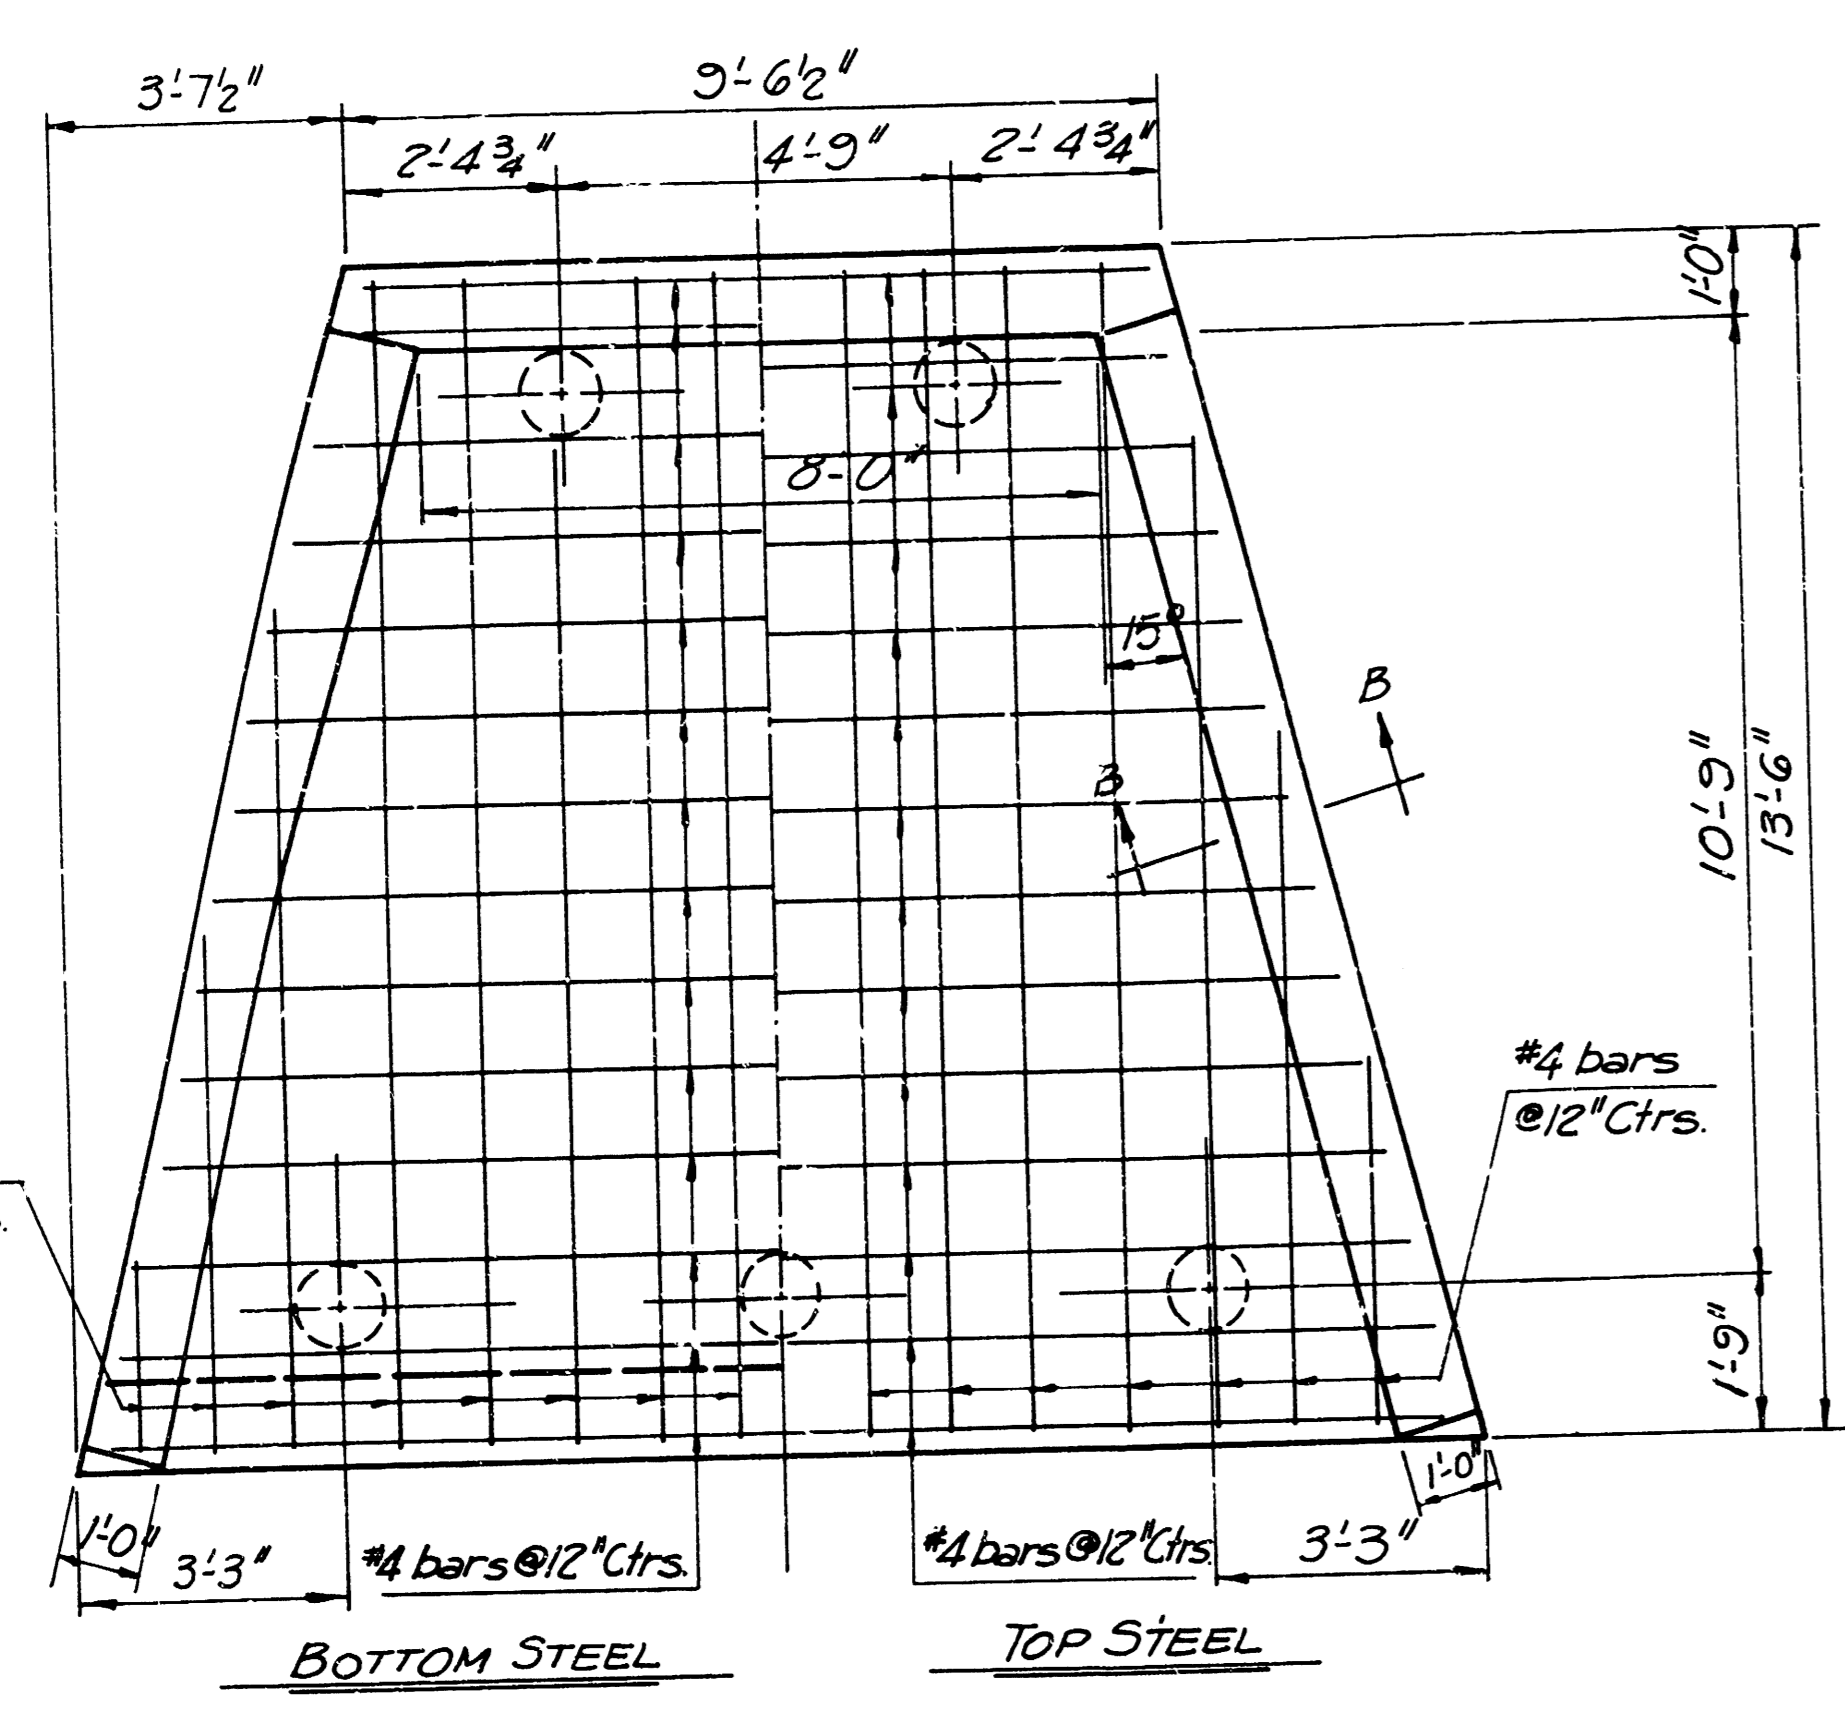

APP. CKD. FR. DR. DES. PLOT. SURV.

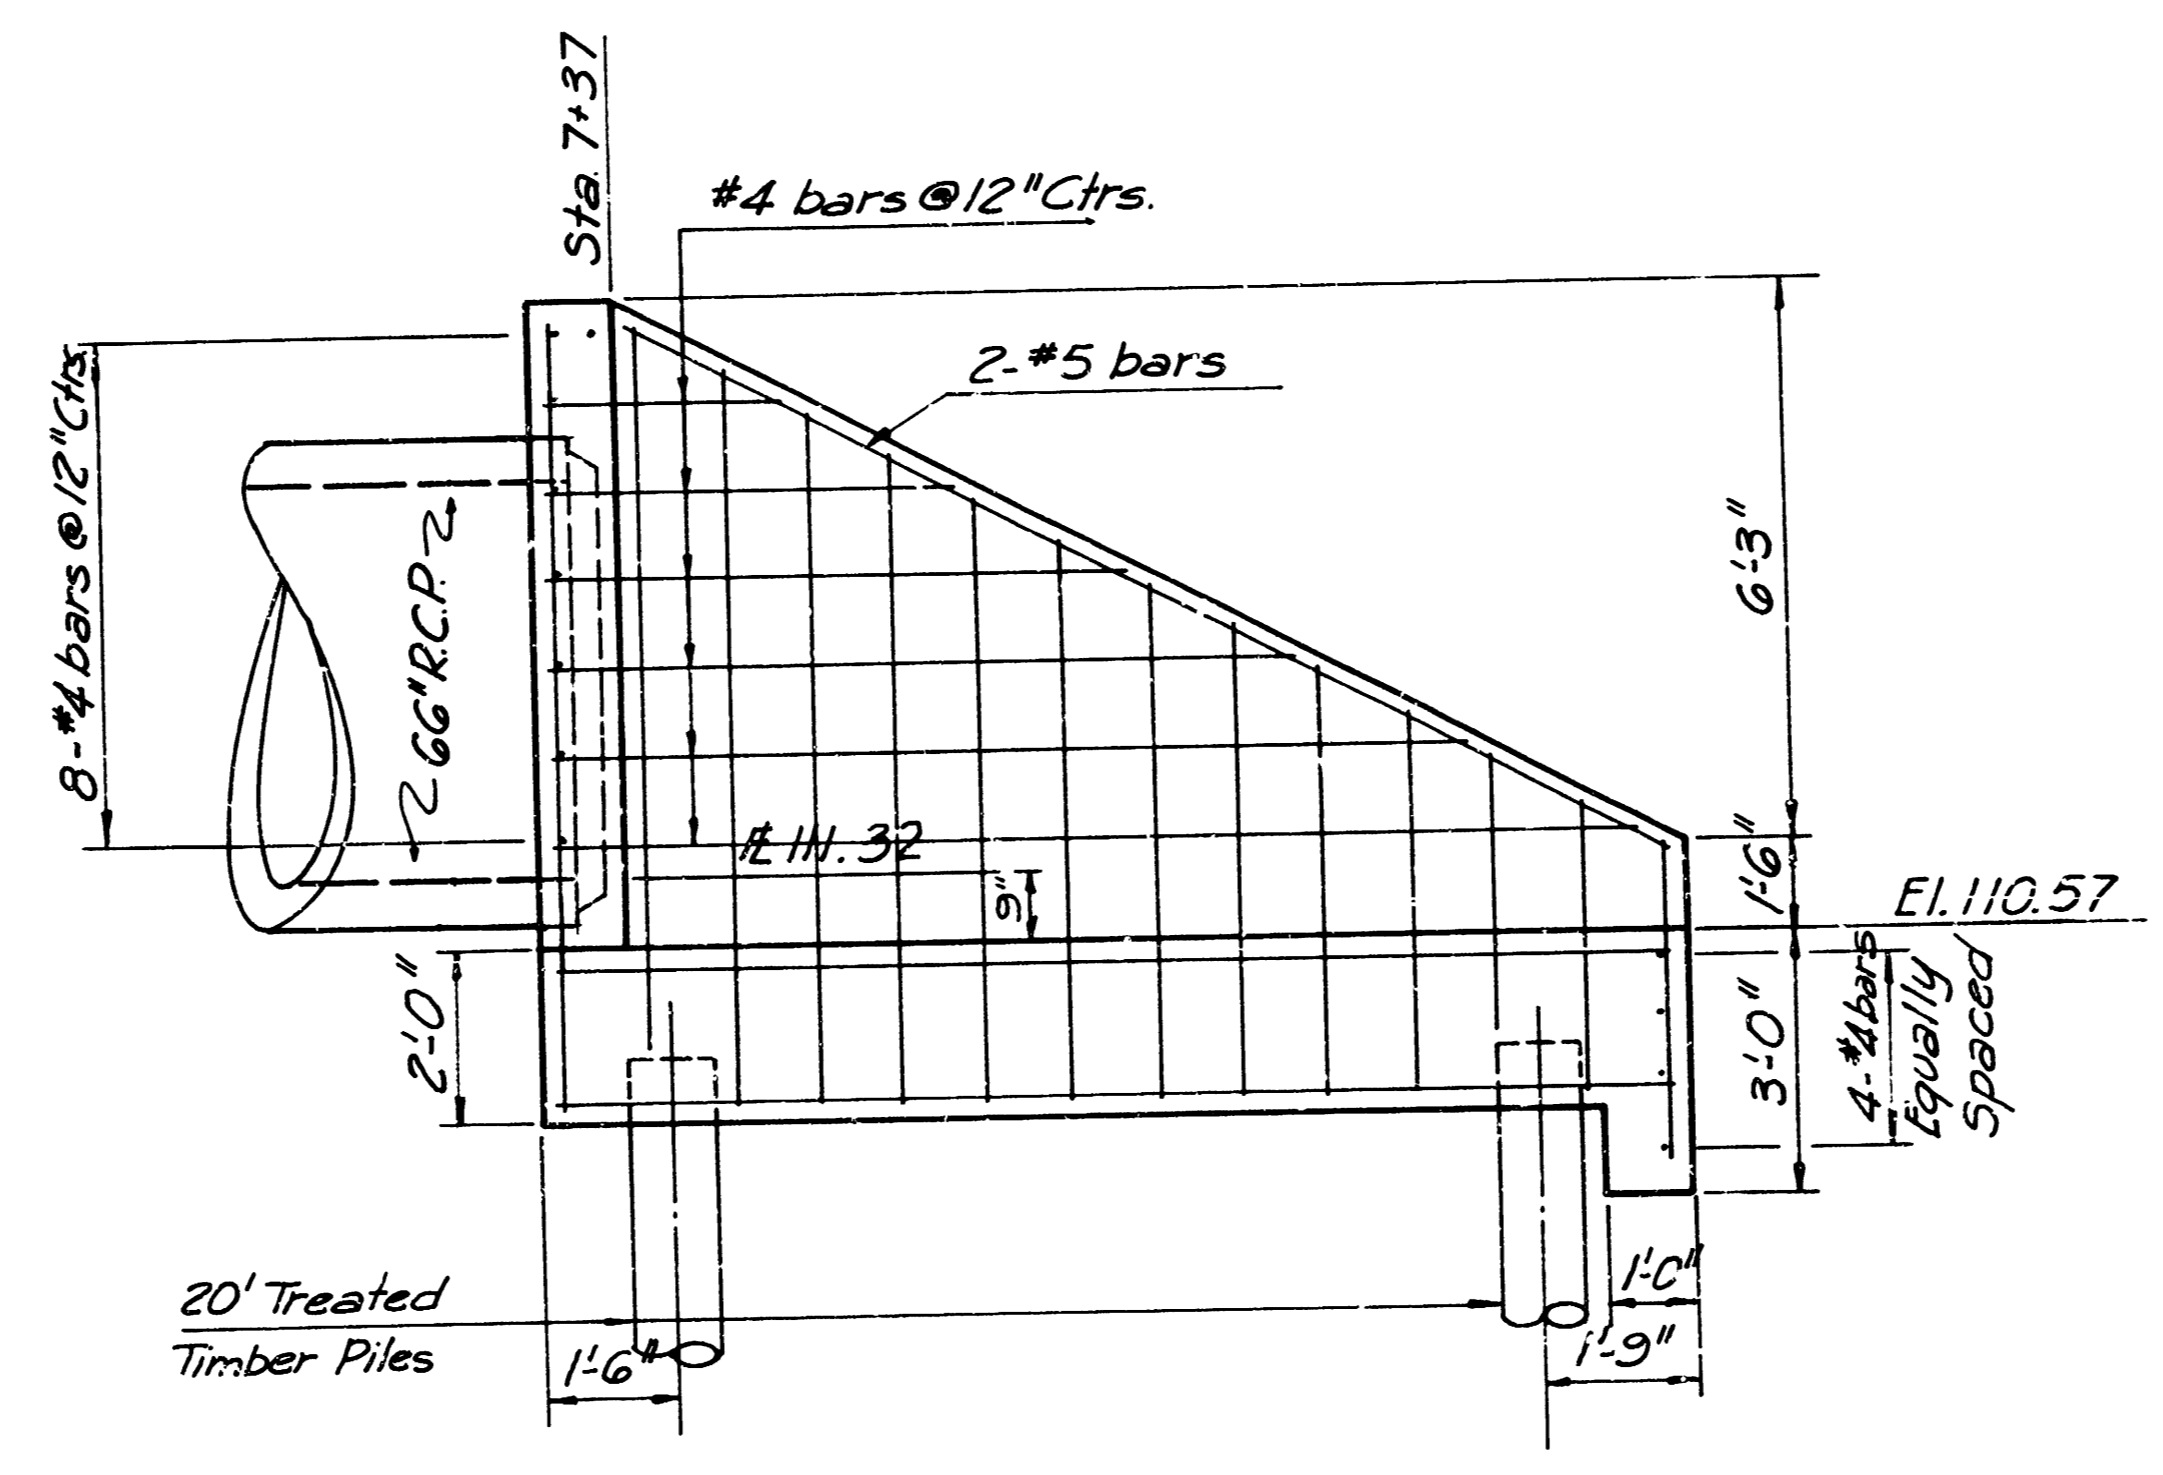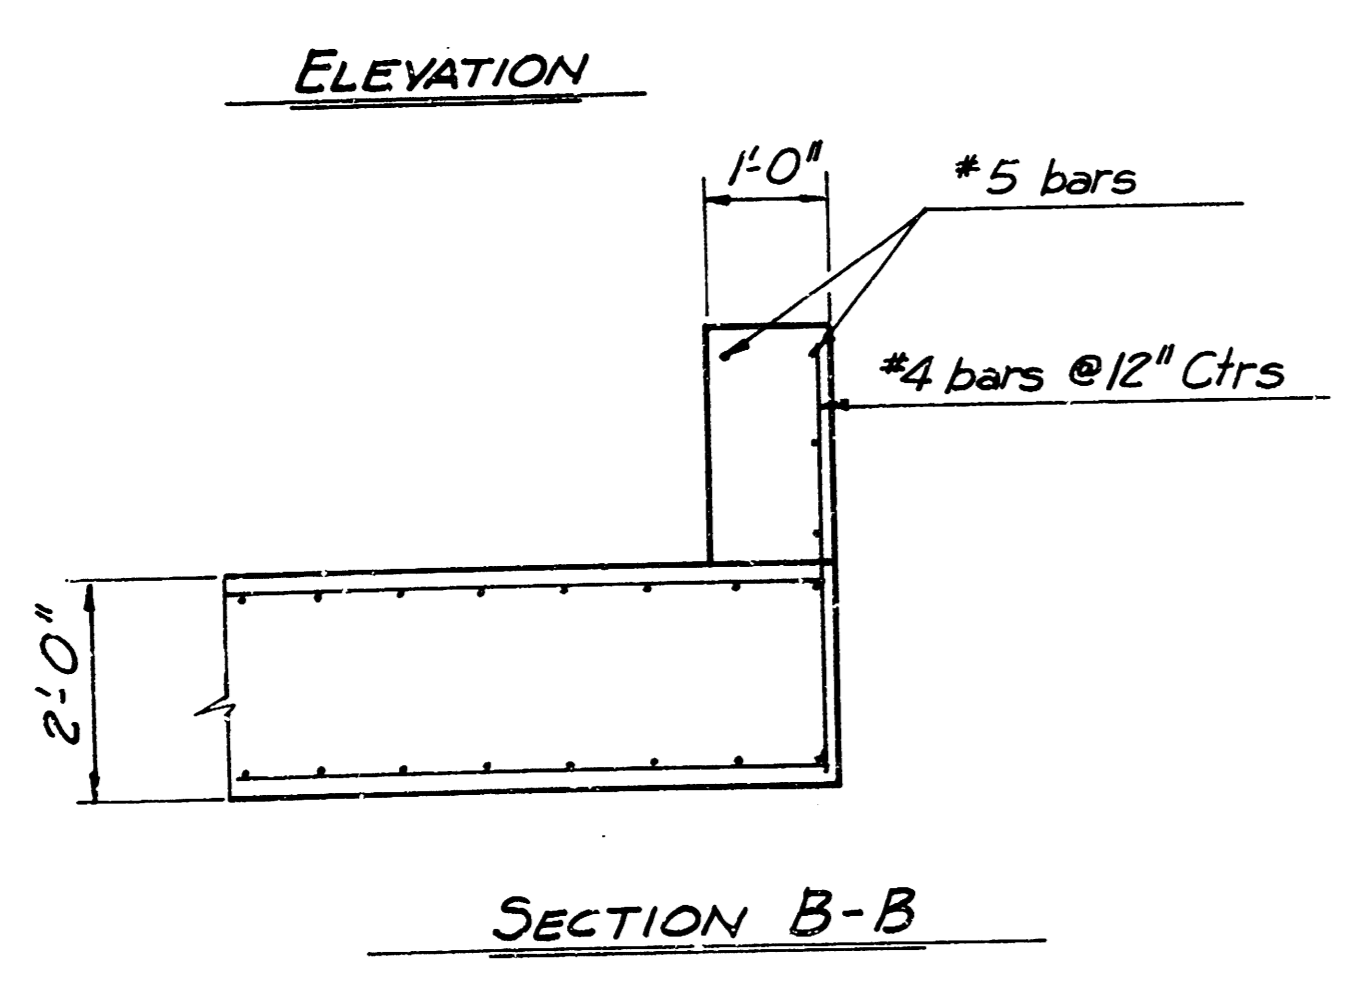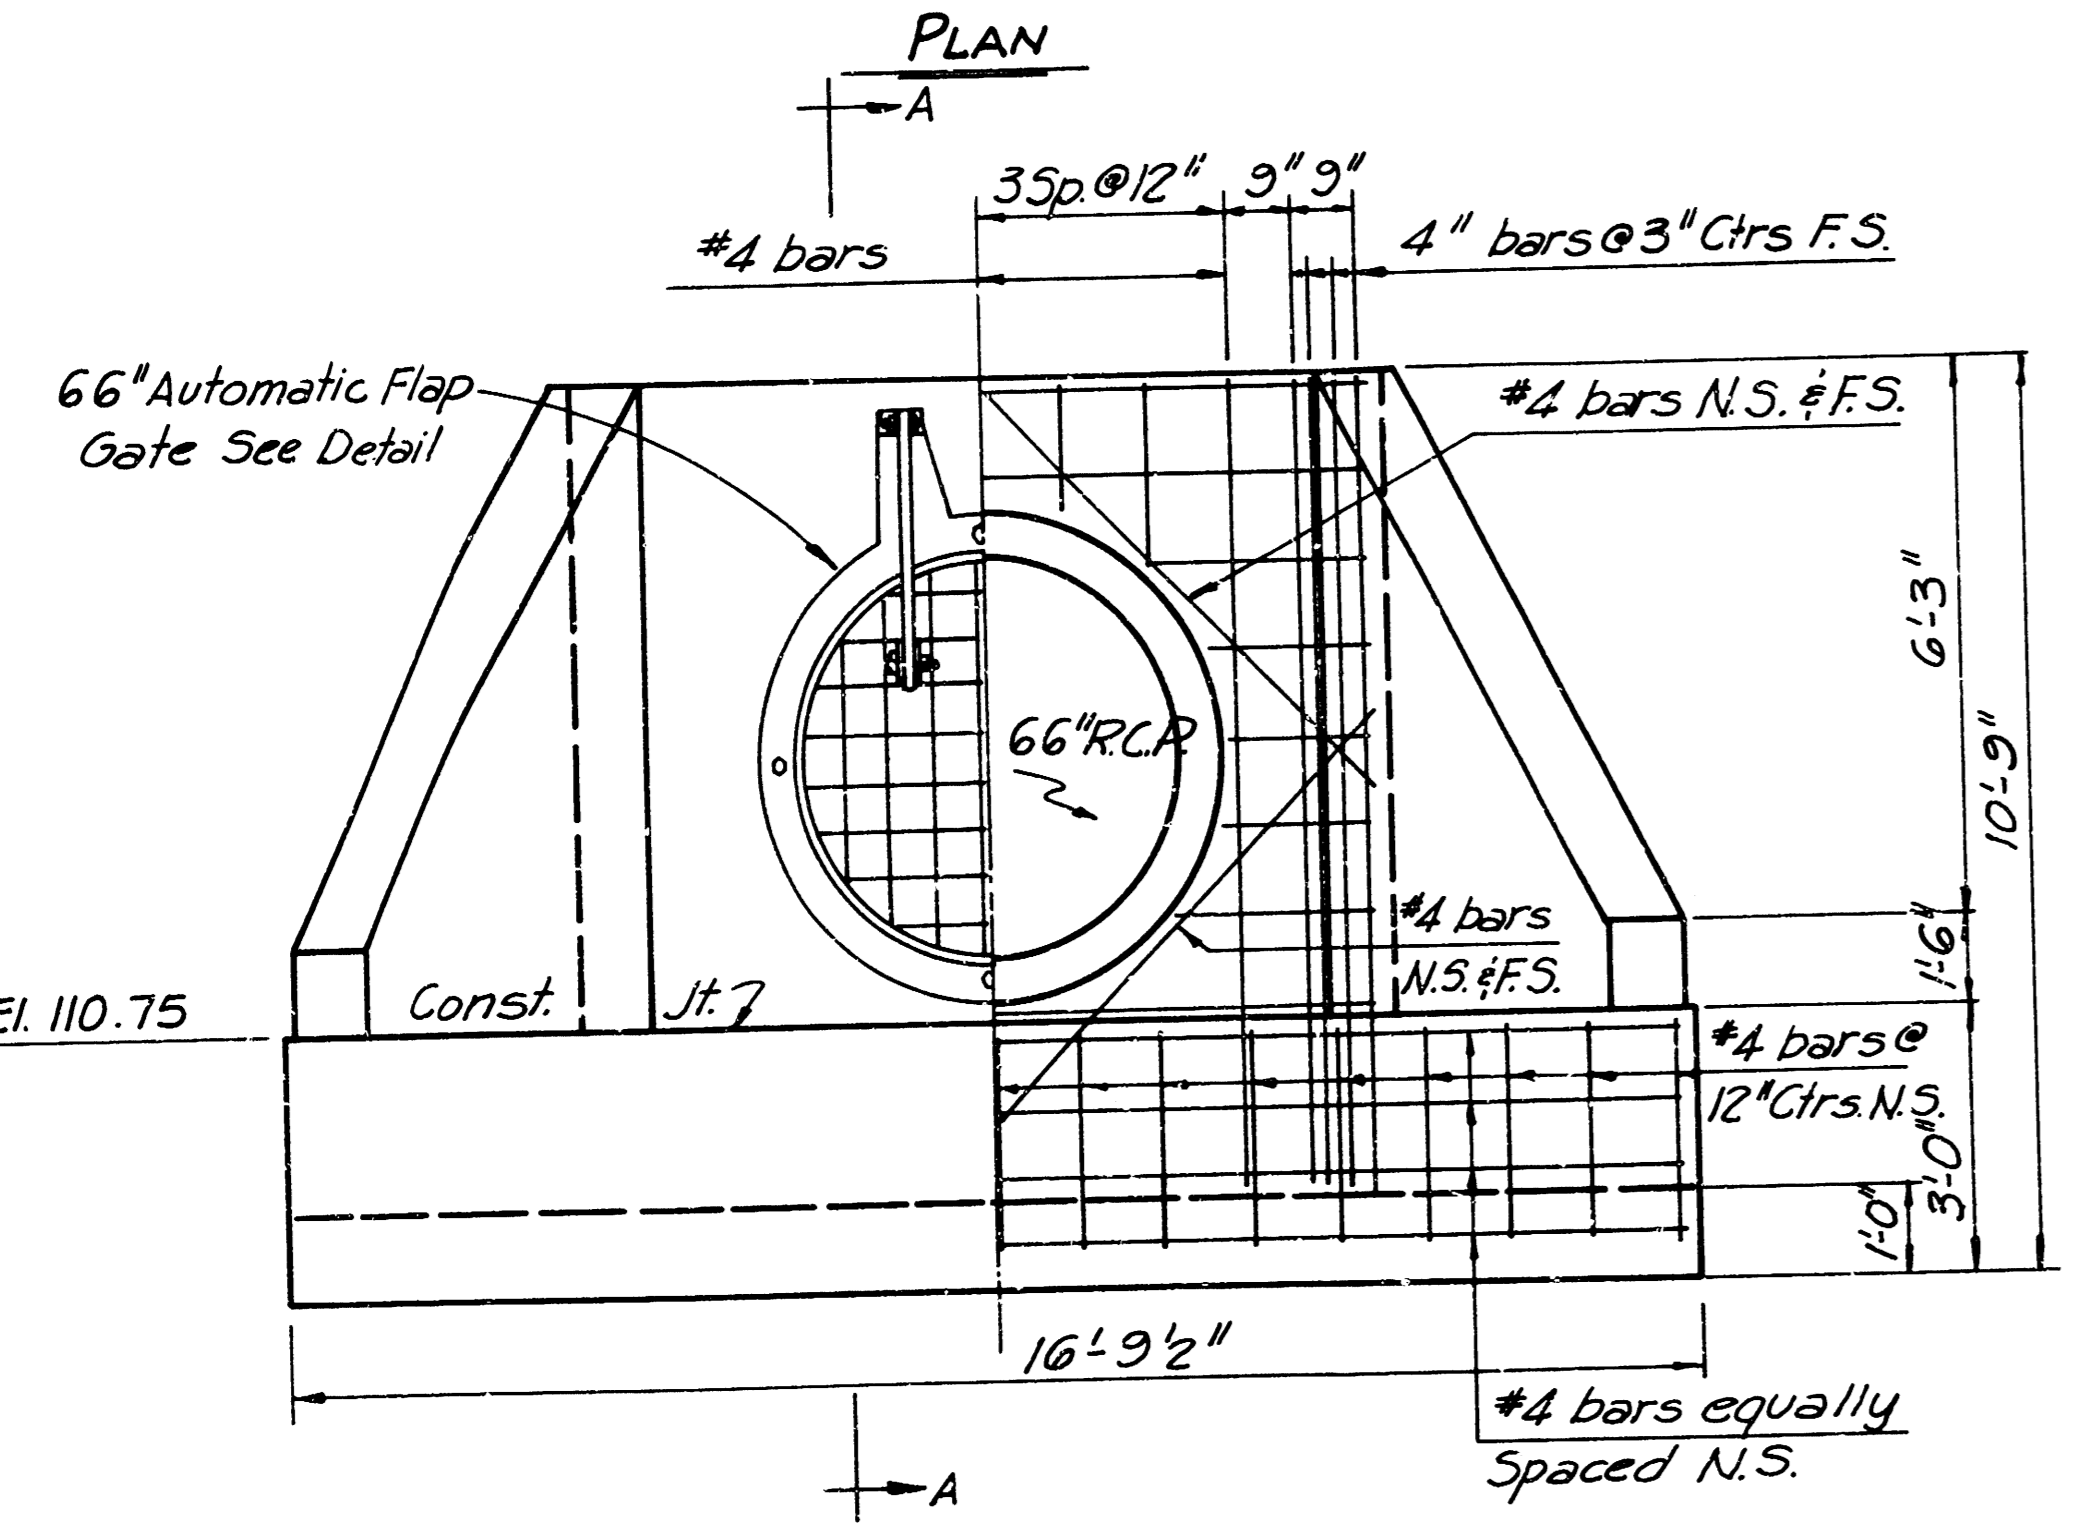

NOTE:  
City Concrete Pavement Mix (5.6 Sack) shall be used throughout. Bevel all exposed edges with 3/4" triangular mousing.  
All dimensions are to centerline of bar unless otherwise noted.  
Concrete and reinforcing steel will not be paid for directly, but shall be subsidiary to the item "Concrete Headwall Structure."

CITY OF WICHITA  
MAPLE STREET  
CONCRETE HEADWALL  
AND FLAP GATE  
CITY OF WICHITA PROJ. NO. 468-76-245-8137-000-000-001

**Booker/Freund** 15/16  
Engineers Architects Planners

SCALE DATE Nov. 1984 DWG. NO. K-9130

FILMED FROM THE BEST AVAILABLE COPY.....

