

PLAN LINE 1


AS-BUILT SEPTEMBER 2007

= PAVEMENT REMOVE & REPLACE (MATCH EXIST.)
 = TREE REMOVAL

FIRE HYDRANT
 BURY LINE=1374.3
 VALVE BOX=1375.60
 BURY LINE=1373.71 AB
 VALVE BOX=1373.88 AB

PROFILE LINE 1

SCALE: HORIZ. 1"=40'
 SCALE: VERT. 1"=5'

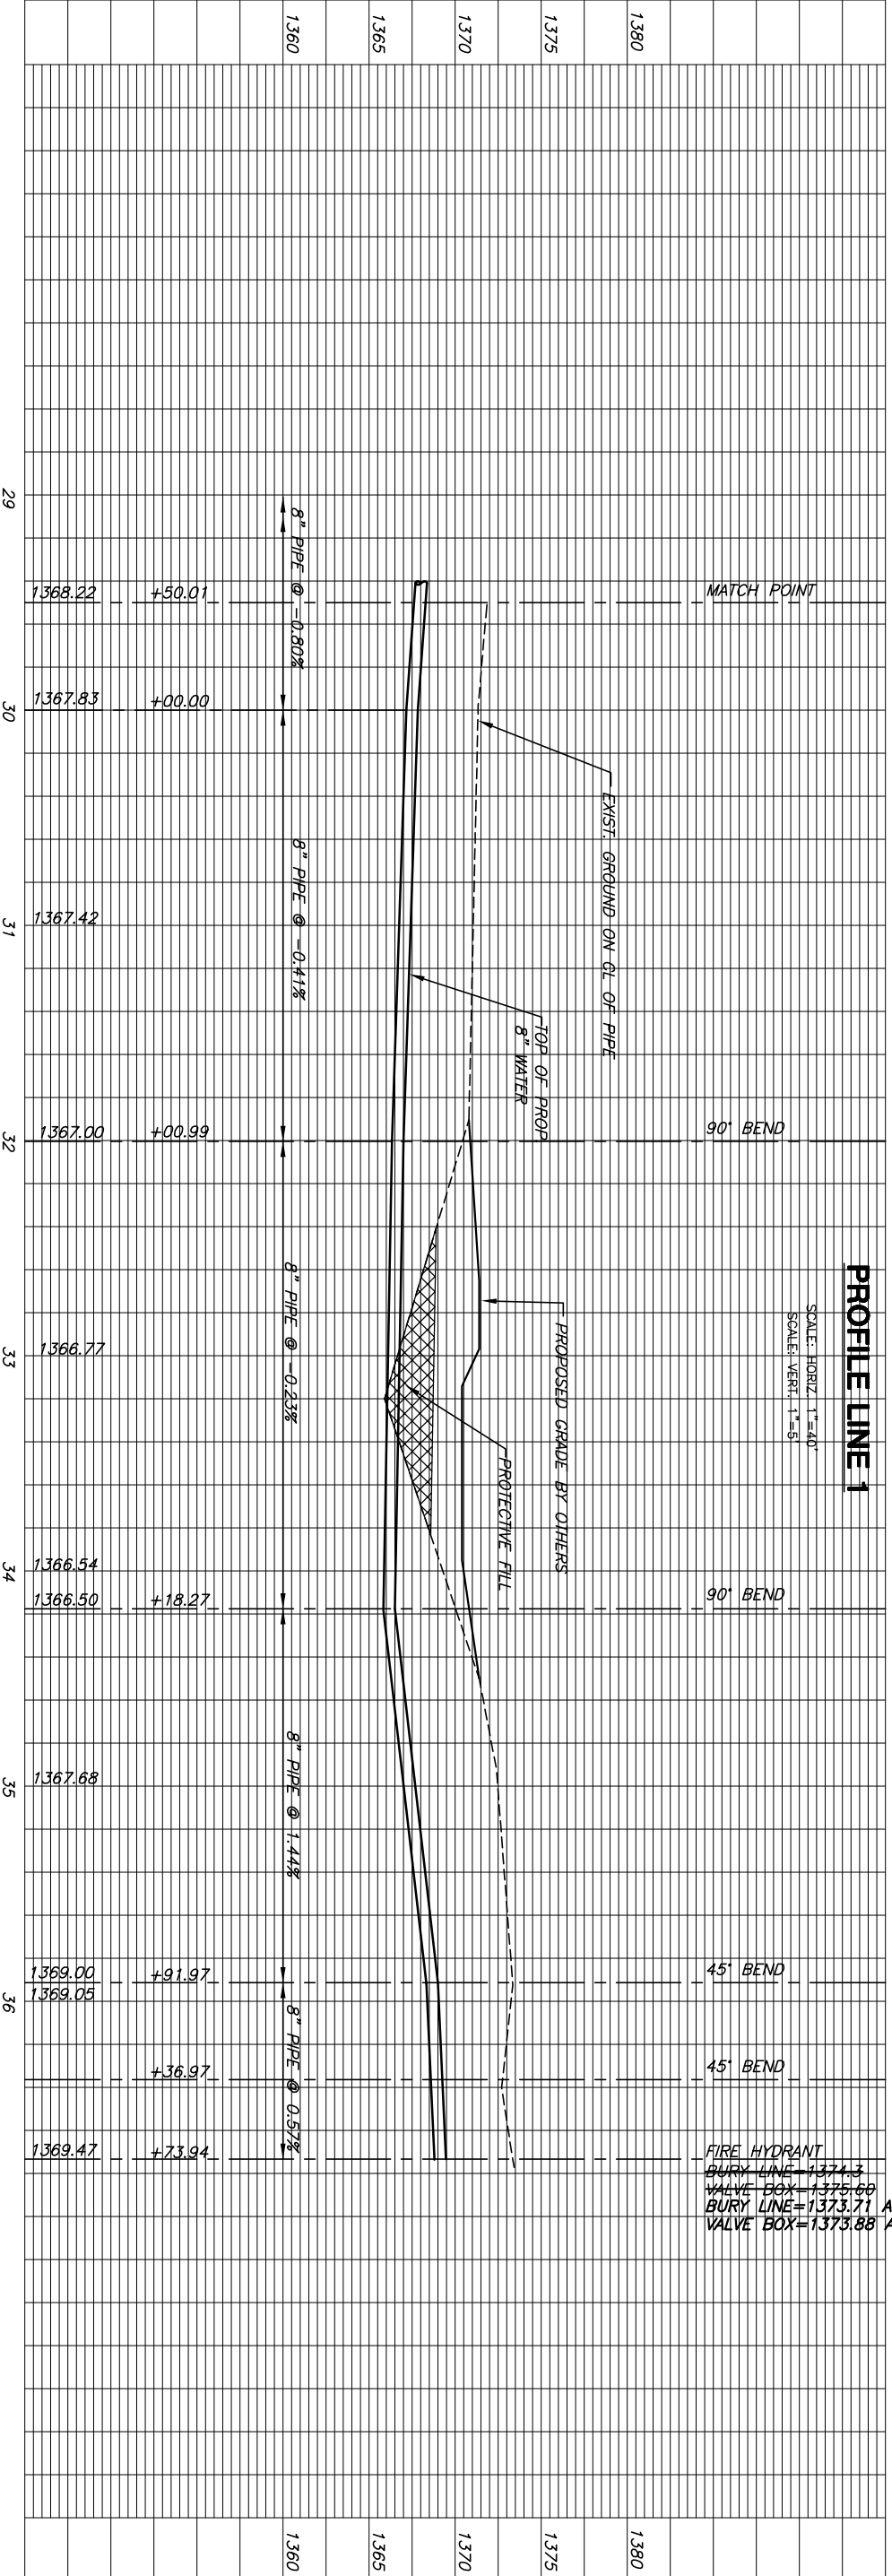

<p>WICHITA COUNTRY CLUB SECOND ADDITION</p> <p>WATER PLANS</p>	
<p>PLAN & PROFILE LINE 1</p> <p>SHEET TITLE 07038</p> <p>PROJECT NUMBER</p>	<p>DESIGN BY MMB</p> <p>DRAWN BY DM</p> <p>CHECKED BY GJA</p>
<p>ISSUED June 2007</p> <p>REVISED</p>	<p>SHEET NO. 5 of 15</p>

MKEEC
 ENGINEERING
 CONSULTANTS, INC.
 411 N. WEBB ROAD
 WICHITA, KS 67208
 316-684-9600