

SANITARY SEWER COLLECTION SYSTEM IMPROVEMENTS

MAIN 5 OF THE NW INTERCEPTOR SEWER - PHASE 2

Wildcat Construction Co., Inc. - Contractor
 Koleczek/Shearer, City - Inspectors
 Released 7/3/07
 As-Built
 Risers
 .pdf by JDL 10/19/07

INDEX


Title Sheet	1
Keysheet	2
Notepage	3
Line 1 Plan/Profile Sheets	4
Line 2 Plan/Profile Sheets	5-6
Lines 3 & 4 Plan/Profile Sheets	7
Force Main Plan/Profile Sheets	8-9
Lift Station Site Plan & Detail	10
Lift Station Electrical Plans	11-12
Lift Station & Forcemain Details	13-14
Standard Manhole Detail	15
Ring and Cover Detail	16
Erosion Control Details	17-19

Project No. ~~468-83136~~ **468-84039** OCA No. 624062



CITY OF WICHITA, KANSAS

Jim Armour, P.E. City Engineer

April 2005

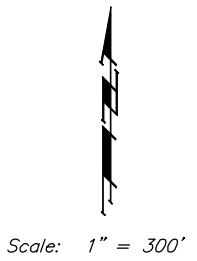

VICINITY MAP

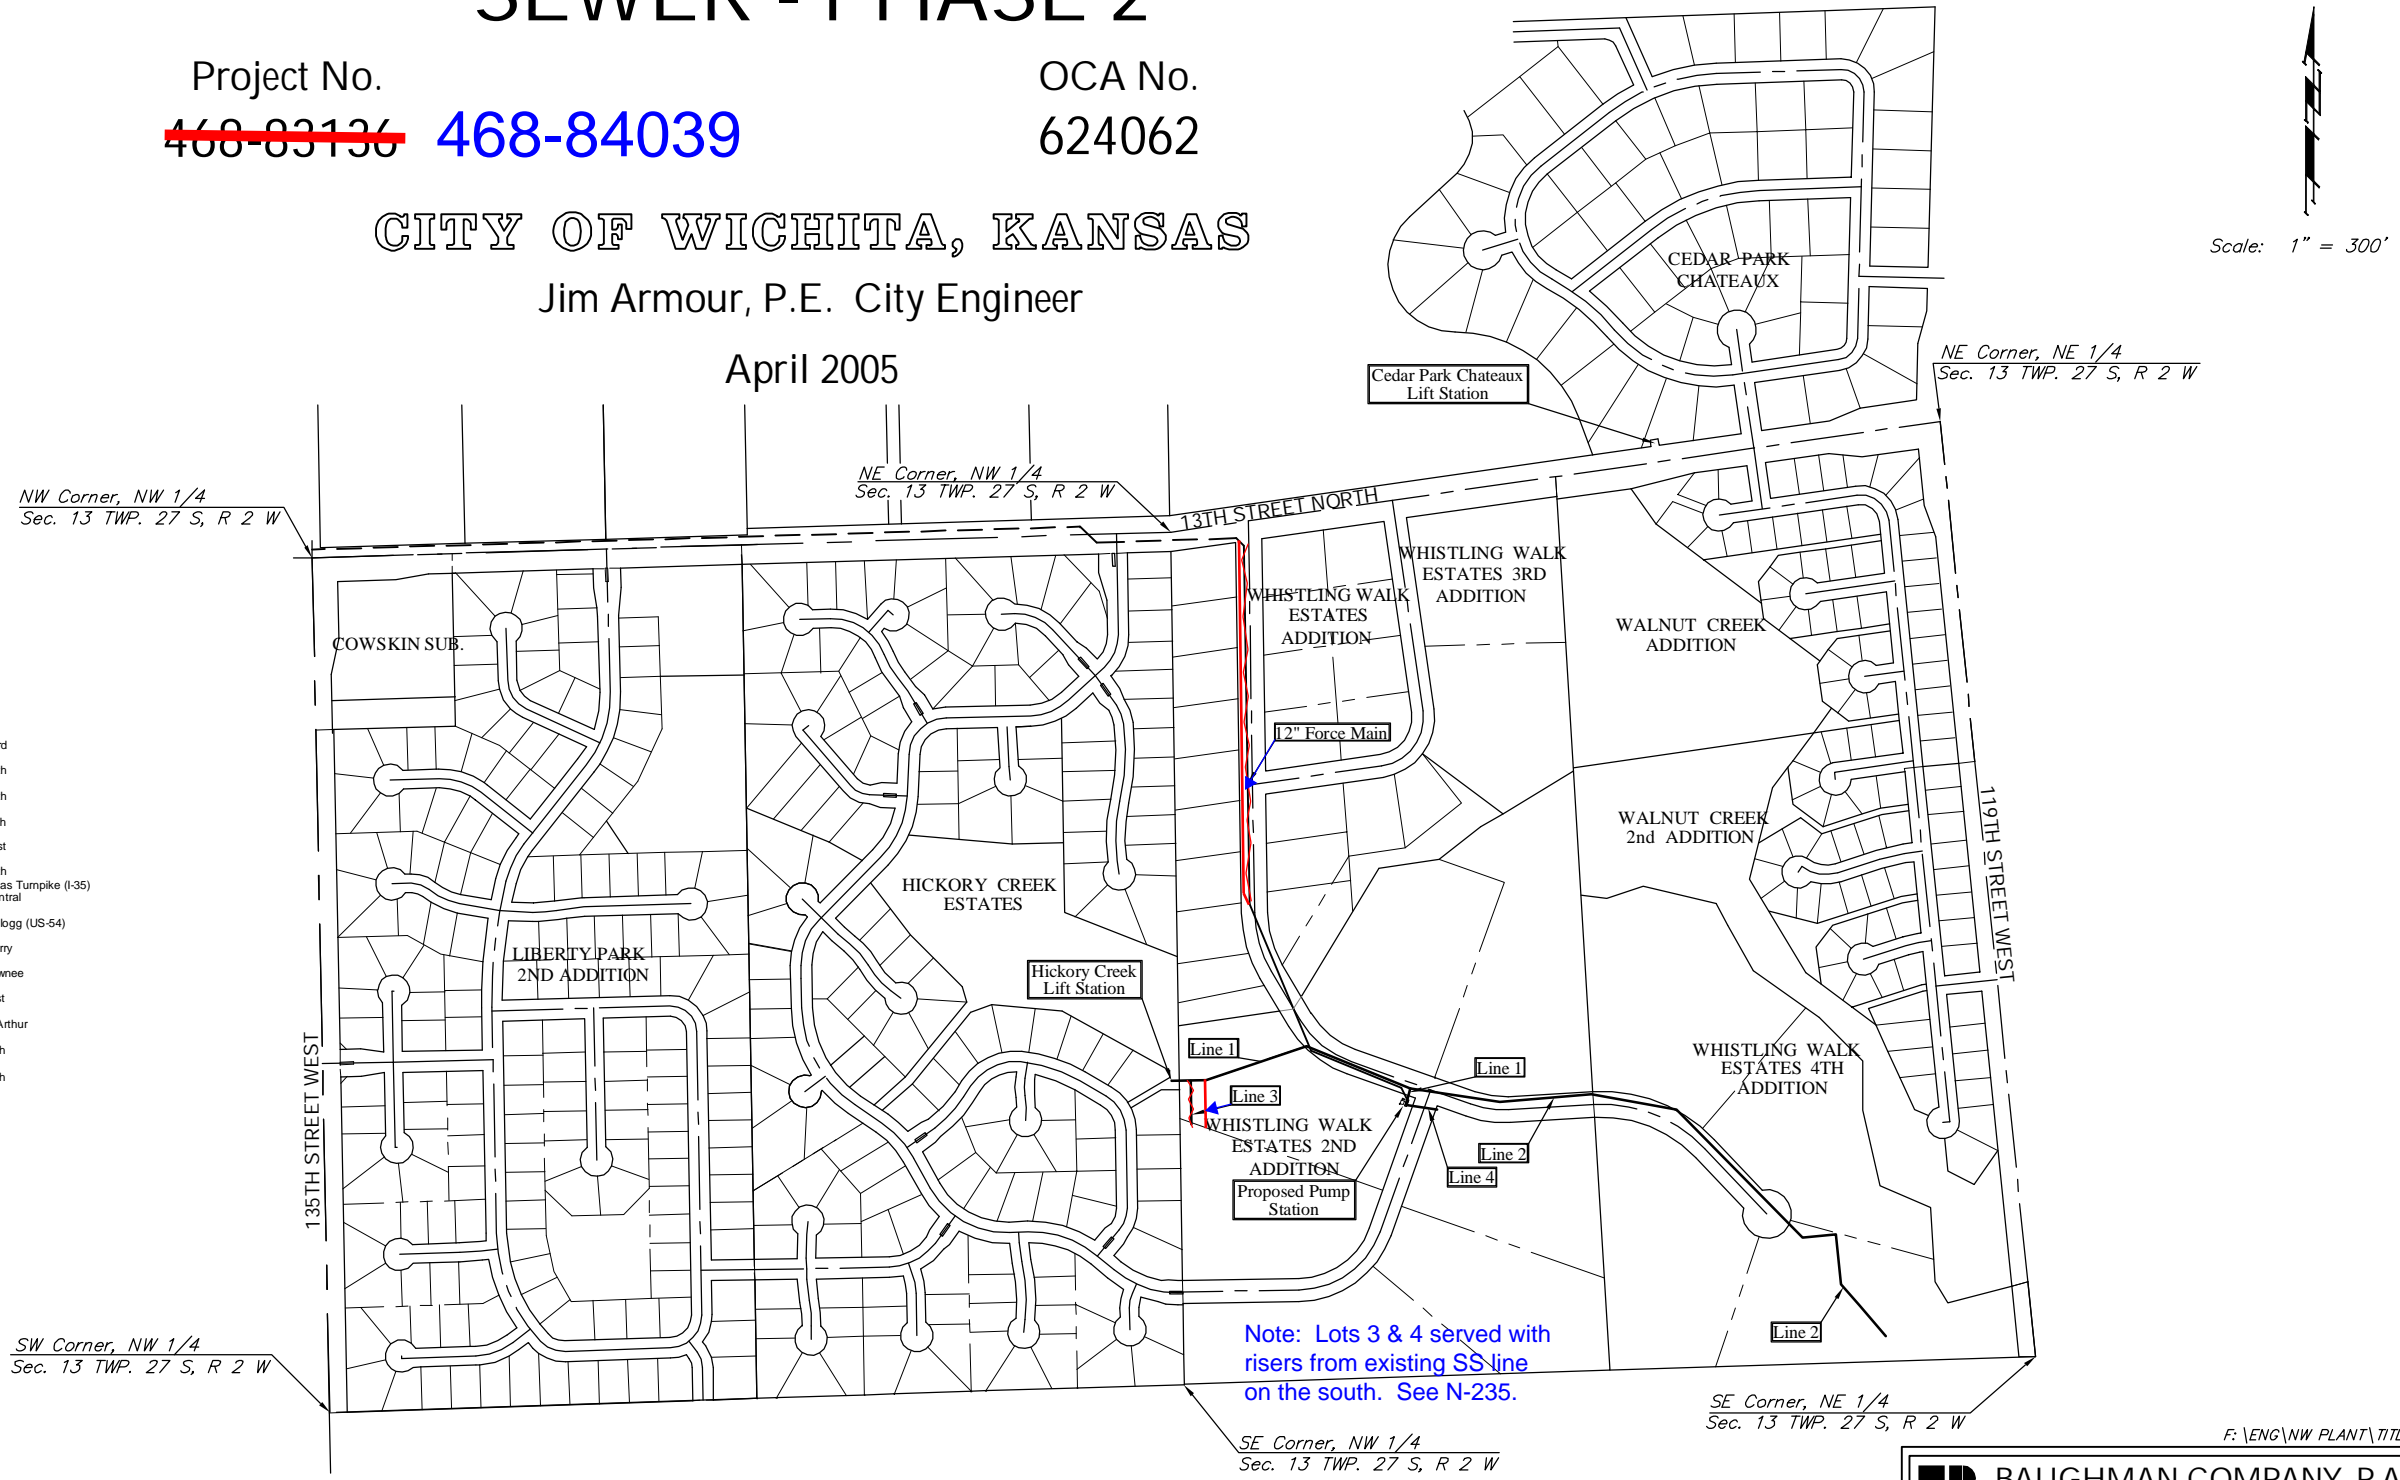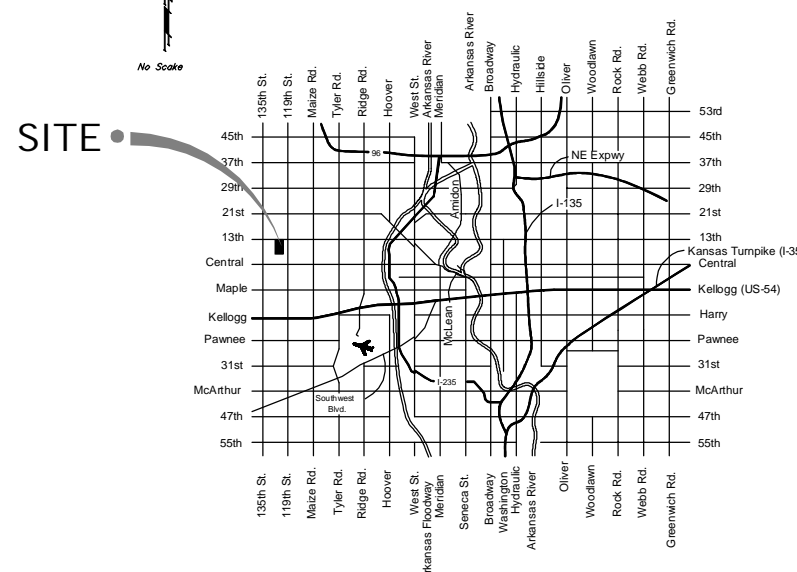

Note: Lots 3 & 4 served with risers from existing SS line on the south. See N-235.