

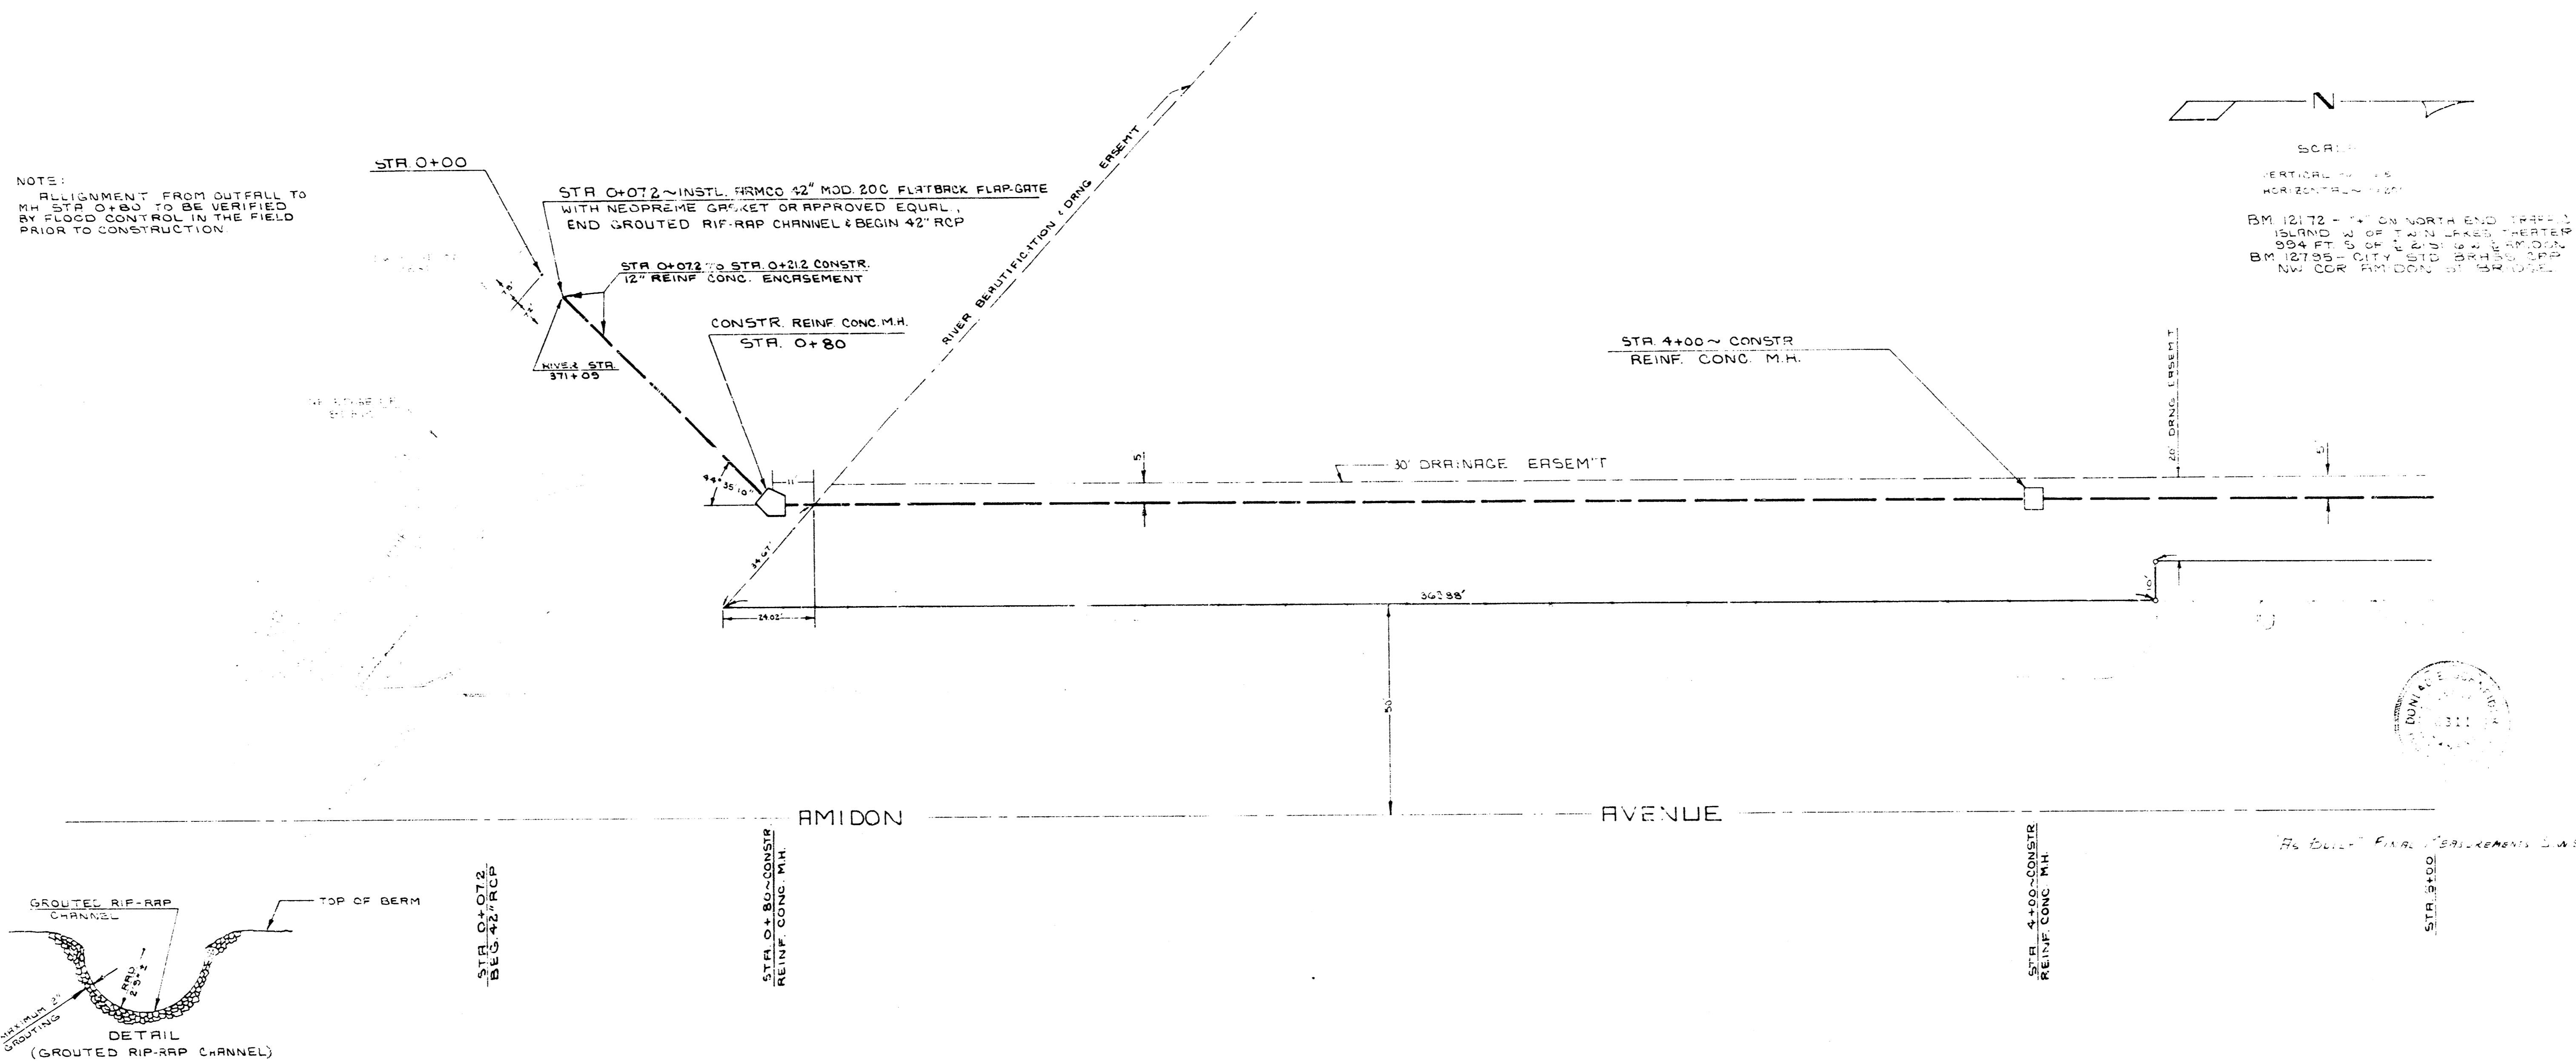


NOTE:
ALIGNMENT FROM OUTFALL TO
MH STA 0+80 TO BE VERIFIED
BY FLOOD CONTROL IN THE FIELD
PRIOR TO CONSTRUCTION

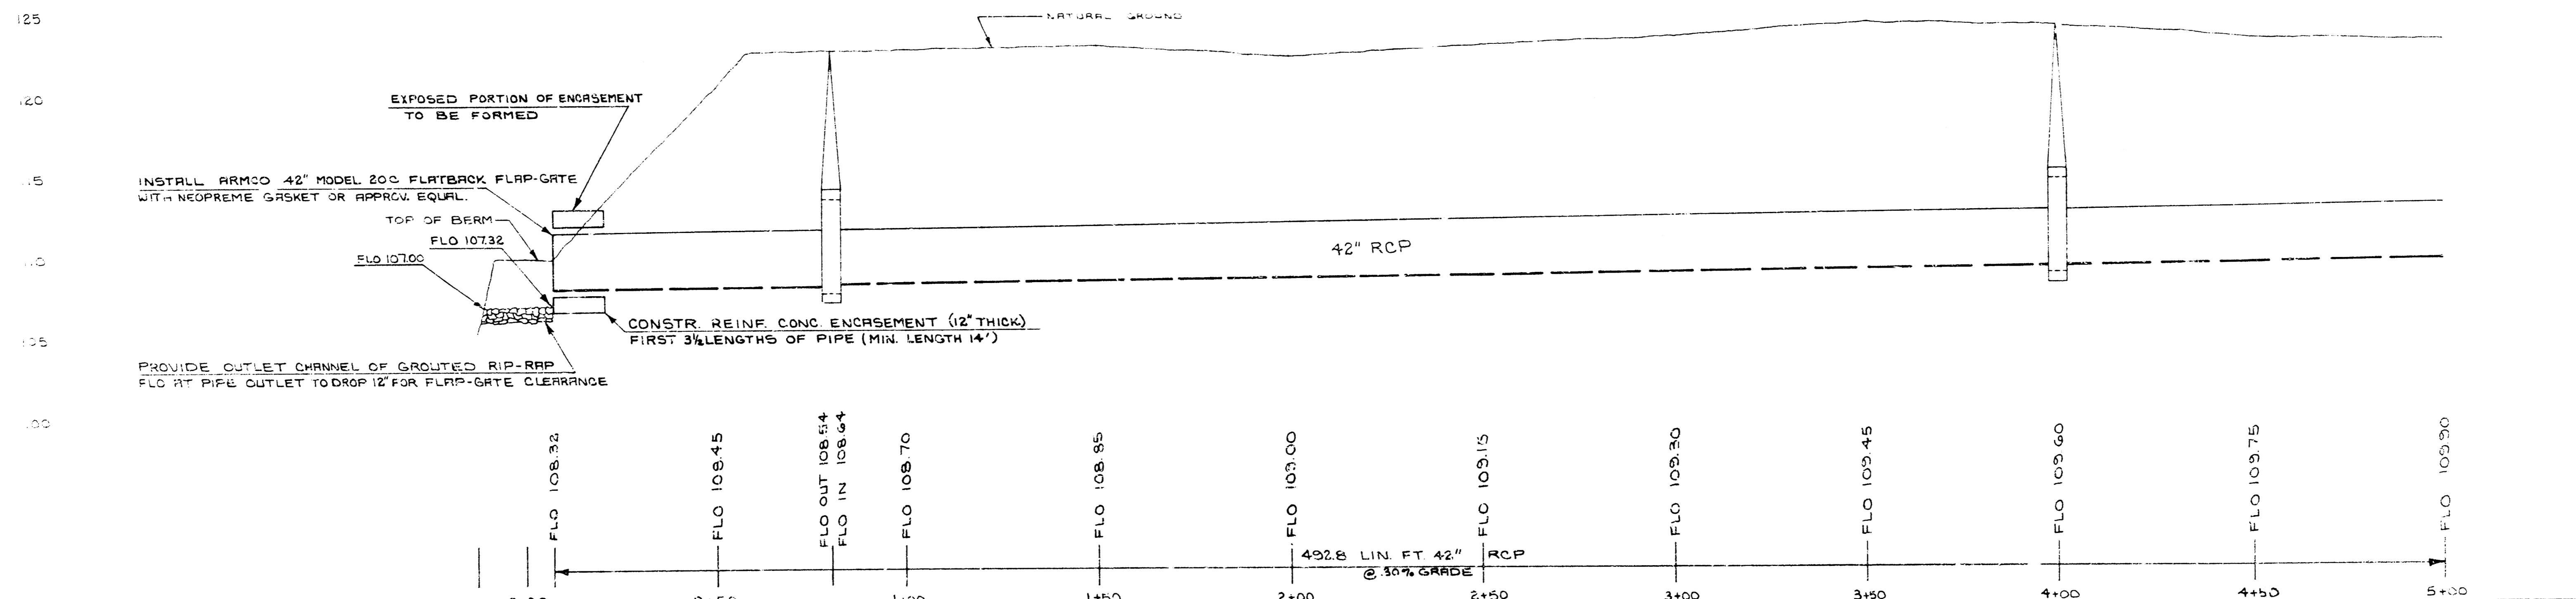


SCALE:
VERTICAL 1" = 10'
HORIZONTAL 1" = 20'

BM 12172 - 1' ON NORTH END (P&H)
155' W. OF TAN. BRASS CENTER
99.4 FT. S. OF E. S. 1/4 COR.
BM 12795 - CITY FIELD BRASS CAP
NW COR. 1/4 SECTION 17

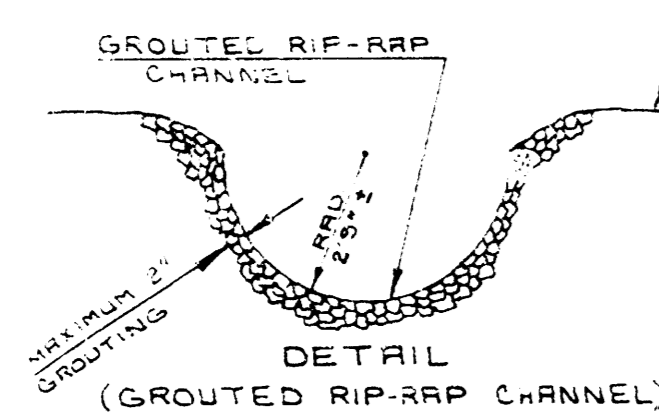

STORM WATER SEWER 97
CITY OF WICHITA
R.W. LINN - CITY ENGINEER
DATE 10/12/72 PROJECT NO. DBA 5702

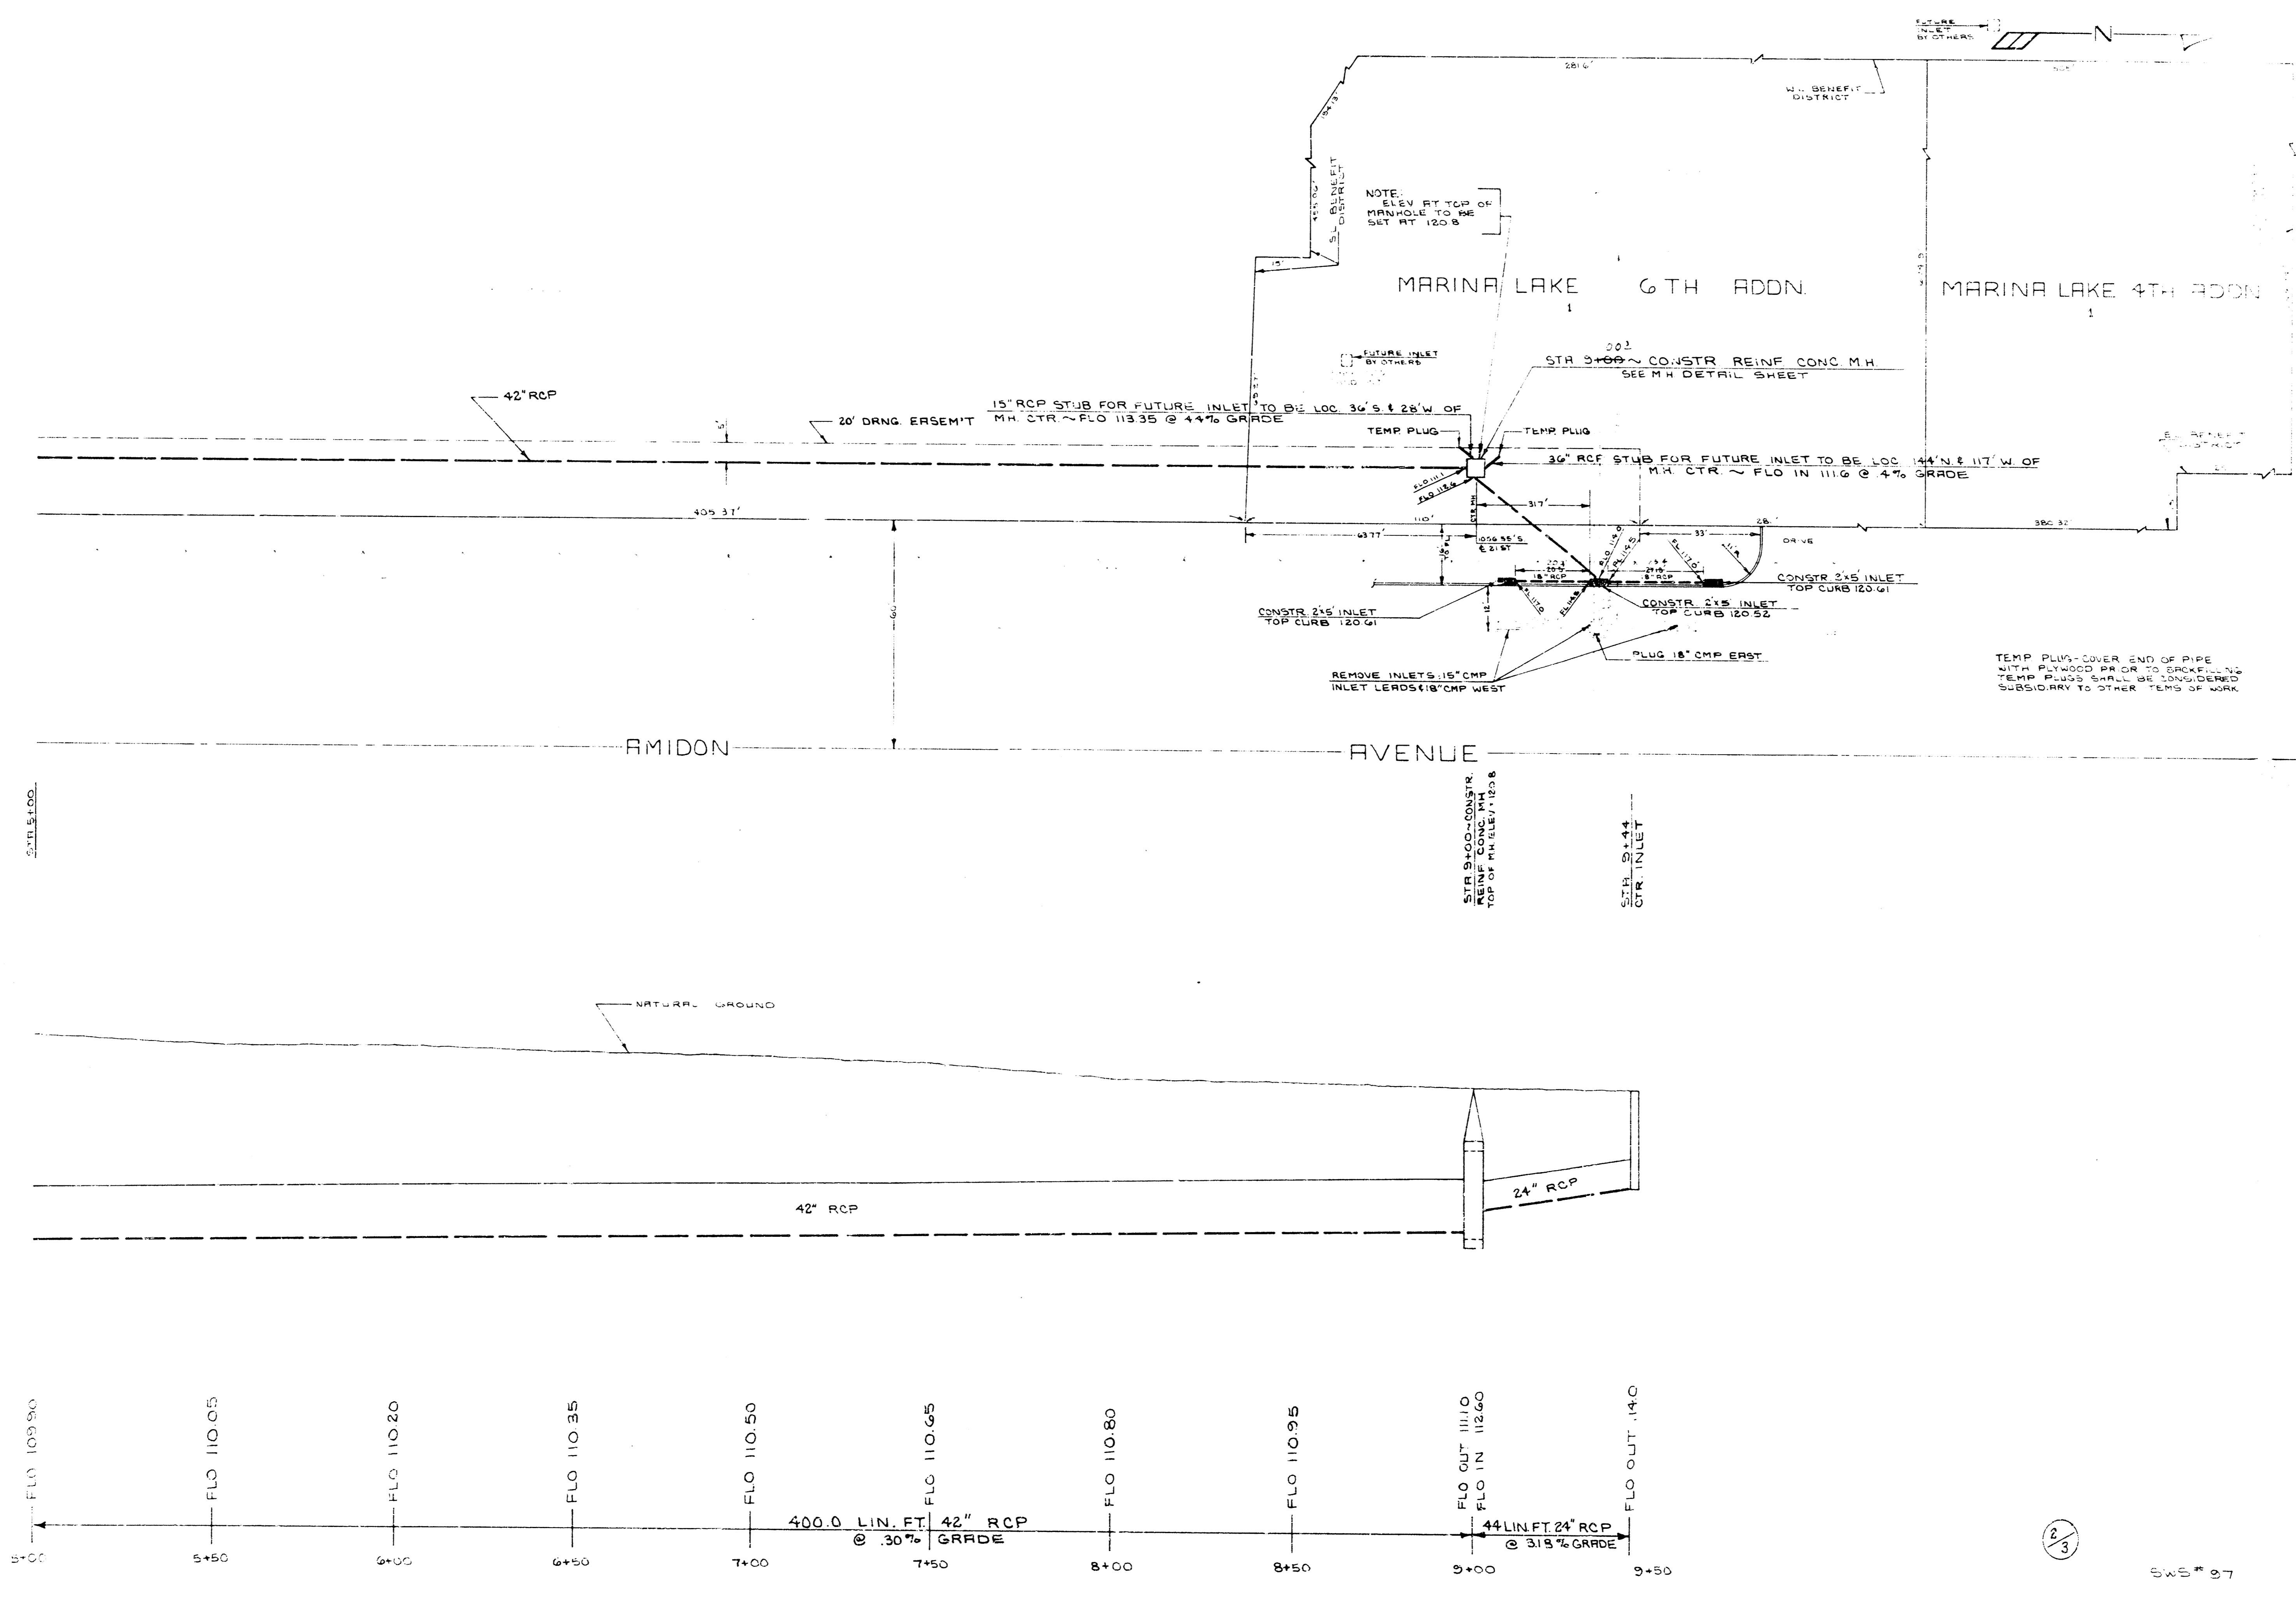

2/3

SW 5" 2.7

