

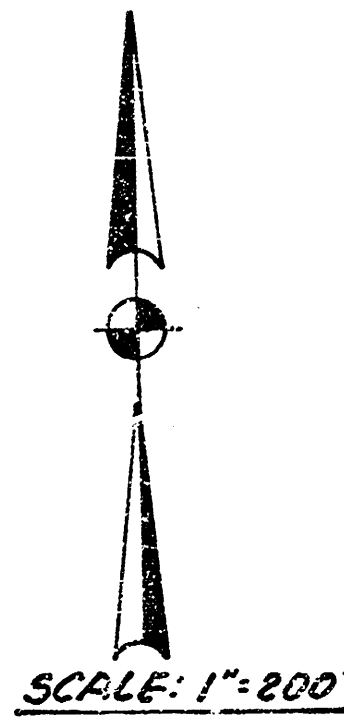
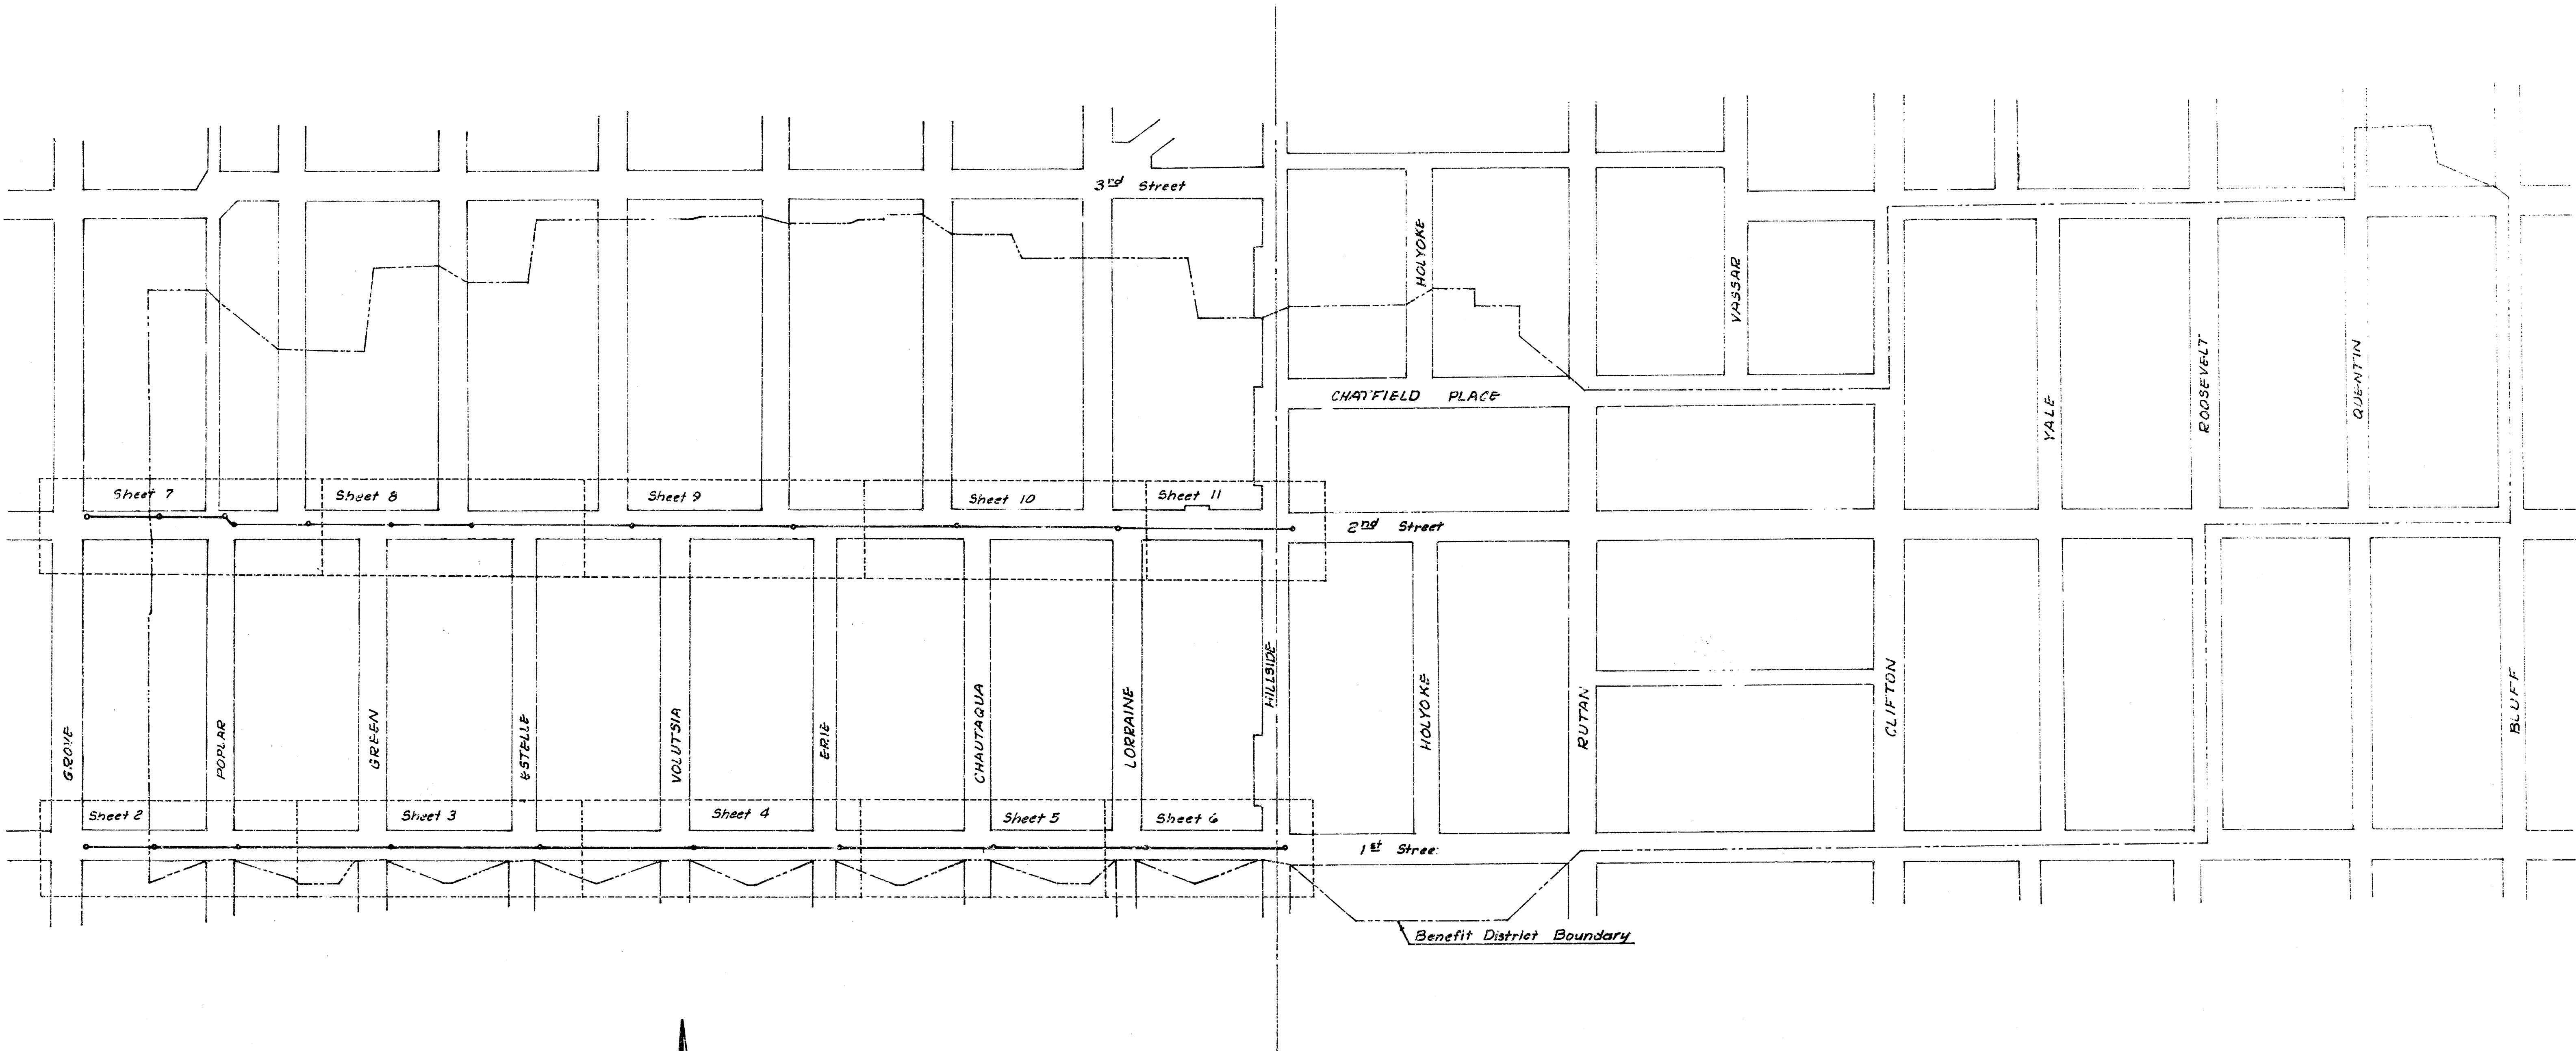


STORM WATER SEWER NO. 105

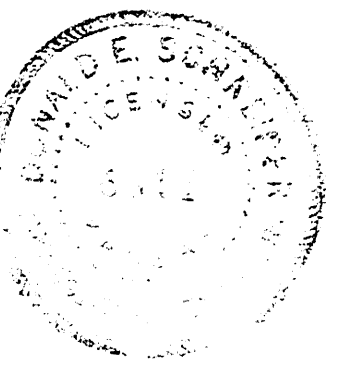


R. W. LINN, CITY ENGINEER
CITY OF WICHITA, KANSAS

DATE May 1, 1913

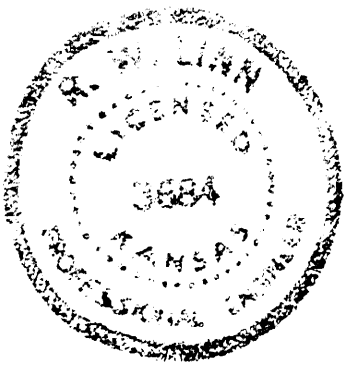

STORM WATER SEWER NO. 105
Project No. DBKA 573027

Sheet 1 of 11

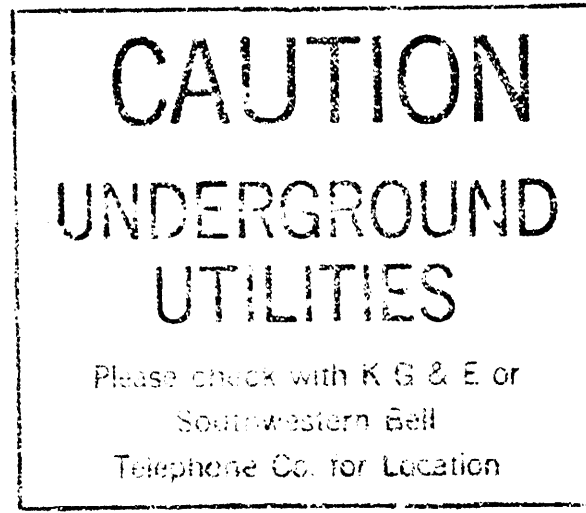

AS BUILT PER PLAN
IH-81

