
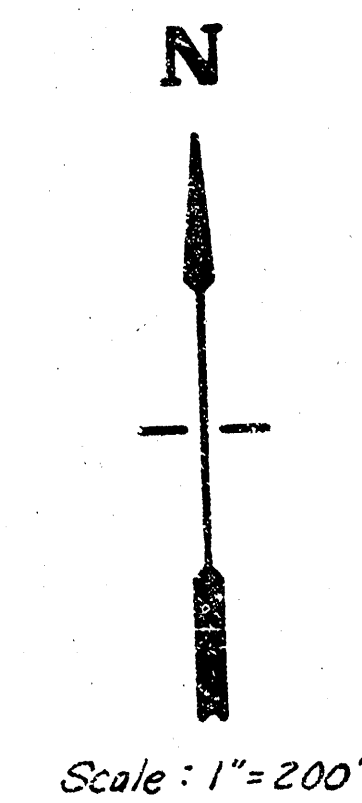


STORM WATER SEWER NO. 198


IN JAMESBURG PARK ADDITION

- GENERAL NOTES**
- 1) CONTRACTOR SHALL COORDINATE WORK WITH PAVING AND SANITARY CONTRACTORS, AND CONTACT RELEVANT UTILITY COMPANIES AND OTHER AGENCIES INVOLVED WITH THIS PROJECT.
 - 2) FIELD ENGINEER SHALL TAKE TIES TO ALL IRONS AND THIMBLES IN THE PROJECT AREA BEFORE CONSTRUCTION BEGINS. FIELD ENGINEER SHALL REPLACE ALL SUCH IRONS AND THIMBLES DISTURBED DURING CONSTRUCTION.
 - 3) THE TOPS OF INLETS AND MANHOLES AS NOTED ON THE PLANS MAY VARY SO AS TO MEET PROPOSED TYP OF CURB ELEVATIONS OR PAVEMENT ELEVATIONS. THE FIELD ENGINEER SHALL LOCATE INLETS AND MANHOLES WITH REFERENCE TO PROPOSED PAVING PLANS OF THE PERTINENT STREETS.
 - 5) CONTRACTOR SHALL AVOID UNCOVERING EXISTING WATERLINES UNLESS ABSOLUTELY NECESSARY. UNCOVERING SHALL BE DONE ONLY IN THE PRESENCE OF A WATER DEPARTMENT ENGINEER.
 - 7) THE INSIDE OF THE METAL PIPE SHALL BE FULLY PAVED FOR PIPE SIZES OF 24" AND LARGER.

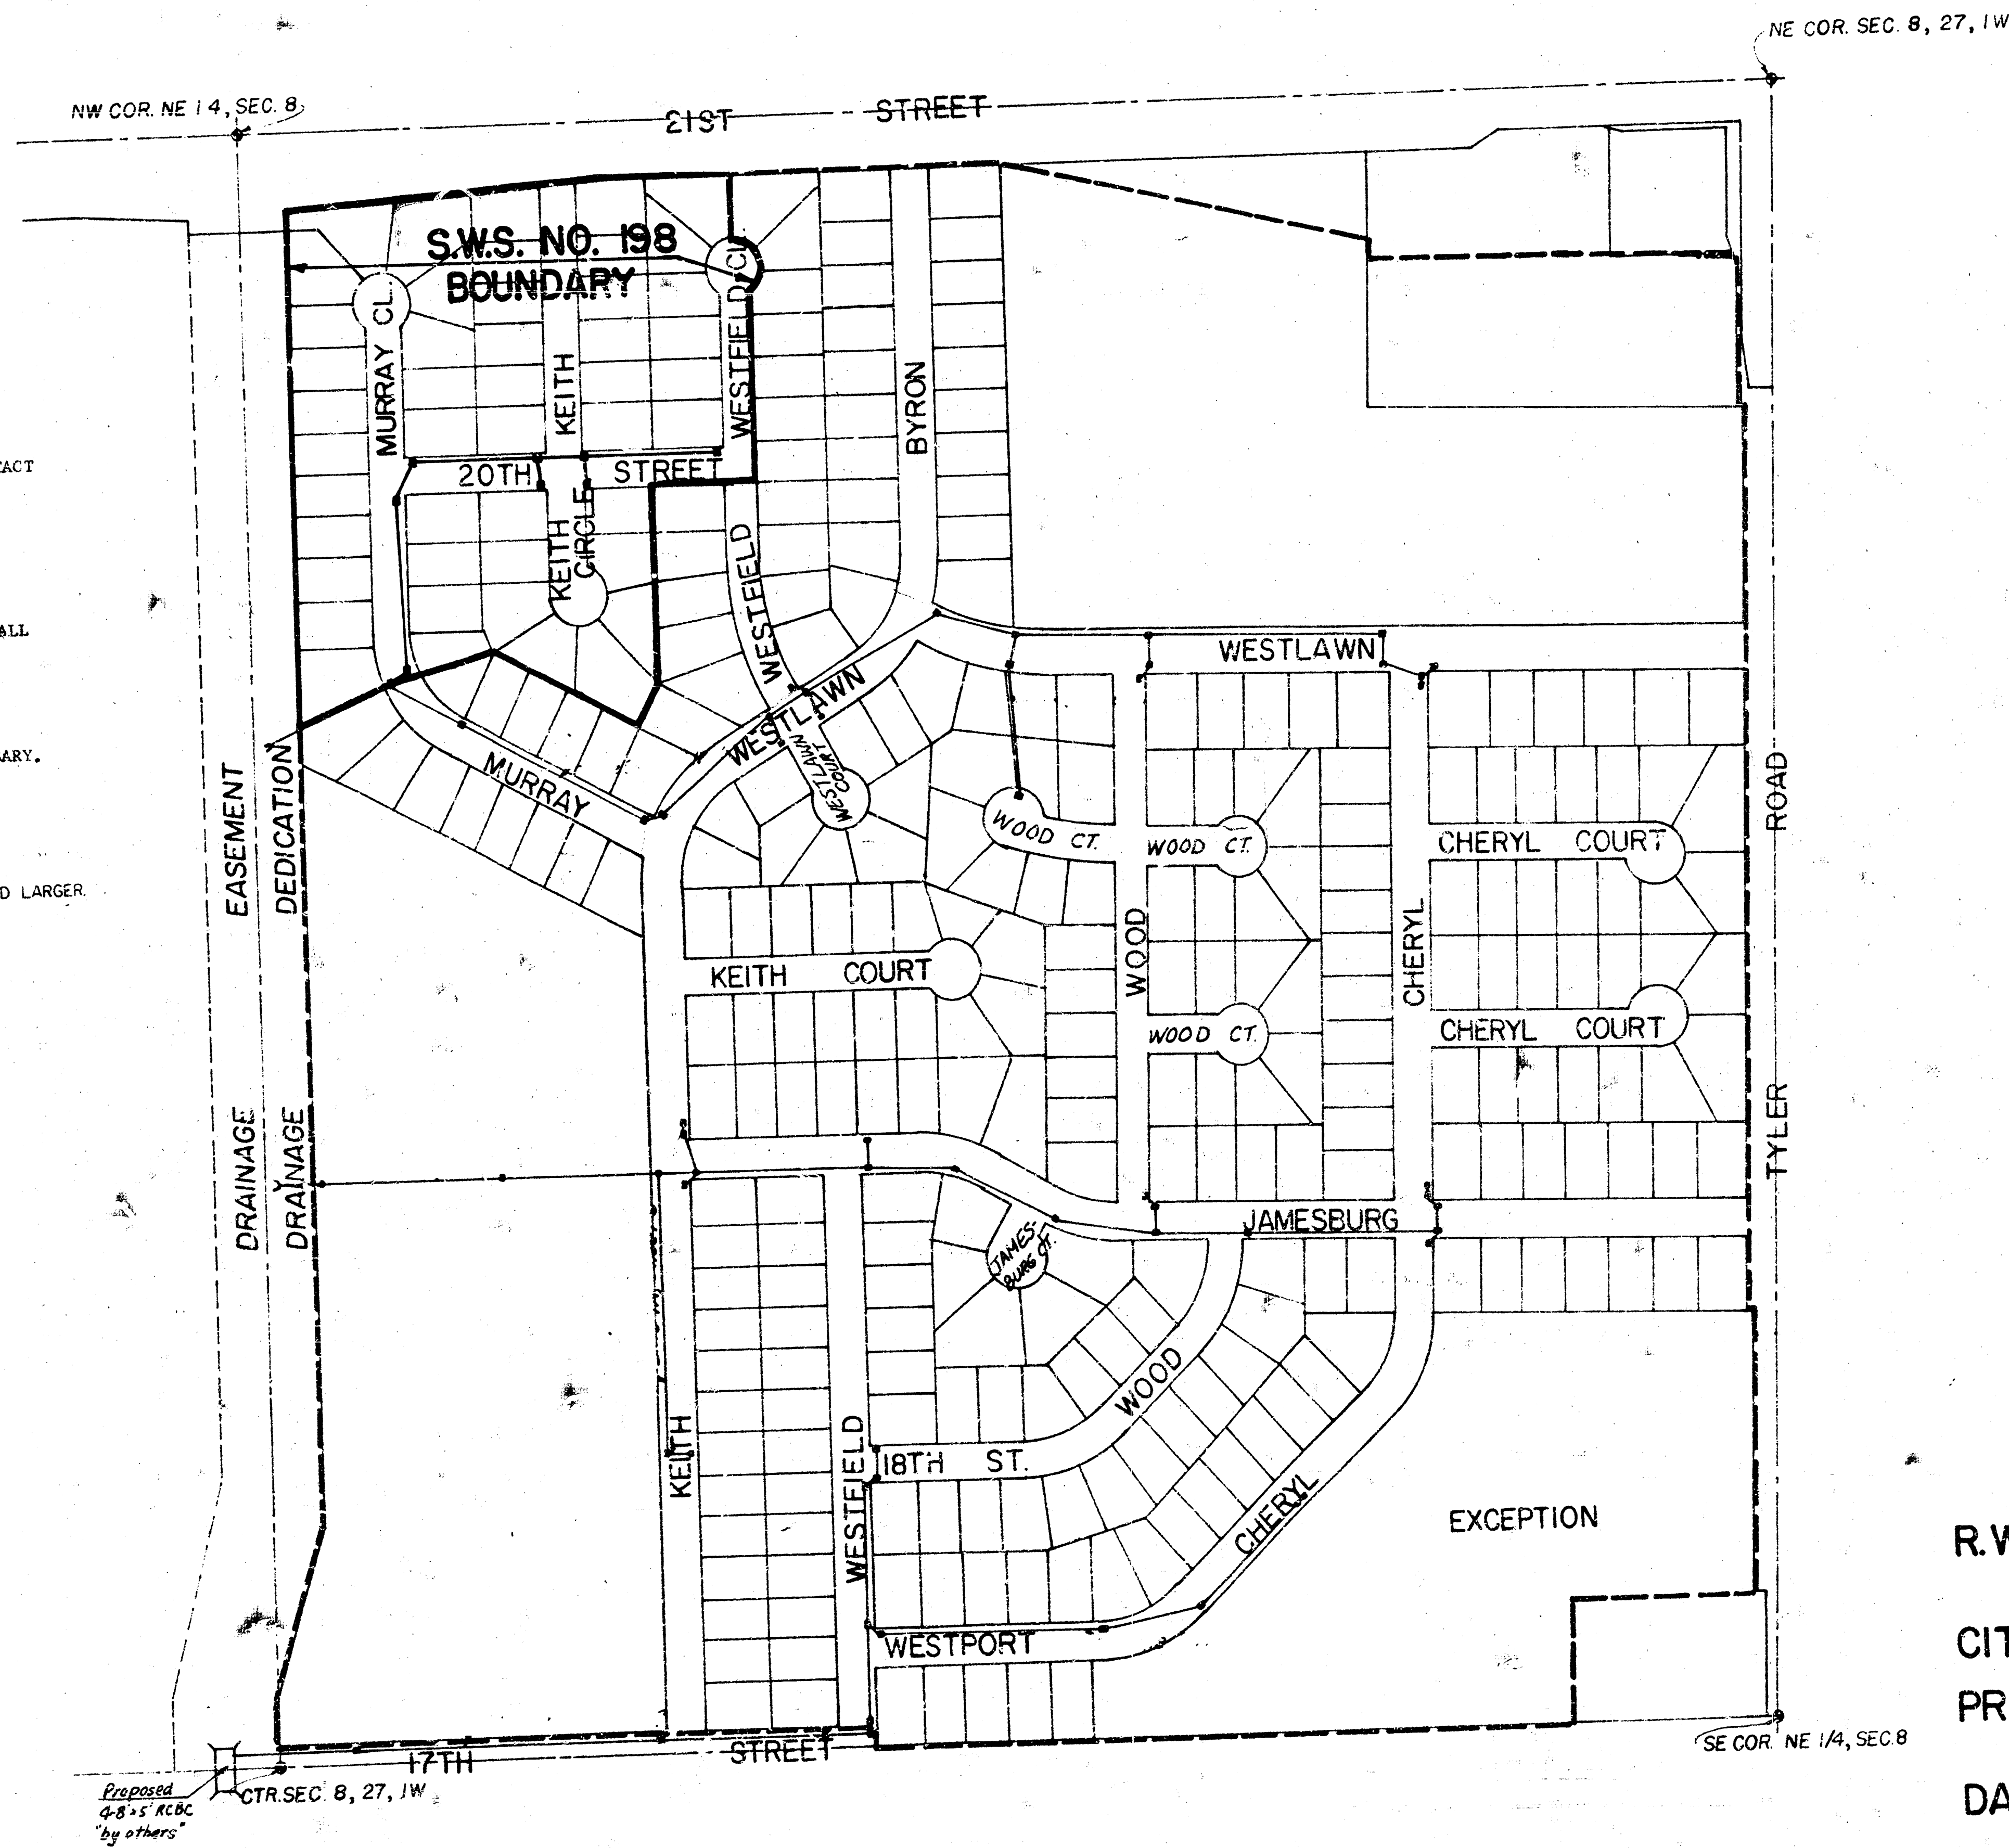


R.W. BRUGGEMAN, DIRECTOR OF THE DEPARTMENT OF
ENGINEERING/CITY ENGINEER
CITY OF WICHITA, KANSAS
PROJECT NO. 468 76 245 80984 000 000 001

DATE: _____

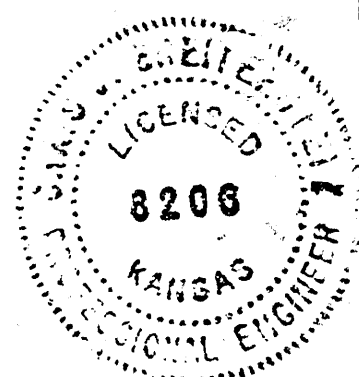


As Built 8/20/83

1/4

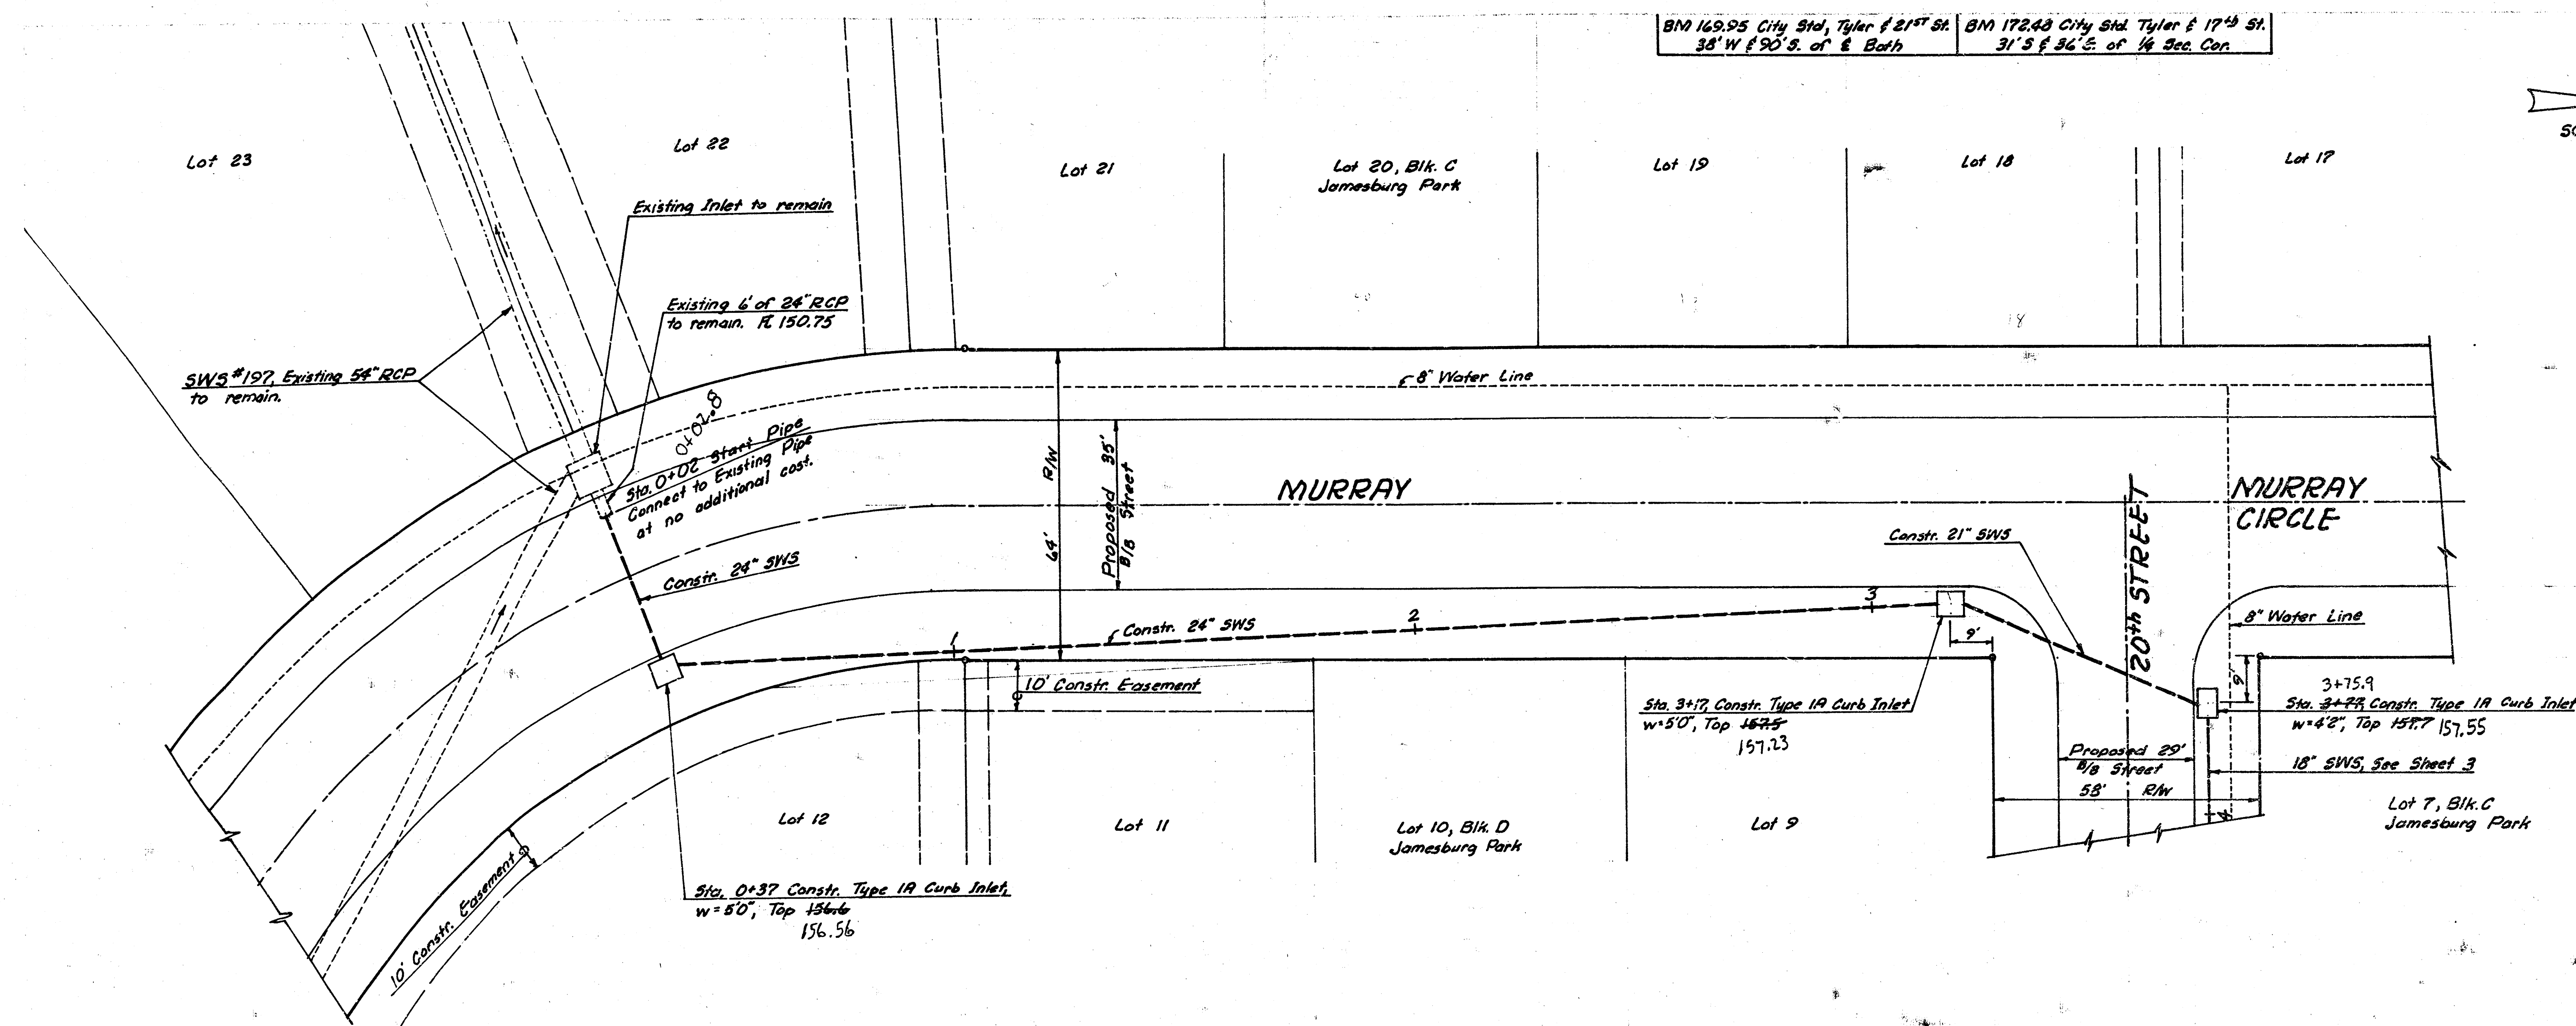

BM 169.95 City Sid. Tyler f 21" St. 38' W f 90' S. of & Bath
 BM 172.43 City Sid. Tyler f 17" St. 31' S f 36' E. of 1/4 Sec. Con.



SCALE: 1"=20'

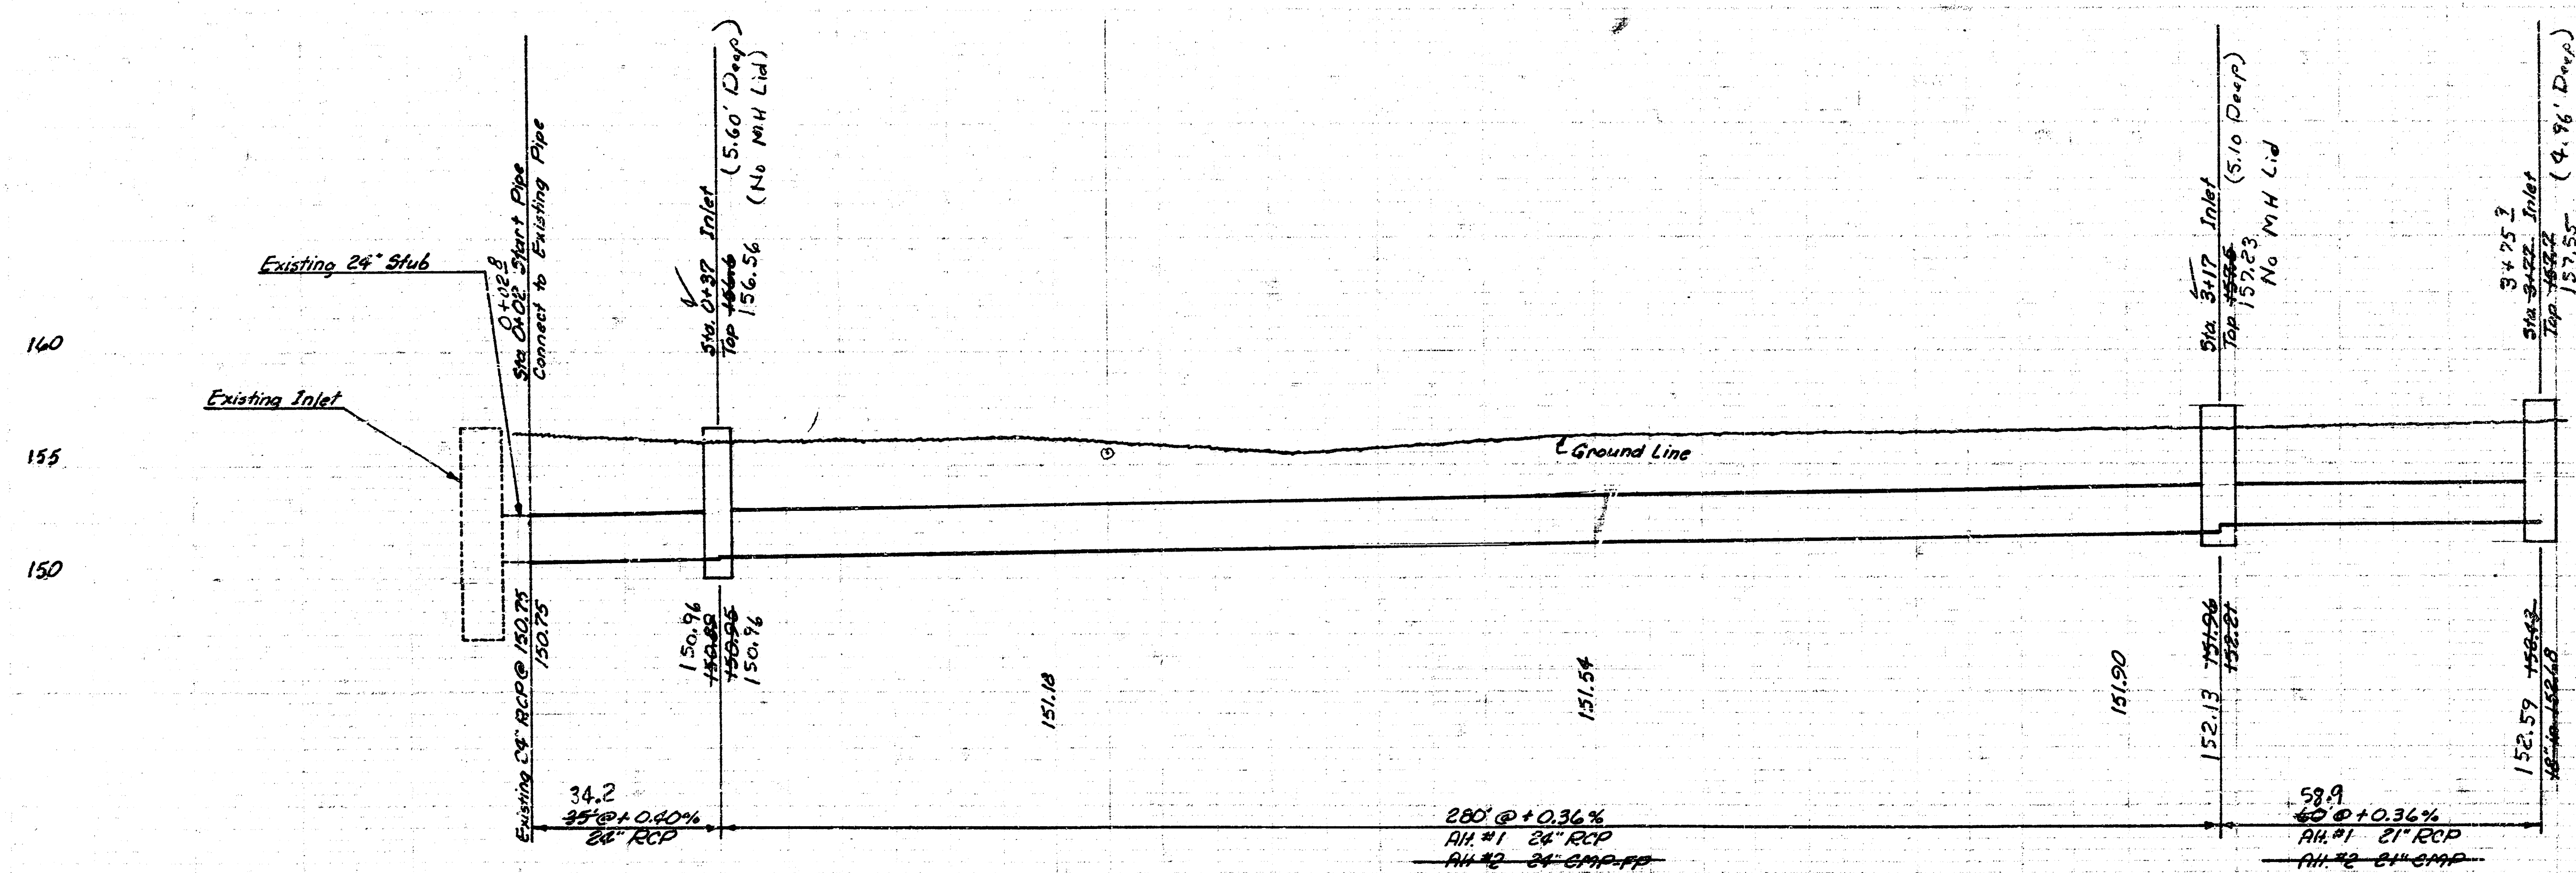

As Built 8/30/83

PROJECT DESCRIPTION
SWS #198
PROJECT NUMBER
468-76-245-80904-000-000-001

Sheet 2 of 4 2/4

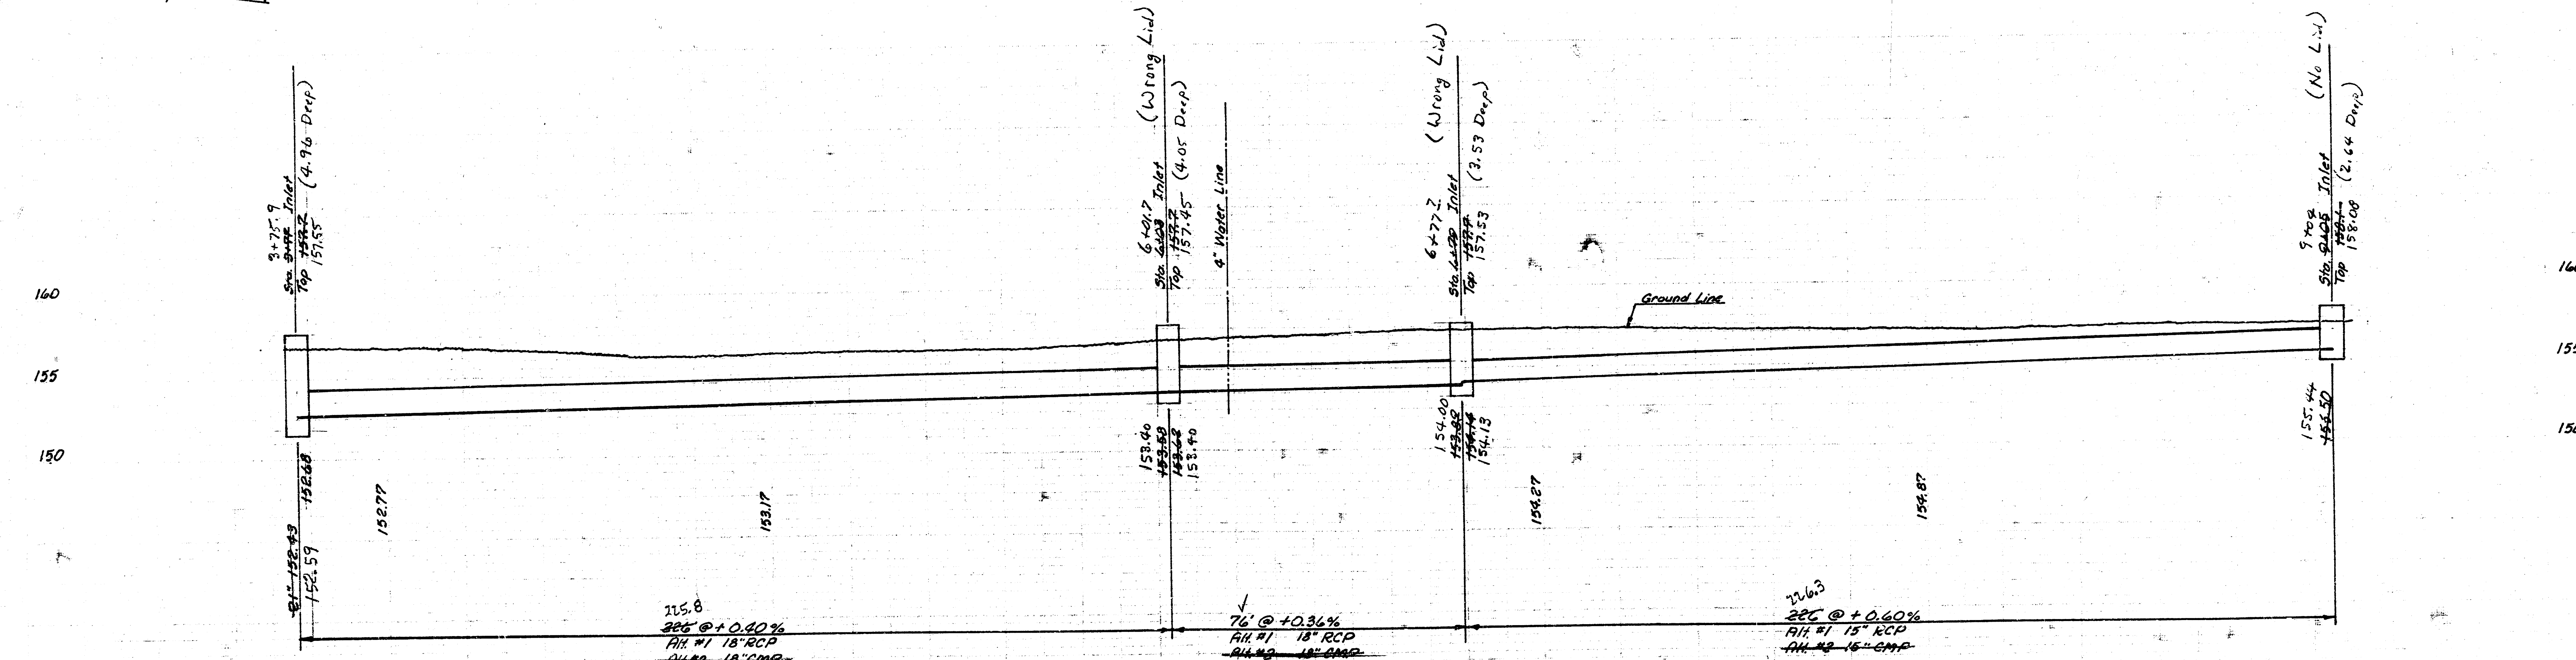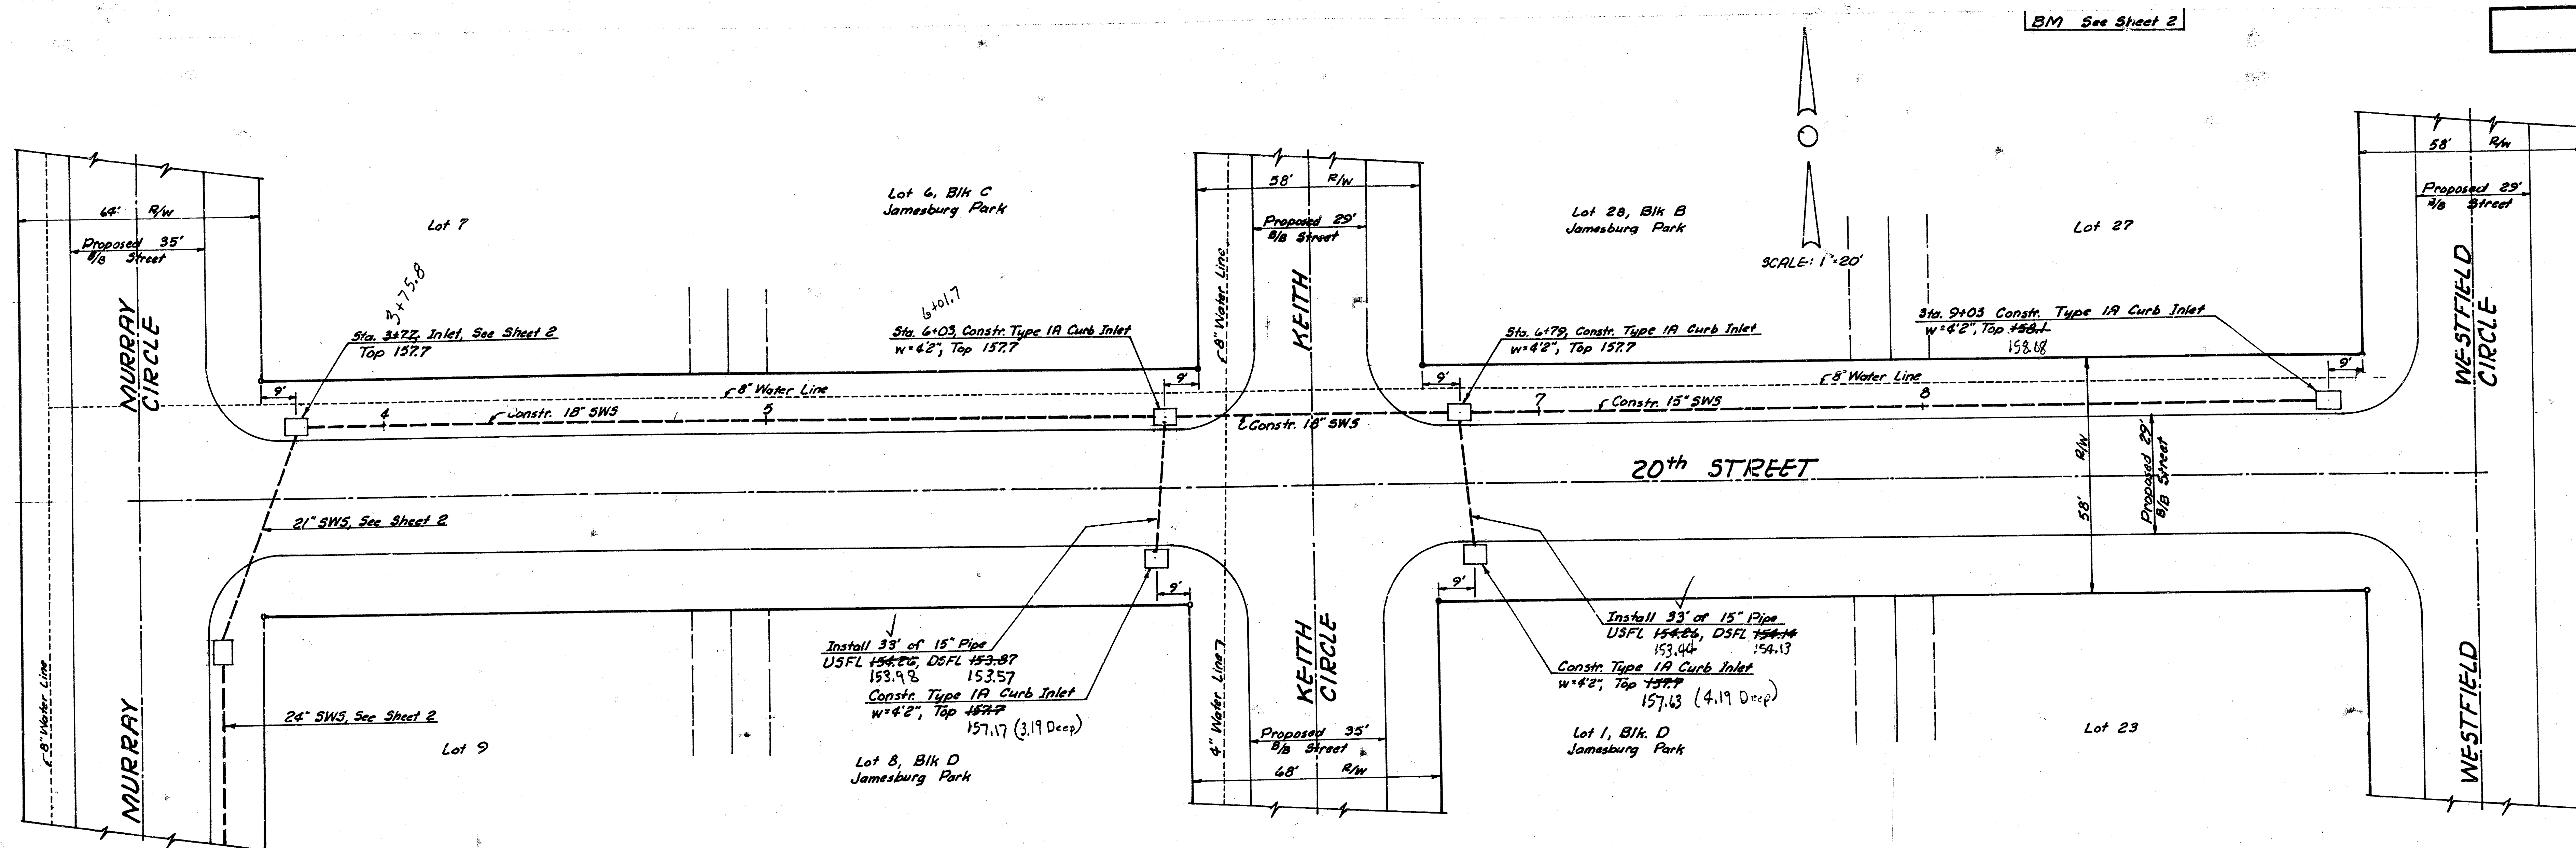


As Built 8/30/83

PROJECT DESCRIPTION
SWS # 198
PROJECT NUMBER
468-76-245-80984-000-000-001



Sheet 3 of 4

16 4 1 2M 1480 2004 4 of 4


Technical drawing of a mechanical part, likely a valve or fitting, showing a cross-section with a hatched area. The drawing includes dimension lines and labels: 'H' for height, 'D' for diameter, and 'L' for length. There are also some handwritten notes and a small table with two columns and two rows.

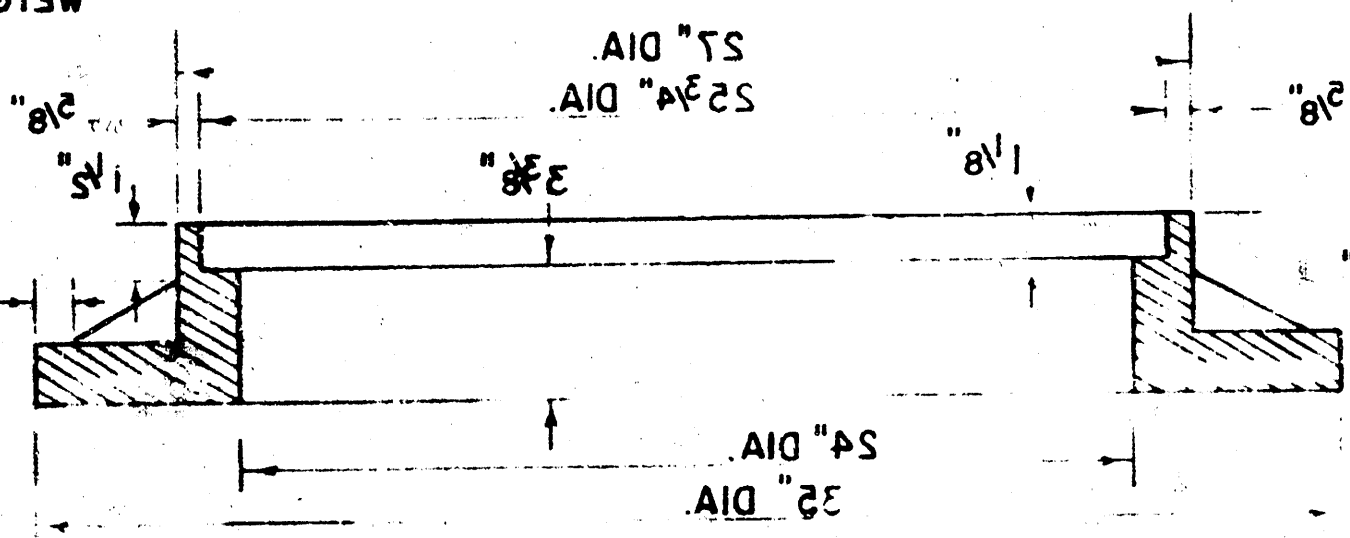


"812" "511" "1" 1

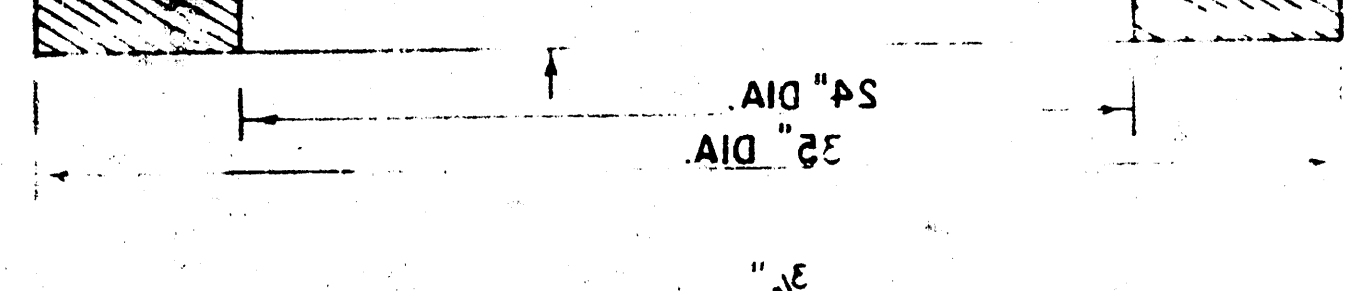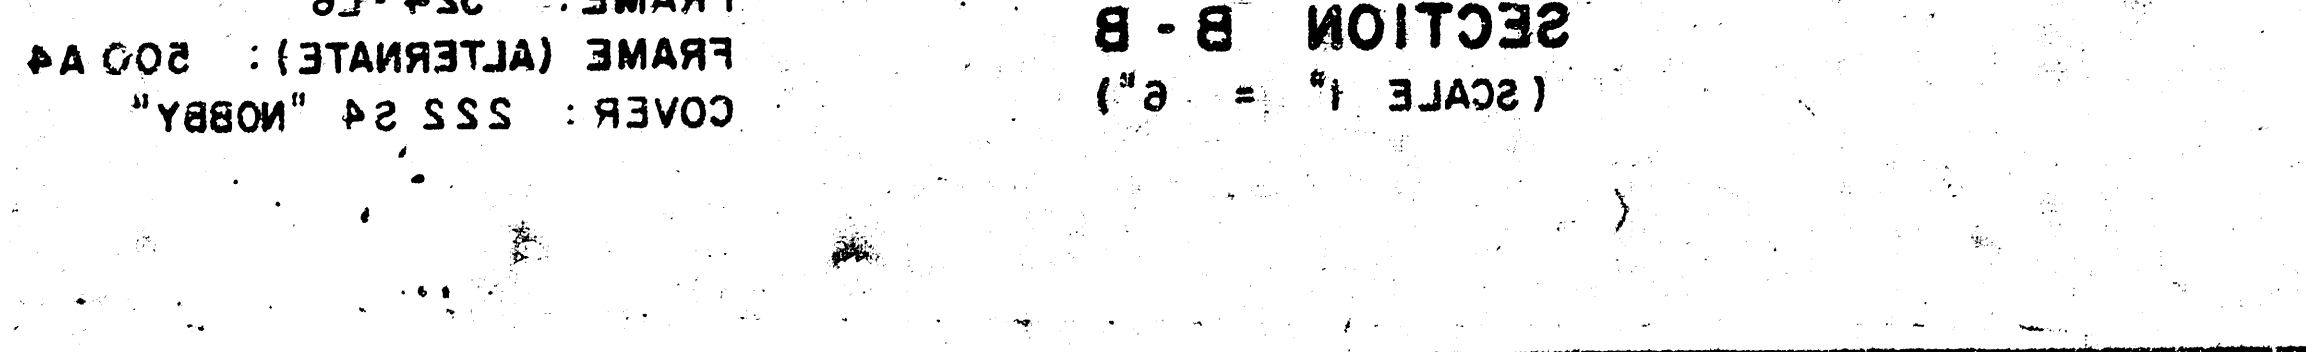[illegible]

"e",

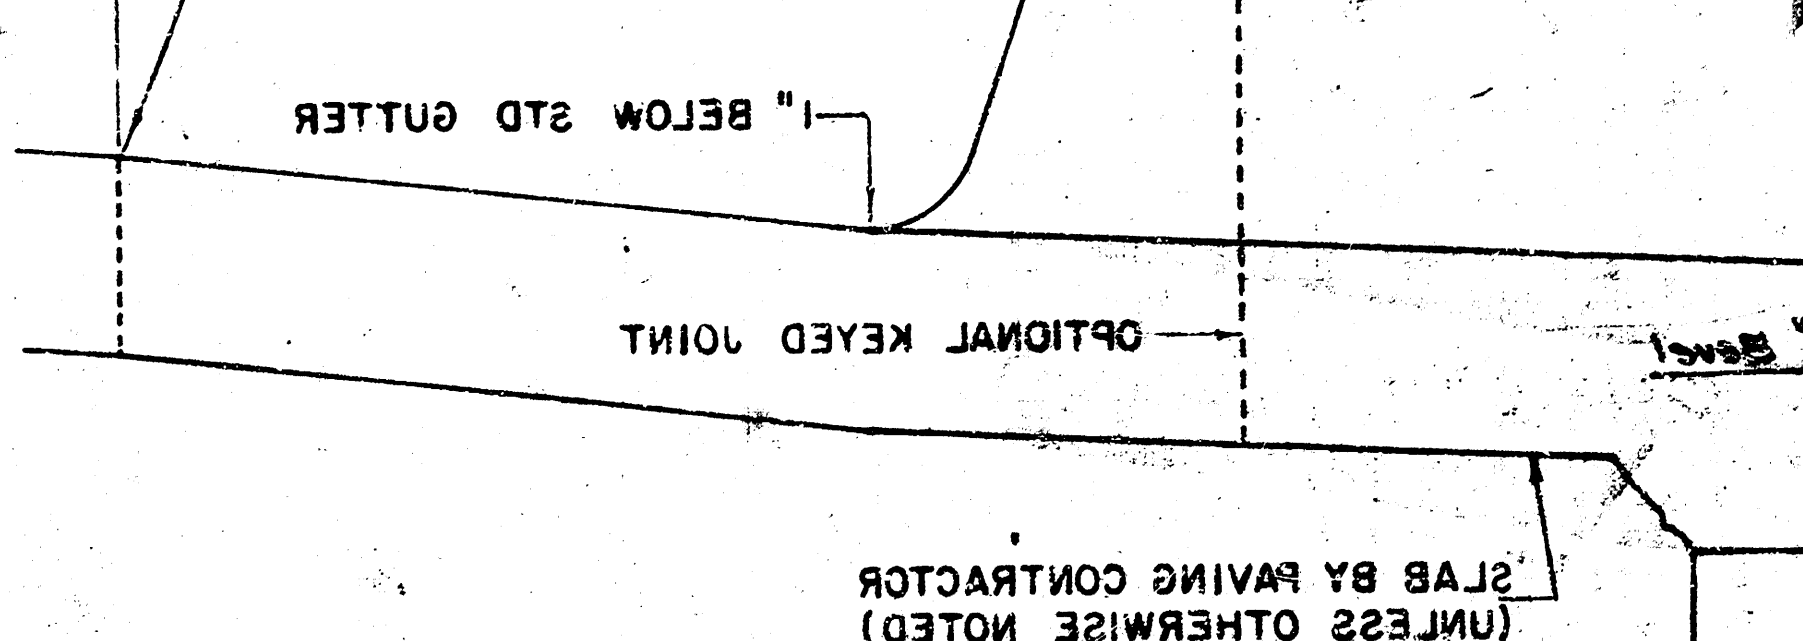


—

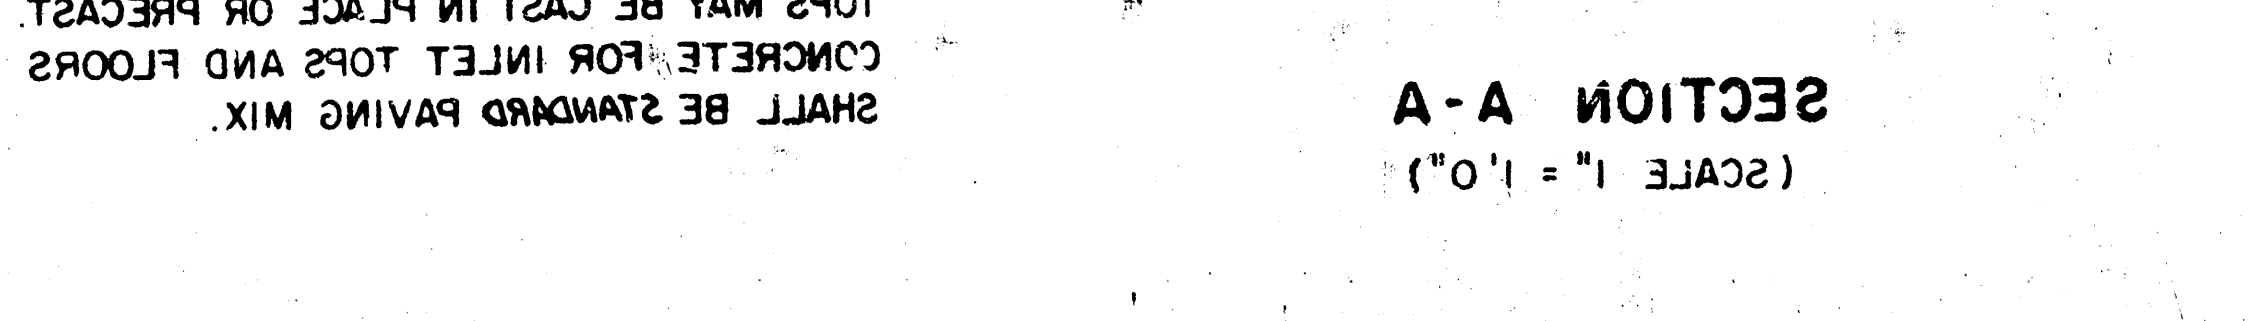


100

10

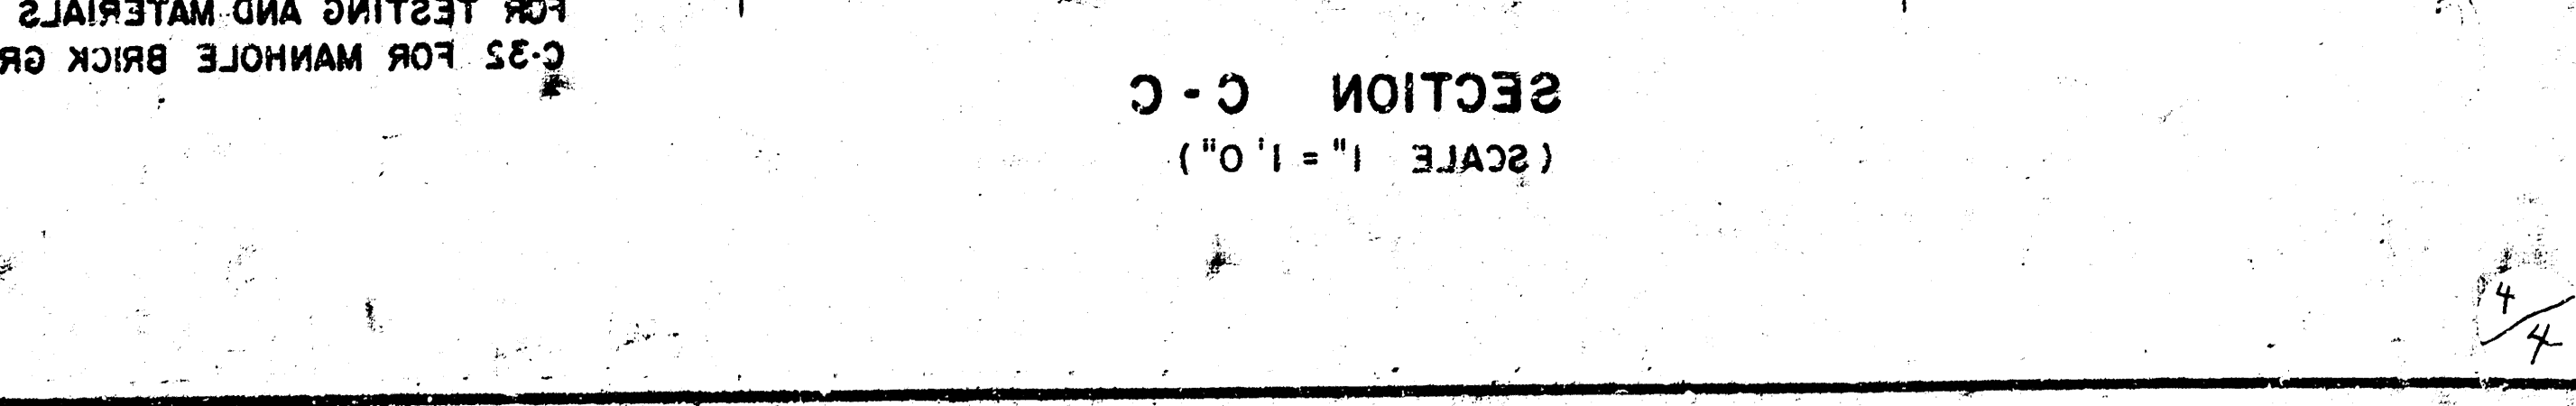

d	p			
a	e	ɛ	ɜ	ɪ

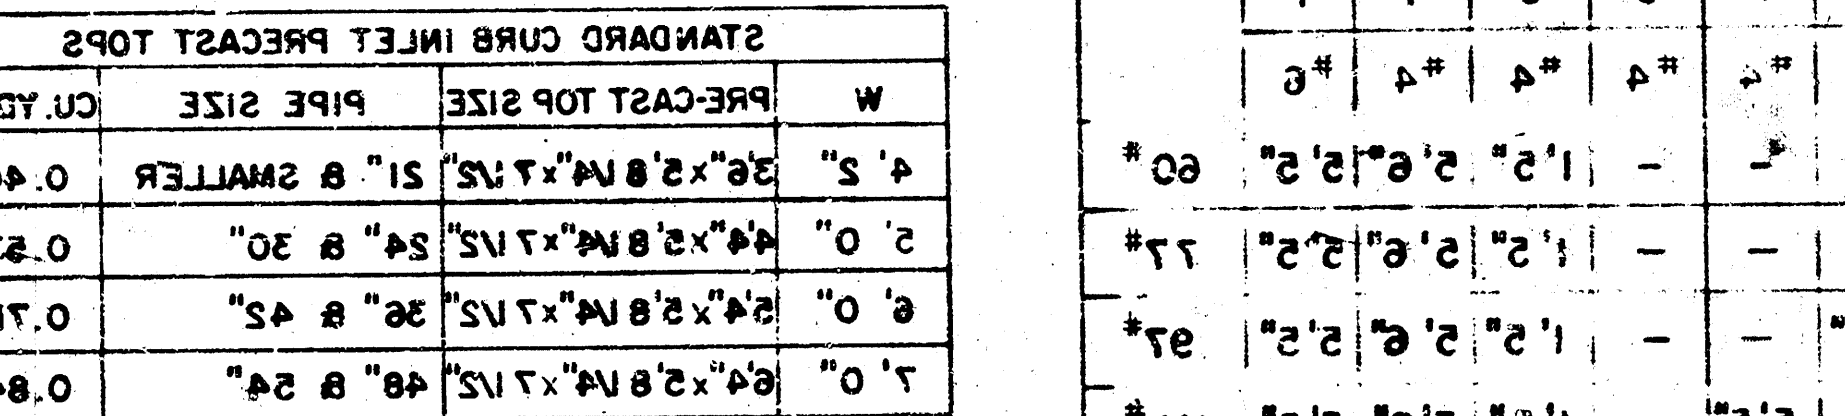

100-443887-100

* GROSS VOLUME

