
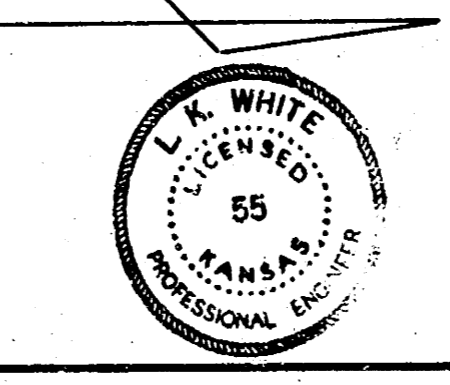
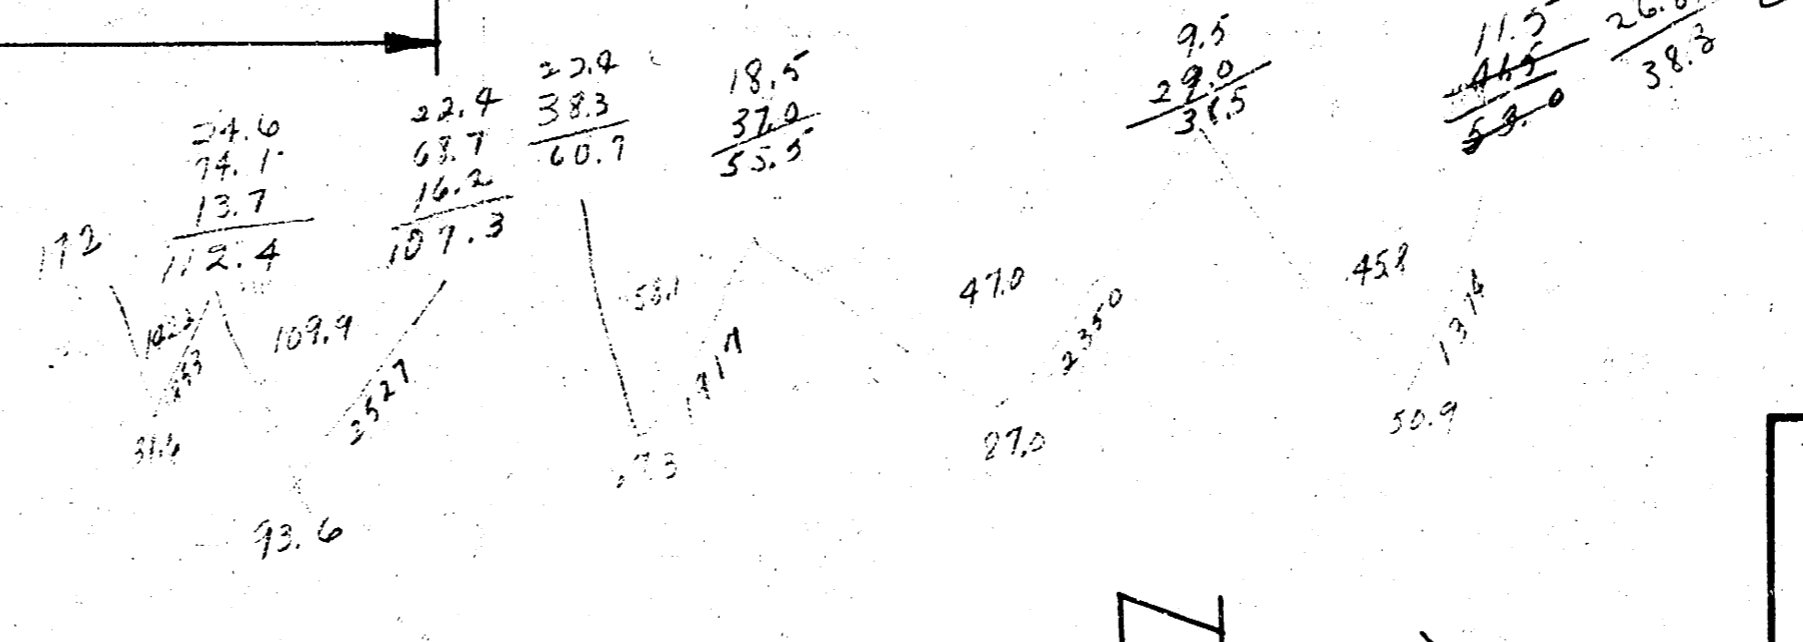


WEST FABRIQUE DRIVE

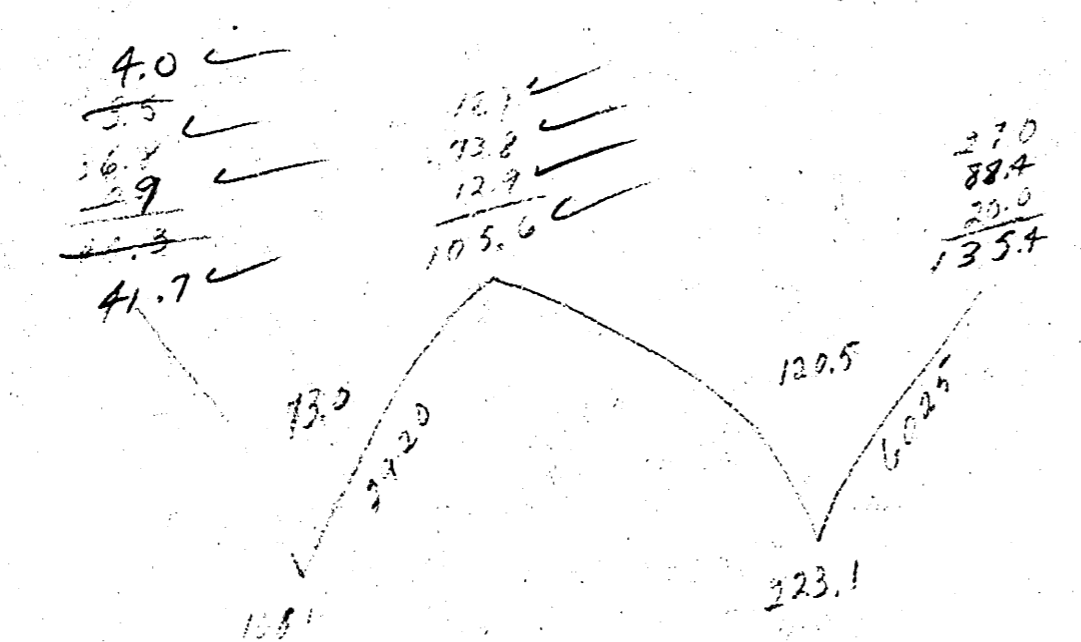

LEXINGTON

2/2