


B.M. 154.44 NE Cor. Stone Slab on Brock Rail N.S. 16" 8202 Levitt
 B.M. 151.68 SW Cor. Conc. Patch N.S. Levitt 15' W of E.L. Blackwell

FIELD ENGR. & CONTRACTOR NOTE
 Spec. Drain Location

PROJ. NO. C15-49
 DATE 2-2-30
 CITY WICHITA, KANSAS

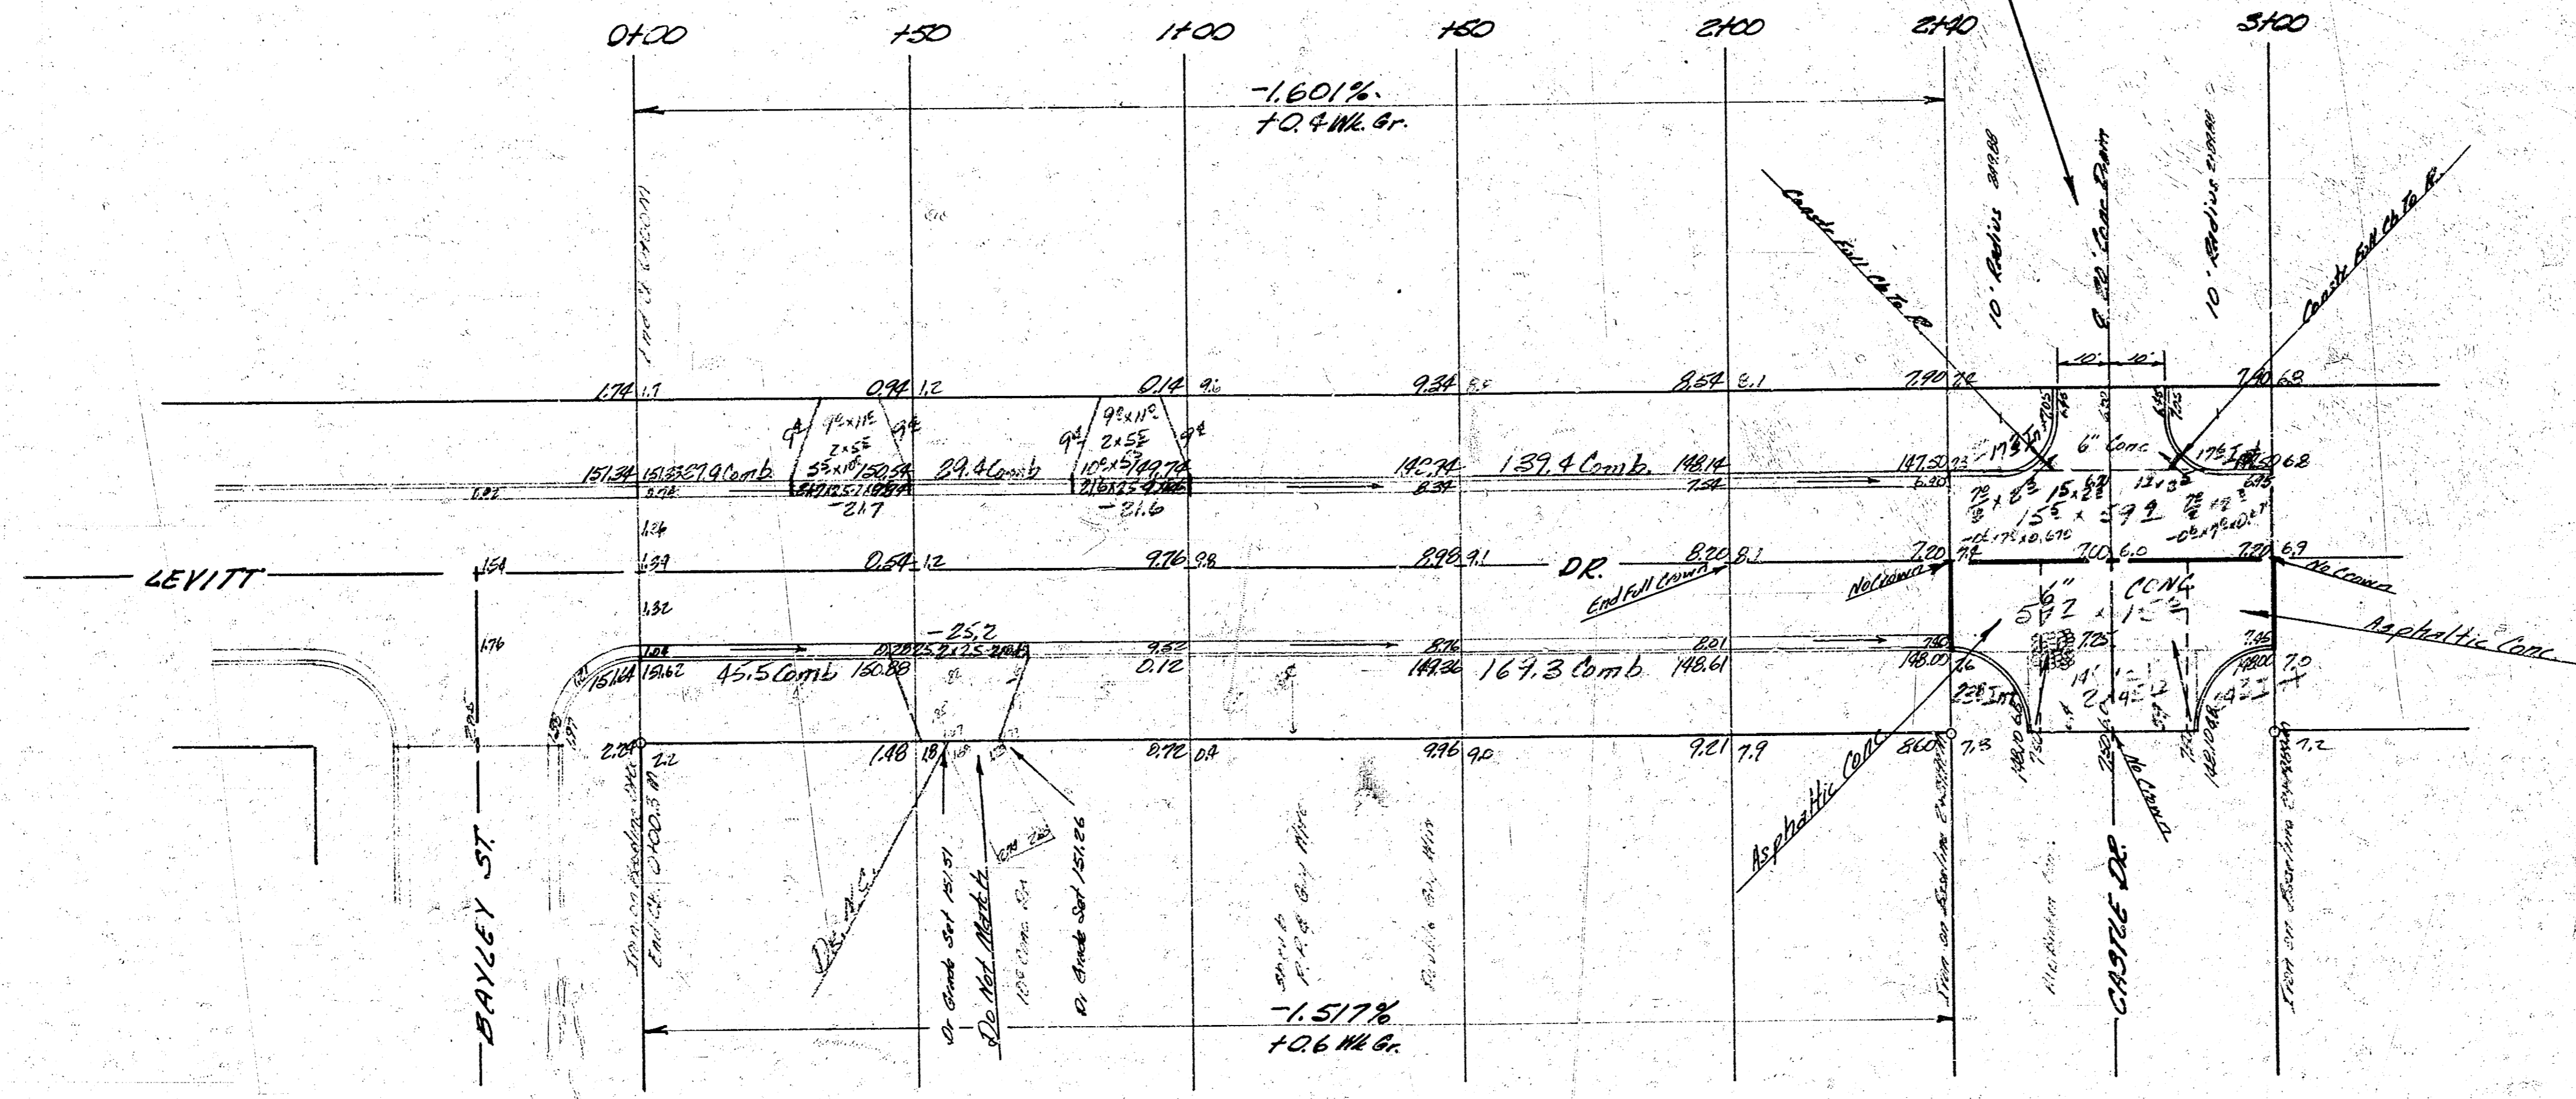

PRIVATE CONTRACTOR QUANTITIES		FINAL
695 SY	Pav't	695.2
142 SY	6" Conc Pav't	142.0
370 LF	Comb. Ch. & Gr.	411.5
81 LF	Reinf. Inst. Ch.	84.8
100 SF	Sep. Ch.	87.6
275 SF	5" Sep. Gr.	146.5
875 SF	6" Drive	220.0
2570 Lbs	Reinf. Steel	222.5
190.2 CY	Excavation	212.8
60.1 CY	Comp. Fill	65.0
30 LF	Mastic H.	22.0
1' ea	5m. Tree Rem.	1
1' CH	Concrete	1
1' CH	Spec Excav	1

PROJ. C15-49

Excav.
 City
 3.8 CY
 0.4% 10%
 9.2 CY Total

Comp. Fill
 City
 45.4 CY
 4.8% 10%
 50.5 CY Total

LEVITT DRIVE
 E.L. BAYLEY ST TO E.L. CASTLE DR
 26'-2" - 30 AC.

INTERSECTIONS
 CASTLE DR & LEVITT DR
 CASTLE DR & CAFFREY ST
 ASPHALTIC CONCRETE

CITY OF WICHITA, KANSAS
 B. E. SMITH CITY ENGINEER
 DATE PRIVATE CONTRACT

CITY OF WICHITA, KANSAS
 B. E. SMITH CITY ENGINEER
 DATE PROJ. NO. C15-49

