


Madison Ave. - S.L. Messman to N.L. Rendon Rd.

26-2-30 A.S.

B.M. Elev. 115.31 "B" in Batt back of
wk. H., N.W. cor Batt + 9th

Boys E. 11999. no one comes, bored.

1014

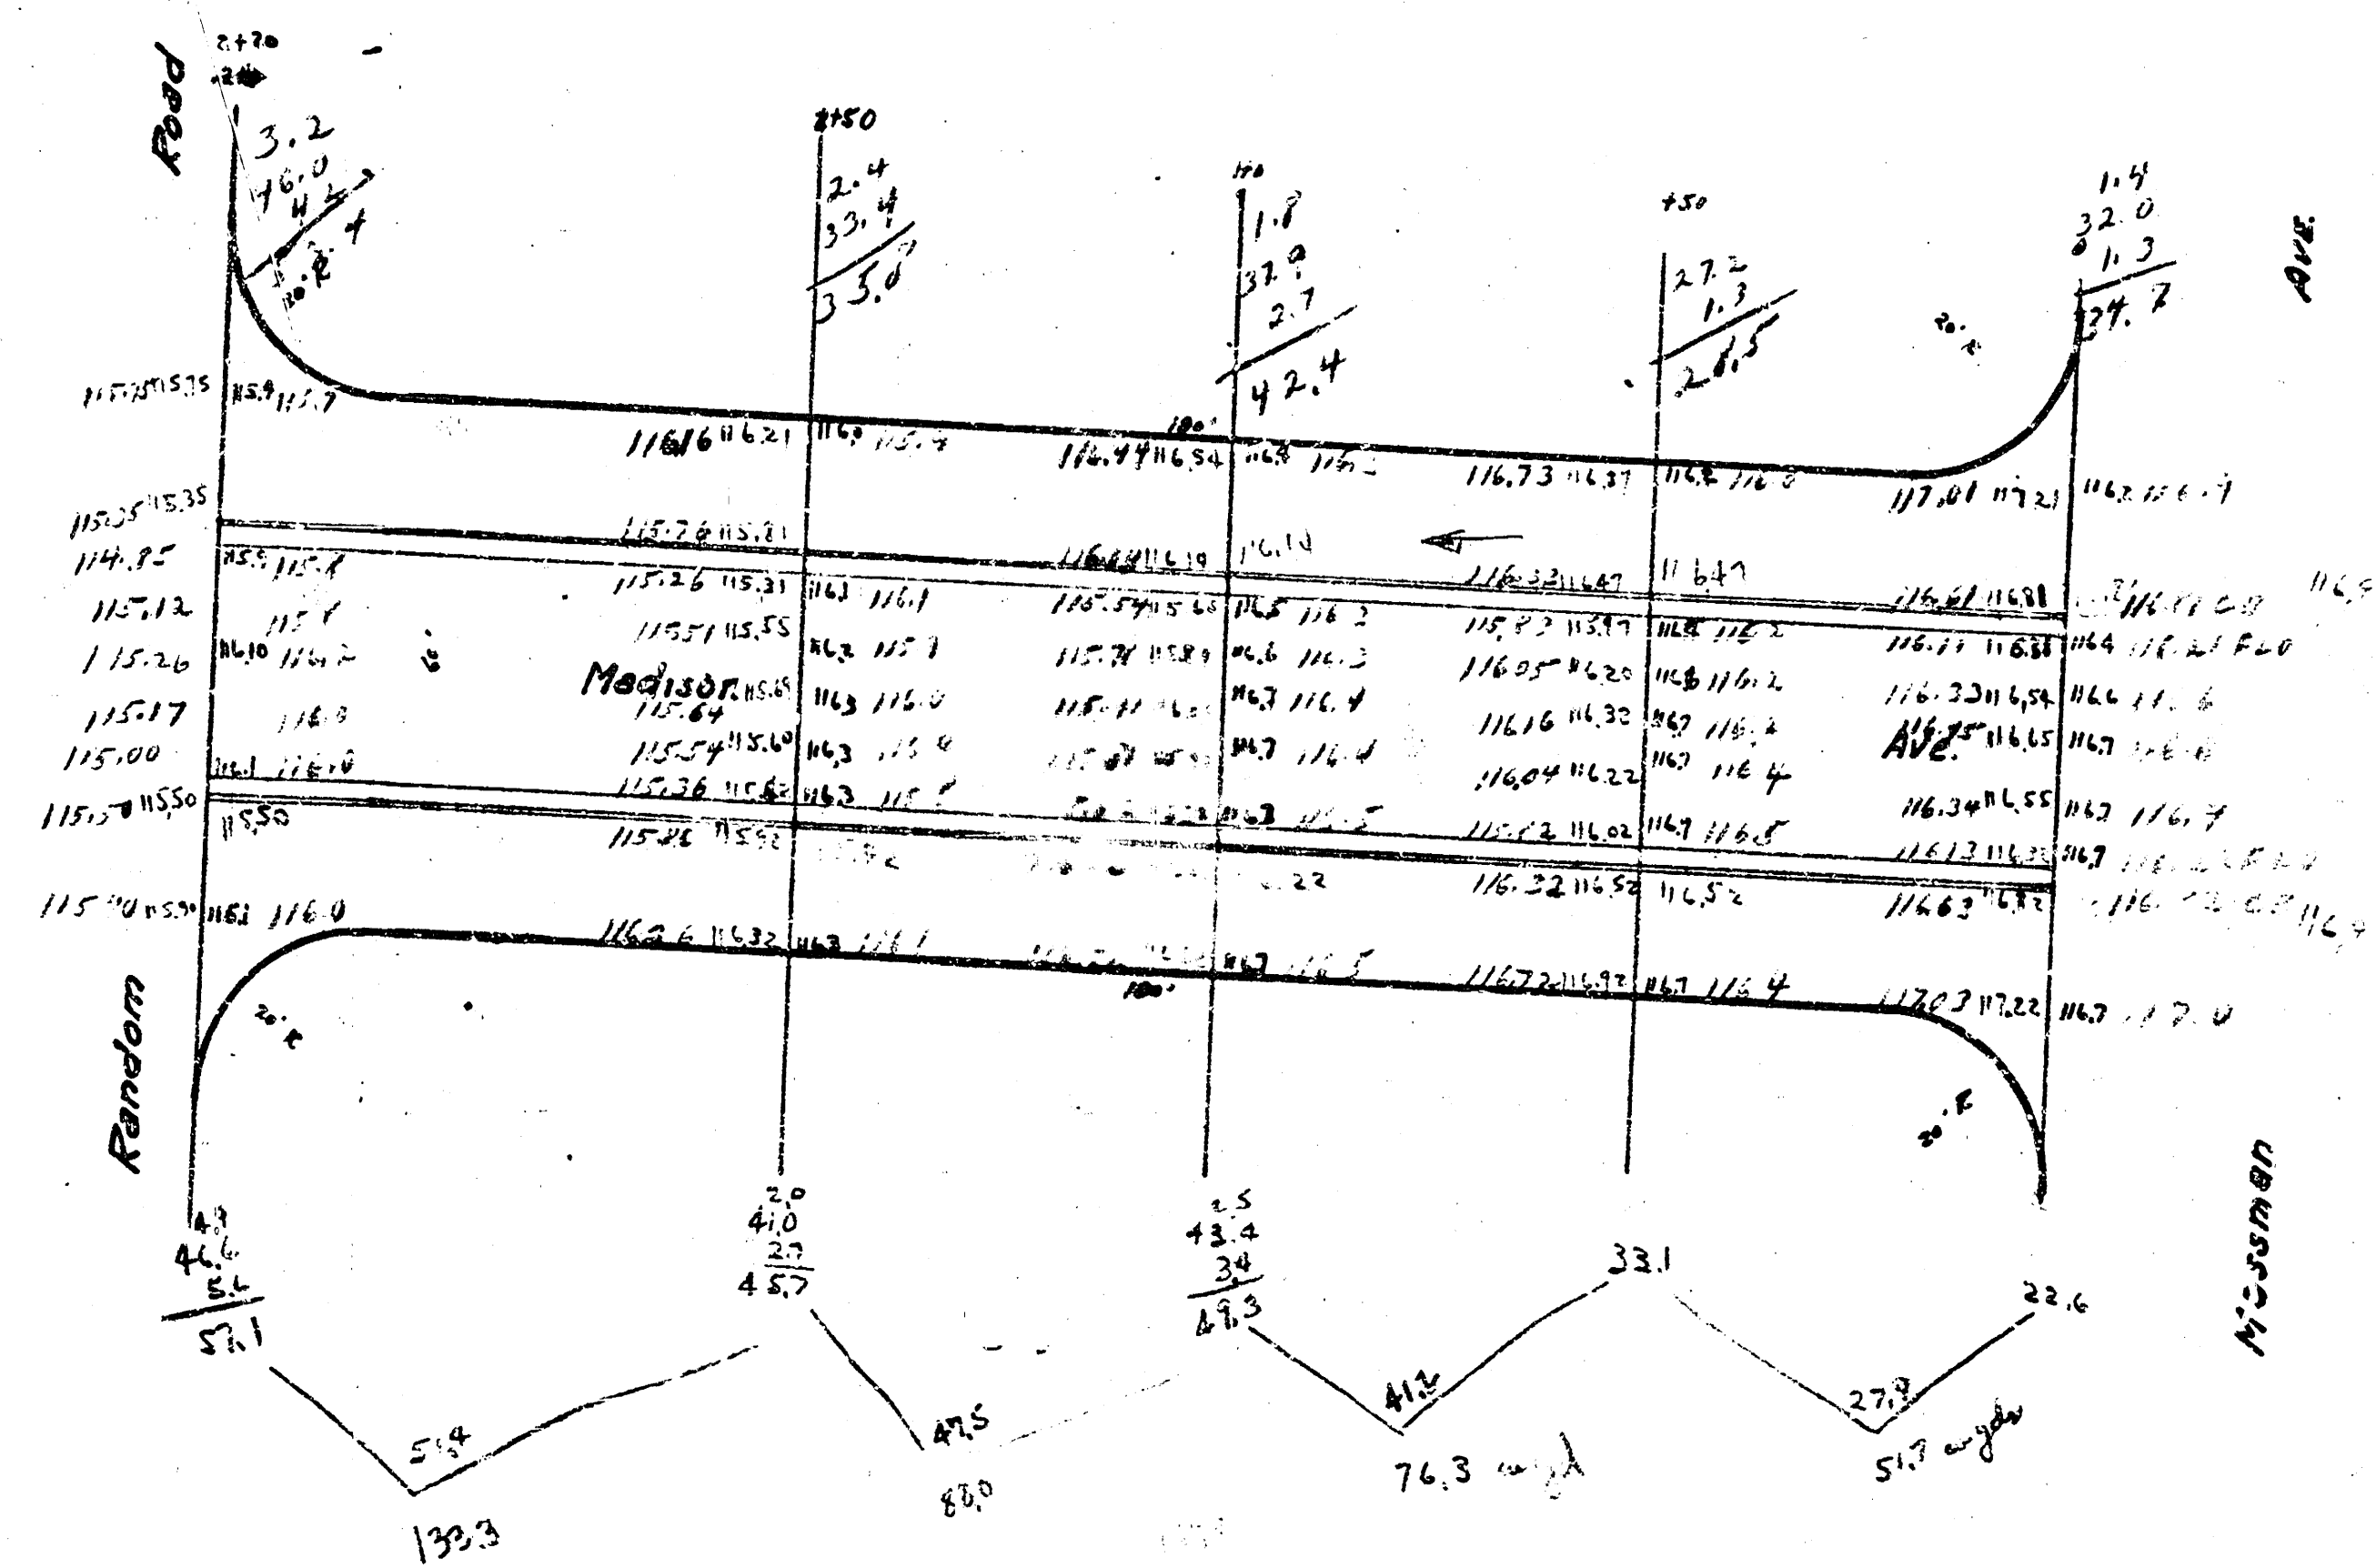

Property	349.3	in lbs
7107	34.9	
<u>Total</u>	<u>384.2</u>	in lbs