


B.M. 1 - 123.45 S.E. Cor. Conc. Patch Has. N.W. Cor. 14th & Service
 B.M. 2 - 121.44 N.W. Cor. bottom Step Has. S.E. Cor. 16th & Madison

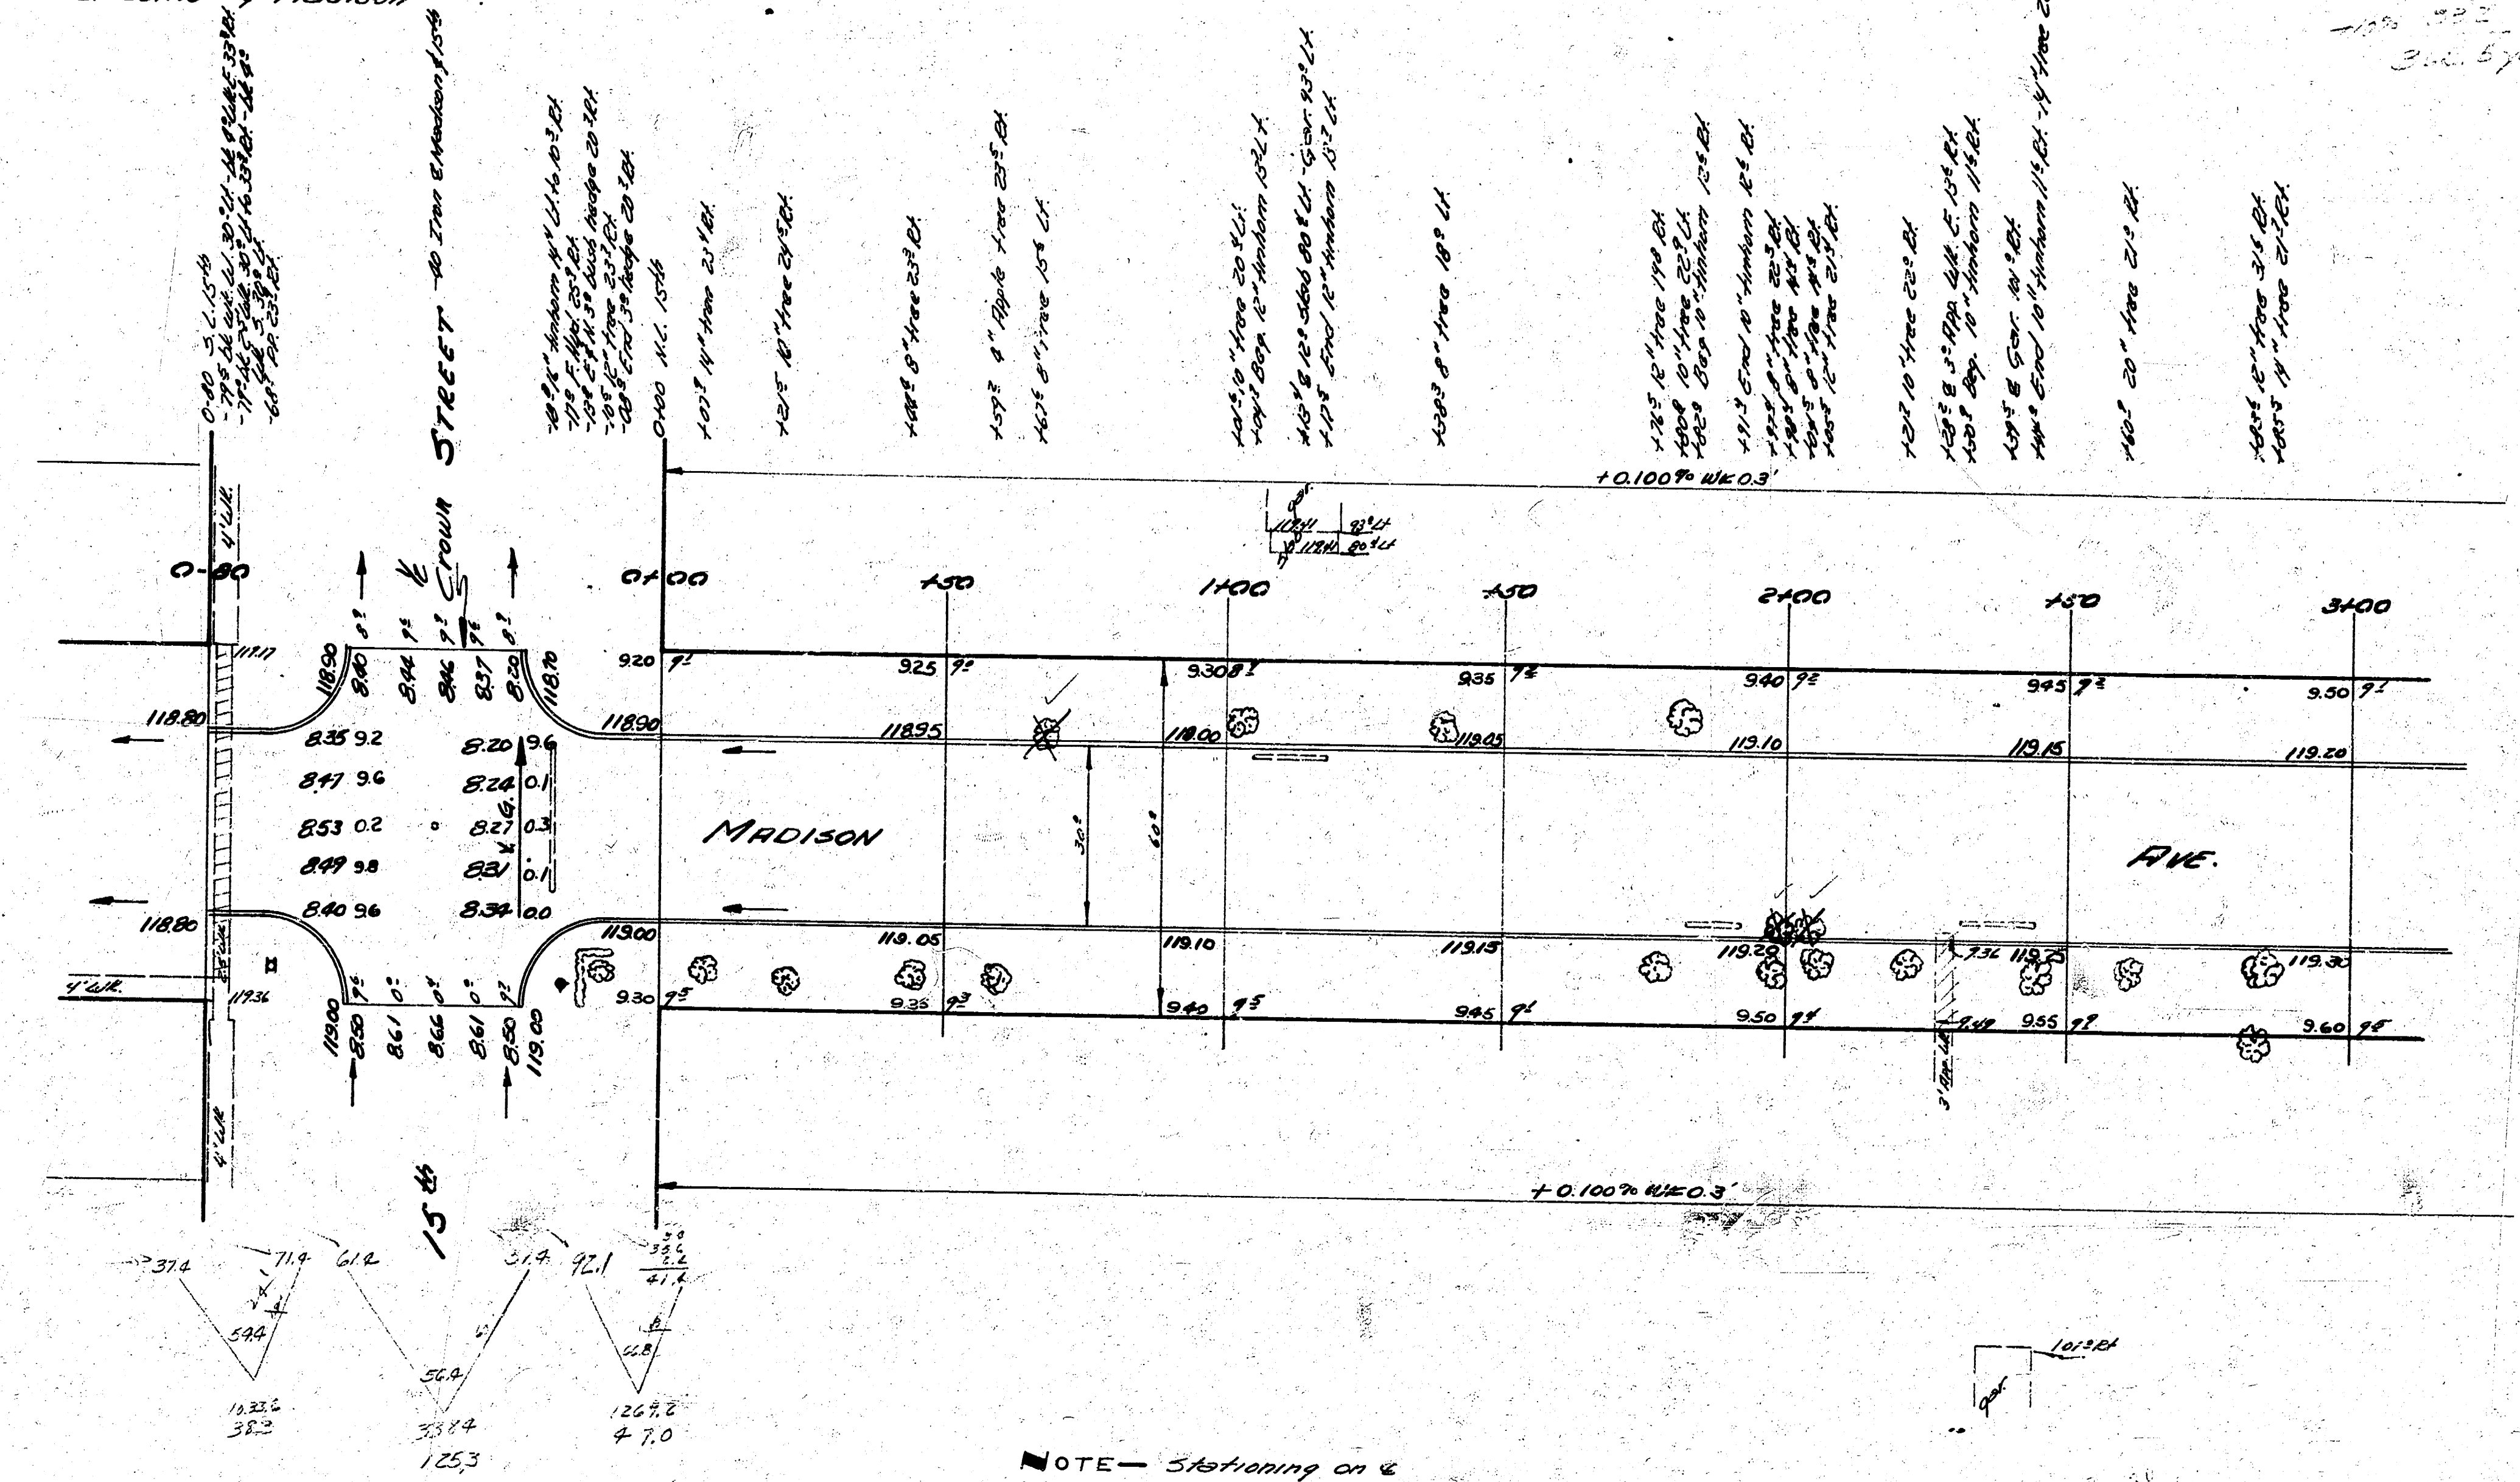


TIES TO IRONS

6 1/2" & 8 Madison
 3862 - N.E. 1/4 16" Spike N.W. Side 12" Tree
 3840 - S.E. 1/4 16" Spike N.E. Side 10" Tree
 3862 - S.W. 1/4 16" Spike S.E. Side 8" Tree

6 1/2" & Madison
 7030 - S.E. 1/4 N.W. Cor. Patch 16' Tree
 3839 - N.E. 1/4 16" Spike S.E. Side 10" Tree
 6871 - S.W. 1/4 16" Spike S.E. Side 16" Tree

NOTE - Stationing on 6
 NOTE - X-Secs. run from 6+37.4 to 0+00

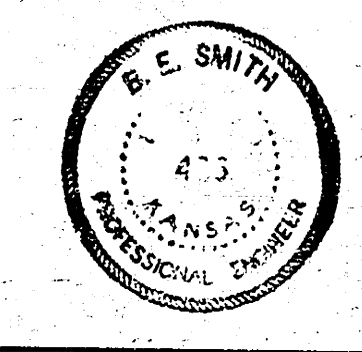

MADISON
 S.E. 15th to N.W. 16th
 30' CONC. & CO.
 City of Wichita, Kans.
 B.E. Smith City Engineer
 July 1953 Proj. No. C15-110

