


B.M. #1 (City) R.R. spk. in pwr. pole
 47' Rt. Sta. 16+63 El. 1320.09 M.S.L. El. 132.83 City

B.M. #2 S.E. cor retaining wall
 137' Rt. Sta. 17+90 El. 1320.71 M.S.L. El. 133.45 City

B.M. #3 (FC) R.R. Spk. in N.E. wing
 30' Lt. Sta. 25+90 El. 1320.40 M.S.L. El. 133.14 City

B.M. #4 (City) R.R. spk. in pwr. pole
 35' Rt. Sta. 26+00 El. 1319.78 M.S.L. El. 129.52 City

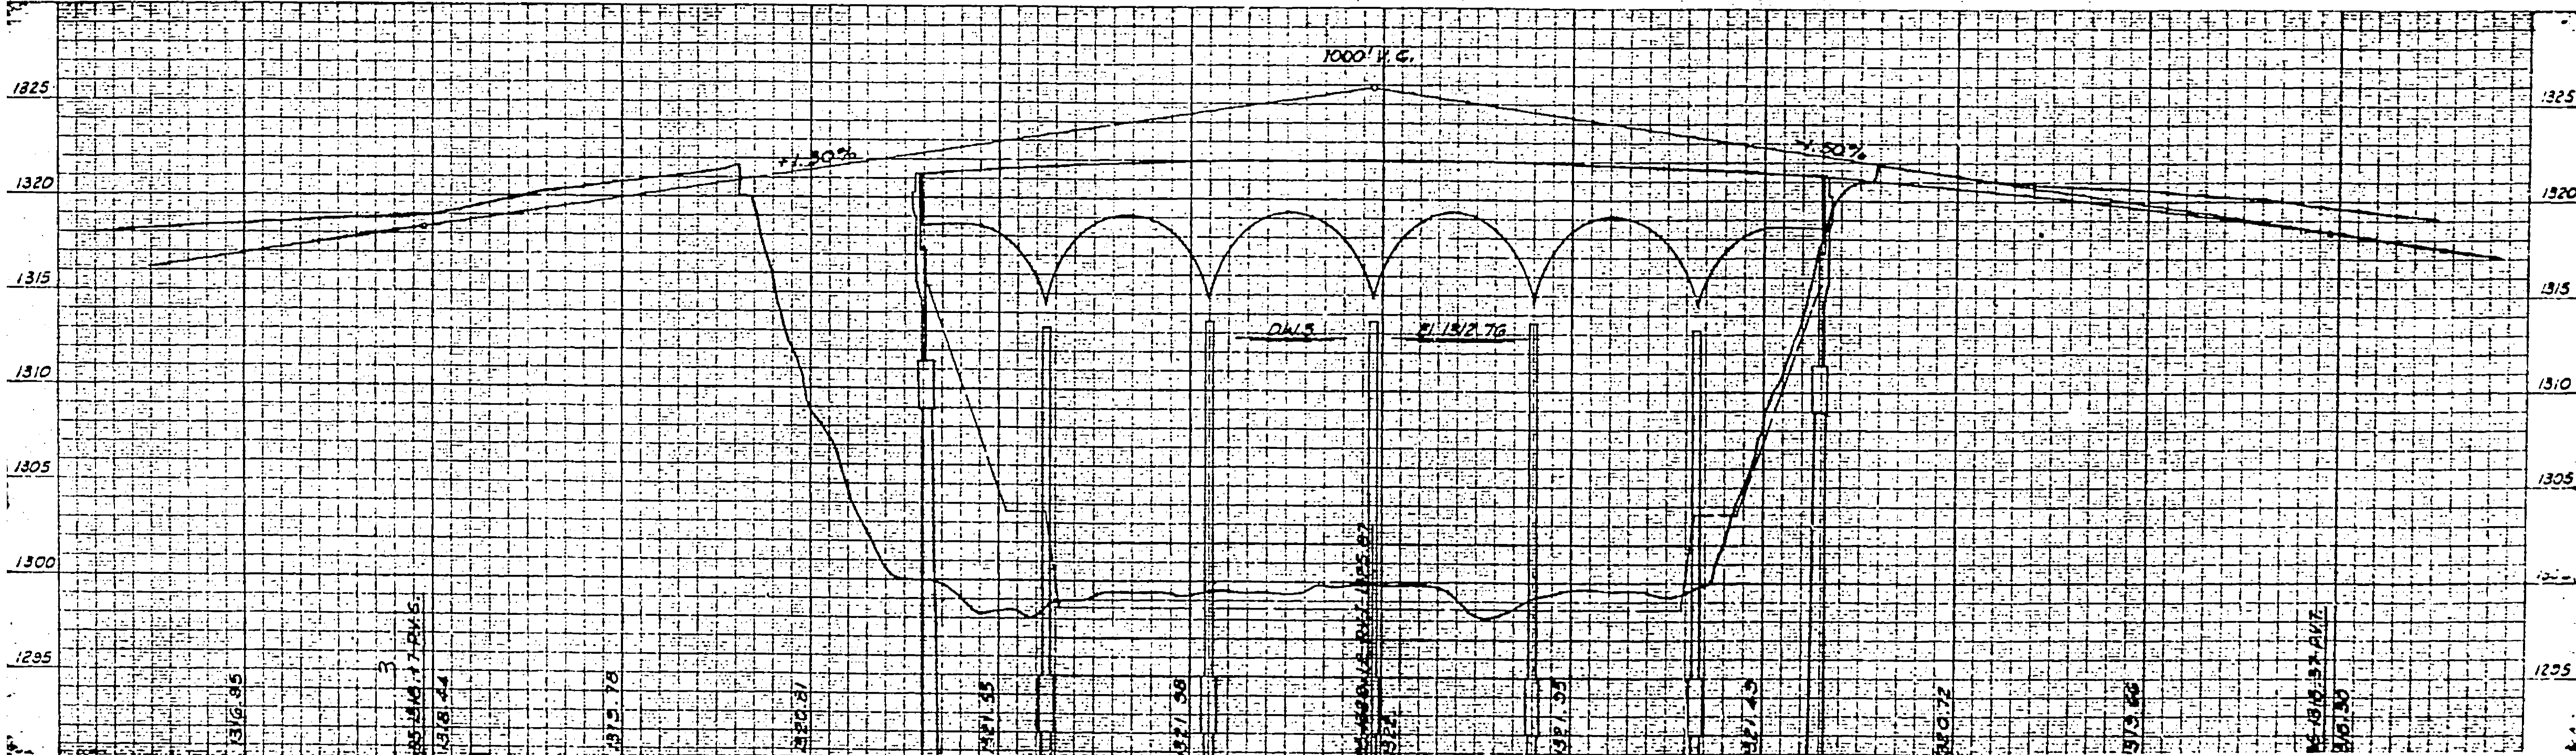

NOTES:
 See Sheet 1 for dimensions of concrete parapet
 See Sheet 2 for details and sections of parapet, and base grouting sections
 See Sheet 14 for details of storm sewer roadways.
 See Sheet 14 for Summary of Quantities

J:\Civil\04223\Original bridge plans\Sheet 3.dwg 06/01/2007 04:07:21 PM CST

CITY OF WICHITA, KANSAS
 B.E. SMITH, P.E. CITY ENGINEER

TWENTY-FIRST STREET BRIDGE OVER
 THE BIG ARKANSAS RIVER

PLAN - PROFILE

PROJECT C 10-51 AS-BUILT
 NOVEMBER 1972